



JURUPA COMMUNITY SERVICES DISTRICT

REQUEST FOR PROPOSAL

Nitrate Removal Media

Roger Teagarden Treatment Plant

Jurupa Community Services District
11201 Harrel Street
Jurupa Valley, CA 91752

Issue Date: February 28, 2024
Due Date: March 14, 2024
Thursday, 12:00 p.m. PST

Project Manager: Bryan Smith
Phone: (951) 685-7434 Ext. 139
BSmith@jcsd.us

TABLE OF CONTENTS

1. REQUEST FOR PROPOSALS (RFP)	1
A. OVERVIEW	1
B. PROPOSAL SUBMITTAL DETAILS	1
C. DISCLAIMER	1
2. ANTICIPATED SCHEDULE	2
3. PROPOSAL FORMAT	2
A. TECHNICAL REQUIREMENTS	2
B. ADDITIONAL REQUIREMENTS	2
C. PROJECT SCHEDULE	3
D. QUALIFICATIONS & PRODUCT RELIABILITY:	3
E. CONFLICTS/CONTRACTUAL ISSUES	3
F. FEE ELEMENTS	3
4. SELECTION OF VENDOR	3
A. CRITERIA FOR SELECTION	3
B. NOTIFICATION OF UNSUCCESSFUL VENDORS	4
5. SCOPE OF WORK	5
A. Background	5
B. Project Overview & Objectives	5
6. LIST OF ATTACHMENT AND REFERENCE DOCUMENTS	7

1. REQUEST FOR PROPOSALS (RFP)

A. OVERVIEW

The Jurupa Community Services District (JCSD or District) is requesting proposals from qualified vendors to supply regenerable ion exchange resin or equivalent JCSD-approved media (referred to as media herein) suitable for Nitrate treatment from groundwater. The media shall be integrated into the Nitrate treatment system at the JCSD Roger Teagarden Water Treatment Plant ("RT WTP" or "Site") located in Jurupa Valley, California. Vendors shall quote the appropriate type and required quantity of media that meets the criteria outlined in this request for proposal (RFP).

B. PROPOSAL SUBMITTAL DETAILS

Proposals shall be submitted electronically in PDF format to:

Bryan Smith
Project Manager
BSmith@JCSD.US

Email subject shall read "Proposal from *Vendor's Name*: Nitrate Treatment Media – Roger Teagarden Treatment Plant."

Proposals must be sent no later than the deadline listed in the Project Schedule section of this RFP. All proposals received after this deadline will be rejected. Vendors are encouraged to send their proposals utilizing the DELIVERY and READ Receipts enabled.

The delivery receipt will be the bidder's verification that the proposal has been sent to JCSD prior to the deadline. All files must be less than 20MB as this is JCSD's limit for email submission. Multiple emails for the proposals can be sent to accommodate larger proposal files. If multiple emails are required for proposal submission, the email subject shall be suffixed with *Part [#] of [Total Parts]*.

C. DISCLAIMER

This RFP does not commit the District to award a contract or to pay any costs incurred in the preparation of the proposal. The District reserves the right to extend the due date for the proposal, to accept or reject any or all proposals received as a result of this request, to negotiate with any qualified vendor, to cancel this request in part or in its entirety, and to procure alternate or additional services.

More than one proposal from an individual, firm, partnership, corporation, or association under the same or different names shall not be considered. JCSD shall not be liable for any pre-contractual expenses incurred by the vendor.

2. ANTICIPATED SCHEDULE

The following estimated dates have been set for this project:

RFP Advertisement	February 28, 2024
RFP Questions Due	March 6, 2024 via email only
Proposals Due	March 14, 2024, 12:00 PM PST via email
Anticipated Board Approval	April 2024
Anticipated Delivery & Commissioning Date	May – June 2024

Questions regarding the RFP shall be addressed to the Project Manager, Bryan Smith, via email at BSmith@JCSD.US. All questions must be received prior to the deadline shown in the Project Schedule above. Answers to these questions will be sent to all prospective vendors. No answers will be given on an individual basis.

3. PROPOSAL FORMAT

Vendors are requested to prepare a technical and fee proposal in response to the scope of work outlined in Section 5 in accordance with the following requirements.

A. TECHNICAL REQUIREMENTS

The proposal shall include the following technical information at a minimum:

- Product data sheet for the recommended single-use resin/media including information related to media matrix, active functional group if any, typical physical and chemical characteristics, NSF61 and other applicable certifications, principal applications, and typical packaging;
- Information demonstrating the media's applicability for Nitrate removal from Site influent: Nitrate selectivity, quantity of media, estimated/modeled breakthrough curves, and anticipated regeneration per volume of Site water treated;
- Media loading procedure, including necessary clearance, access, and utility requirements;
- Media evacuating and containment for on-site storage procedure, including necessary clearance, access, and utility requirements;
- Recommended preservation procedure for media during periods of extended shutdown (i.e., greater than 7 days);
- Media commissioning requirements (such as product soak, conditioning etc.) and other applicable instructions; and

B. ADDITIONAL REQUIREMENTS

- Modeling information regarding media performance based on influent water quality (**Attachment B**) and effluent goals (Section 5) provided;

- Hydraulic performance metrics such as pressure drop across the media bed at the design flowrate, backwash requirements and bed expansion if any; and

C. PROJECT SCHEDULE

Vendors shall confirm availability of the required quantity of media and their ability to meet the delivery and commissioning schedule outlined in Section 2.

D. QUALIFICATIONS & PRODUCT RELIABILITY:

Vendors must provide evidence of successful use of the proposed media for similar applications and vendor's capability and experience in the key areas identified in the scope of work in Section 5. Vendors shall provide descriptions of at least five of their firm's recent record of performance on similar projects, including project completion date, media quantities supplied, and any support services offered. Vendors shall include a reference personnel from the agency/customer for each project referenced, including name and current telephone number of a person familiar with the vendor's performance.

E. CONFLICTS/CONTRACTUAL ISSUES

Vendors shall indicate if there are any personnel or organizational conflicts of interest and if there are none, provide a statement to this effect.

F. FEE ELEMENTS

Vendors are requested to provide estimated costs for the media quantity, and removal of the current media for storage on site as part of the proposal. The vendor's cost estimate shall include line items listed in the fee proposal table provided in **Attachment A** and detailed below:

- Cost associated with delivery, installation, and commissioning of recommended fill of media in the Nitrate Treatment System (including freight, taxes, and other miscellaneous fees);
 - Estimated costs associated with future media changeouts on a per vessel basis (including freight, taxes, and other miscellaneous fees); Applicable discounts for contract clients (if any); and

4. SELECTION OF VENDOR

A. CRITERIA FOR SELECTION

Selection among the proposals received shall be based upon (but not necessarily in the order given) the following:

- Ability to meet the delivery schedule specified in Section 2;

- Qualifications and experience of the firm, reliability of the product based on performance on similar applications/projects;
- Media technical specifications including estimated breakthrough period for Site influent water, pressure drop and hydraulic characteristics;

Each vendor's proposal shall be evaluated and ranked based on the technical criteria listed in section 3A and 3B of this RFP. Following the ranking of the proposals, the fee for the top-ranked vendor will be opened and reviewed for its reasonableness relative to the proposed scope of work. JCSD will then negotiate the final Scope of Work and fee estimate with the top-ranked vendor. If an agreement cannot be reached with the highest-ranked vendor, negotiations will be terminated, and the vendor will be notified of termination in writing.

B. NOTIFICATION OF UNSUCCESSFUL VENDORS

Unsuccessful vendors shall be notified as soon as possible by JCSD following the determination of the recommended vendor. The determination is expected to be within 60- days after the proposal deadline. The final determination will likely require acceptance and approval by the Agency's Board of Directors.

5. SCOPE OF WORK

A. Background

JCSD was established in 1956 to provide sewer service to the Jurupa area. JCSD began providing water service in 1966 with the consolidation of the Jurupa Heights Water Company, La Bonita Mutual Water Company, and the Monte Rue Acres Mutual Water Company. JCSD expanded its service area west to an unincorporated area of the County, which is now the City of Eastvale, and expanded its scope of services to include streetlight maintenance, frontage landscape maintenance, graffiti abatement, and parks and recreation services. Today, the JCSD service area covers 40.8 square miles of northwest Riverside County and includes the city of Eastvale and a majority of the city of Jurupa Valley. JCSD serves approximately 131,000 people and is governed by five elected Board of Directors.

JCSD's water supplies have historically been sourced exclusively from the Chino Basin groundwater aquifer. The aquifer in the Chino Basin where JCSD's source water is sourced has elevated Nitrate contaminants and requires treatment for removal. The Roger Teagarden facility was constructed to treat the JCSD facilities for potable production. The treatment plant is under construction to add treatment for PFAS. The current Nitrate resin media has been exposed and is contaminated with PFAS. With the new PFAS removal process in place, there is a concern about sloughing from the old Nitrate removal media. For this JCSD is removing and disposing of the current Nitrate removal media and replacing it with new more efficient Nitrate media. This media will be loaded into the Nitrate treatment portion of Roger Teagarden and be supplied by eight groundwater wells(8, 11, 12, 14, 15, 16, 22, 25). A treatment project, which will remove PFAS from a combination of four wells (Wells 14, 15, 22, and 25) that convey water to JCSD's RT WTP, is currently in design, with construction completion expected in May 2024.

B. Project Overview & Objectives

Vendors are requested to provide a proposal for removal of current media and containment for storage onsite for disposal at a later time(disposal not included in this RFP) and new media fill for an appropriate type and quantity of media for use in the Nitrate treatment system)at the RT WTP. Design specifications of the Nitrate treatment system are summarized below:

- The goal of the Nitrate treatment system is to reduce Nitrate concentrations by treating groundwater from Wells 8, 11, 12, 14, 15, 16, 22, and 25 before entering the JCSD potable water system. Detailed design drawings for the Nitrate treatment system are provided in **Attachment C**;
- The Nitrate treatment system is designed to accept groundwater from four wells (i.e., Wells 8, 11, 12, 14, 15, 16, 22, and 25) with a design flowrate of 15,000 gallons per minute (gpm) as shown on Table 1;

Table 1: Influent Flowrates to Nitrate Treatment System

Well Name	Average Flowrate (gpm)
Well 8	850
Well 11	1100
Well 12	1100
Well 14	2,100
Well 15	530
Well 16	1,875
Well 22	3,100
Well 25	3,000
TOTAL INFLUENT	13,655

- The unit operations in the Nitrate treatment system include three active bag filters, followed by ten Nitrate removal Ion exchange media vessels in a parallel configuration. Note that the Site infrastructure is not currently equipped with air induction capabilities for the media vessels. Key design specifications associated with the system relevant to media selection are listed in Table 2.

Table 2: Media System - Design specifications per vessel

Treatment Flowrate (gpm) ¹	1,600
Minimum Empty Bed Contact Time (minutes)	2.2
Drain filter basket size	.229mm

¹Vendor to propose appropriate volume of media based on design specifications.

- The treatment system is designed for continuous operation and is expected to be operational seasonally;
- A summary of relevant design parameters and operating conditions are presented in Table 3;

Table 3: Media Vessel Specifications

Specifications of Each Vessel in Media System	
Vessel Diameter	144"
Side Shell Height	96"
Overall Height (Approximate)	17'-3"
Maximum Media Fill Capacity	455 CF
Manways:	
Flanged at side shell	20"
Flanged at head	20"
Working Pressure	120 psi @ 60°F

Specifications of Each Vessel in Media System	
Material	Steel

lbs. - pounds; °F - degree Fahrenheit; CF – cubic feet; psi - pounds per square inches;

- The treatment goal for the Nitrate treatment system is 35 mg/L which is 80% of the Maximum Contaminant Level (MCLs) proposed by United States Environmental Protection Agency (USEPA) for Nitrate (Table 4). Concentrations of Nitrate above the 35 mg/L which is 80% the USEPA 80% MCLs (Table 4) from the effluent media vessels will be considered breakthrough triggering a media regeneration in that vessel;
- There are currently nine vessels loaded with 454CF of media to be evacuated and packaged for on-site storage.

Table 4: Nitrate Discharge Criteria

Nitrate Constituent	USEPA MCL (mg/L)
Nitrate	45mg/L

mg/L - milligrams per liter; EPA - United States Environmental Protection Agency; MCL - Maximum Contaminant Levels

- The proposed media is expected to be compatible with existing vessel infrastructure, appropriate for influent water quality (**Attachment B**), and meet the technical requirements detailed in Section 3A and Section 3B.

Site specific information considered necessary to execute this scope of work referenced above are provided as attachments to this RFP.

6. LIST OF ATTACHMENT AND REFERENCE DOCUMENTS

The following attachments are included in the RFP:

Attachment “A” – Fee Proposal Table

Attachment “B” – Influent Water Quality to Nitrate Treatment System

Attachment “C” – Nitrate Treatment System Design Drawings

Attachment “D” - Process Controls and Operation

**Attachment “A”
Fee Proposal Table**

PROPOSAL FEE TABLE - PFAS TREATMENT MEDIA RFP
Roger Teagarden Treatment Plant, Jurupa Valley, CA

Name of Company:		Date:		
Client Manager:				
Contact Information:				
Quoted Media:				
		Qty.	Unit Cost	Total Cost
<u>Initial Procurement & Commissioning</u>				
Media Cost ¹	\$/cuft			
Volume of Media Quoted	cuft			
Freight	ea			
Commissioning/Loading Cost	ea			
Taxes	\$			
Miscellaneous charges	\$			
Total				
<u>Media removal and storage</u>				
Per Vessel Exacuation Cost	ea			
Mobilization	ea			
Materials	\$			
Miscellaneous charges	\$			
Total				

Date	Signature

Notes:

cuft - cubic feet, ea - each; qty - quantity

¹Vendor to provide appropriate amount of media based on design flowrates provided in Section 5 of the

Attachment “B”
Influent Water Quality to Nitrate Treatment System
(in folder as Excel file)

Attachment “C”
Nitrate Treatment System Design Drawings

CONSTRUCTION PLANS FOR:

JURUPA COMMUNITY SERVICES DISTRICT

JURUPA ION EXCHANGE
WATER TREATMENT PLANT
PHASE III


WORK INCLUDED IN THIS CONTRACT IS SHOWN IN BOLD
WORK TO BE DONE BY CONTRACTOR INCLUDES:
1) INSTALL IX NITRATE VESSELS G, H, J&K
2) INSTALL 2ND IX SOFTENER VESSEL - 20SVB
3) INSTALL 2ND WASTEWATER-70TKB
4) PIPING, VALVING, ELECTRICAL, AND
I/C ASSOCIATED WITH 1,2, AND 3
AS SHOWN ON THE PLANS:

APPROVED BY:
JURUPA COMMUNITY SERVICES DISTRICT

ELDON HORST - GENERAL MANAGER DATE


MARCH 2007

PROJECT LOCATION

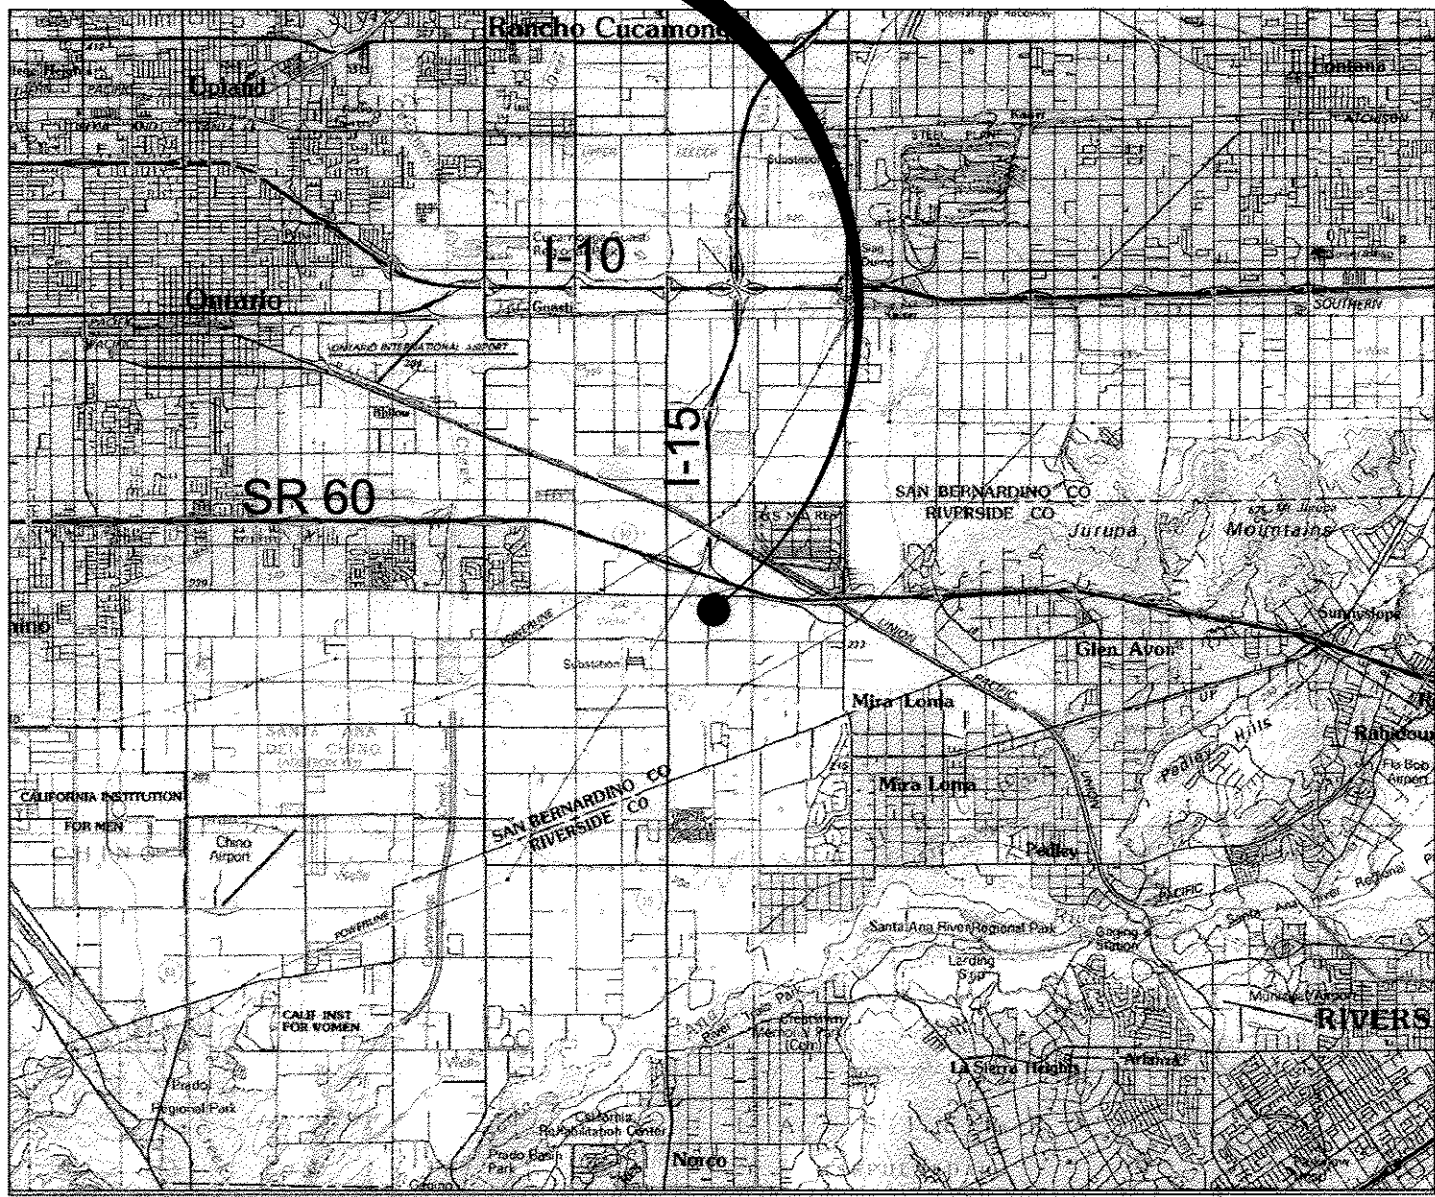

VICINITY MAP

PROJECT LOCATION

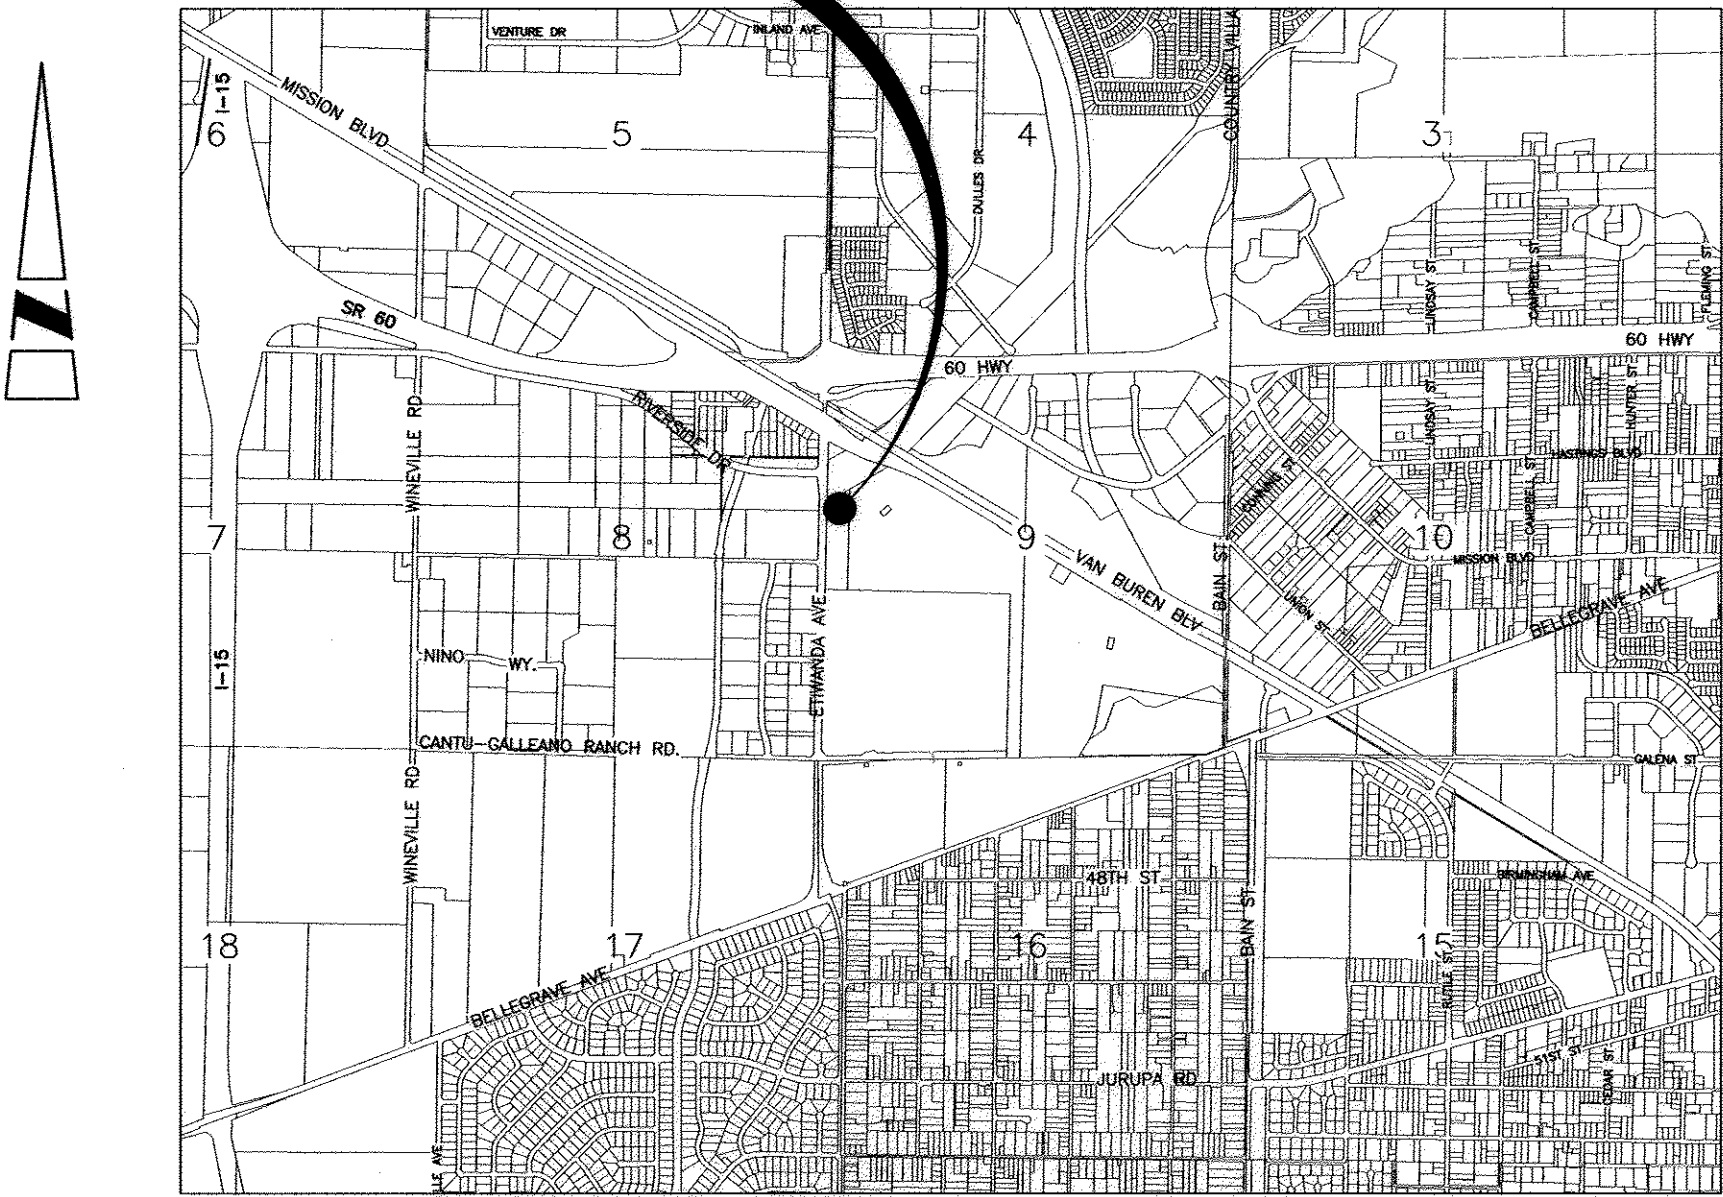

LOCATION MAP


SHEET INDEX:

1	T-1	TITLE SHEET
2	P-1	PROCESS FLOW DIAGRAM 1 OF 2
3	P-2	PROCESS FLOW DIAGRAM 2 OF 2
4	P-3	PLANT LAYOUT
5	P-4	IX NITRATE REMOVAL VESSEL PARTIAL PLAN
6	P-5	IX NITRATE REMOVAL VESSEL SECTIONS
7	P-6	IX NITRATE REMOVAL VESSEL - INTERNAL DETAILS
8	P-7	WASTE TANK AND SOFTENER VESSELS PIPING PLAN
9	P-8	SOFTENER VESSEL PIPING SECTIONS
10	P-9	SOFTENER VESSEL SECTION AND DETAILS
11	P-10	BRINE RINSE TANKS AND PUMP STATIONS PARTIAL PLAN
12	P-11	BRINE TANK PIPING SECTIONS
13	P-12	WASTE TANK SECTIONS AND DETAILS
14	P-13	NEW BRINE TANKS
15	P-14	BRINE TANK SECTIONS AND DETAILS
16	P-15	HYDROGEN PEROXIDE INJECTION SYSTEM
17	DP-1	PIPE SUPPORT DETAILS
18	DP-2	MISCELLANEOUS DETAILS
19	DP-3	MISCELLANEOUS DETAILS
20	DP-4	RAW WATER SCHEMATIC
21	DP-5	TREATED WATER SCHEMATIC
22	DP-6	AIR LINE SCHEMATIC
23	DP-7	BRINE/RINSE IN SCHEMATIC
24	DP-8	BRINE/RINSE OUT SCHEMATIC
25	DP-9	BACKWASH SUPPLY SCHEMATIC
26	DP-10	DRAIN/BACKWASH OUT SCHEMATIC
27	DP-12	INSTRUMENT MOUNTING DETAILS
28	E-1	ELECTRICAL SYMBOLS AND ABBREVIATIONS
29	E-2	SINGLE LINE DIAGRAM
30	E-3	EQUIPMENT ELEVATIONS
31	E-4	CONDUIT SCHEDULES
32	E-5	CONDUIT SCHEDULES
33	E-6	CONDUIT SCHEDULES
34	E-7	CONDUIT SCHEDULES
35	E-8	ELECTRICAL SITE PLAN
36	E-9	SITE POWER AND CONTROL DISTRIBUTION PLAN
37	E-10	IX VESSEL PARTIAL POWER PLAN
38	E-11	ION EXCHANGE VESSEL PARTIAL POWER PLAN
39	E-12	WASTE TANKS AND SOFTENER VESSELS POWER PLAN
40	E-13	BRINE AND RINSE TANKS POWER PLAN
41	E-14	BLOWER AND BLENDING STATION POWER PLAN
42	E-15	ION EXCHANGE VESSEL PARTIAL CONTROL PLAN
43	E-16	ION EXCHANGE VESSEL PARTIAL CONTROL PLAN
44	E-17	WASTE TANKS AND SOFTENER VESSELS CONTROL PLAN
45	E-18	BRINE AND RINSE TANKS CONTROL PLAN
46	E-19	CONTROL BUILDING ELECTRICAL PLAN
47	E-20	SCHEMATIC DIAGRAMS
48	E-21	ELECTRICAL DETAILS

RECORD DRAWING
Date: 08-23-07

These record drawings apply only to those facilities constructed under the contract identified in the title block and have been prepared, in part, on the basis of information compiled and furnished by others. The Engineer/Architect will not be responsible for any errors or omissions which have been incorporated into this drawing as a result of the work by others.

BOYLE ENGINEERING CORPORATION

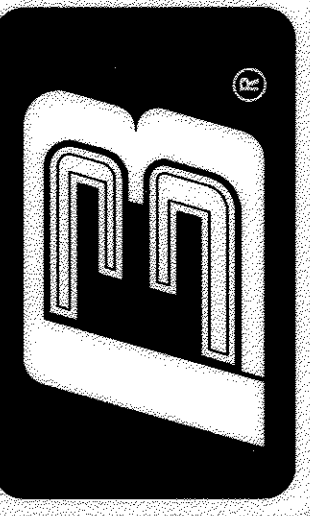

PROJECT
JURUPA ION EXCHANGE
WATER TREATMENT PLANT
PHASE III

CLIENT
JURUPA COMMUNITY SERVICES DISTRICT

PROJECT MANAGER CE DATE

PROJECT ENGINEER CE DATE



ACCOUNT NUMBER FILE NUMBER
BK-J04-100-04 S-2268

SHEET NUMBER 1 OF 48 SHEETS

BOYLE ENGINEERING CORPORATION

5001 E. COMMERCE DR.
Bakersfield, California 93309
661 / 325-7253

PROCESS 10 - NITRATE REMOVAL VESSELS (MODULE No. 2)

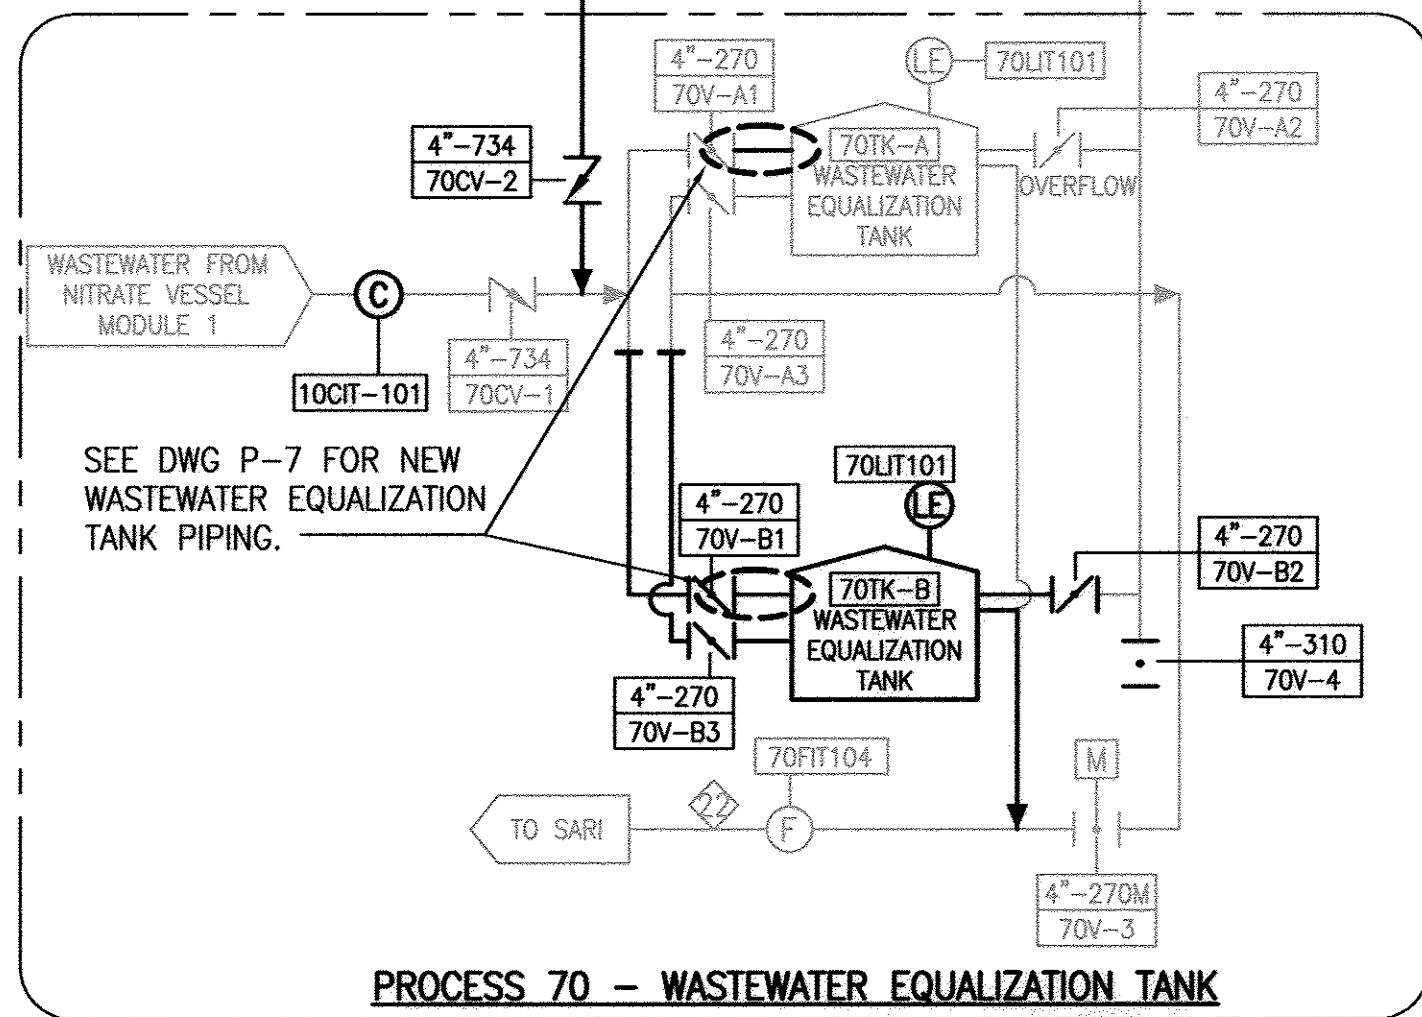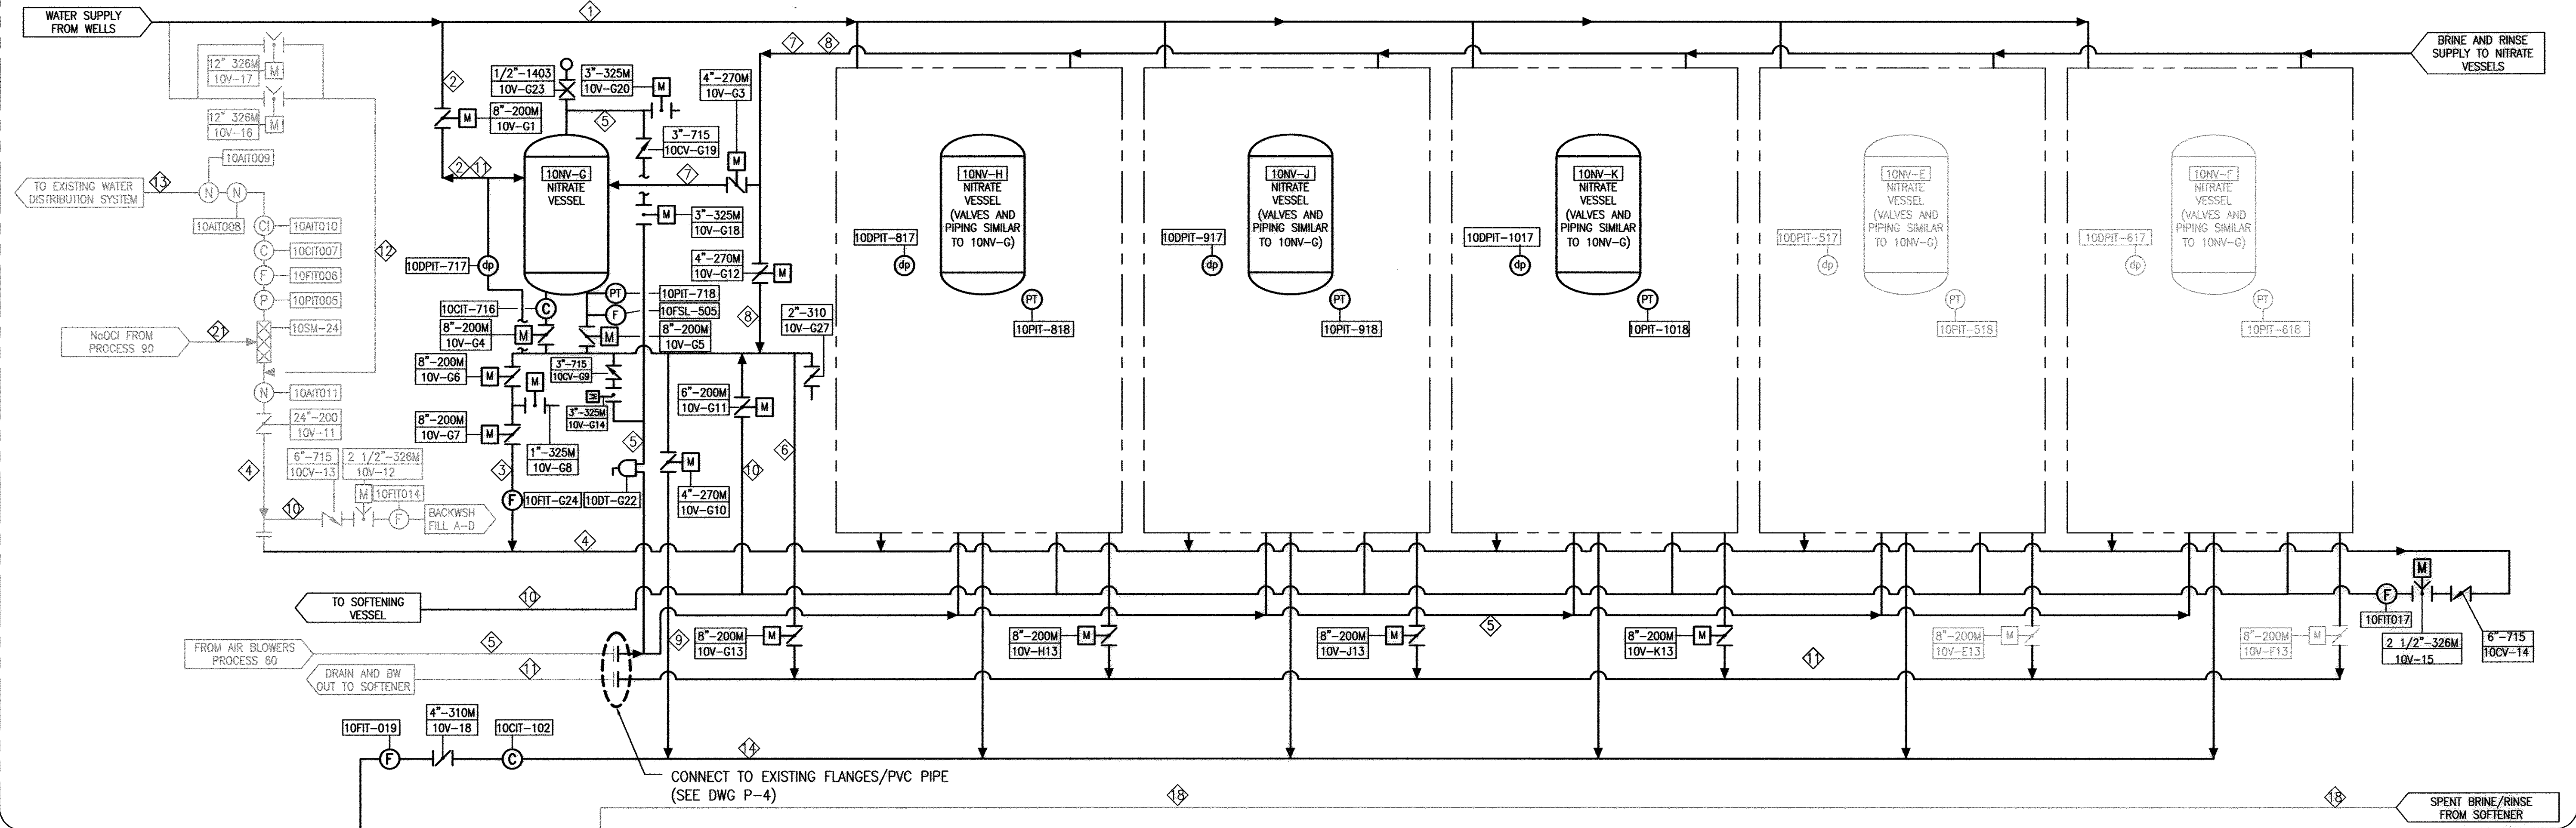

NOTE:
1. COORDINATE VALVE DESIGNATIONS TO MATCH VESSEL LETTER DESIGNATION (SIMILAR TO VESSEL "10NV-E")
2. VESSELS A-D (NOT SHOWN) WERE INSTALLED DURING PHASE I.

NOTE:
ALL MANUAL VALVES ARE NORMALLY OPEN, EXCEPT AS NOTED

VALVE IDENTIFICATION

VALVE TYPE, SEE SPEC. 15100
VALVE SIZE

TAG NUMBER DESCRIPTION

PROCESS
DESCRIPTION
SERIES
NUMBER

LEGEND

- (P) PRESSURE ELEMENT
- (FS) FLOW SWITCH
- (DP) DIFFERENTIAL PRESSURE ELEMENT
- (N) NITRATE ANALYZER
- (C) CONDUCTIVITY ELEMENT
- (CH) CHLORINE ANALYZER
- (F) FLOW METER
- (L) LEVEL ELEMENT
- (V) CHECK VALVE
- (K) DOUBLE SWING CHECK VALVE
- (|) BALL VALVE
- (V-PORT) V-PORT BALL VALVE
- (3-WAY) 3-WAY BALL VALVE
- (FCV) FLOW CONTROL VALVE
- (BV) BUTTERFLY VALVE
- (MA) MOTORIZED ACTUATOR
- (WS) WYE STRAINER
- (SM) STATIC MIXER
- (WT) WATER TRAP
- (HT) HYDROPNEUMATIC TANK

NOTE:

- 1. 6 & 8 UNDERGROUND PIPING FUSION BONDED EPOXY LINED & COATED STEEL PIPE.
- 2. 4" UNDERGROUND PIPING SHALL BE SCH. 80 PVC PIPE.

RECORD DRAWING

Date: 08-23-07

These record drawings apply only to those facilities constructed under the contract identified in the title block and have been prepared, in part, on the basis of information compiled and furnished by others. The Engineer/Architect will not be responsible for any errors or omissions which have been incorporated into this drawing as a result of the work by others.

	NITRATE REMOVAL VESSELS										BLENDING STATION			SOFTENERS													
LINE DESIGNATION	1	2	3	4	5	6	7	8	9	10	11	12	13	14	15	16	17	18	19	20	21	22	23	24	25	26	27
DESCRIPTION	WELL WATER	NITRATE VESSEL FEED	TREATED WATER	TREATED WATER COLLECTOR	AIR HEADER	DRAIN TO SOFTENER	BRINE SUPPLY	RINSE SUPPLY	SPENT BRINE/RINSE TO WASTE	BACKWASH & VESSEL FILL SUPPLY	DRAIN TO SOFTENER COLLECTION	WELL WATER TO BLENDING STATION	BLENDING FINISH WATER	SPENT BRINE/RINSE (E-K)	SOFTENED WATER	REGENERANT SUPPLY	RINSE SUPPLY	SPENT BRINE/RINSE (SOFTENER)	SOFTENER BACKWASH FEED	SPENT BACKWASH	NaOCl FEED	WASTEWATER TO SARI	BRINE SUPPLY TO PUMP STATION No. 1 AND 2	DILUENT SUPPLY TO PUMP STATION No. 1 AND 2	BRINE TO NaOCl GENERATOR	SOFT WATER TO NaOCl GENERATOR	RINSE TANK DRAIN TO RAW WATER
ORIGINAL FLOW (GPM)	8820	1103	1103	8594	151 ACFM	1000	200	200	200	340	340	VARIES 0 (MIN.)	8820	280	340-1000	200	200	200	340	340	33 gph	200	80-160	120-240	0.7	2.4	200
REVISED FLOW (GPM)	12,778	1600	1600	12,778	151 ACFM	1000	200	200	200	340	340	VARIES 0 (MIN.)	12,778	280	340-1000	200	200	200	340	340	48 gph	200	80-160	120-240	0.7	2.4	200
SIZE (INCHES)	24	8	8	24	4	8	4	4	4	6	8	24	24	4	8	4	4	4	6	8	1	4	6	6	1	1	4
MATERIAL	SCH. 10 SST	SCH. 10 SST	SCH. 10 SST	SCH. 10 SST	SCH. 10 SST	SCH. 10 SST	SCH. 80 PVC	SCH. 80 PVC	SCH. 80 PVC	SCH. 10 SST	SCH. 10 SST	FEC&L	FEC&L	SCH. 80 PVC	SCH. 10 SST	SCH. 80 PVC	SCH. 80 PVC	SCH. 80 PVC	SCH. 10 SST	SCH. 10 SST	SCH. 80 PVC	SCH. 80 PVC	SCH. 80 PVC	SCH. 80 PVC	SCH. 80 PVC	SCH. 80 PVC	SCH. 80 PVC

*DO NOT PAINT OR COAT STAINLESS STEEL PIPE


VERIFY SCALES
BAR IS ONE INCH ON ORIGINAL DRAWING
0 1
IF NOT ONE INCH ON THIS SHEET, ADJUST SCALES ACCORDINGLY

APPROVAL:	DATE:	DESIGN BY:	DATE:	2/27/06	ADDENDUM 2
APPROVAL:	DATE:	DRAWN BY:	DATE:		
APPROVAL:	DATE:	CHECKED BY:	DATE:		
APPROVAL:	DATE:	DATE:	DATE:	AUGUST 2005	

BOYLE ENGINEERING CORPORATION

JURUPA COMMUNITY SERVICES DISTRICT
ION EXCHANGE WATER TREATMENT PLANT - PHASE III
PROCESS FLOW DIAGRAM
1 OF 2

DRAWING NO: P-1
SHEET NO: 2
OF 48 SHEETS
FILE NO: S-2268

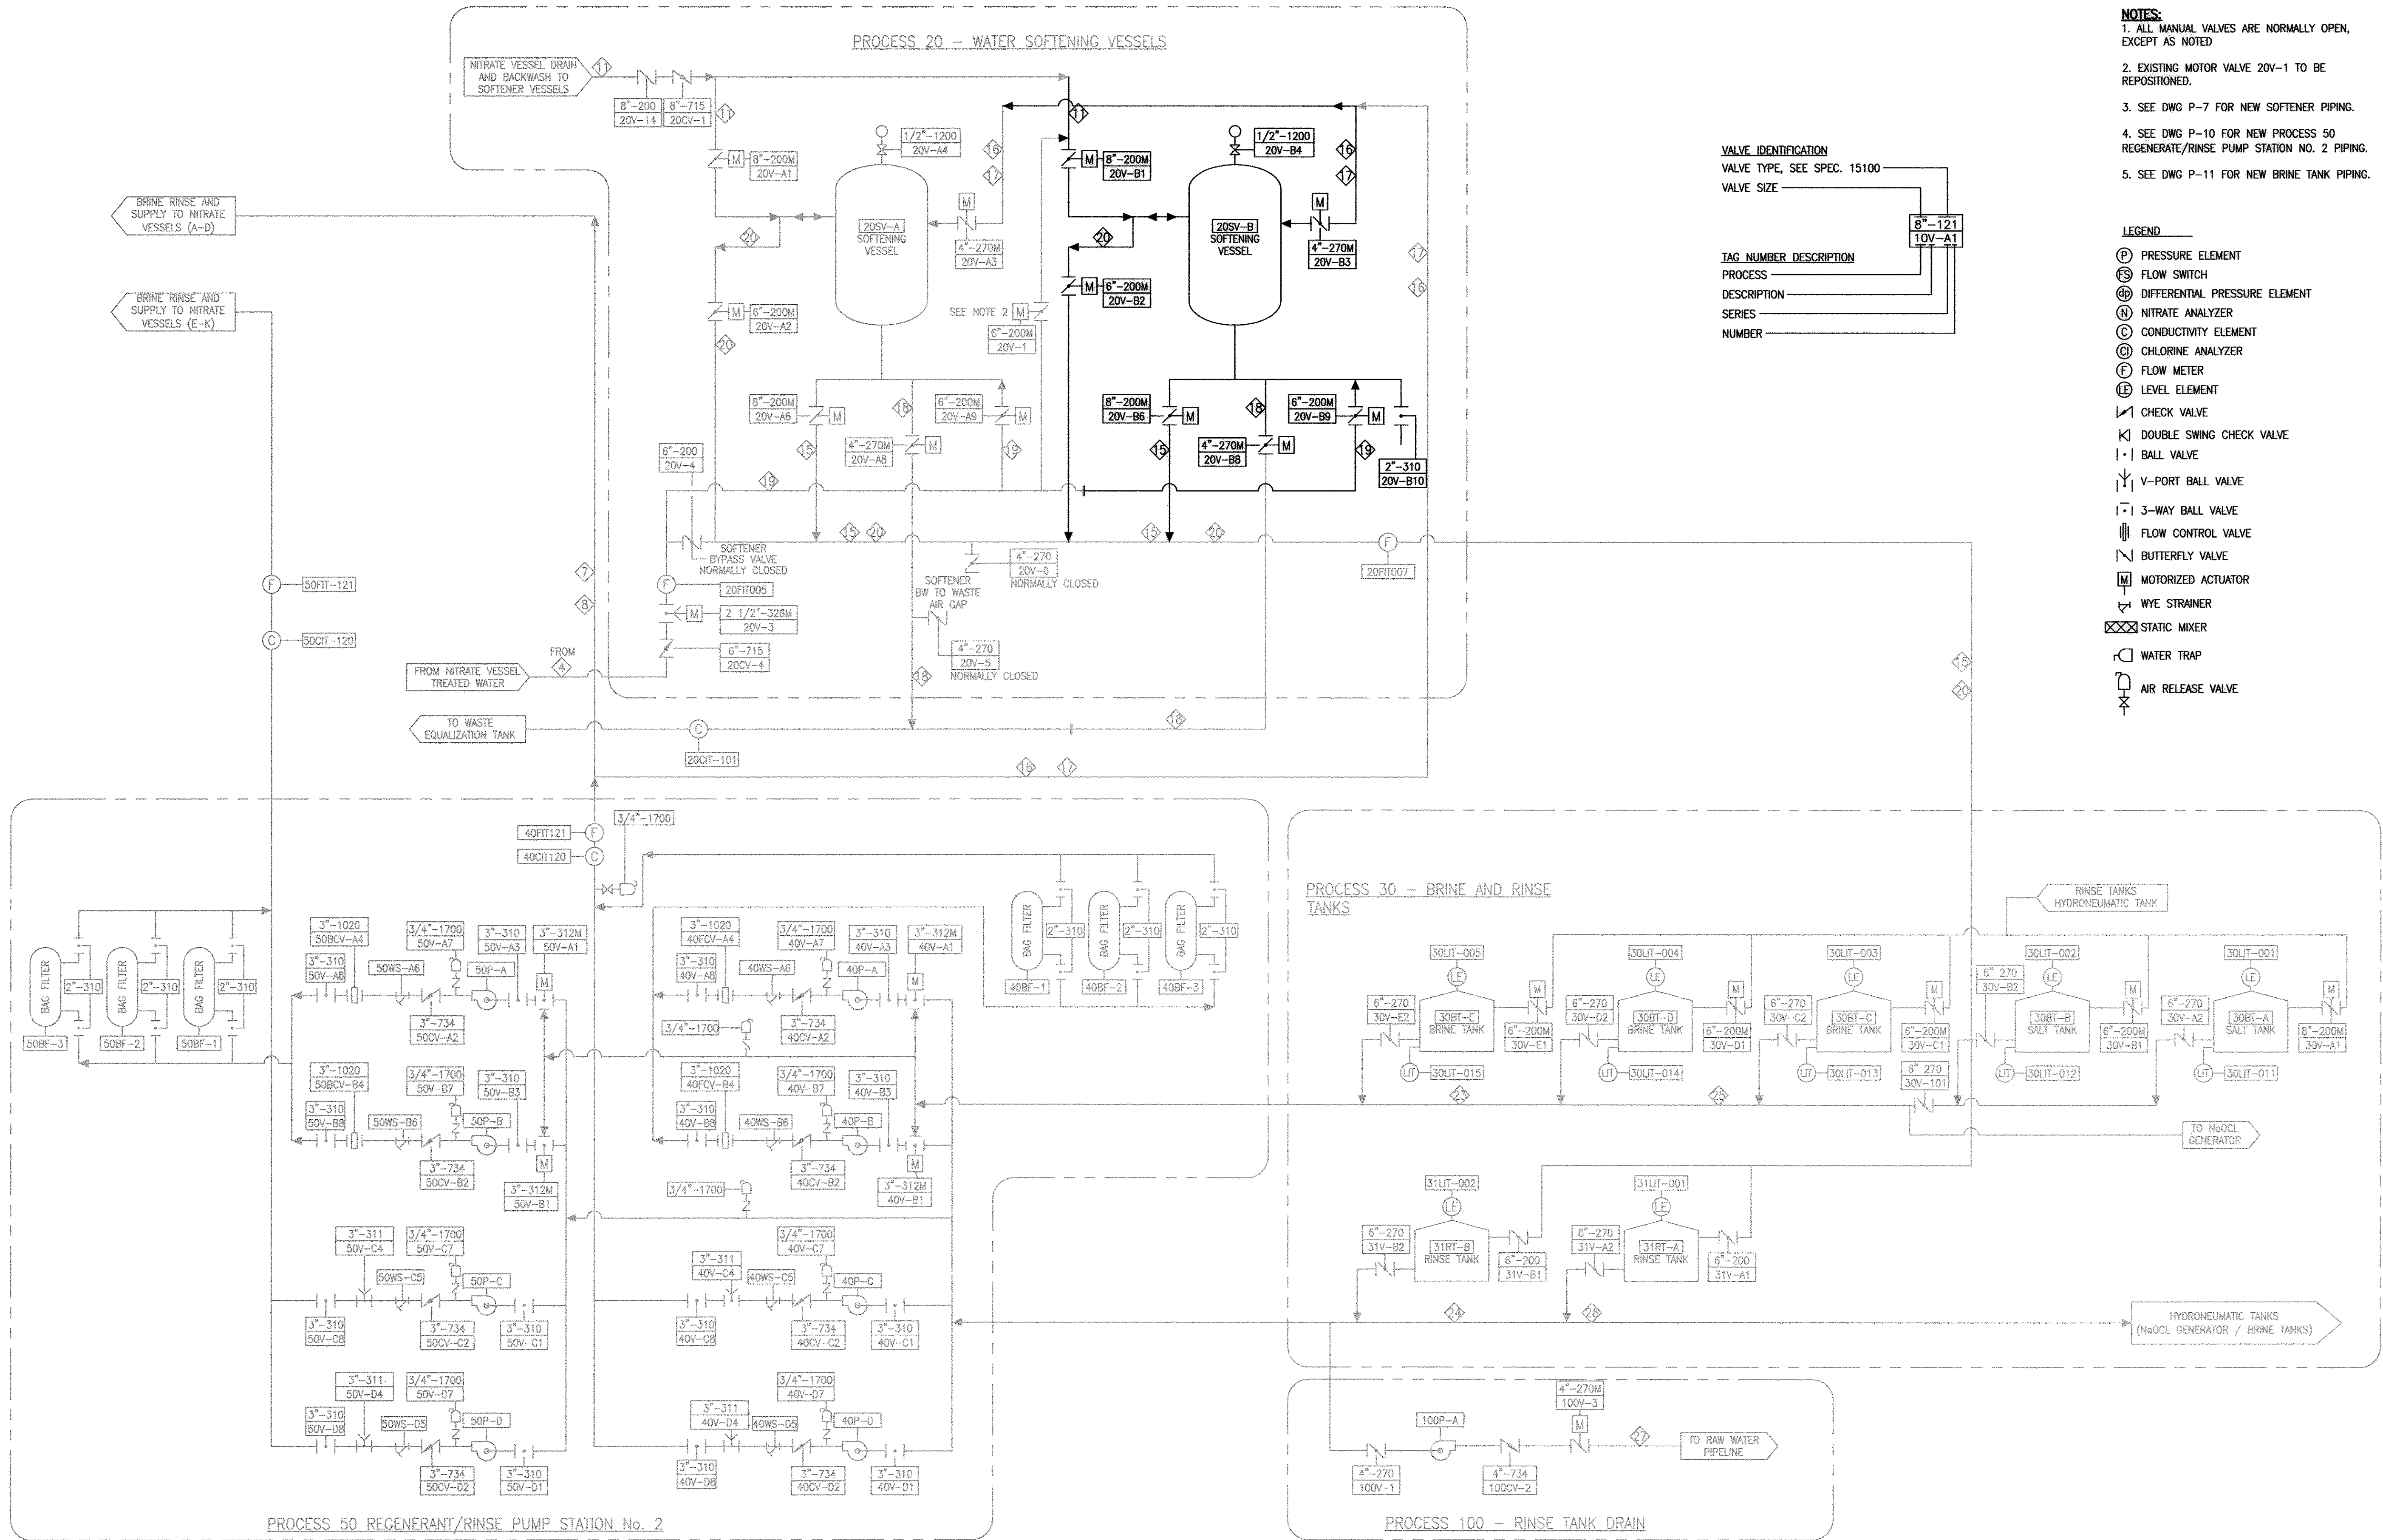

DWG: S:\04\100-04\040\Phase III\PlatSet\2268-P2.dwg
DATE: Nov 08, 2007 2:00pm
USER: leedford
XREFS: 2268DR

VERIFY SCALES
BAR IS ONE INCH ON ORIGINAL DRAWING
0 1
IF NOT ONE INCH ON THIS SHEET,
ADJUST SCALES ACCORDINGLY


APPROVAL: _____
DATE: _____
DESIGN BY: CJM
DRAWN BY: DTG
CHECKED BY: _____
DATE: AUGUST 2005

2/27/06 ADDENDUM 2
3/1/07 CHANGE ORDER 1.2
REV DATE DESCRIPTION APP


BOYLE ENGINEERING CORPORATION

JURUPA COMMUNITY SERVICES DISTRICT
ION EXCHANGE WATER TREATMENT PLANT - PHASE III
PROCESS FLOW DIAGRAM
2 OF 2

DRAWING NO: _____ SHEET NO: _____
P-2 3
OF 48 SHEETS
FILE NO: _____ S-2268

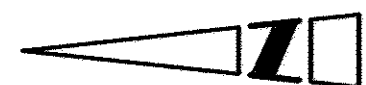

SCALE: 1/8" = 1'-0"

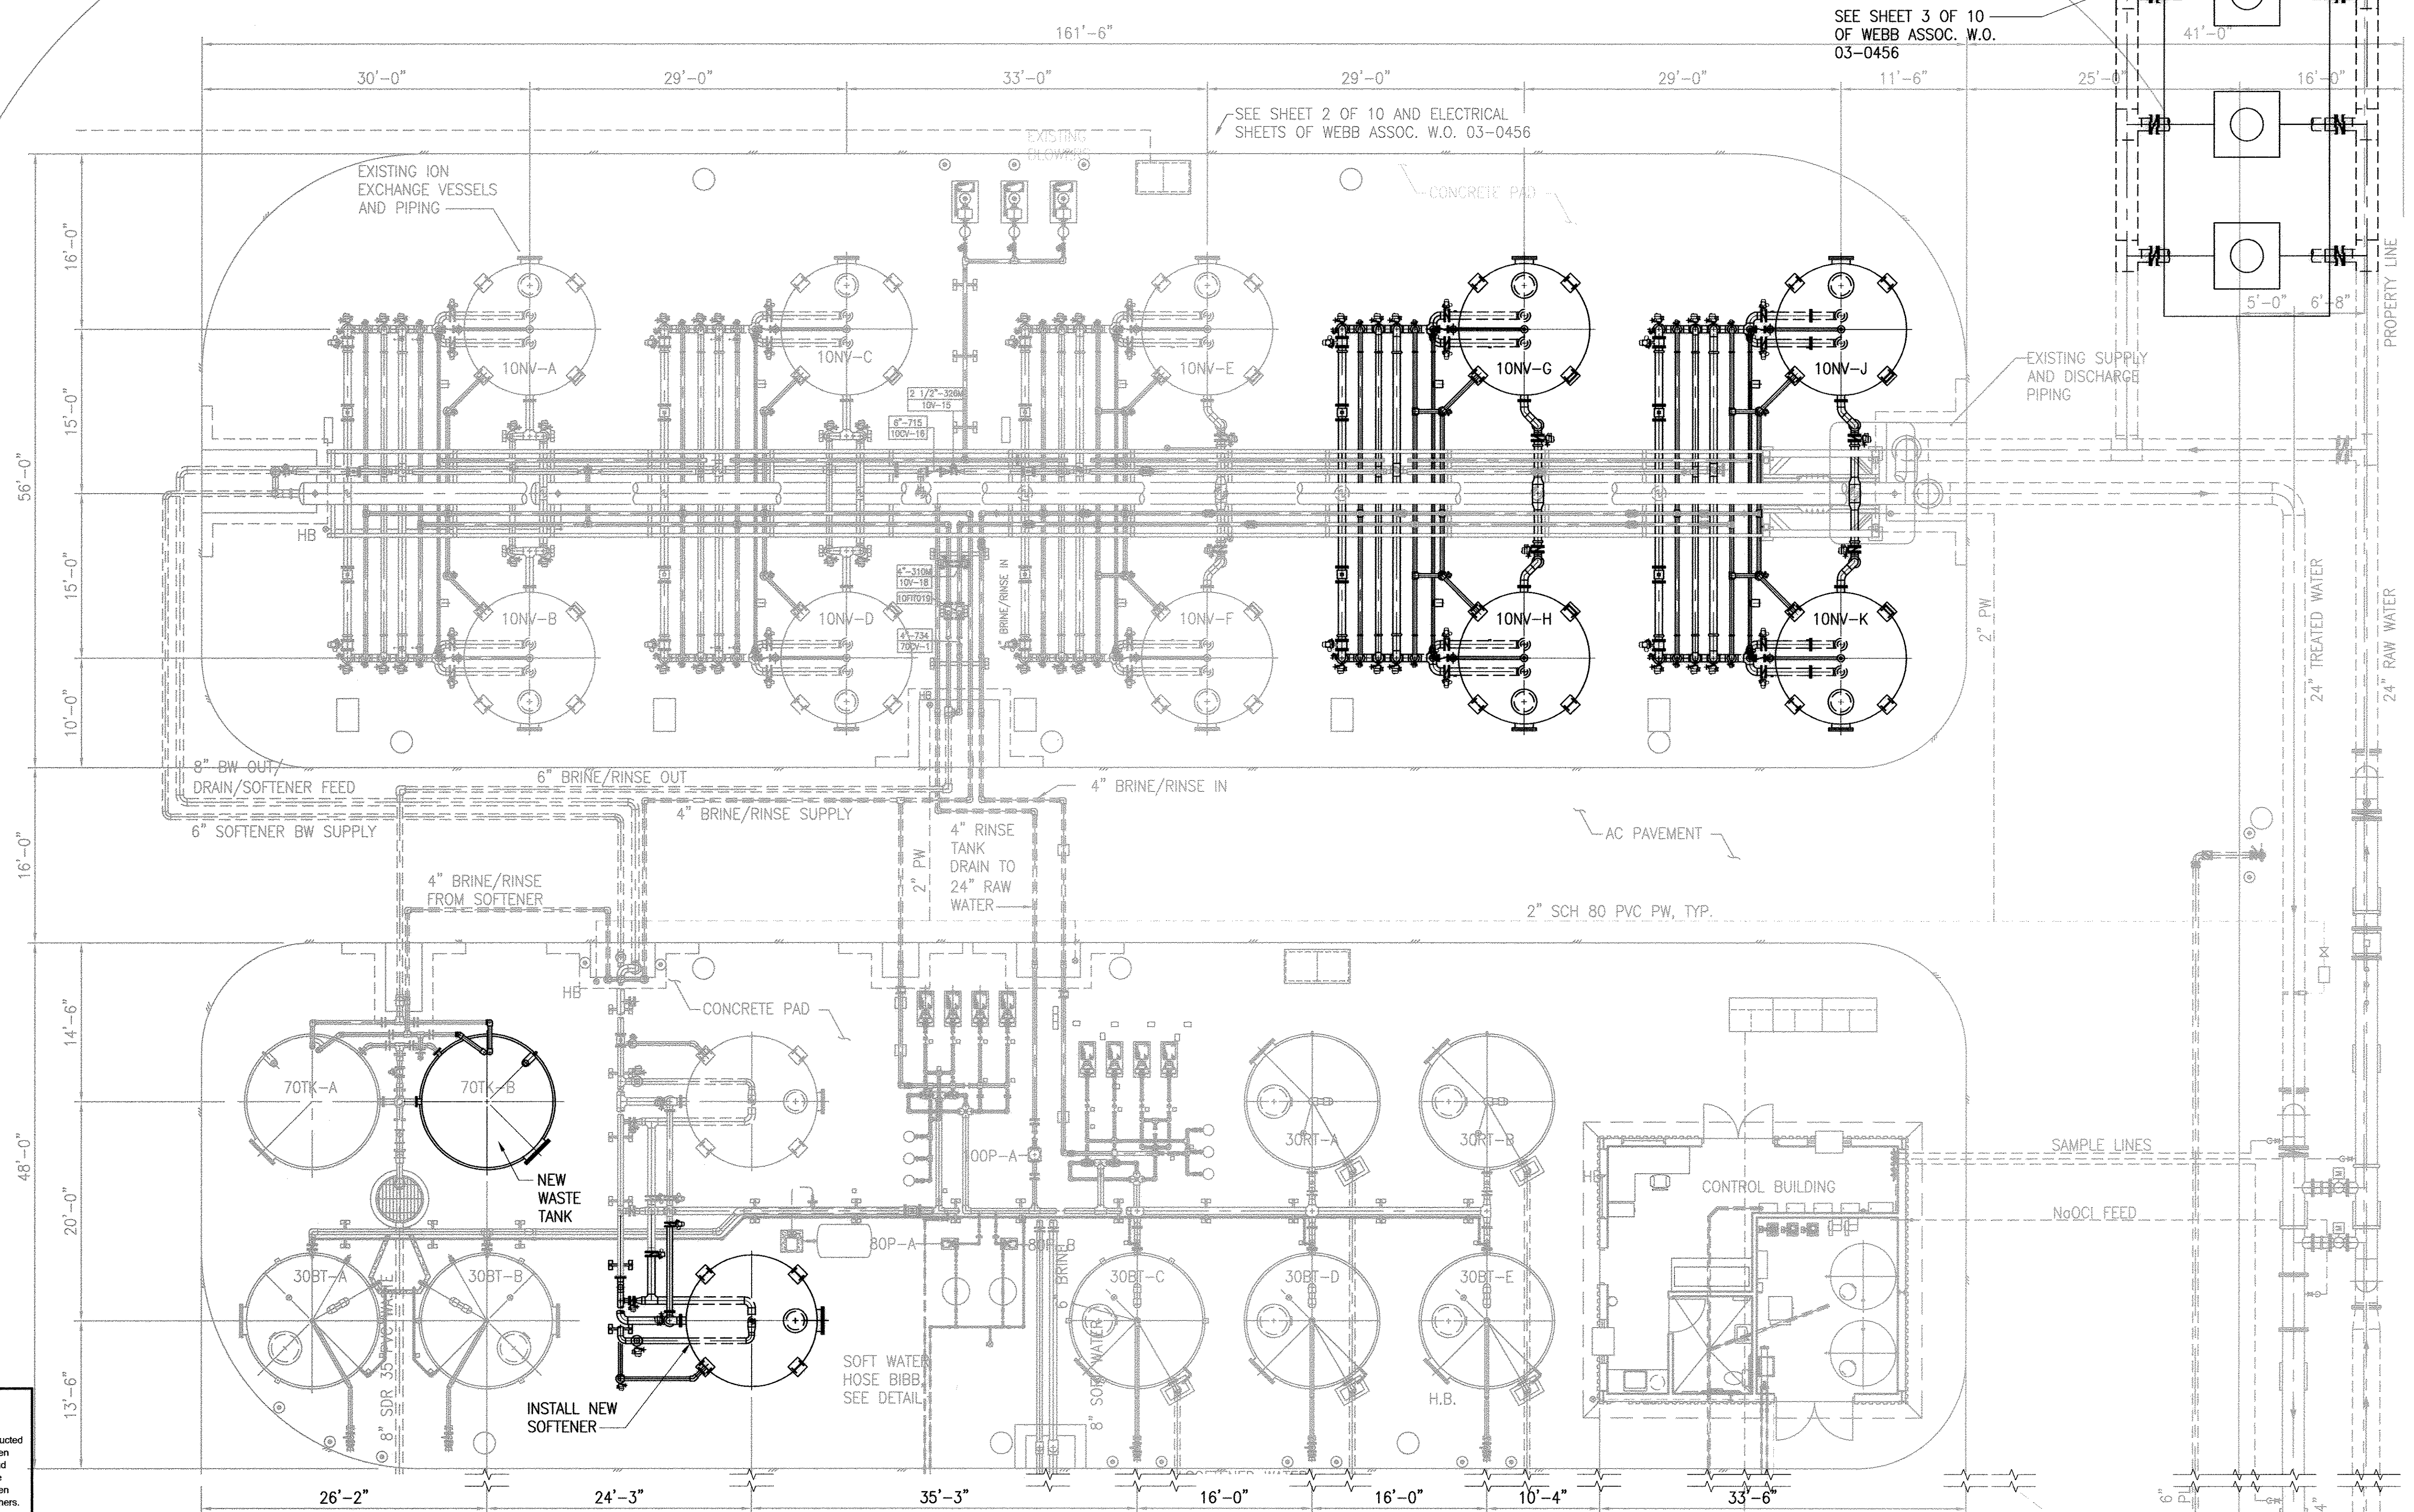

RECORD DRAWING

Date: 08-23-07

These record drawings apply only to those facilities constructed under the contract identified in the title block and have been prepared, in part, on the basis of information compiled and furnished by others. The Engineer/Architect will not be responsible for any errors or omissions which have been incorporated into this drawing as a result of the work by others.

VERIFY SCALES

BAR IS ONE INCH ON ORIGINAL DRAWING
0 1

IF NOT ONE INCH ON THIS SHEET,
ADJUST SCALES ACCORDINGLY

APPROVAL:

DATE:

DESIGN BY: CJM

DATE:

CHECKED BY: VENE

DATE:

AUGUST 2005

REV

DATE

DESCRIPTION

APP

BOYLE ENGINEERING CORPORATION

JURUPA COMMUNITY SERVICES DISTRICT

ION EXCHANGE WATER TREATMENT PLANT - PHASE III

PLANT LAYOUT

DRAWING NO:

SHEET NO:


P-3

4

FILE NO:

OF 48 SHEETS



S-2268

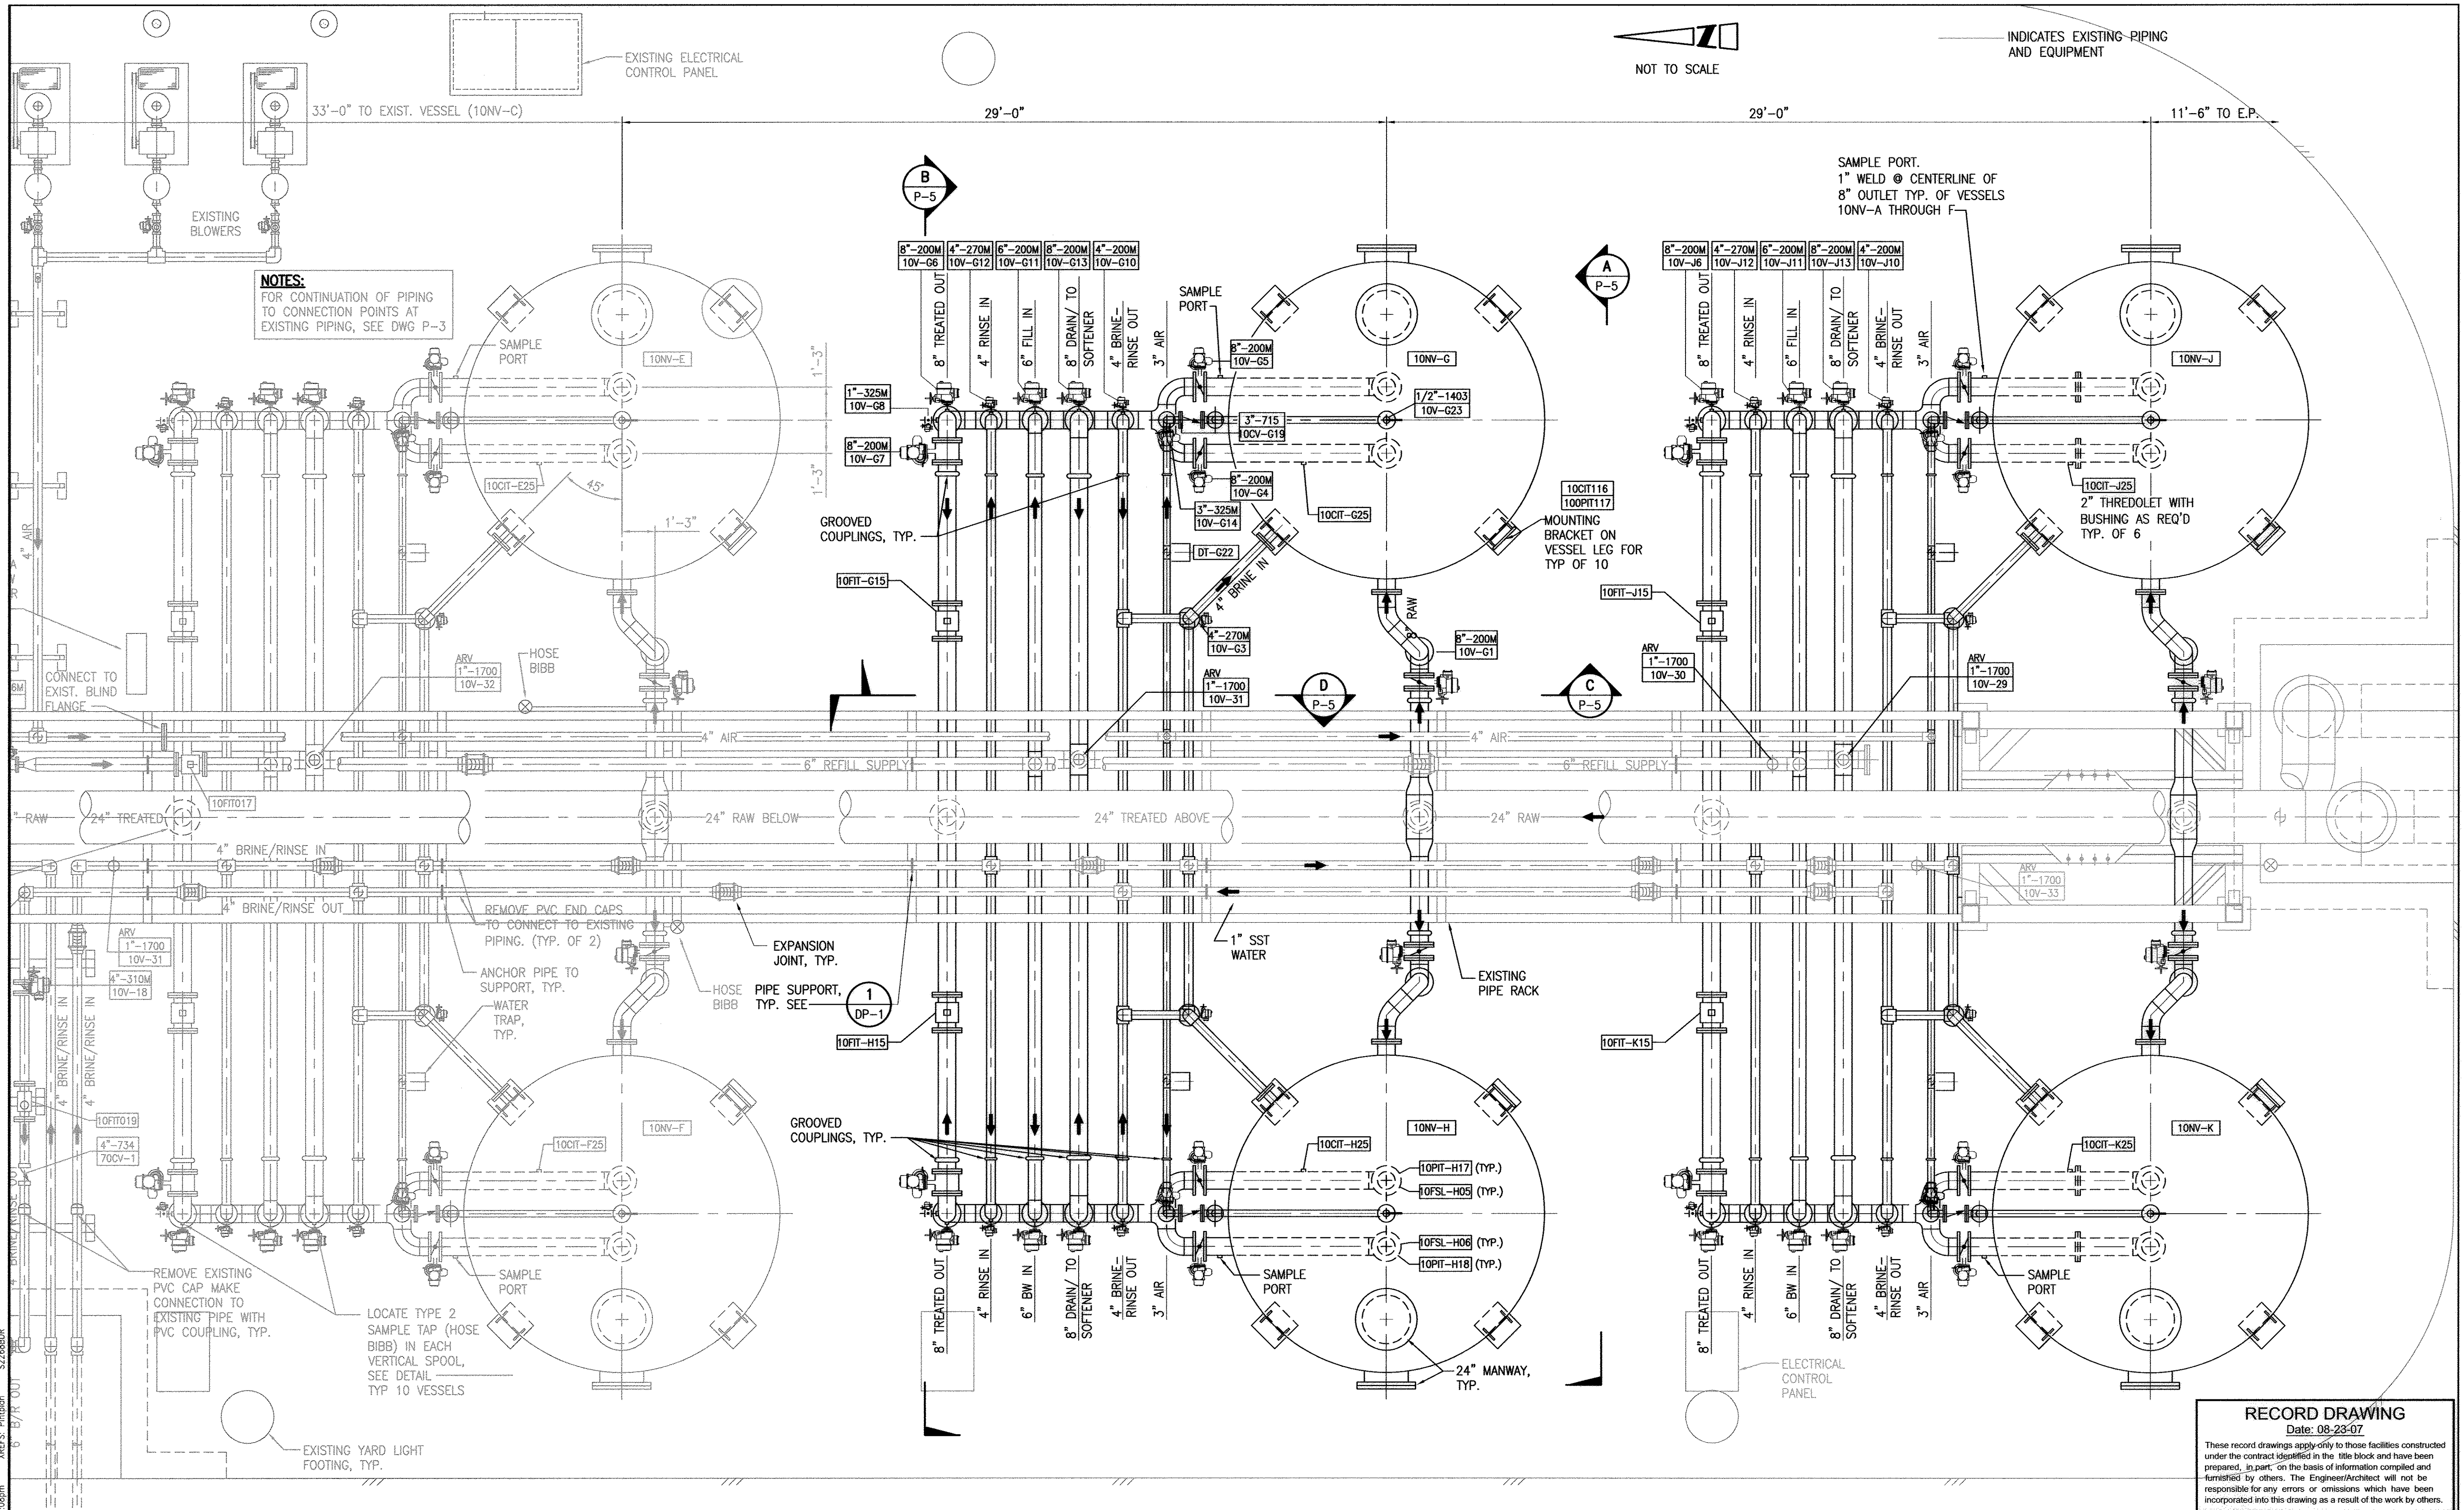

NOTES:
FOR CONTINUATION OF PIPING
TO CONNECTION POINTS AT
EXISTING PIPING, SEE DWG P-3

RECORD DRAWING
Date: 08-23-07
These record drawings apply only to those facilities constructed
under the contract identified in the title block and have been
prepared, in part, on the basis of information compiled and
furnished by others. The Engineer/Architect will not be
responsible for any errors or omissions which have been
incorporated into this drawing as a result of the work by others.

DWG: S:\JUA\100-04-CAD (Process)\JUA\2268-P5.dwg
DATE: Nov 08, 2007 2:10pm
USER: baedford

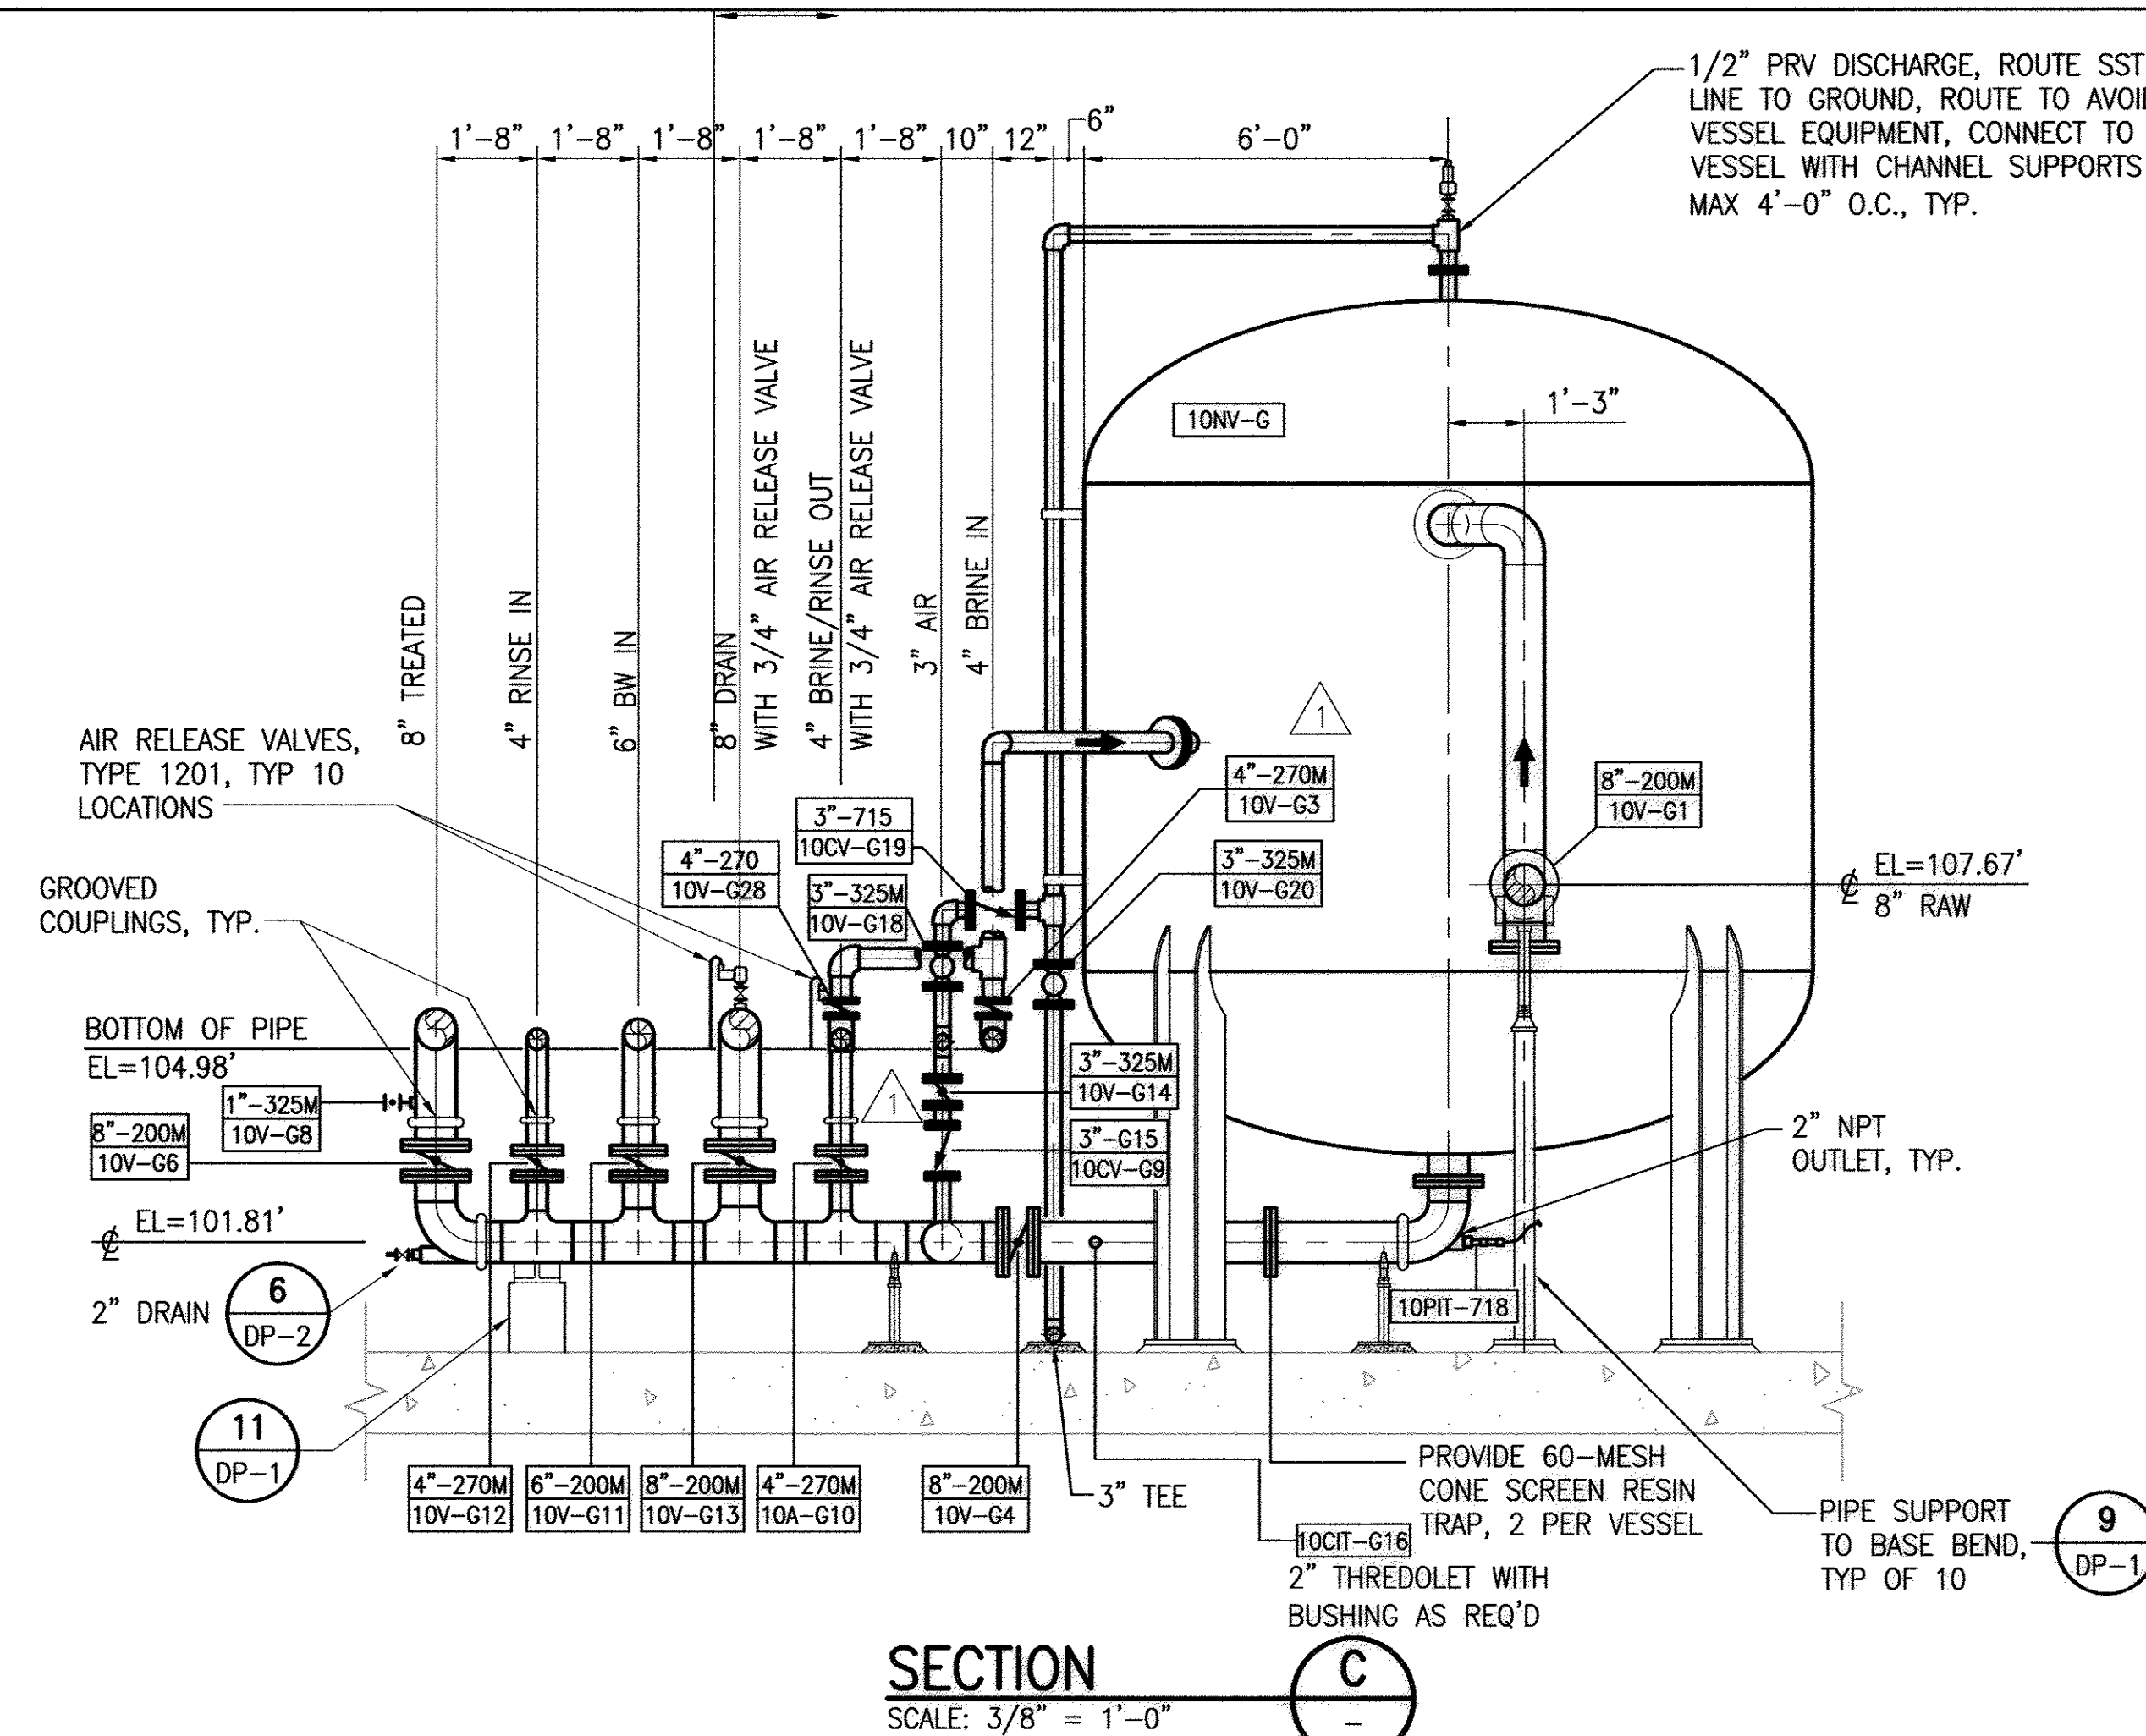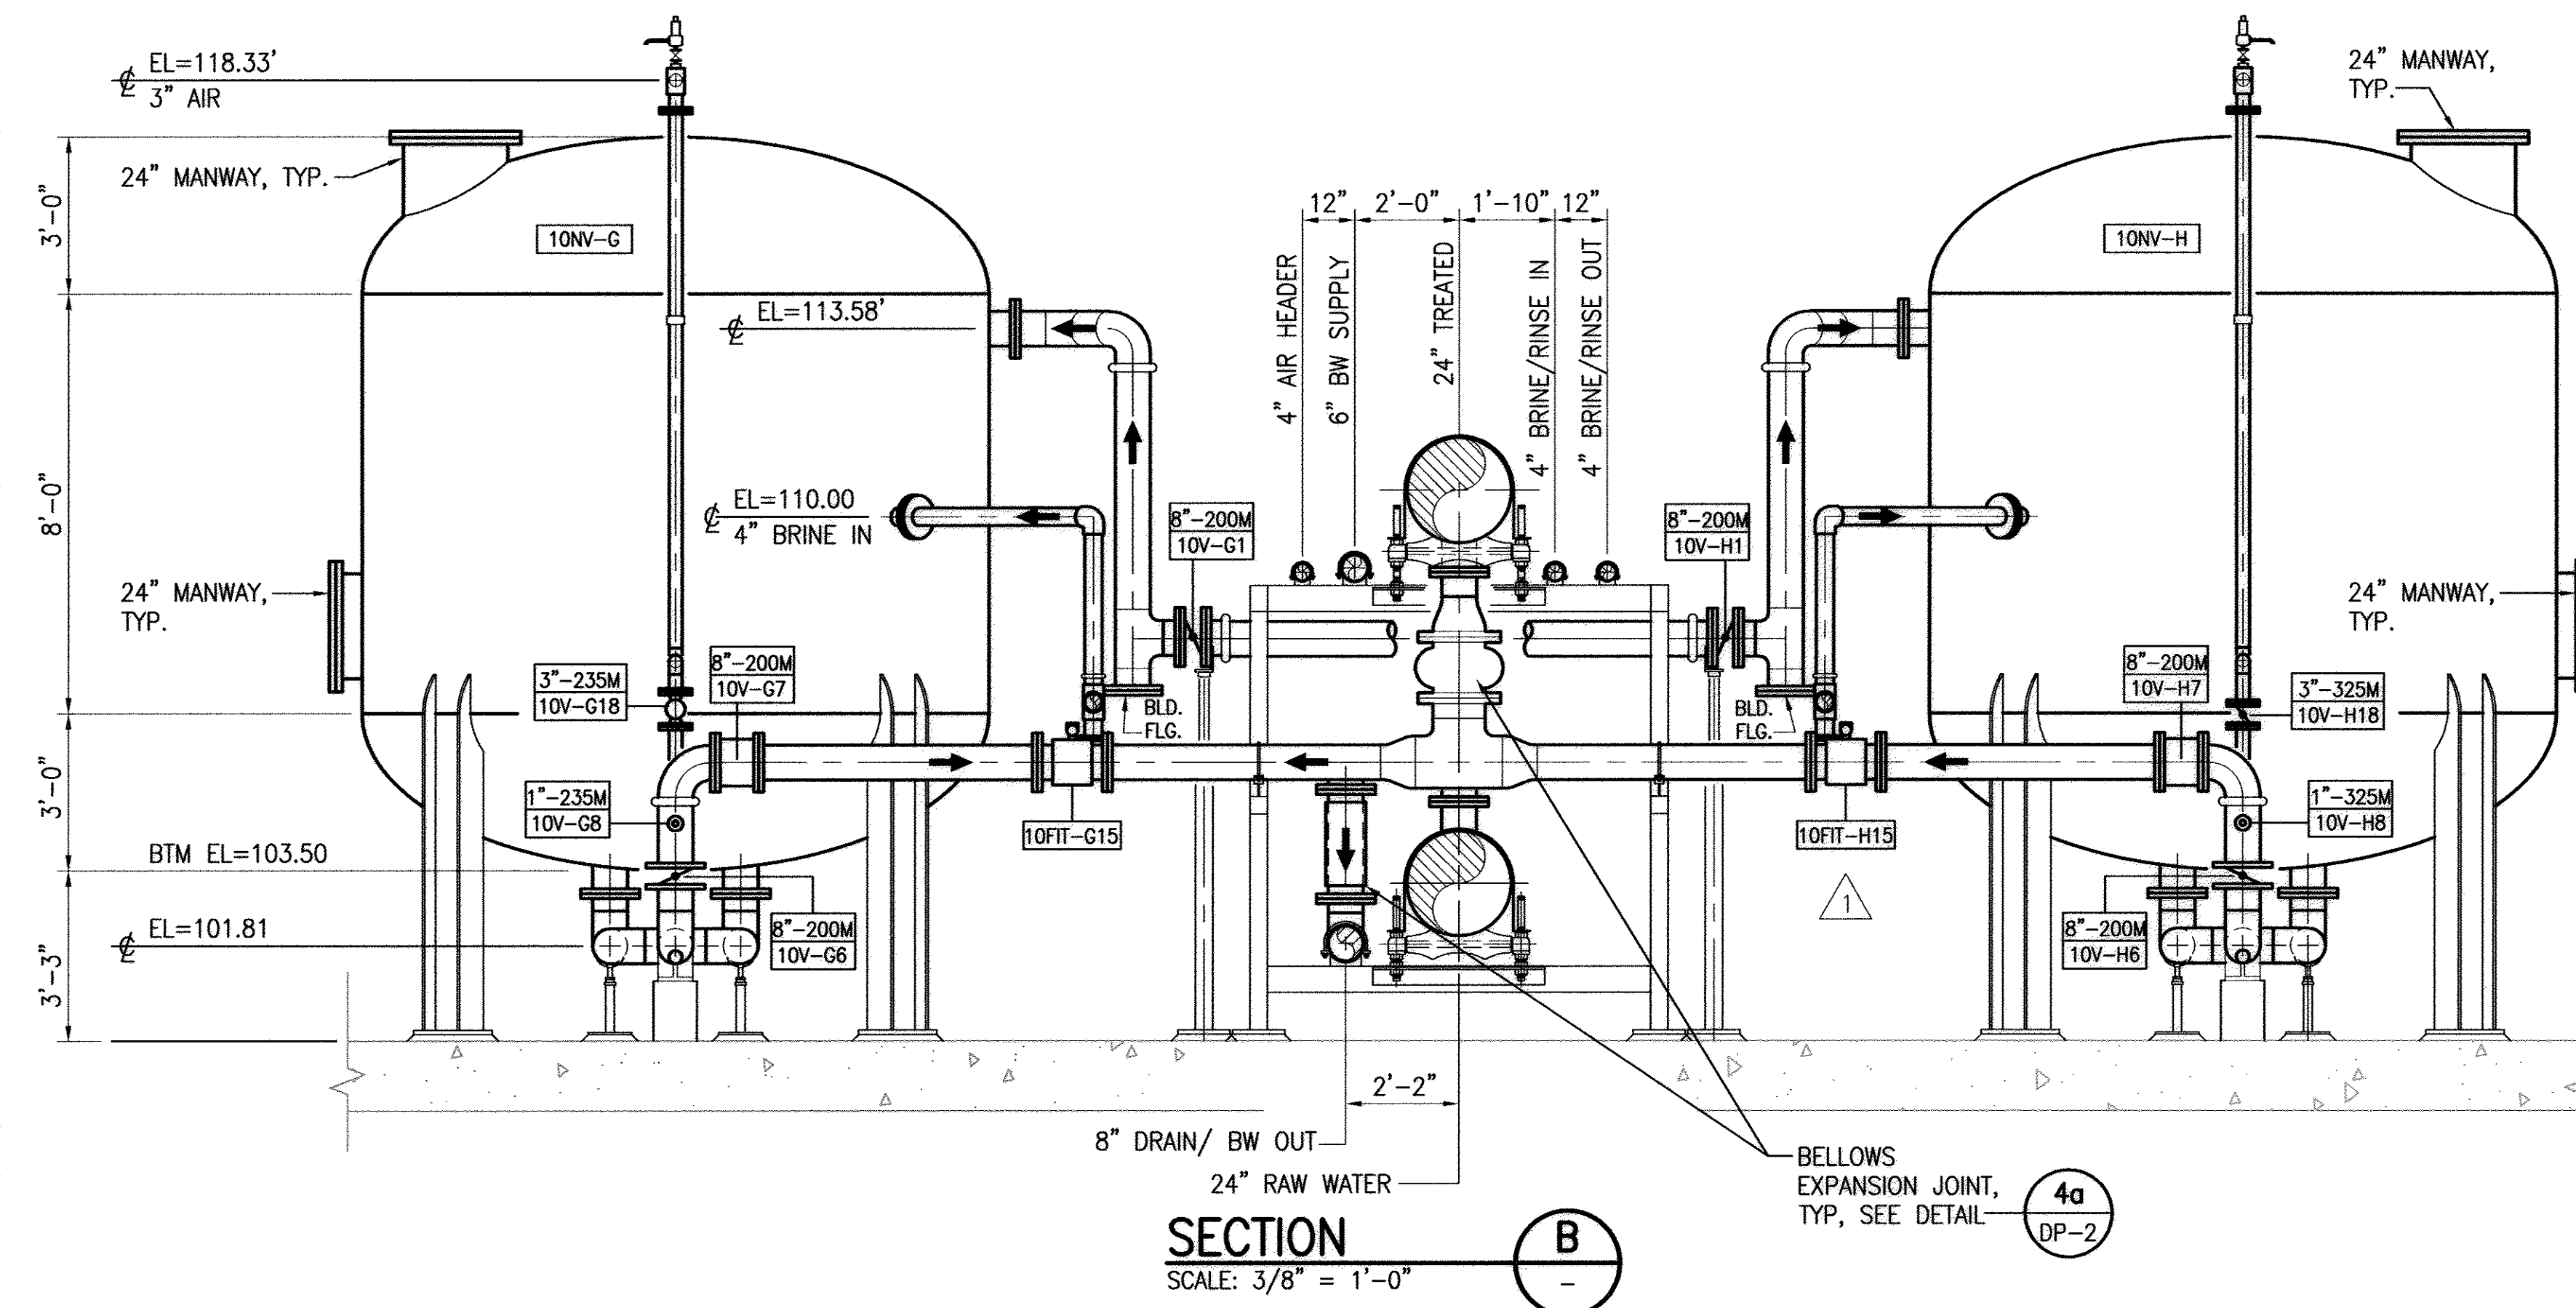


RECORD DRAWING
Date: 08-23-07
These record drawings apply only to those facilities constructed under the contract identified in the title block and have been prepared, in part, on the basis of information compiled and furnished by others. The Engineer/Architect will not be responsible for any errors or omissions which have been incorporated into this drawing as a result of the work by others.

VERIFY SCALES BAR IS ONE INCH ON ORIGINAL DRAWING 0 1 IF NOT ONE INCH ON THIS SHEET, ADJUST SCALES ACCORDINGLY	APPROVAL: DATE: APPROVAL: DATE:	DESIGN BY: CJM DATE: 2/27/06 CHECKED BY: DTG DATE: AUGUST 2005	1 2/27/06 ADDENDUM 2	REV DATE DESCRIPTION APP
--	--	---	----------------------------	-----------------------------------

BOYLE ENGINEERING CORPORATION

JURUPA COMMUNITY SERVICES DISTRICT
ION EXCHANGE WATER TREATMENT PLANT - PHASE III
IX NITRATE REMOVAL VESSEL SECTIONS

DRAWING NO: P-5
SHEET NO: 6
OF 48 SHEETS
FILE NO: S-2268

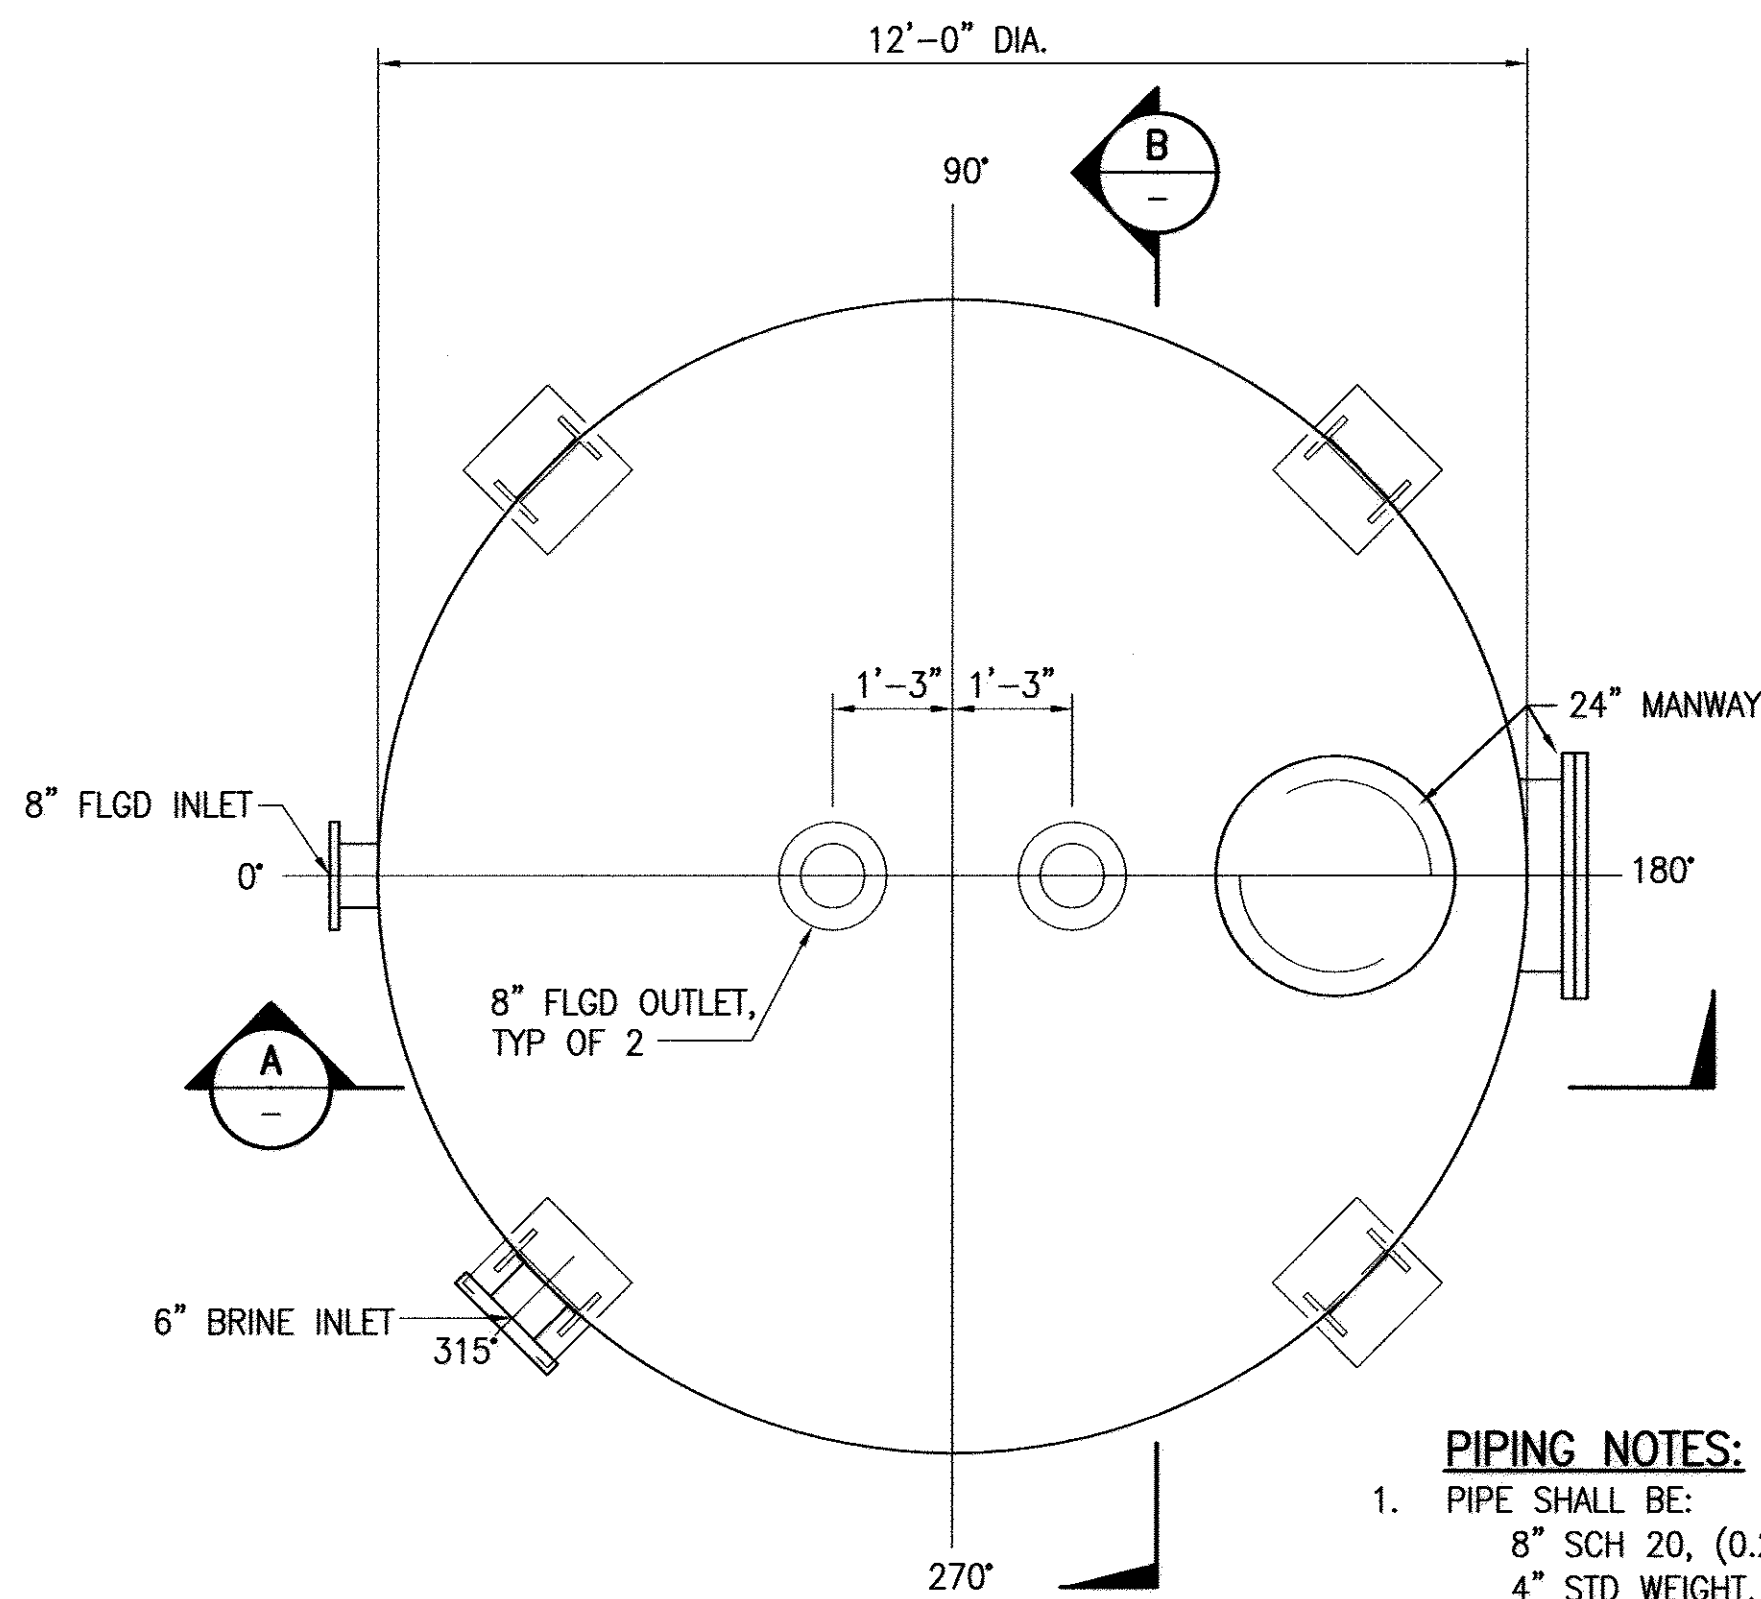


VESSEL PLAN

SCALE: 1/2" = 1'-0"
TYPICAL PLAN FOR VESSELS:
10NV-A,C,E,G & J,
MIRROR IMAGE FOR VESSELS:
10NV-B,D,F,H & K

1
-

PIPING NOTES:


- PIPE SHALL BE:
8" SCH 20, (0.250" WALL)
4" STD WEIGHT, (.237" WALL)
- FITTINGS SHALL BE:
8" LIGHT WEIGHT, (0.219" WALL)
4" STD WEIGHT, (.237" WALL)
- FLANGES SHALL BE:
8" STD WEIGHT, (CLASS 150)
4" LIGHT WEIGHT
- ALL STEEL PIPE AND FITTINGS SHALL BE FUSION EPOXY LINED AND COATED. PRIOR TO INSTALLATION.
- ALL DAMAGED AREAS OR EXPOSED METAL SHALL BE COATED WITH EPOXY PAINT AFTER INSTALLATION.

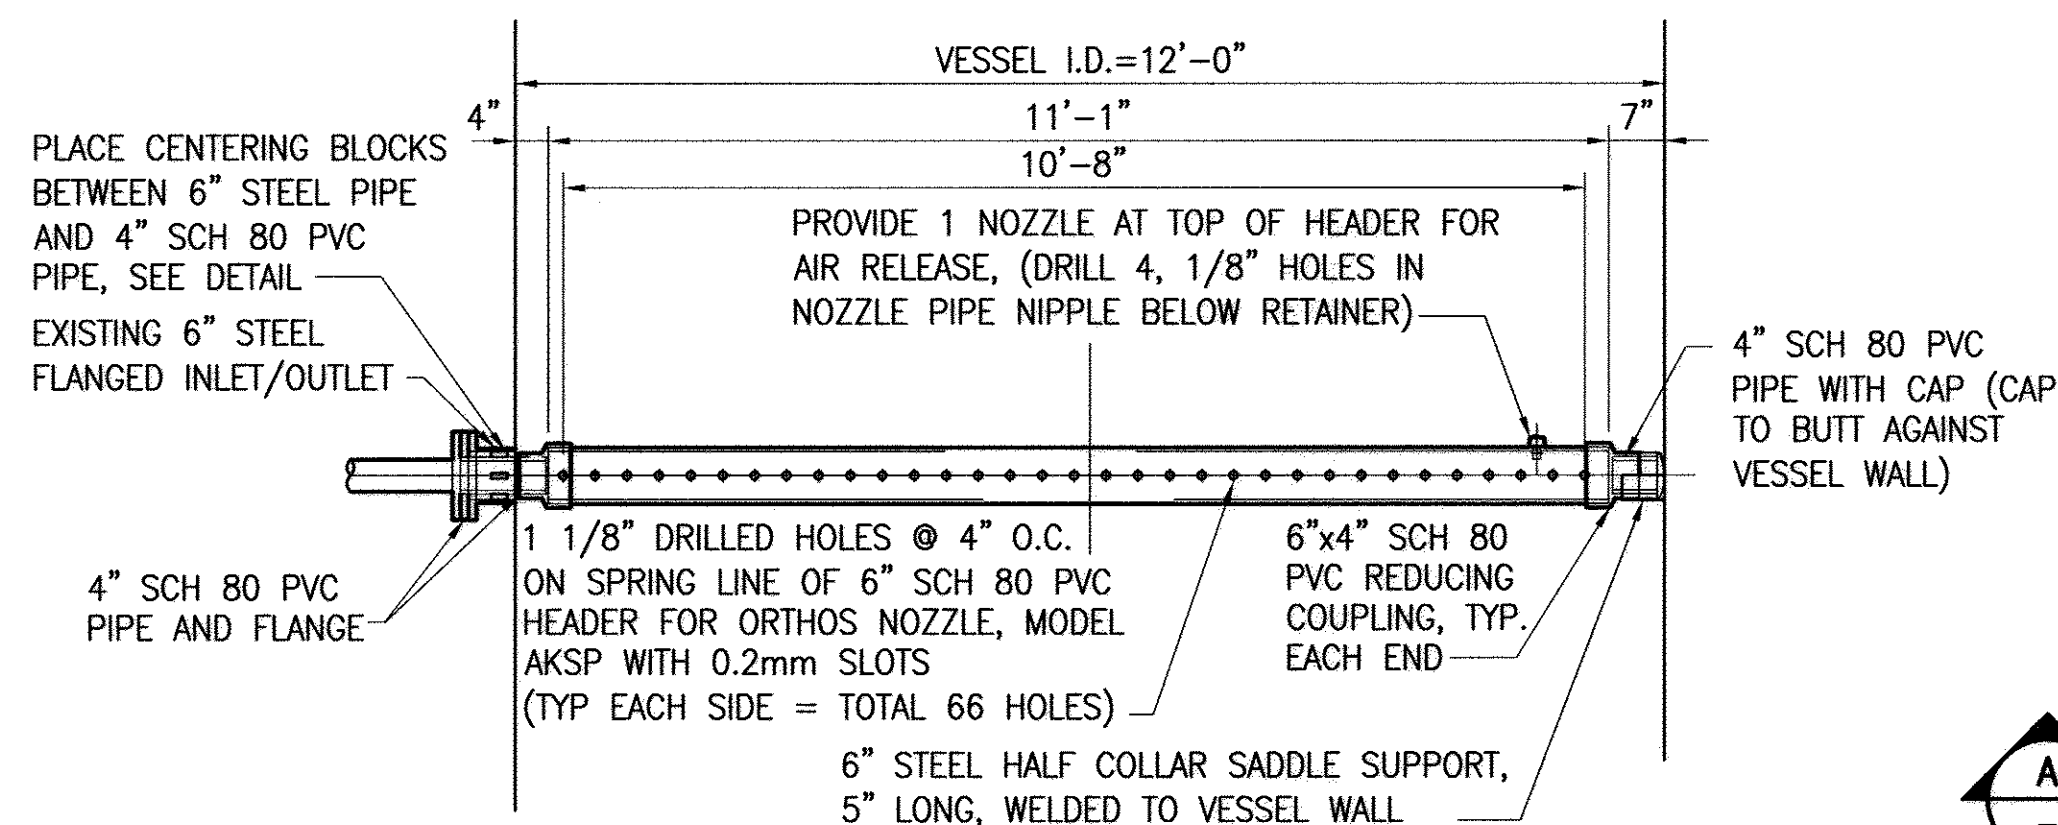

BRINE HEADER

NOTE:

- ALL DIMENSIONS SHALL BE FIELD VERIFIED.
- 4" PVC PIPE TO PENETRATE REDUCING COUPLINGS A MINIMUM OF 2-INCHES. (DO NOT SOLVENT WELD)

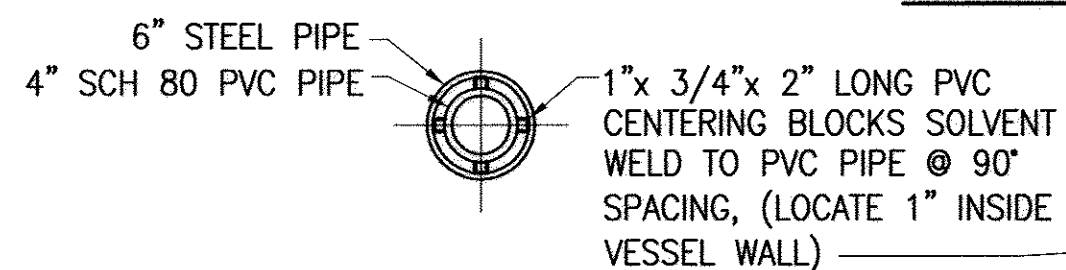


CENTERING BLOCKS

DETAIL

SCALE: 1/2" = 1'-0"


2
-

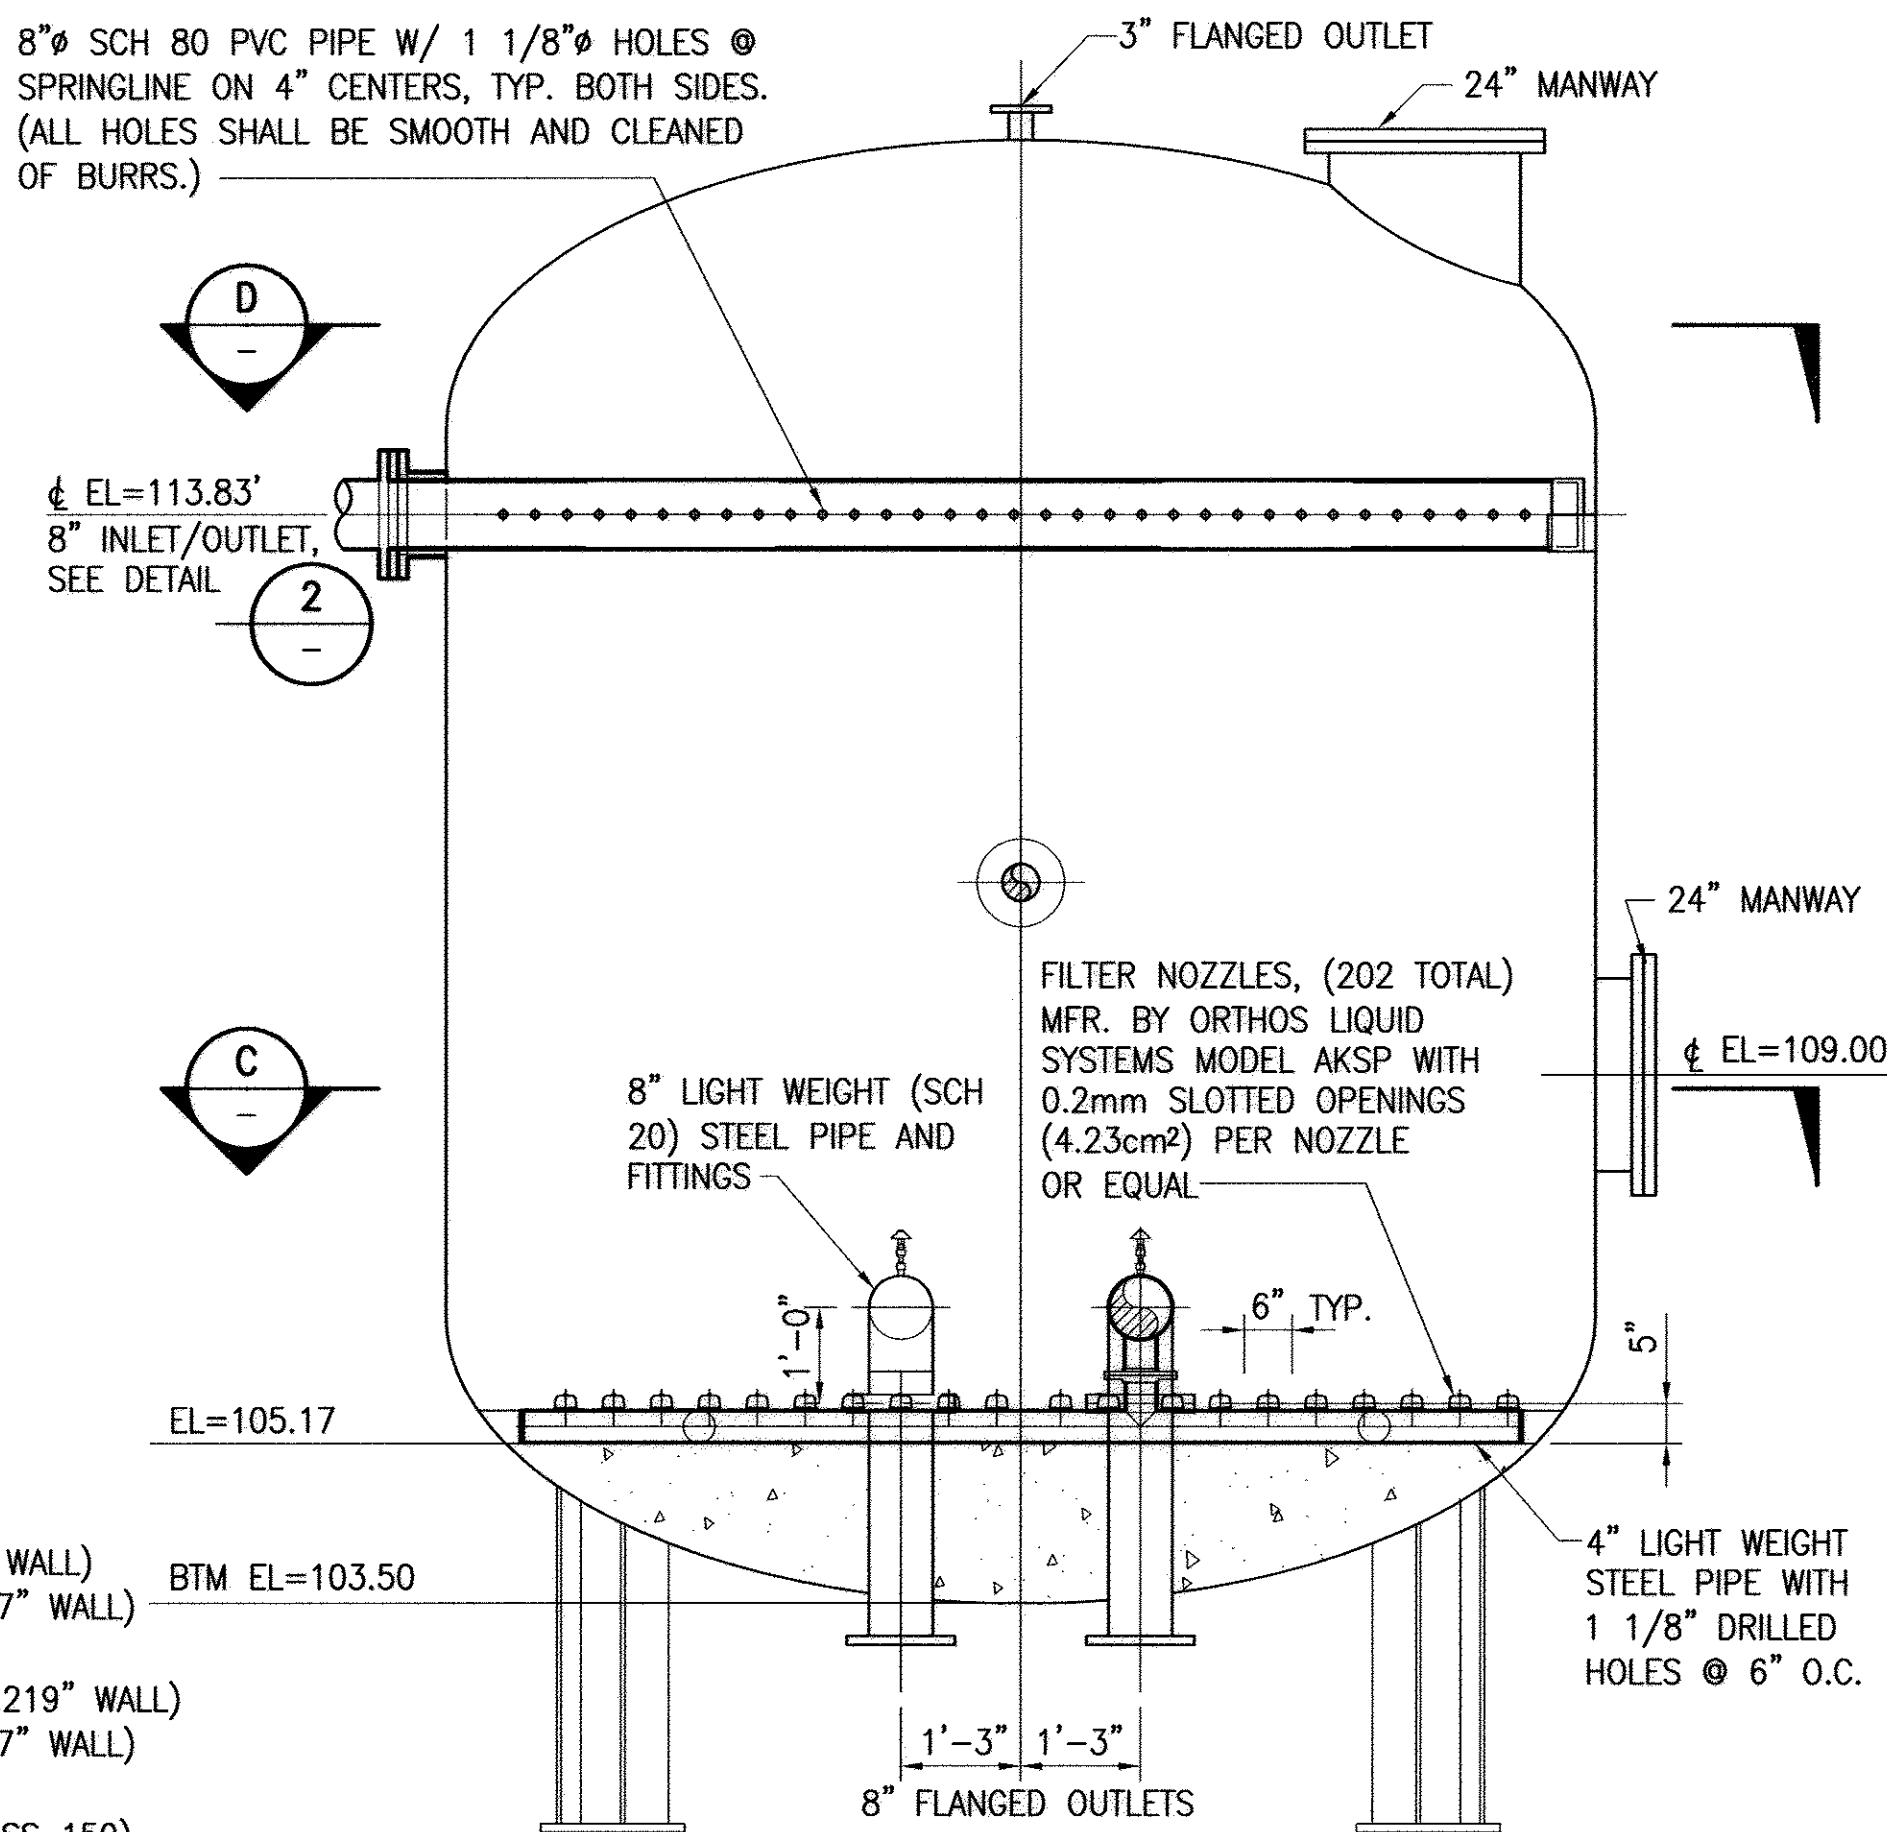

VESSEL SECTION

SCALE: 1/2" = 1'-0"


A
-

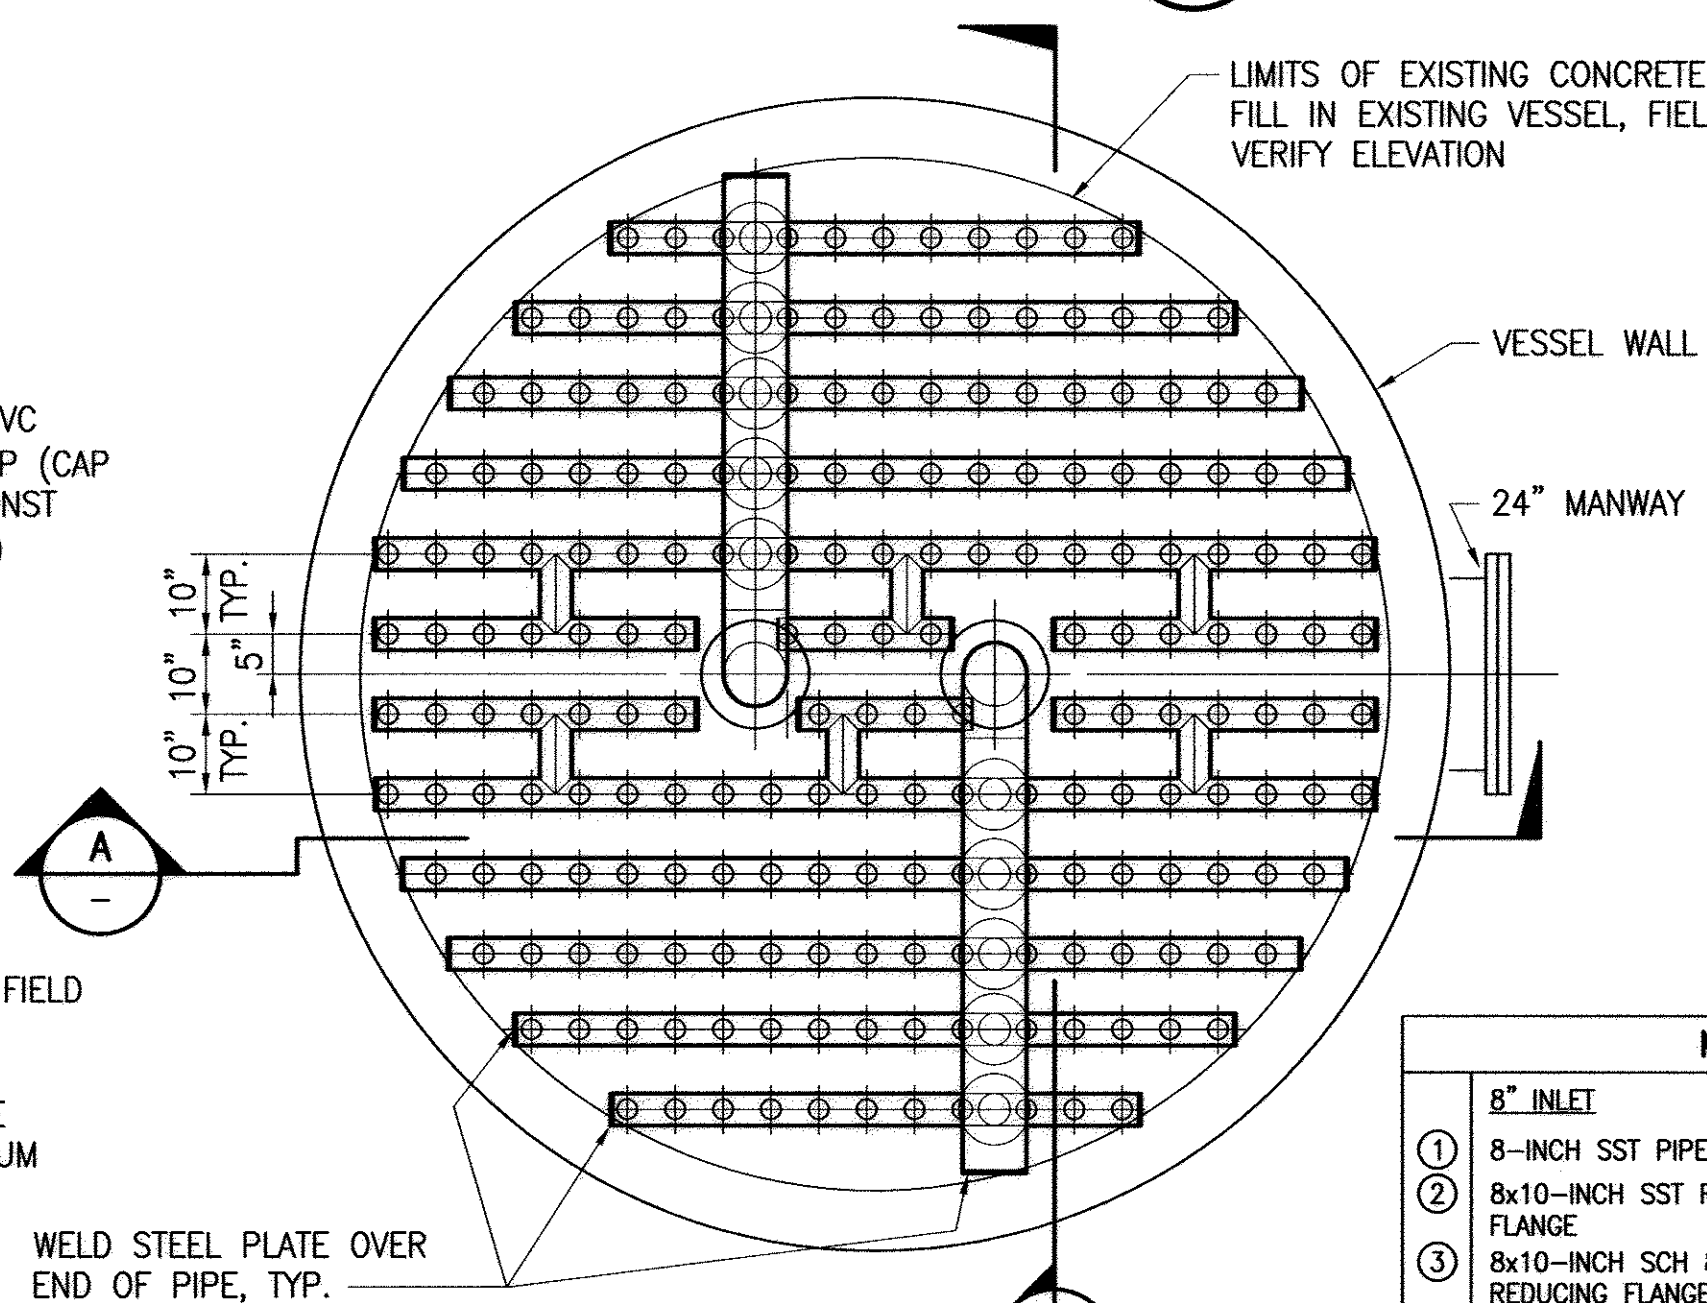

VESSEL SECTION

SCALE: 1/2" = 1'-0"


C
-

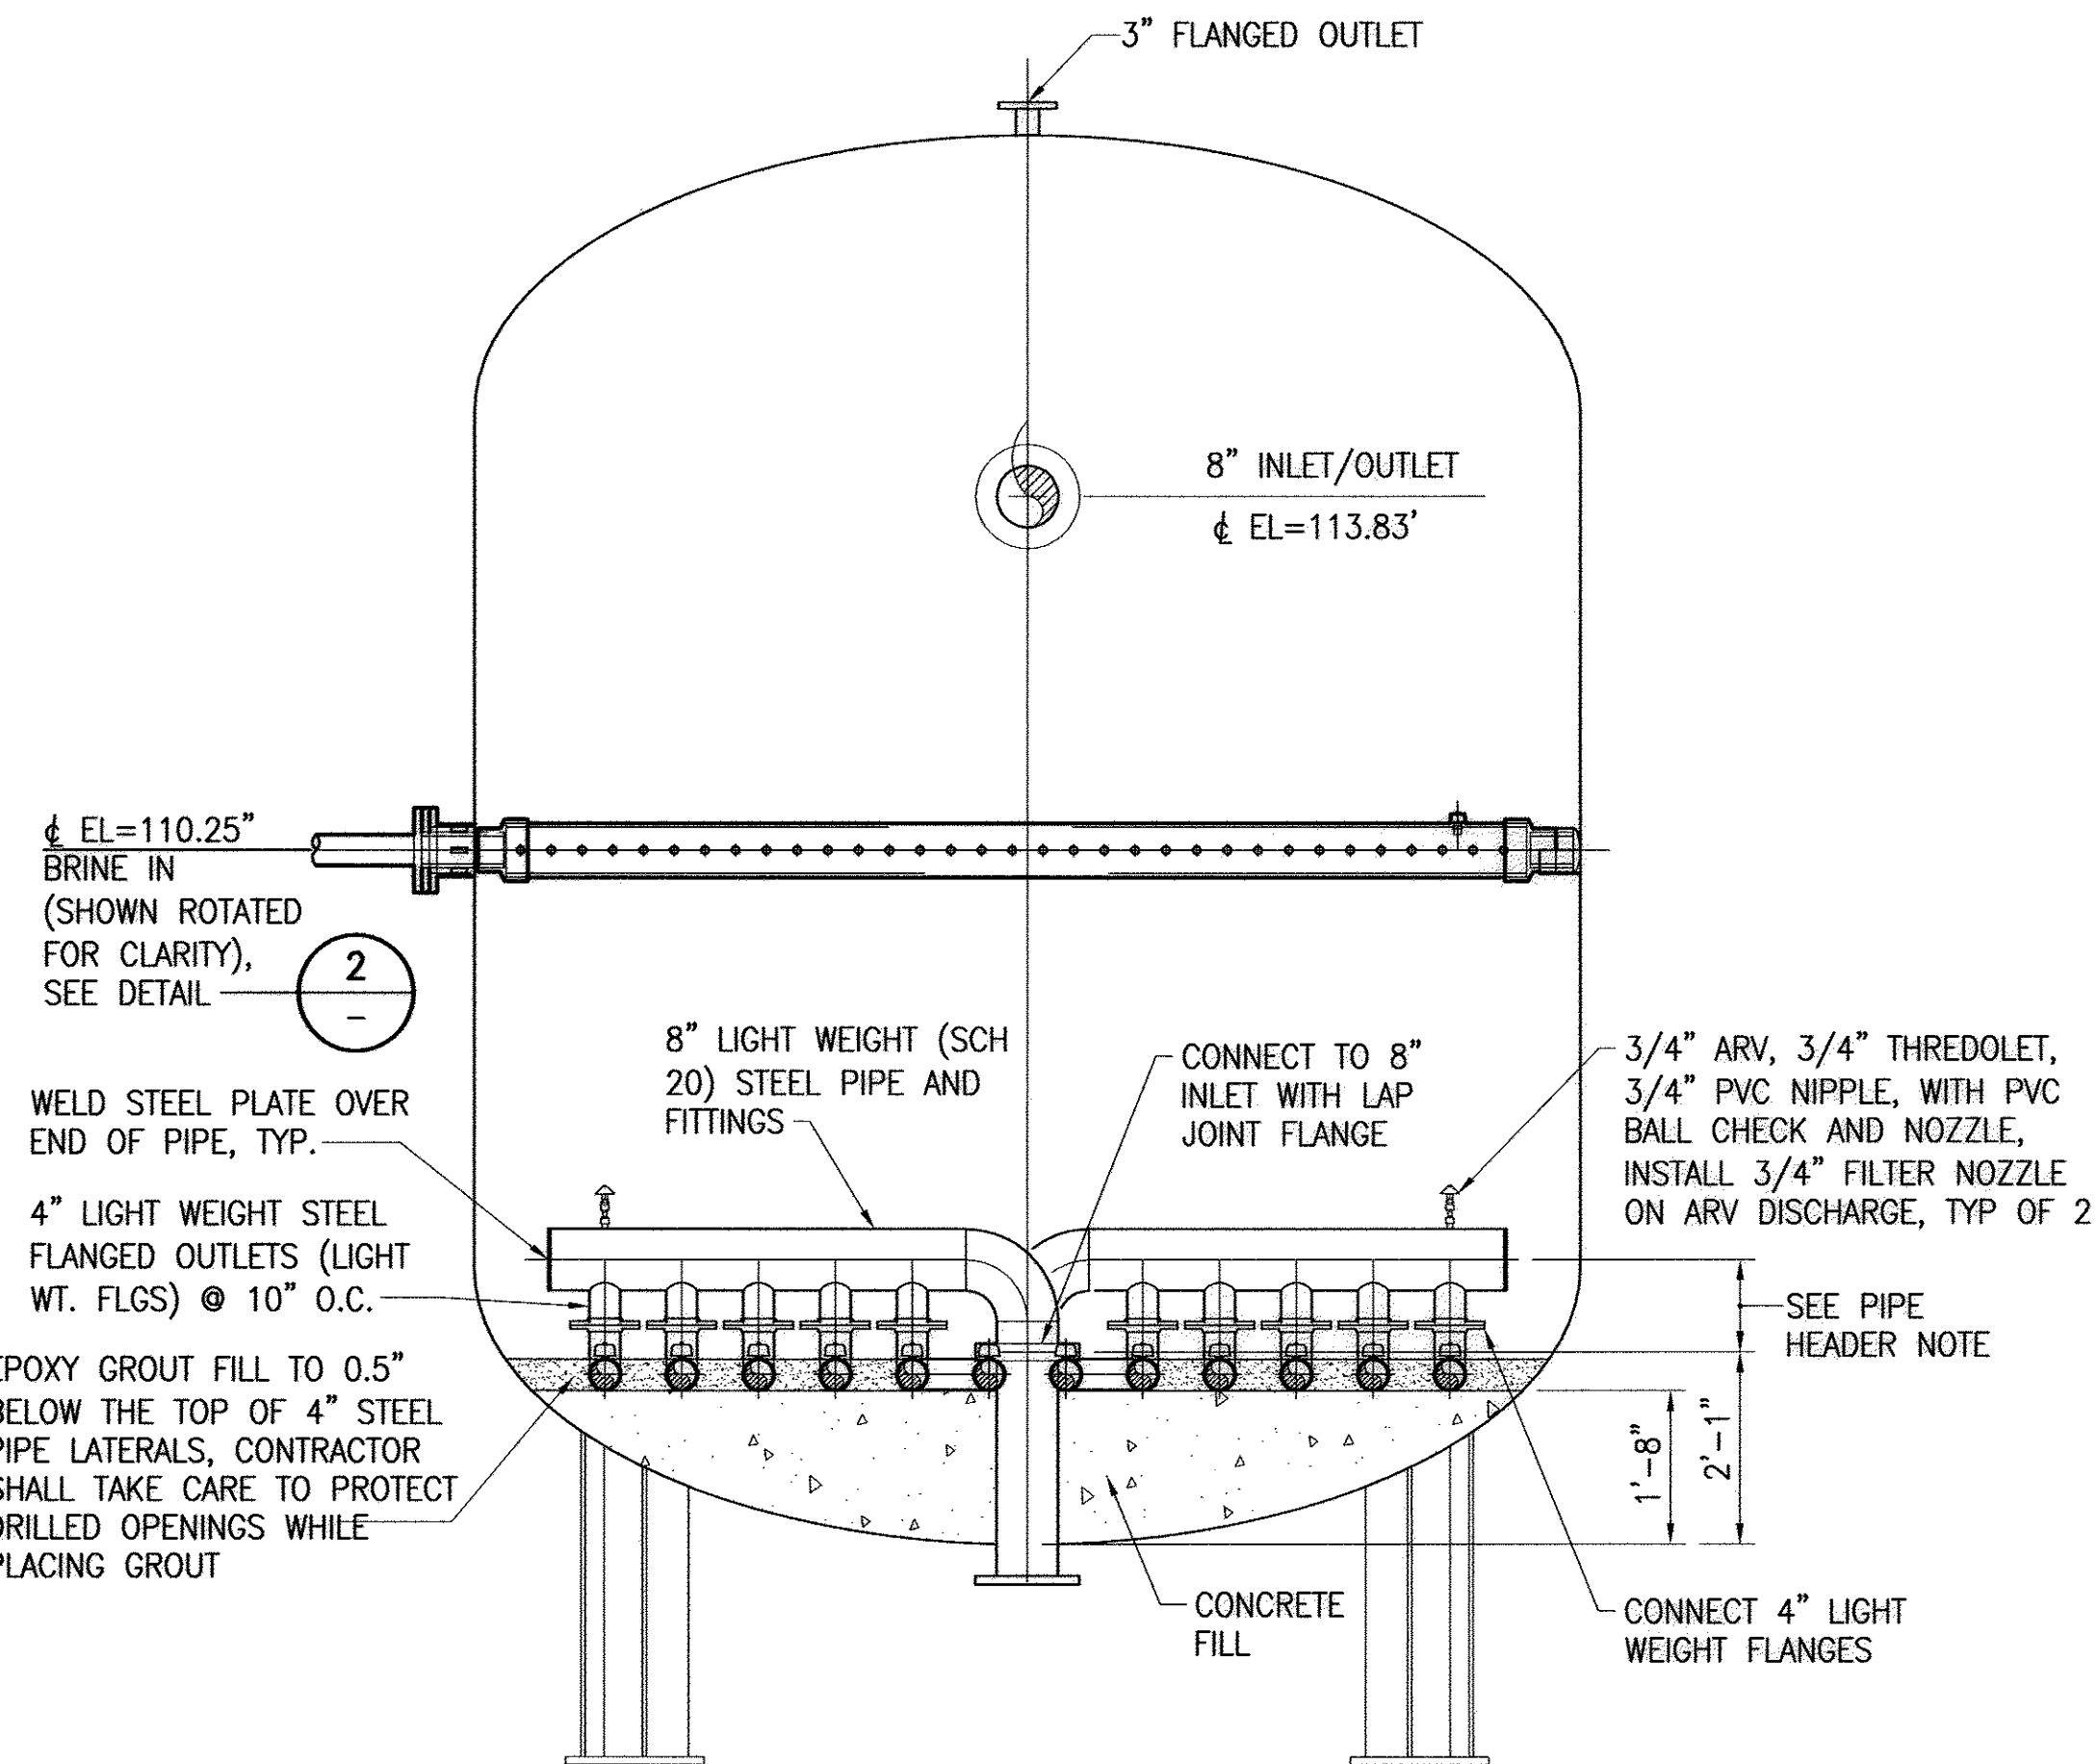

VESSEL SECTION

SCALE: 1/2" = 1'-0"

B
-

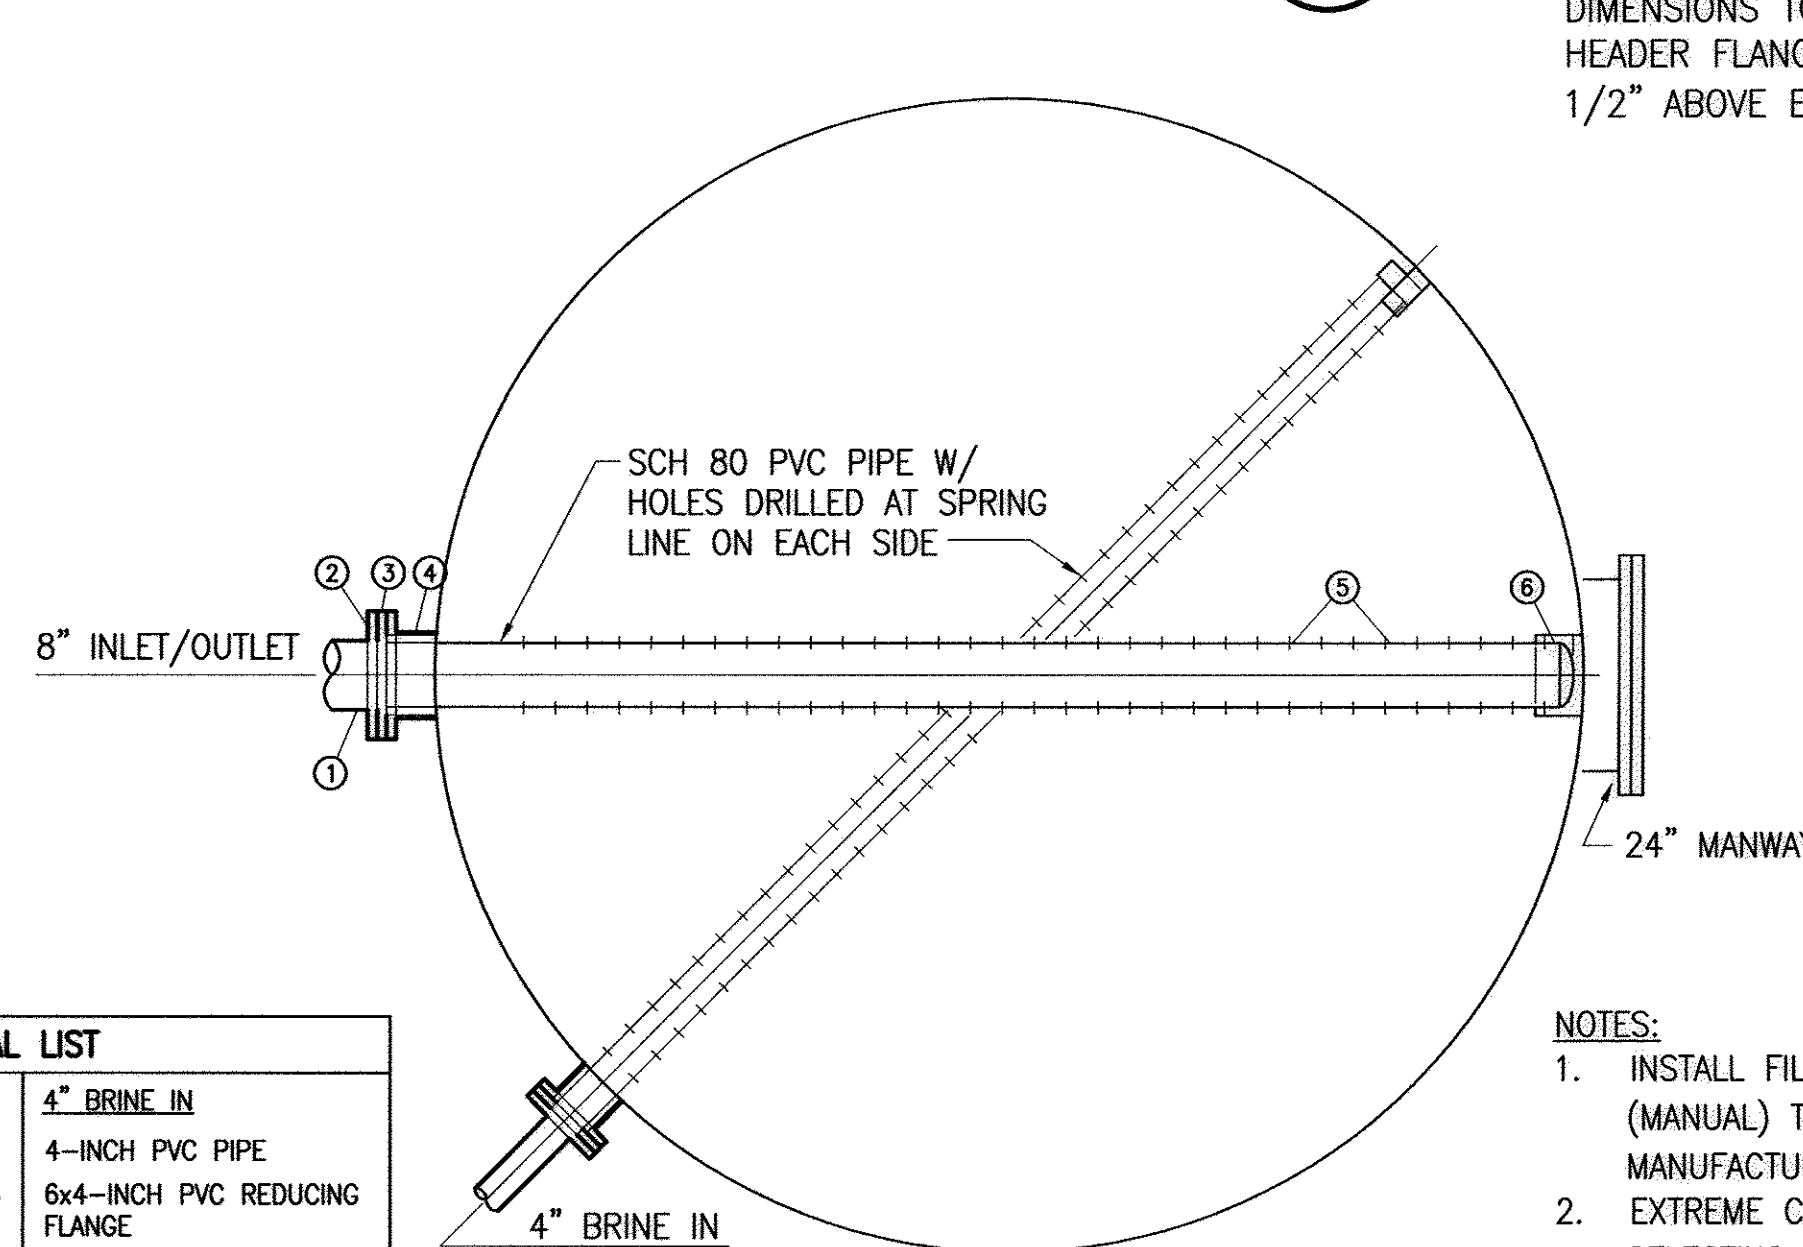

VESSEL SECTION

SCALE: 1/2" = 1'-0"

D
-

PIPE HEADER NOTE:

CONTRACTOR TO FIELD VERIFY ELEVATION OF EXISTING CONCRETE FILL AND ADJUST NEW PIPE DIMENSIONS TO ALLOW 4-INCH HEADER FLANGES TO BE LESS THEN 1/2" ABOVE EXISTING CONCRETE FILL.

NOTES:

- INSTALL FILTER NOZZLES USING (MANUAL) TORQUE WRENCH PER MANUFACTURER'S INSTRUCTIONS. EXTREME CARE MUST BE TAKEN IN SELECTING SIZE OF "NUTS" FOR NOZZLES TO AVOID LOOSE NOZZLES.

RECORD DRAWING

Date: 08-23-07

These record drawings apply only to those facilities constructed under the contract identified in the title block and have been prepared, in part, on the basis of information compiled and furnished by others. The Engineer/Architect will not be responsible for any errors or omissions which have been incorporated into this drawing as a result of the work by others.

DWG: S:\JWA\100-040 CAD Files\10\10-040-001.dwg
 DATE: Nov 08, 2007 2:11pm
 USER: boeeford
 XREFS: S224880R

VERIFY SCALES
BAR IS ONE INCH ON ORIGINAL DRAWING
0 1
IF NOT ONE INCH ON THIS SHEET,
ADJUST SCALES ACCORDINGLY


APPROVAL:	DATE:	DESIGN BY:	CJM
APPROVAL:	DATE:	DRAWN BY:	DTG
APPROVAL:	DATE:	CHECKED BY:	
APPROVAL:	DATE:	DATE:	AUGUST 2005

REV	DATE	DESCRIPTION	APP

BOYLE ENGINEERING CORPORATION

JURUPA COMMUNITY SERVICES DISTRICT
ION EXCHANGE WATER TREATMENT PLANT - PHASE III
IX NITRATE REMOVAL VESSEL
INTERNAL DETAILS

DRAWING NO: **P-6**
SHEET NO: **7**
OF 48 SHEETS
FILE NO: **S-2268**

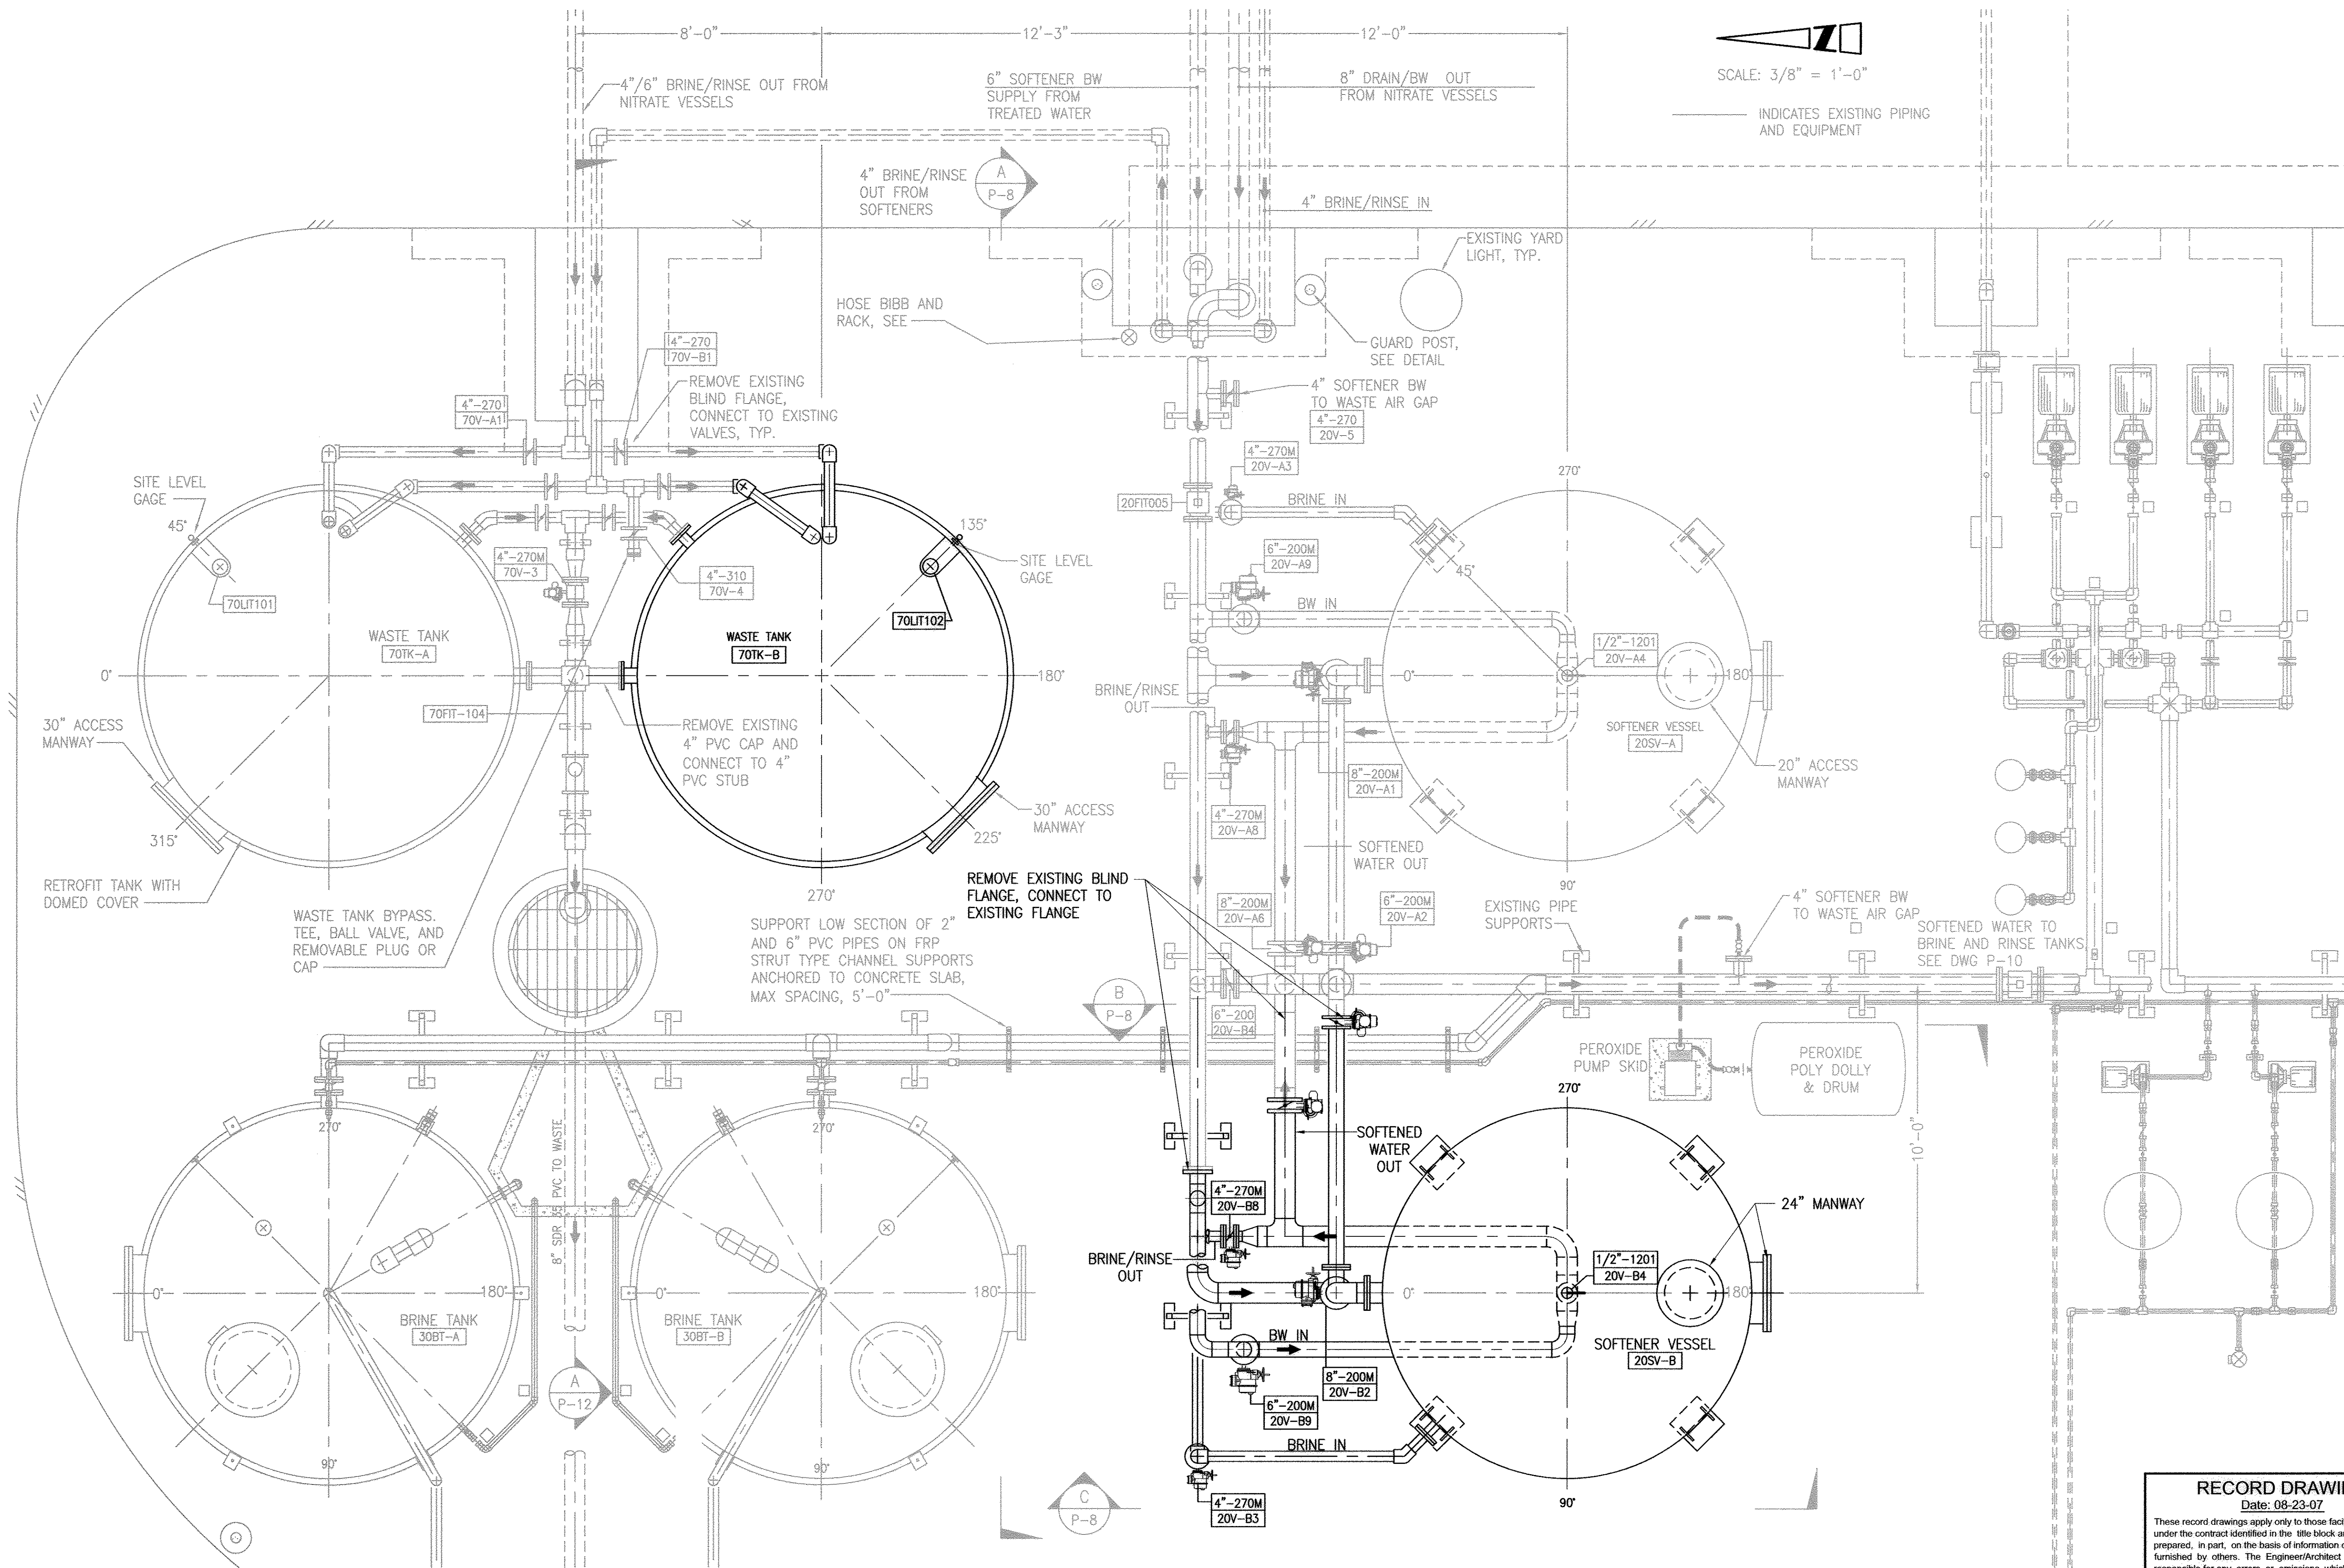

DWG: S:\04\100-04-CAD (Phase III)\Plans\2268-P7.dwg USER: beedford
 DATE: Nov 08, 2007 2:12pm XREFS: 2268BDR

VERIFY SCALES
 BAR IS ONE INCH ON ORIGINAL DRAWING
 0 1
 IF NOT ONE INCH ON THIS SHEET,
 ADJUST SCALES ACCORDINGLY


APPROVAL:	DATE:	DESIGN BY:	CJM	5/10/06	CHANGE ORDER 1.1
APPROVAL:	DATE:	DRAWN BY:	DTG	3/1/07	CHANGE ORDER 1.2
APPROVAL:	DATE:	CHECKED BY:			
APPROVAL:	DATE:	DATE:	AUGUST 2005	REV	DATE
					DESCRIPTION
					APP



JURUPA COMMUNITY SERVICES DISTRICT
 ION EXCHANGE WATER TREATMENT PLANT - PHASE III
WASTE TANKS AND SOFTENER VESSELS
PIPING PLAN


RECORD DRAWING
 Date: 08-23-07
 These record drawings apply only to those facilities constructed under the contract identified in the title block and have been prepared, in part, on the basis of information compiled and furnished by others. The Engineer/Architect will not be responsible for any errors or omissions which have been incorporated into this drawing as a result of the work by others.

DRAWING NO: **P-7** SHEET NO: **8**
 OF 48 SHEETS
 FILE NO: **S-2268**

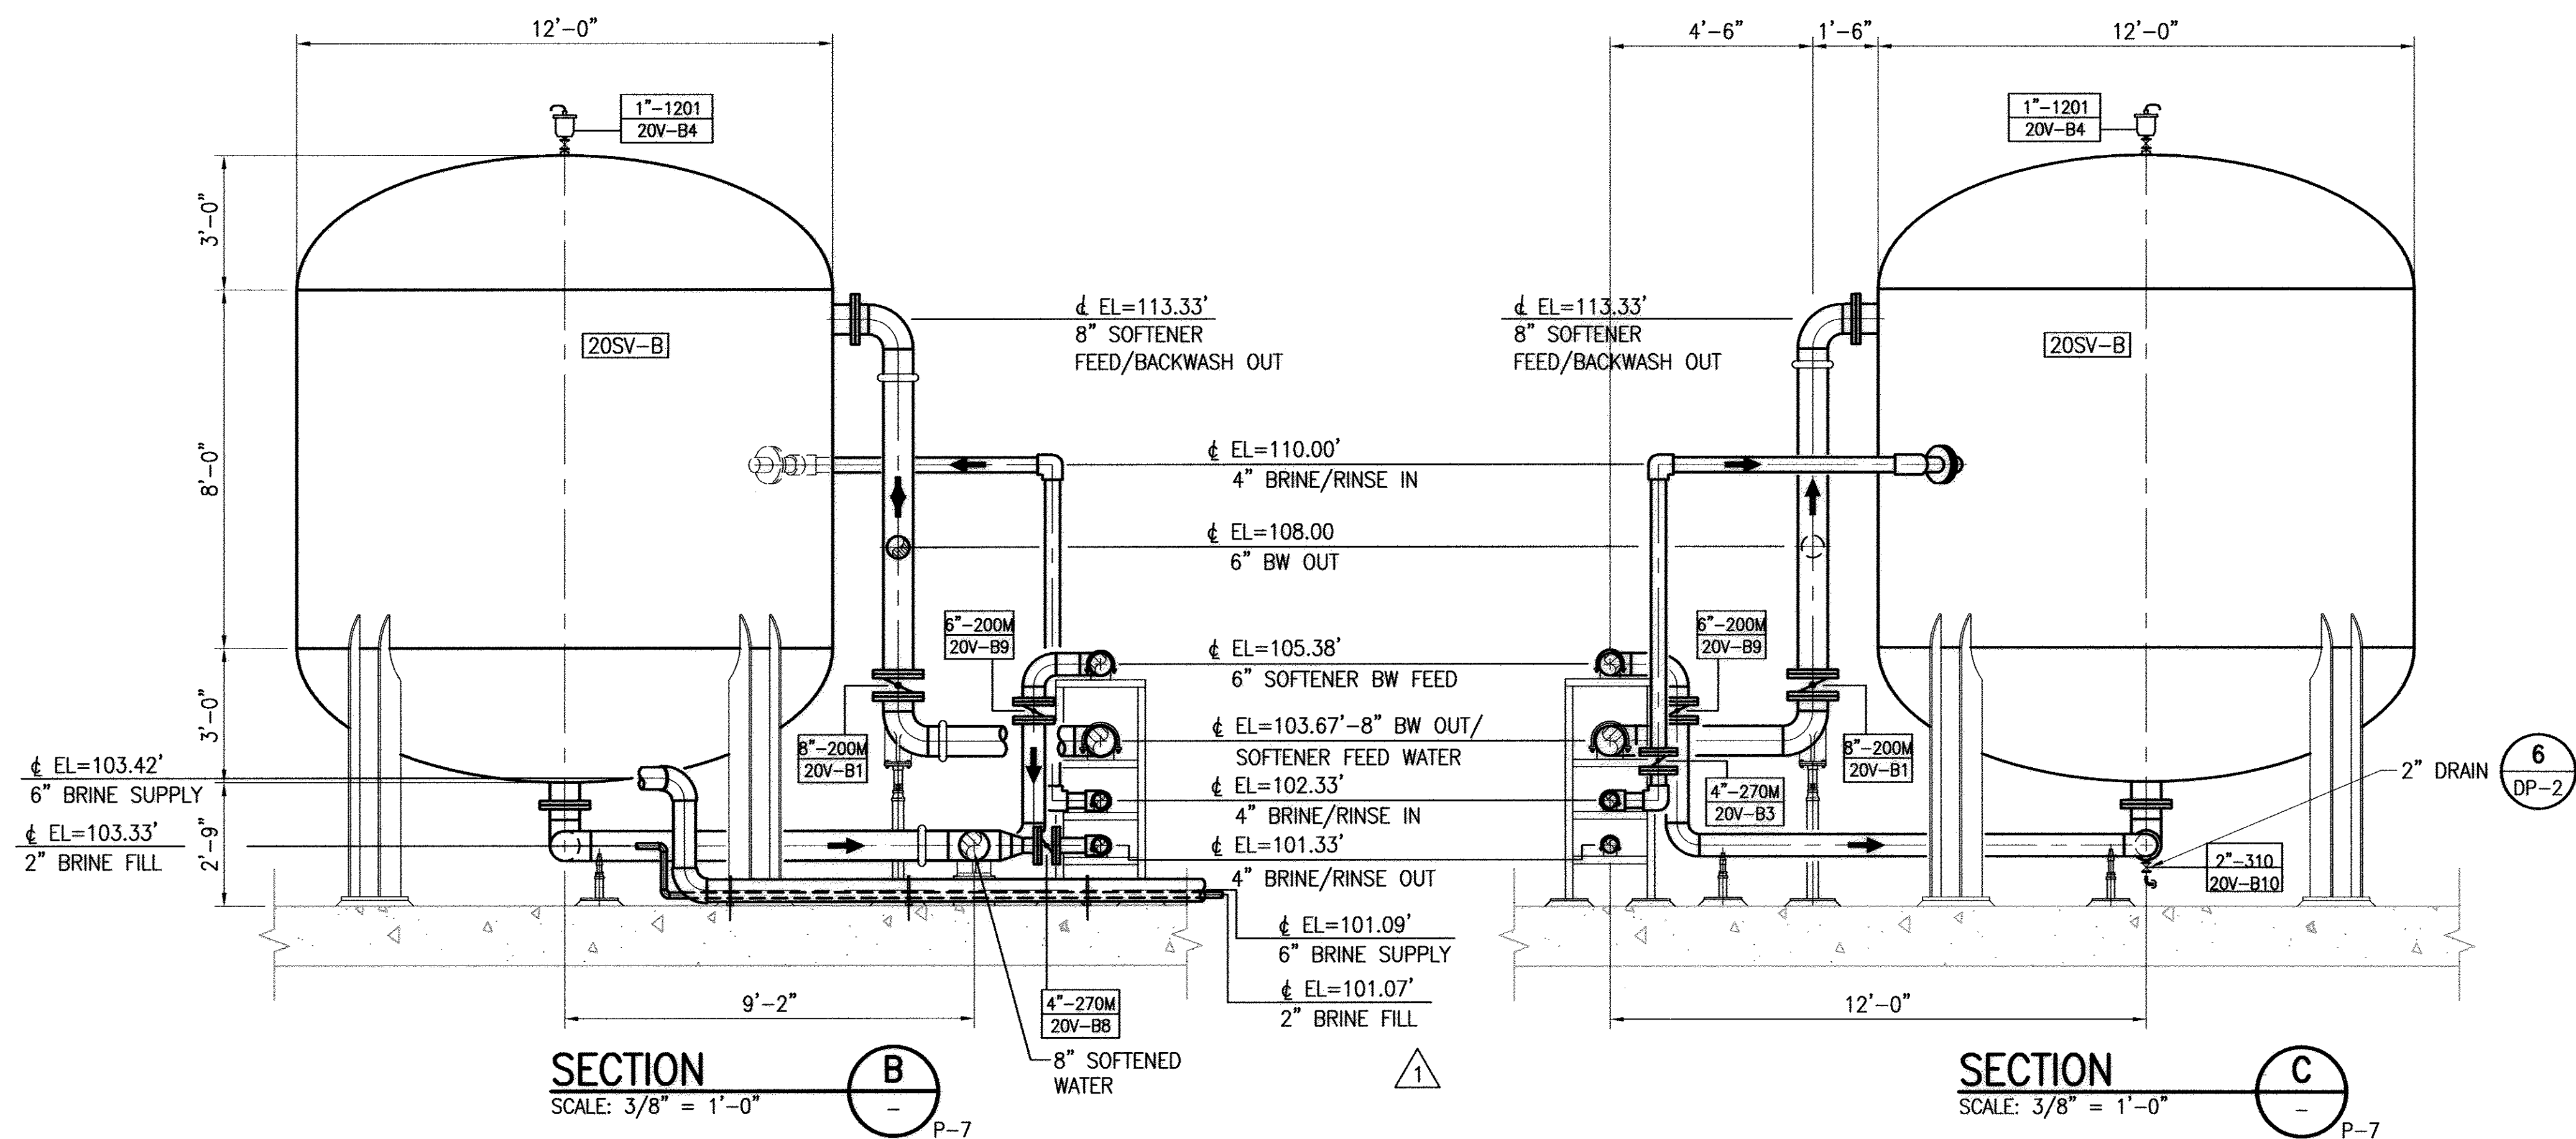

DRAWING NO: P-8	SHEET NO: 9
OF 48 SHEETS	
FILE NO: S-2268	


REMOVE EXISTING 8" SCH 80 PVC PIPE AND INSTALL NEW 8" DIA. SCH 80 PVC PIPE W/ 1 1/8" DIA. HOLES @ 4" O.C. ON SPRINGLINE, TYP. BOTH SIDES. (ALL HOLES SHALL BE SMOOTH AND CLEANED OF BURRS.) INSTALL FILTER NOZZLES AT EACH HOLE, (66 TOTAL) MANUFACTURED BY ORTHOS LIQUID SYSTEM MODEL AKSP WITH 0.2mm SLOTTED OPENINGS (4.23cm²) PER NOZZLE OR EQUAL

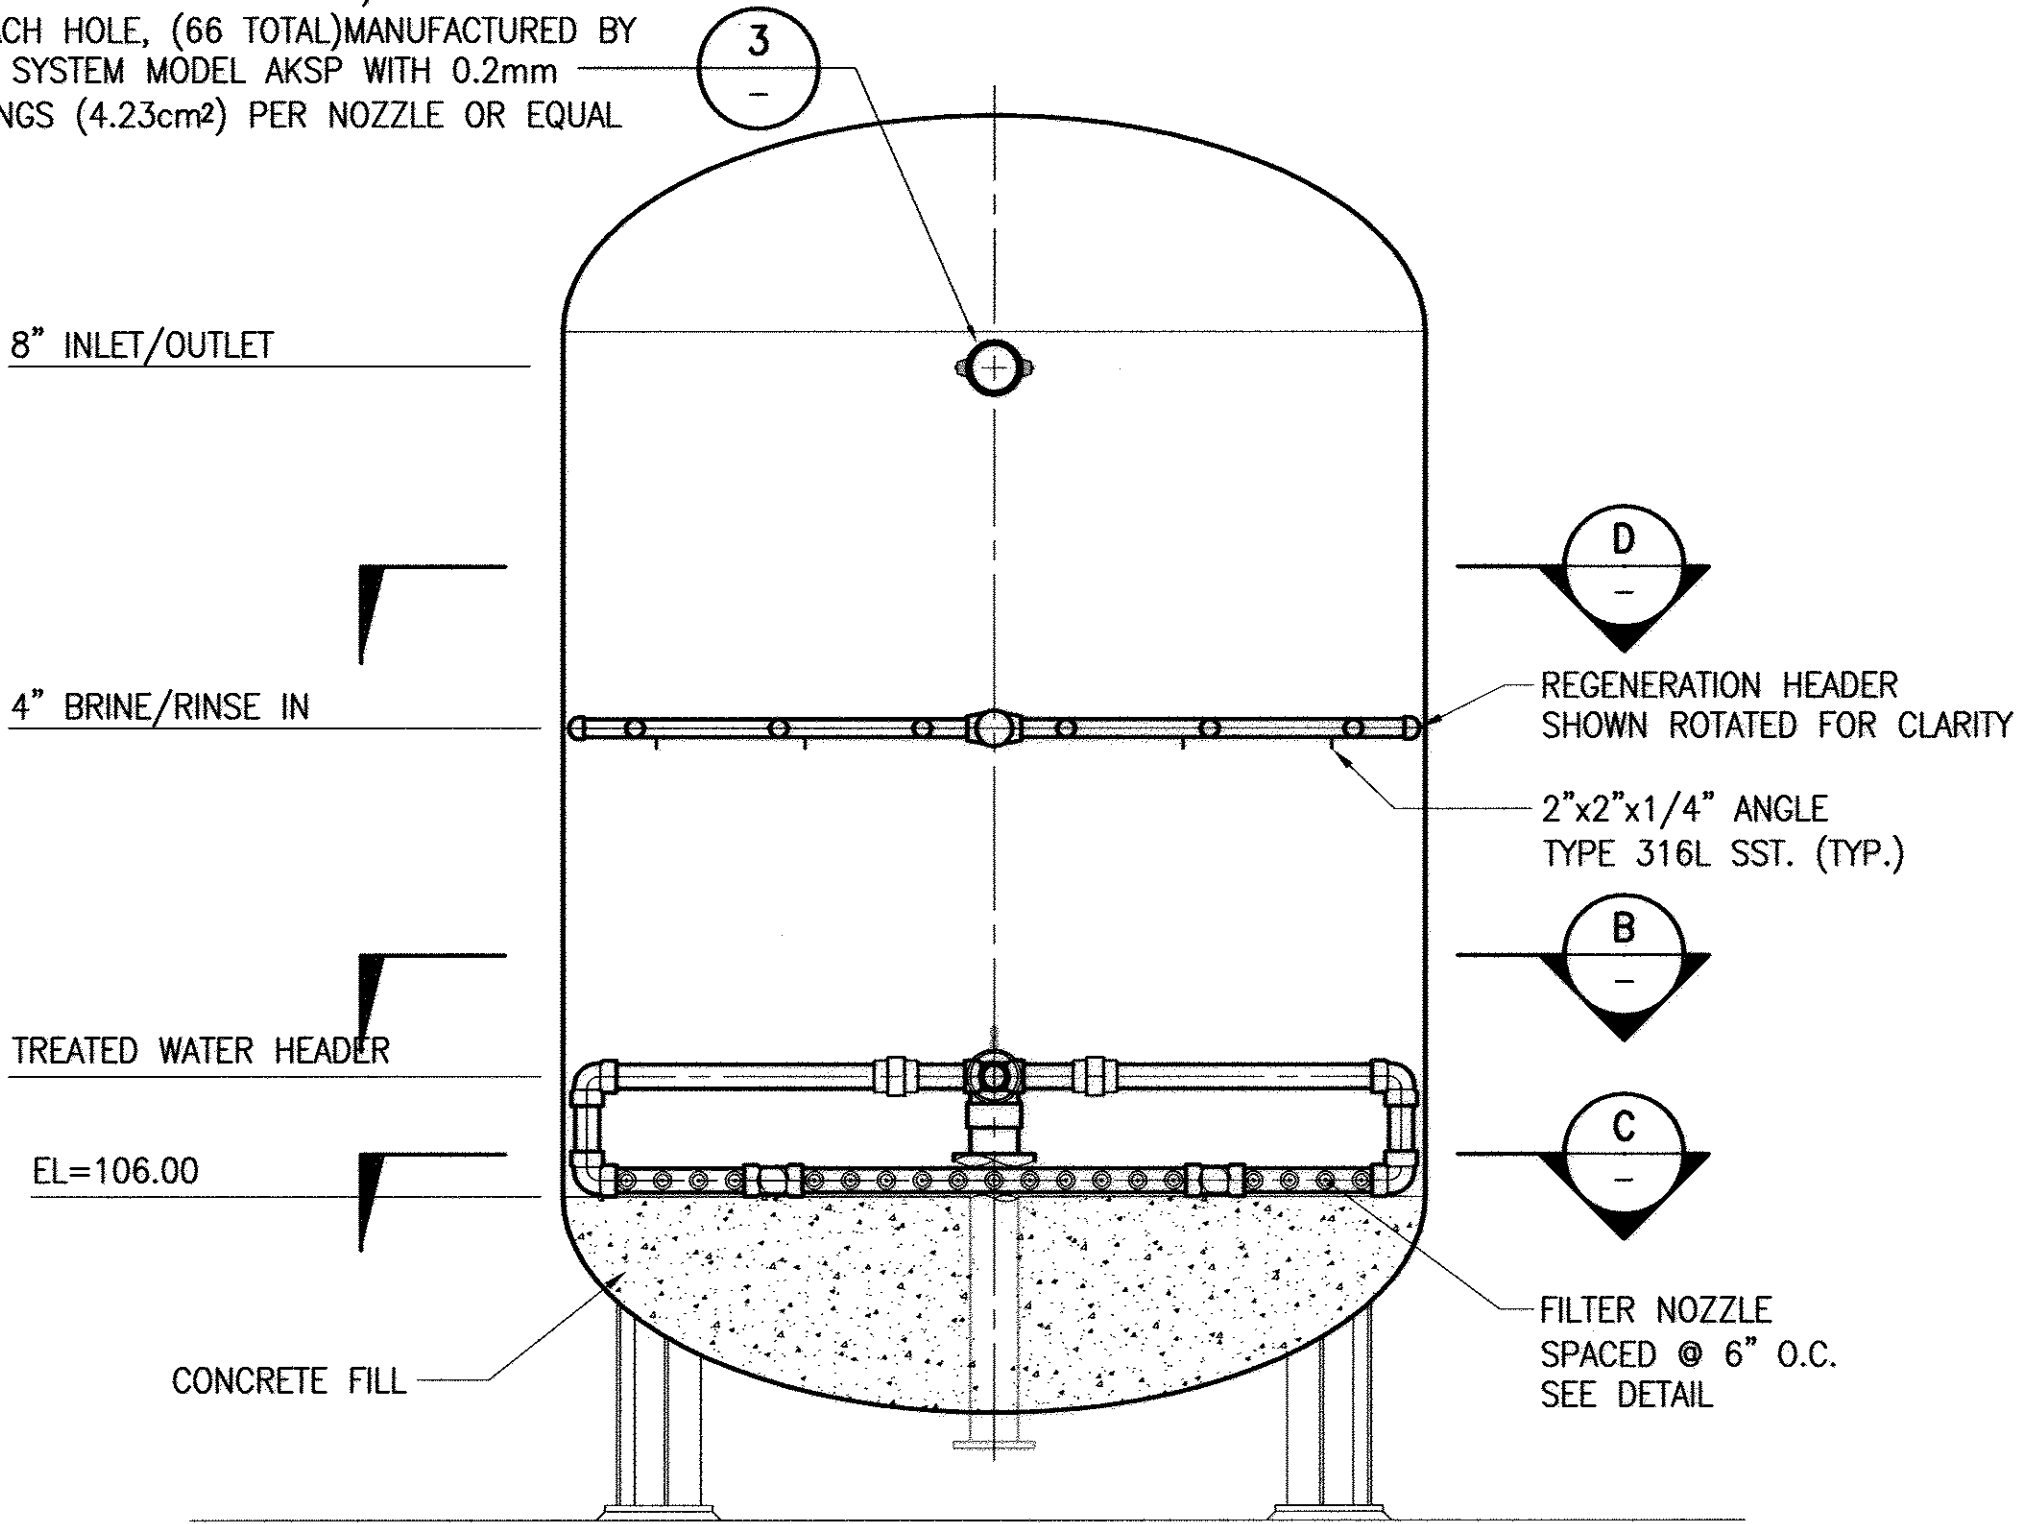

NOTE: HEADERS SHOWN ROTATED FOR CLARITY. SEE INDIVIDUAL HEADER PLANS FOR ACTUAL ORIENTATION.


TYPICAL VESSEL SECTION

SCALE: 3/8" = 1'-0"

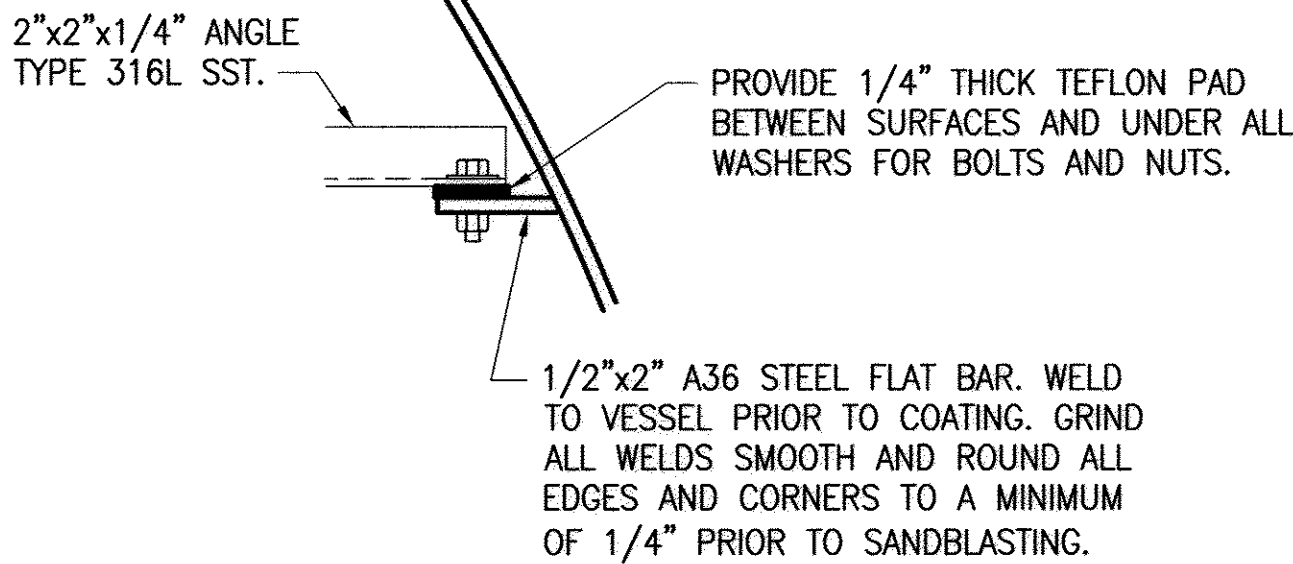

DETAIL


N.T.S.

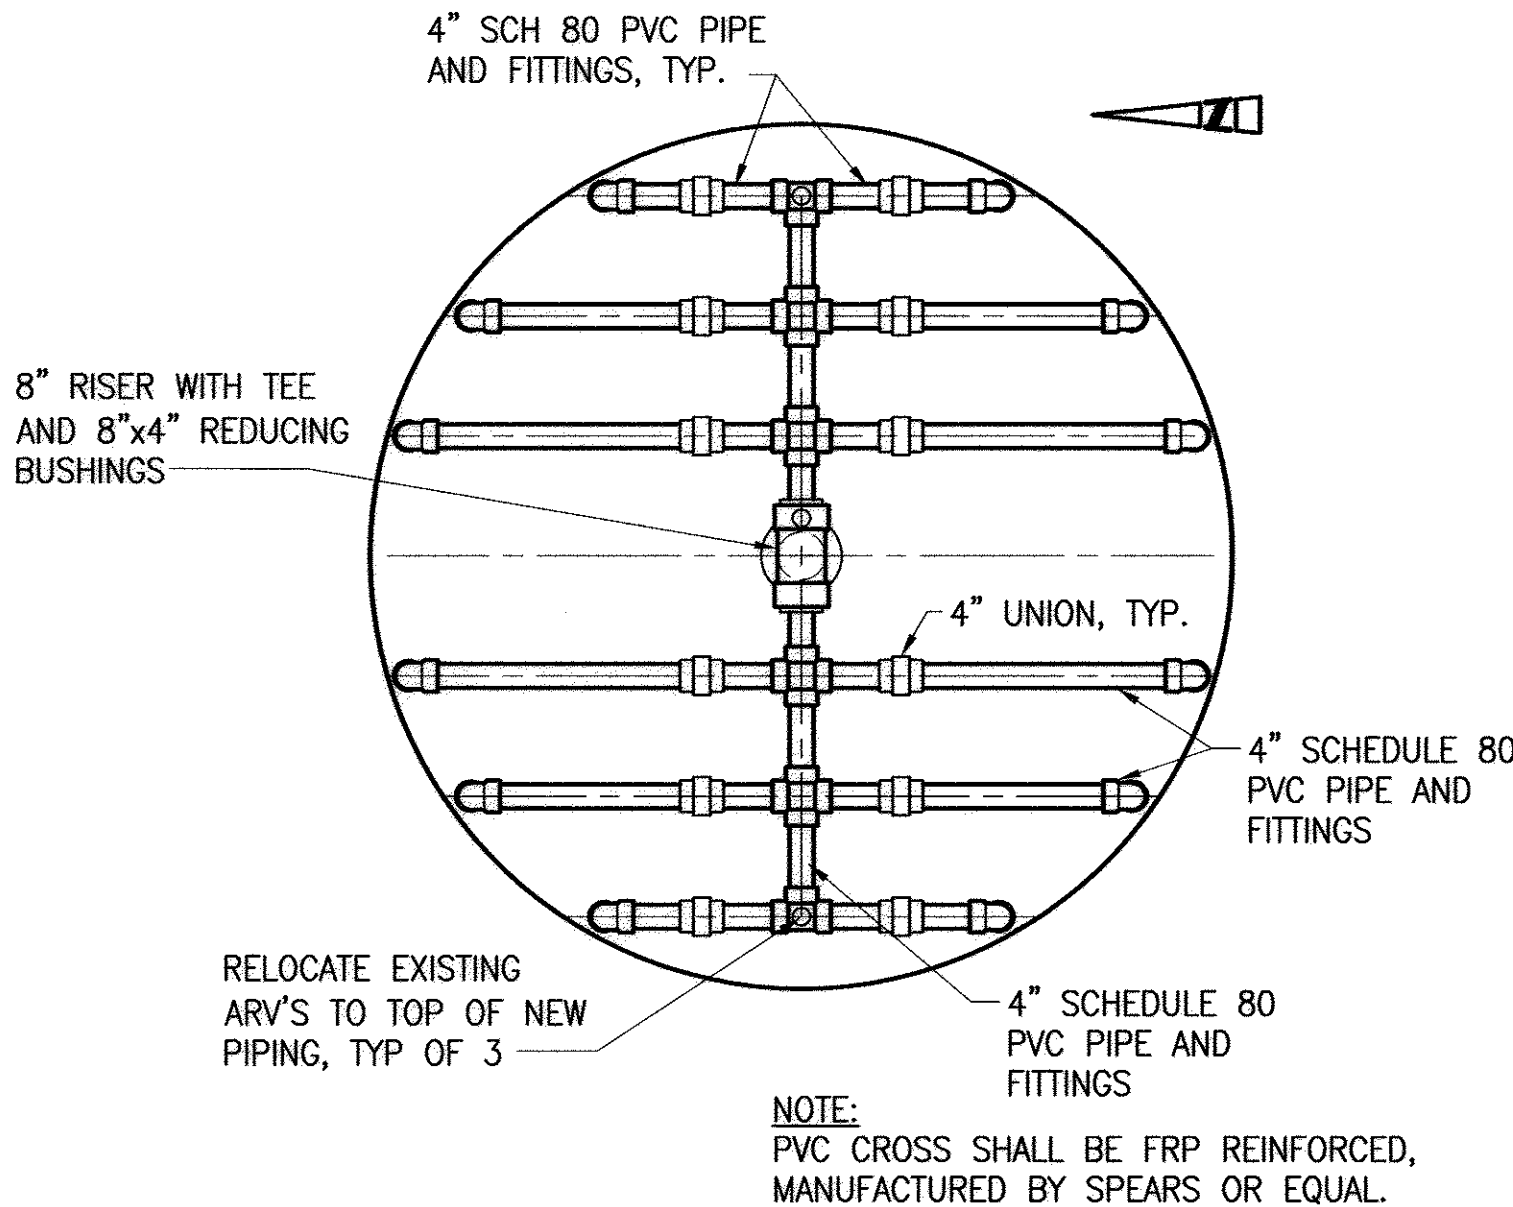

TREATED WATER HEADER


SCALE: 3/8" = 1'-0"

FILTER NOZZLES, (208 TOTAL) MFR. BY ORTHOS LIQUID SYSTEMS MODEL AKSP WITH 0.2mm SLOTTED OPENINGS (4.23cm²) PER NOZZLE OR EQUAL

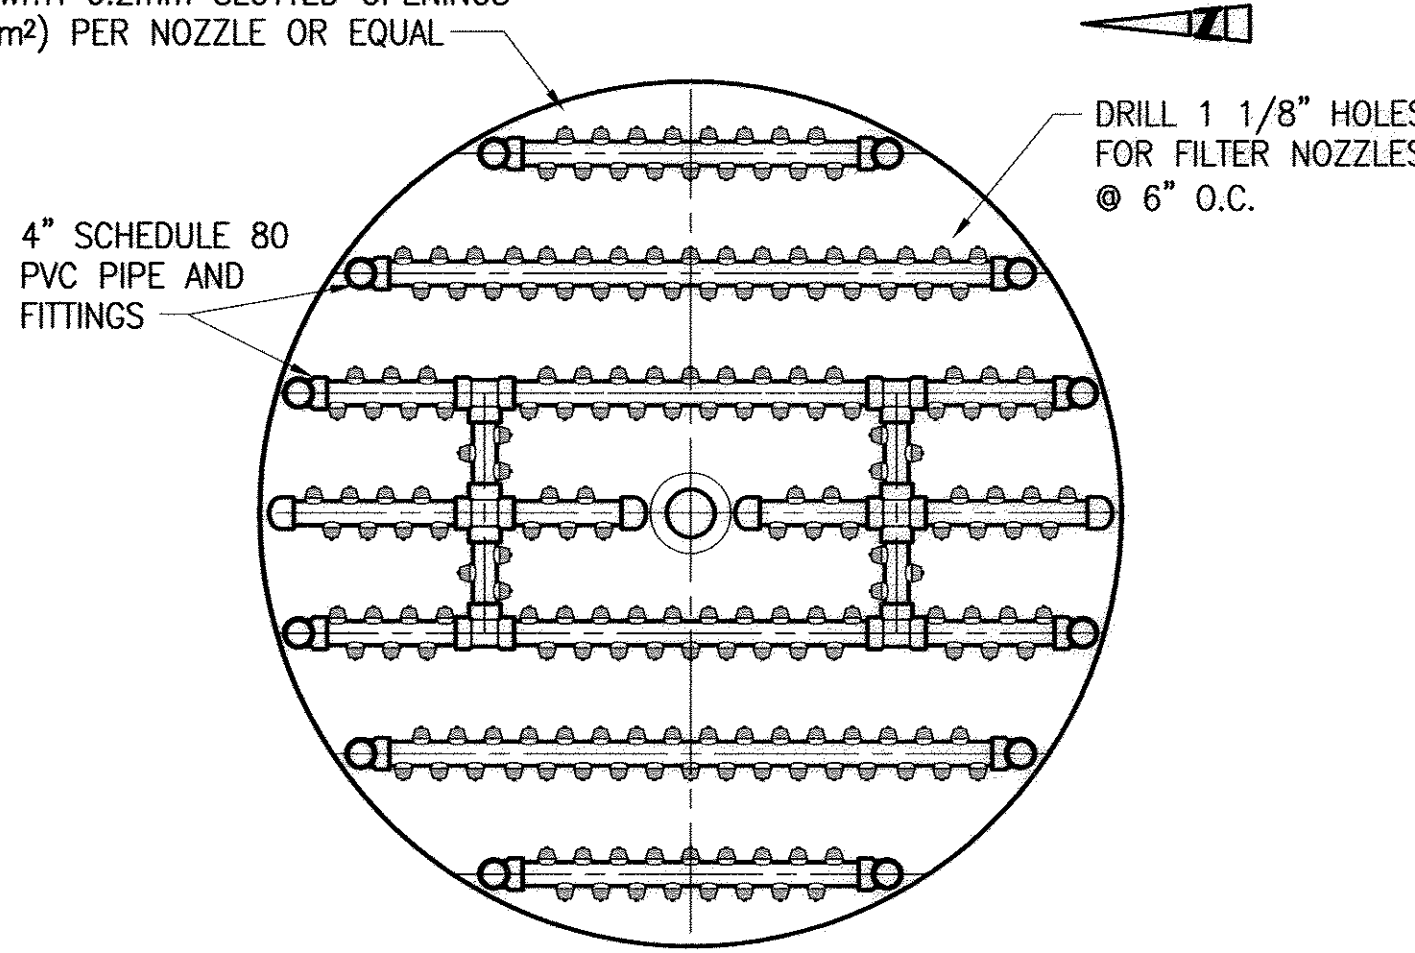

TREATED WATER HEADER

SCALE: 3/8" = 1'-0"

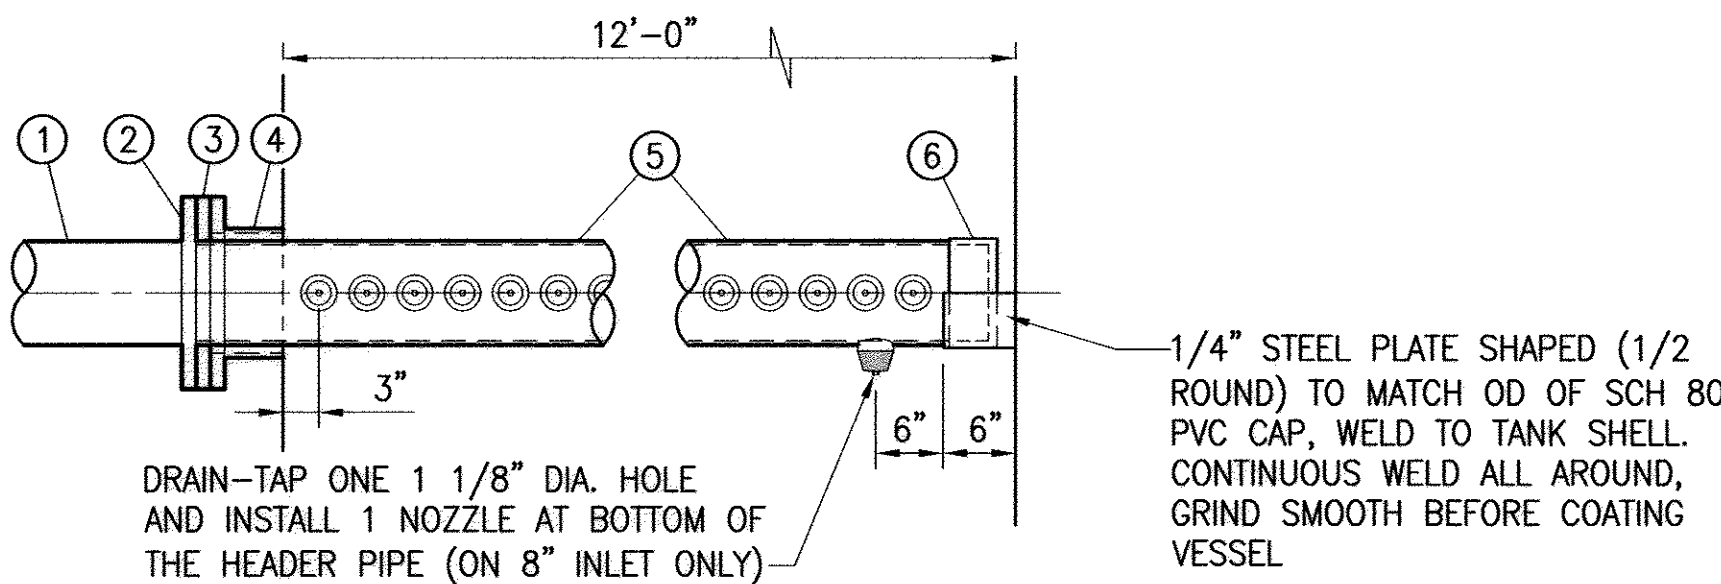


INLET/OUTLET HEADER DETAIL

SCALE: 3/4" = 1'-0"

MATERIAL LIST

- 8-INCH SST PIPE
- 8x10-INCH SST REDUCING FLANGE
- 8x10-INCH FIBERGLASS REDUCING FLANGE
- 10-INCH FLANGED OUTLET
- 8-INCH SCH 80 PVC PIPE
- 8-INCH SCH 80 PVC CAP

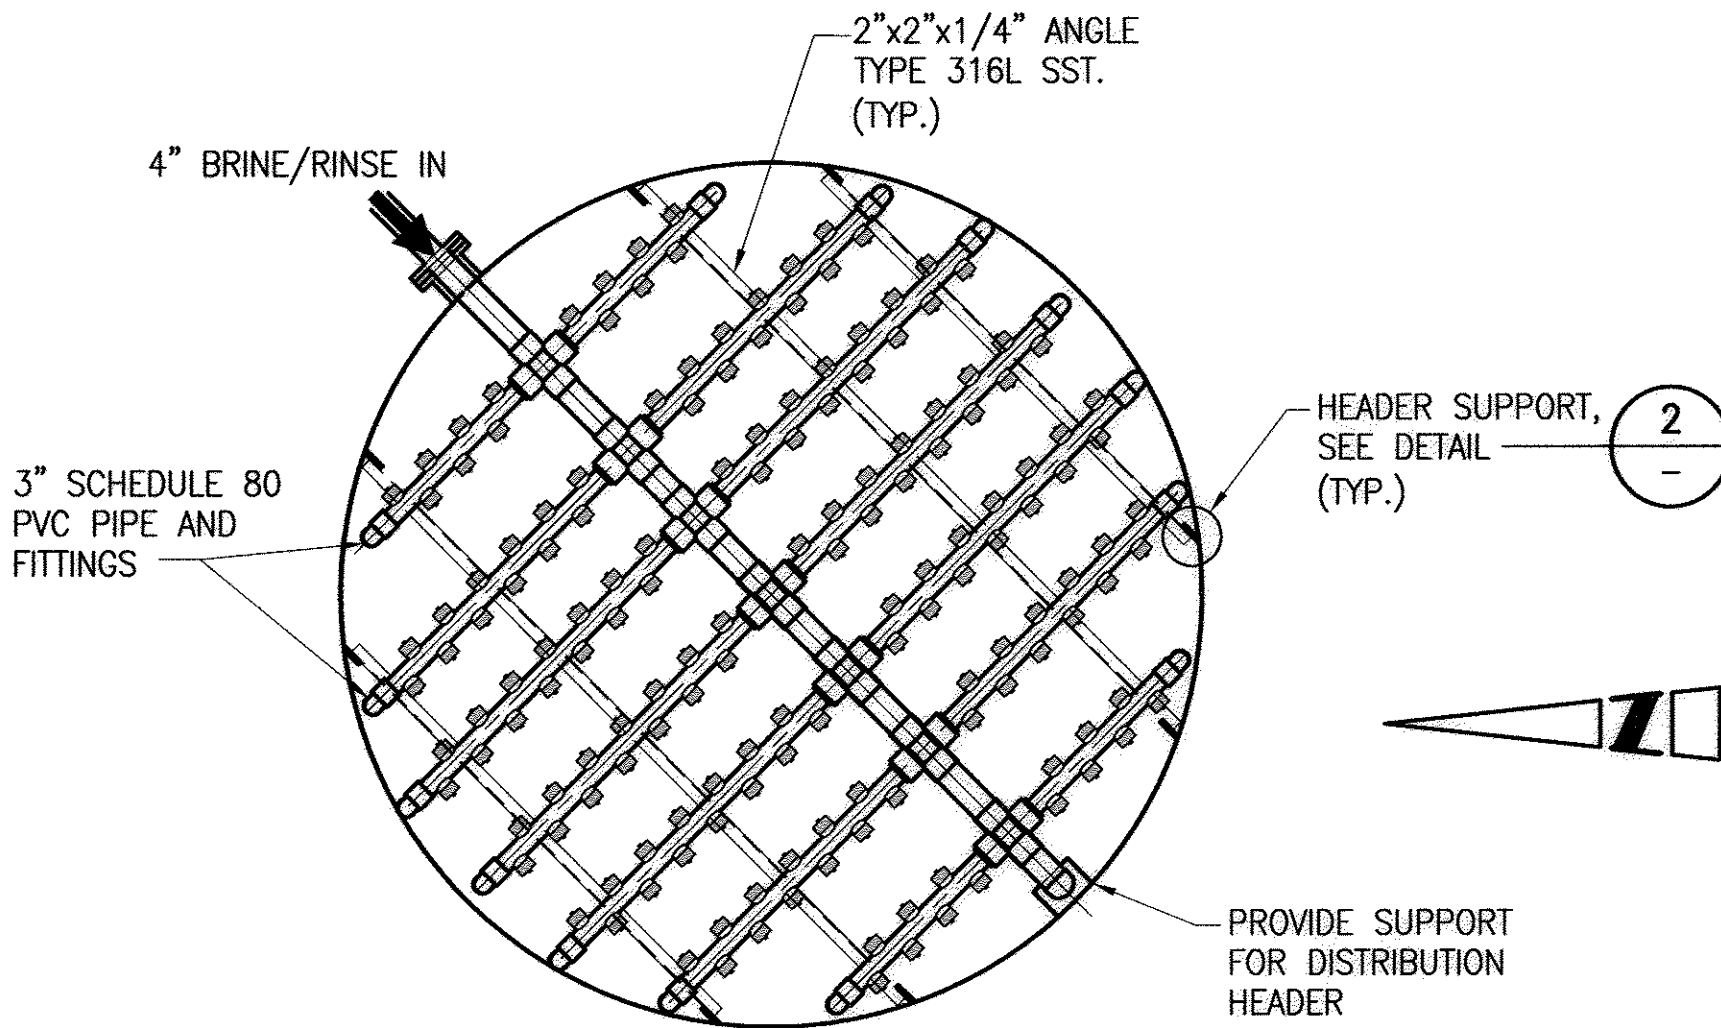

REGENERANT HEADER

SCALE: 3/8" = 1'-0"

RECORD DRAWING

Date: 08-23-07

These record drawings apply only to those facilities constructed under the contract identified in the title block and have been prepared, in part, on the basis of information compiled and furnished by others. The Engineer/Architect will not be responsible for any errors or omissions which have been incorporated into this drawing as a result of the work by others.

DWG: S:\04\10-04-04 CAD (phase III)\PlotSet\52268-P9.dwg
DATE: Nov 08, 2007 2:24pm
USER: lbedford
XREF: 52268D9

VERIFY SCALES
BAR IS ONE INCH ON ORIGINAL DRAWING
0 1
IF NOT ONE INCH ON THIS SHEET,
ADJUST SCALES ACCORDINGLY

APPROVAL: _____
DATE: _____
APPROVAL: _____
DATE: _____
APPROVAL: _____
DATE: _____

DESIGN BY: CJM
DESIGN BY: DTG
CHECKED BY: _____
DATE: AUGUST 2005


REV	DATE	DESCRIPTION	APP

BOYLE ENGINEERING CORPORATION

JURUPA COMMUNITY SERVICES DISTRICT
ION EXCHANGE WATER TREATMENT PLANT - PHASE III
SOFTENER VESSEL SECTION
AND DETAILS

DRAWING NO: P-9
SHEET NO: 10
OF 48 SHEETS
FILE NO: S-2268

DWG: S:\JDA\100-04 CAD (chase) \100-04.dwg USER: kbsford
DATE: Nov 08, 2007 2:56pm XREFS: 32268B2R

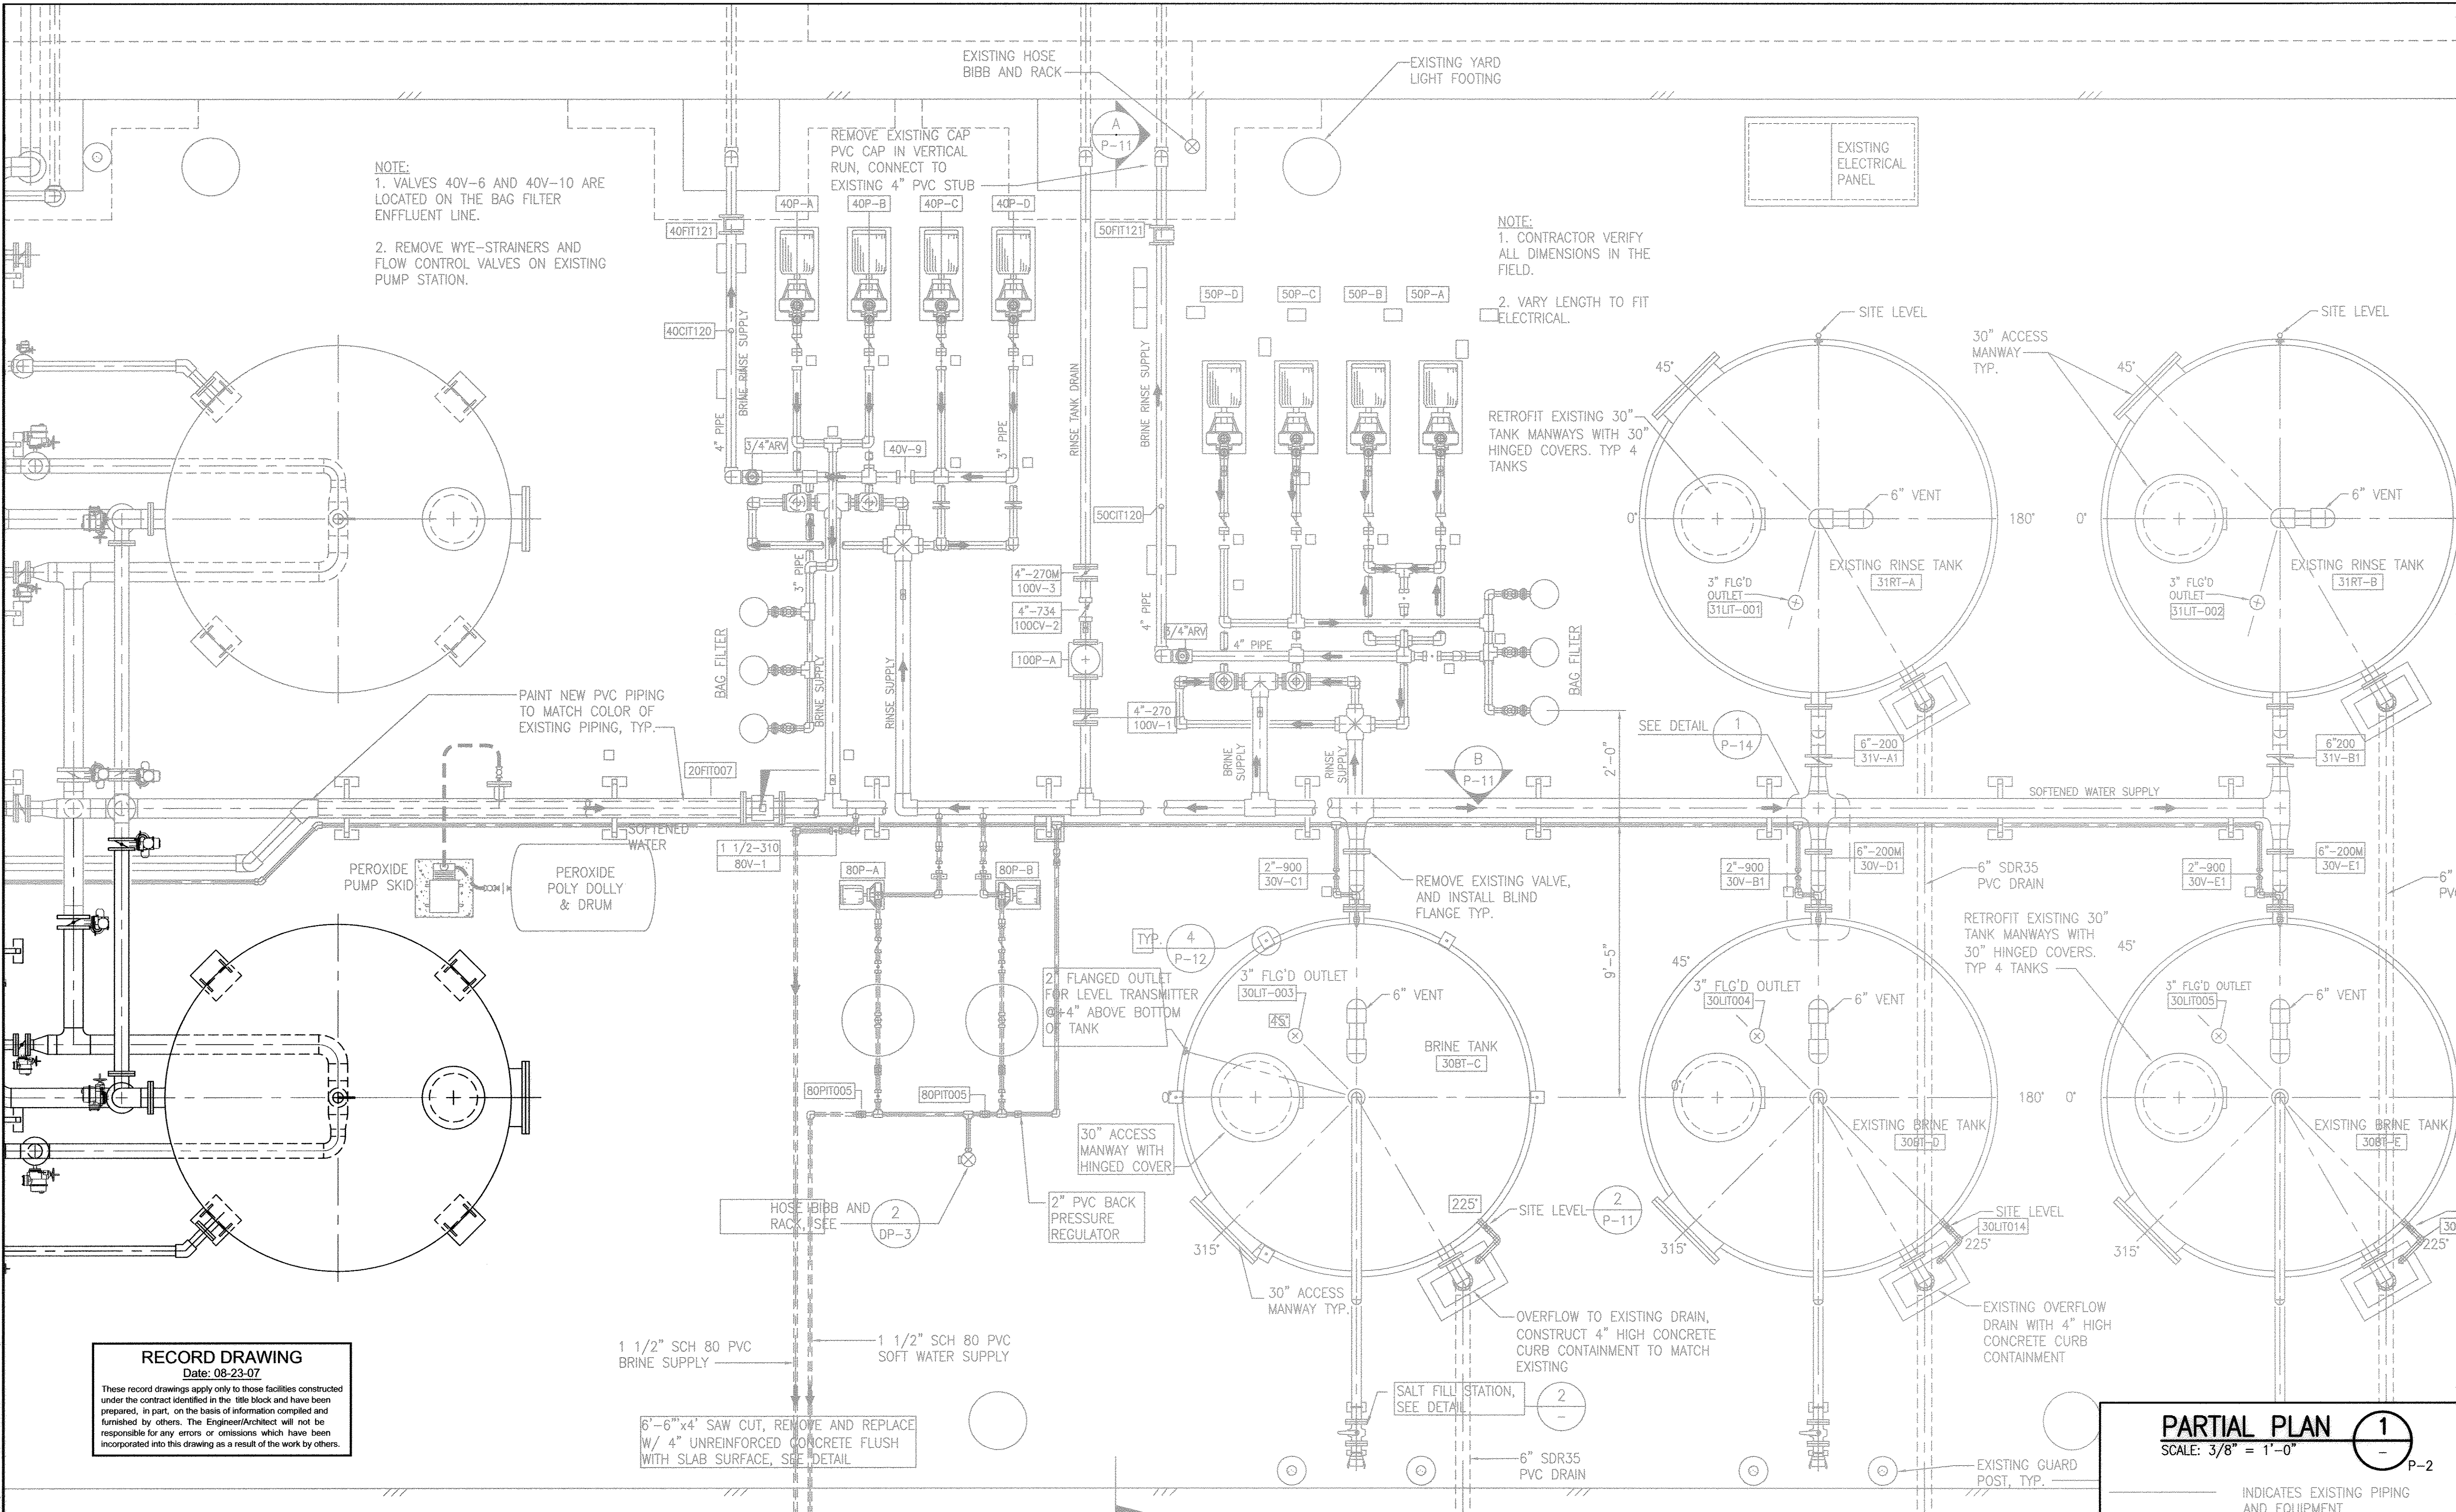

RECORD DRAWING
Date: 08-23-07
These record drawings apply only to those facilities constructed under the contract identified in the title block and have been prepared, in part, on the basis of information compiled and furnished by others. The Engineer/Architect will not be responsible for any errors or omissions which have been incorporated into this drawing as a result of the work by others.

6'-6"x4' SAW CUT, REMOVE AND REPLACE
W/ 4" UNREINFORCED CONCRETE FLUSH
WITH SLAB SURFACE, SEE DETAIL

VERIFY SCALES
BAR IS ONE INCH ON ORIGINAL DRAWING
0 1
IF NOT ONE INCH ON THIS SHEET,
ADJUST SCALES ACCORDINGLY

APPROVAL:	DATE:	DESIGN BY:	5/10/06	CHANGE ORDER 1.1	
APPROVAL:	DATE:	DRAWN BY:	3/1/07	CHANGE ORDER 1.2	
APPROVAL:	DATE:	CHECKED BY:			
APPROVAL:	DATE:	DATE:	AUGUST 2005	REV	DESCRIPTION








BOYLE ENGINEERING CORPORATION

JURUPA COMMUNITY SERVICES DISTRICT
ION EXCHANGE WATER TREATMENT PLANT - PHASE III
BRINE AND RINSE TANKS AND PUMP STATIONS
PARTIAL PLAN

PARTIAL PLAN 1
SCALE: 3/8" = 1'-0"
INDICATES EXISTING PIPING AND EQUIPMENT

P-10
FILE NO:
S-2268

11
OF 48 SHEETS
S-2268

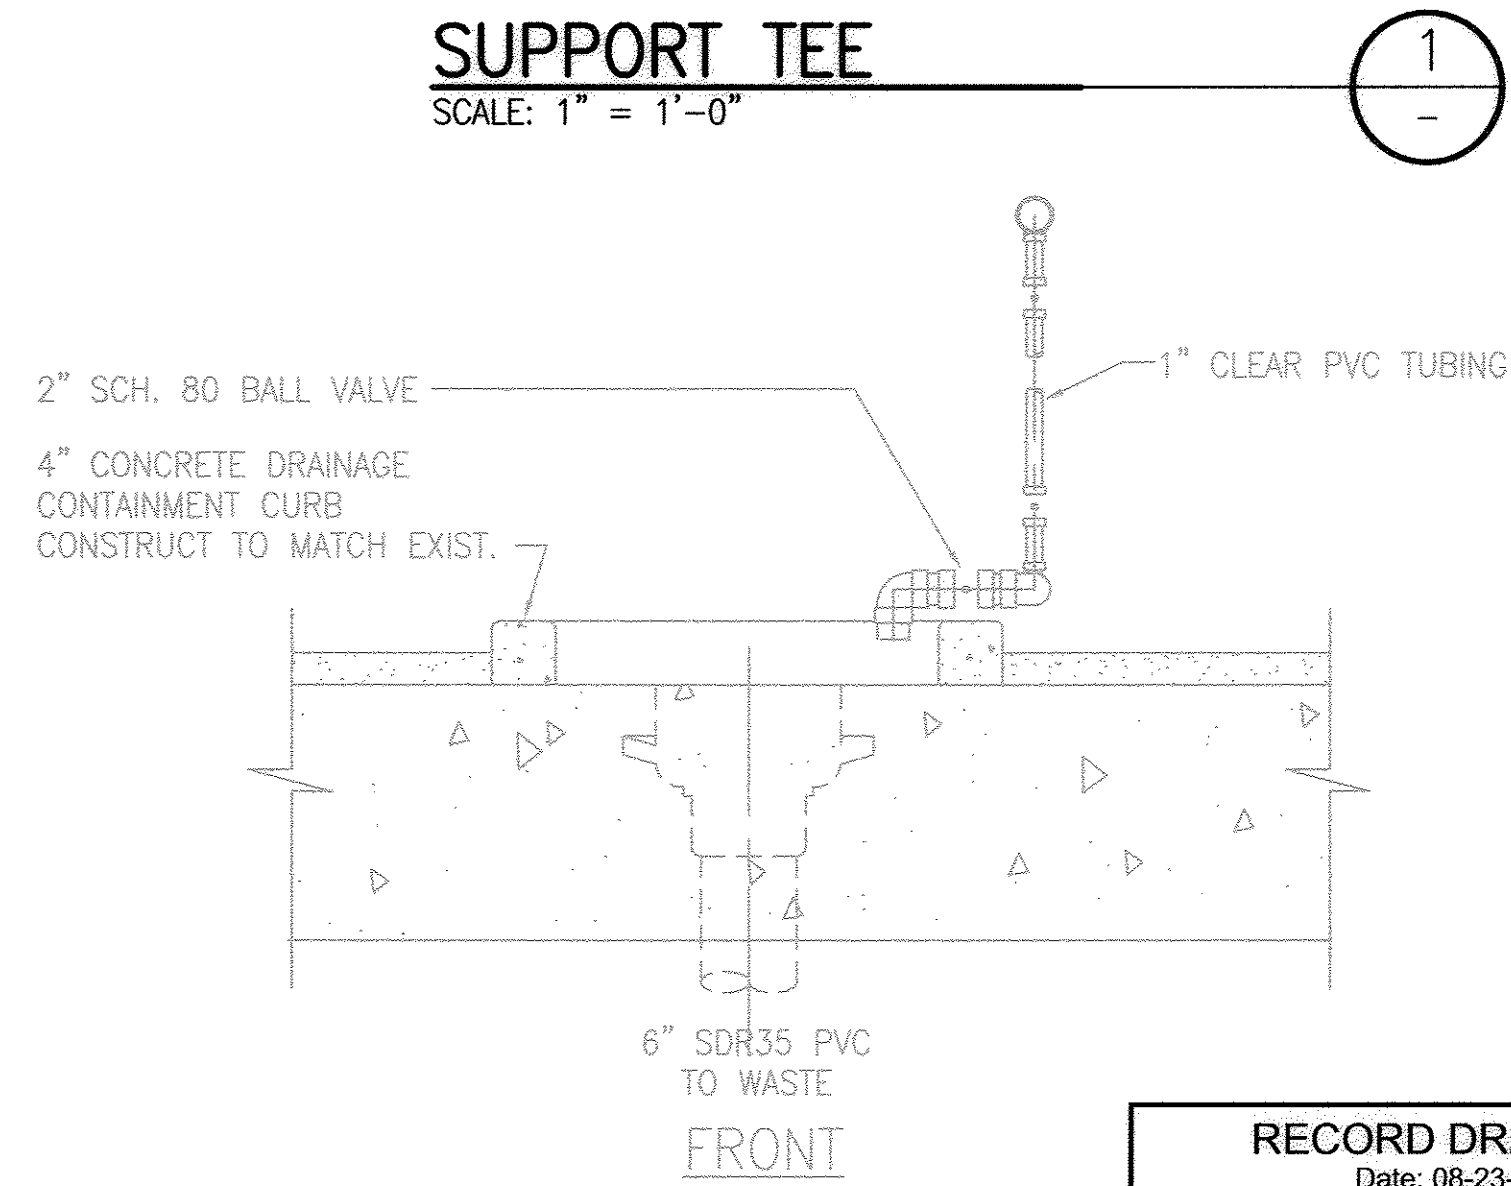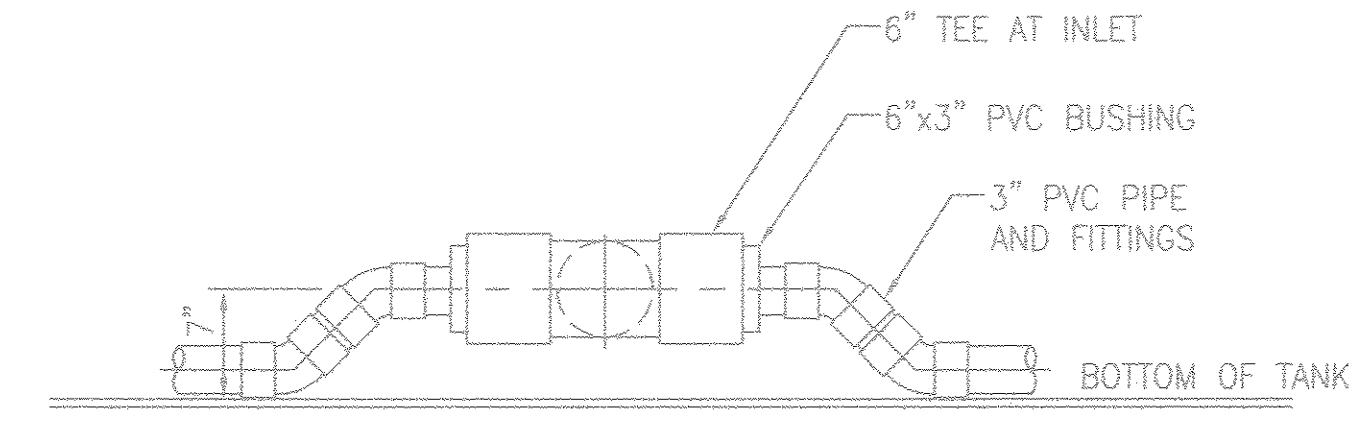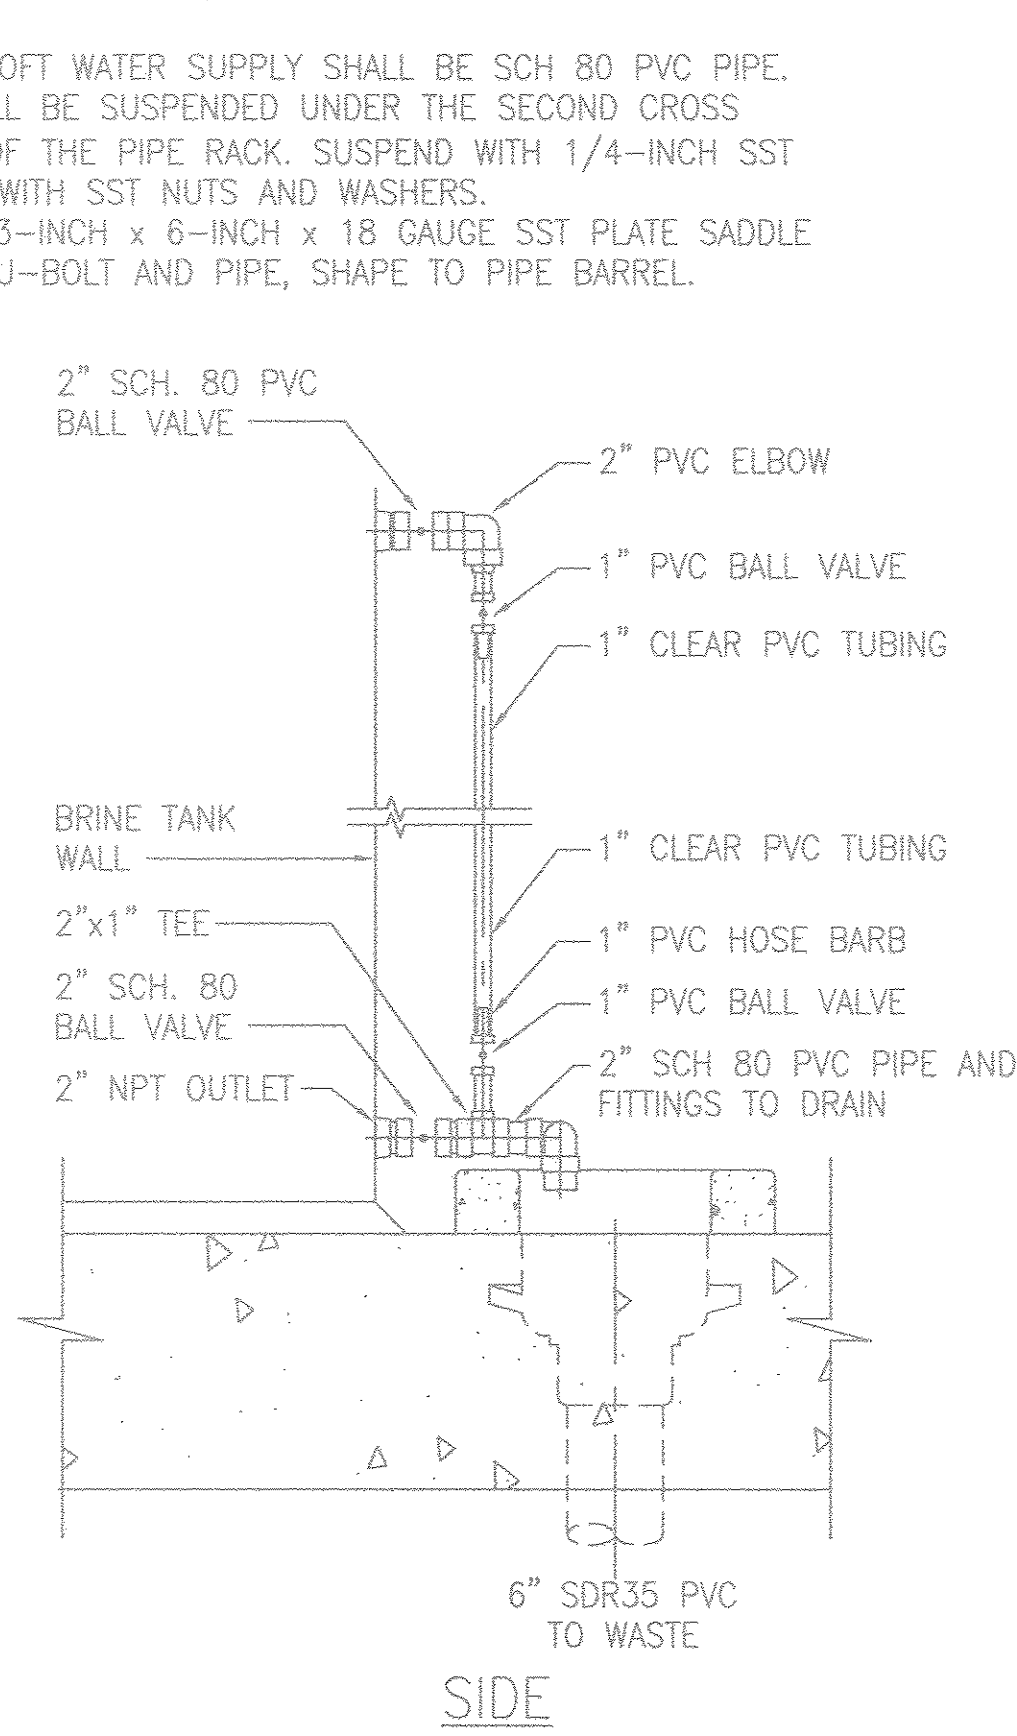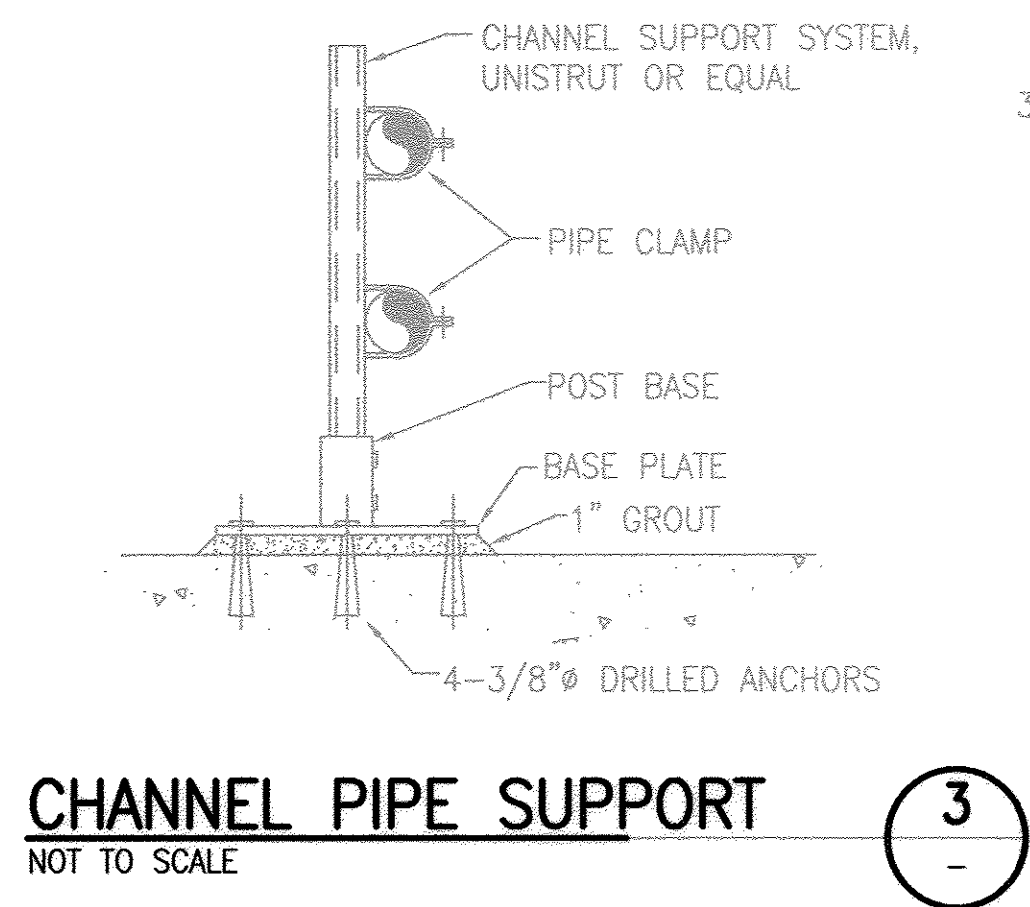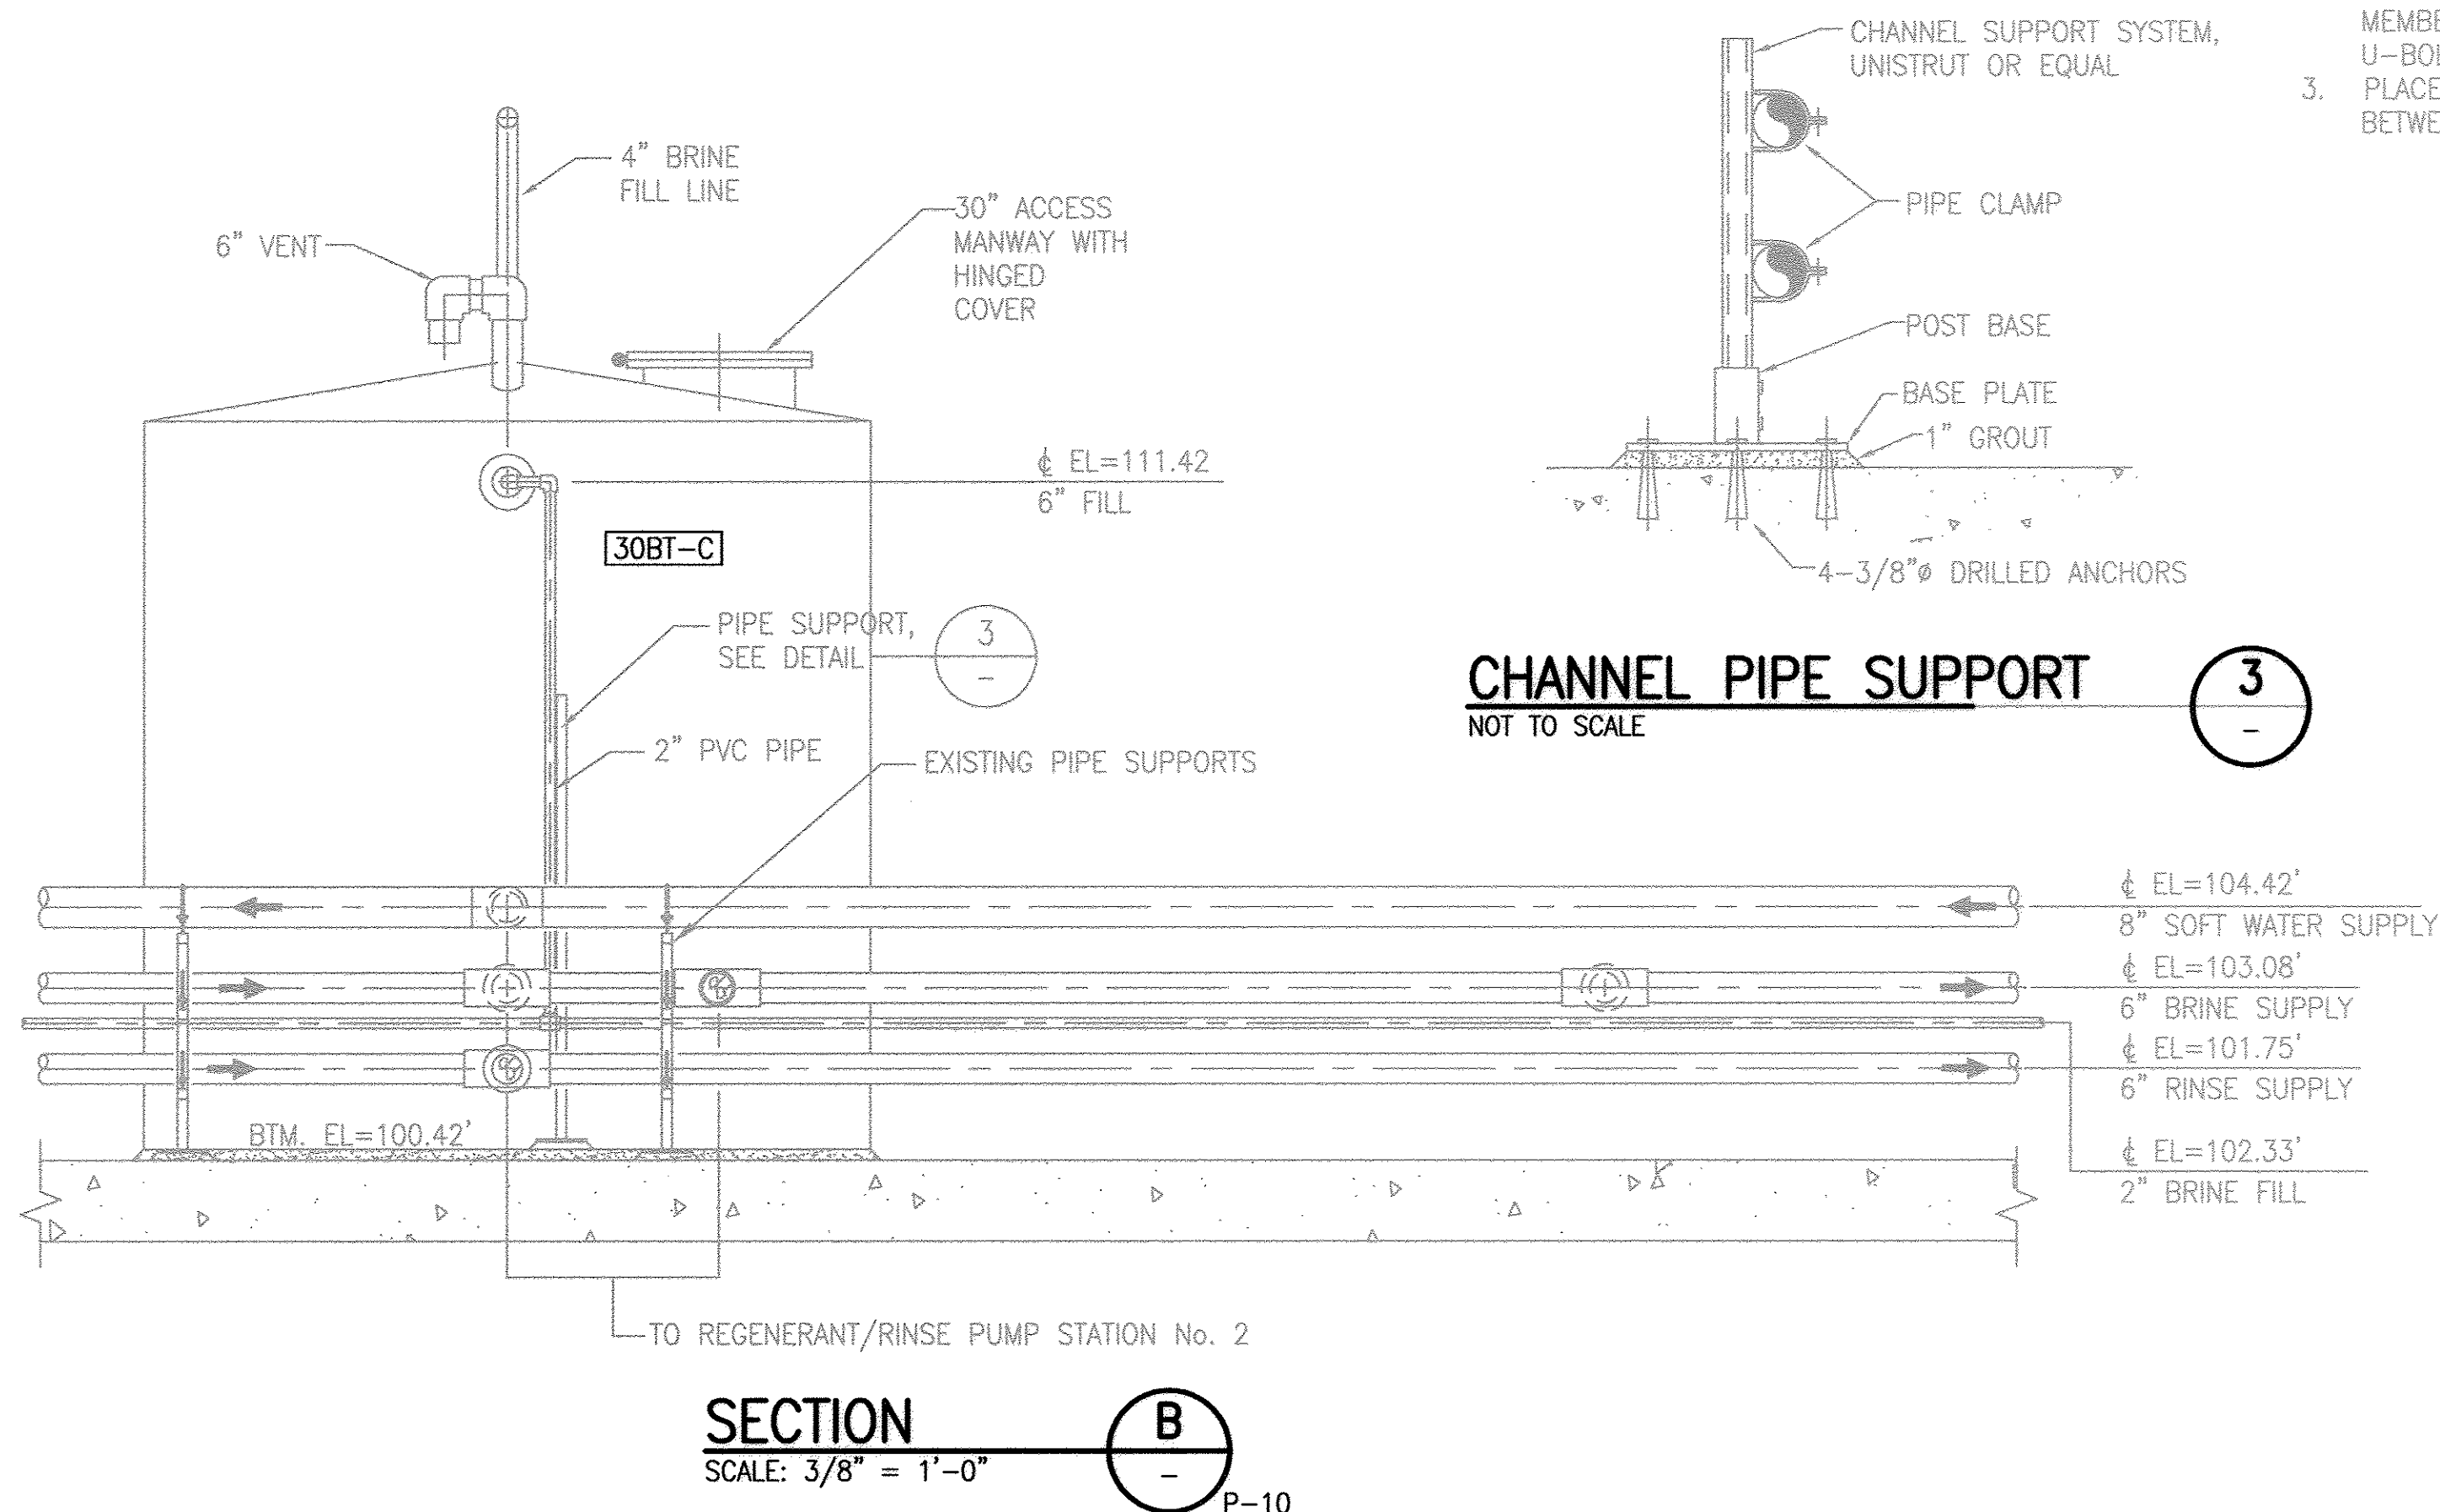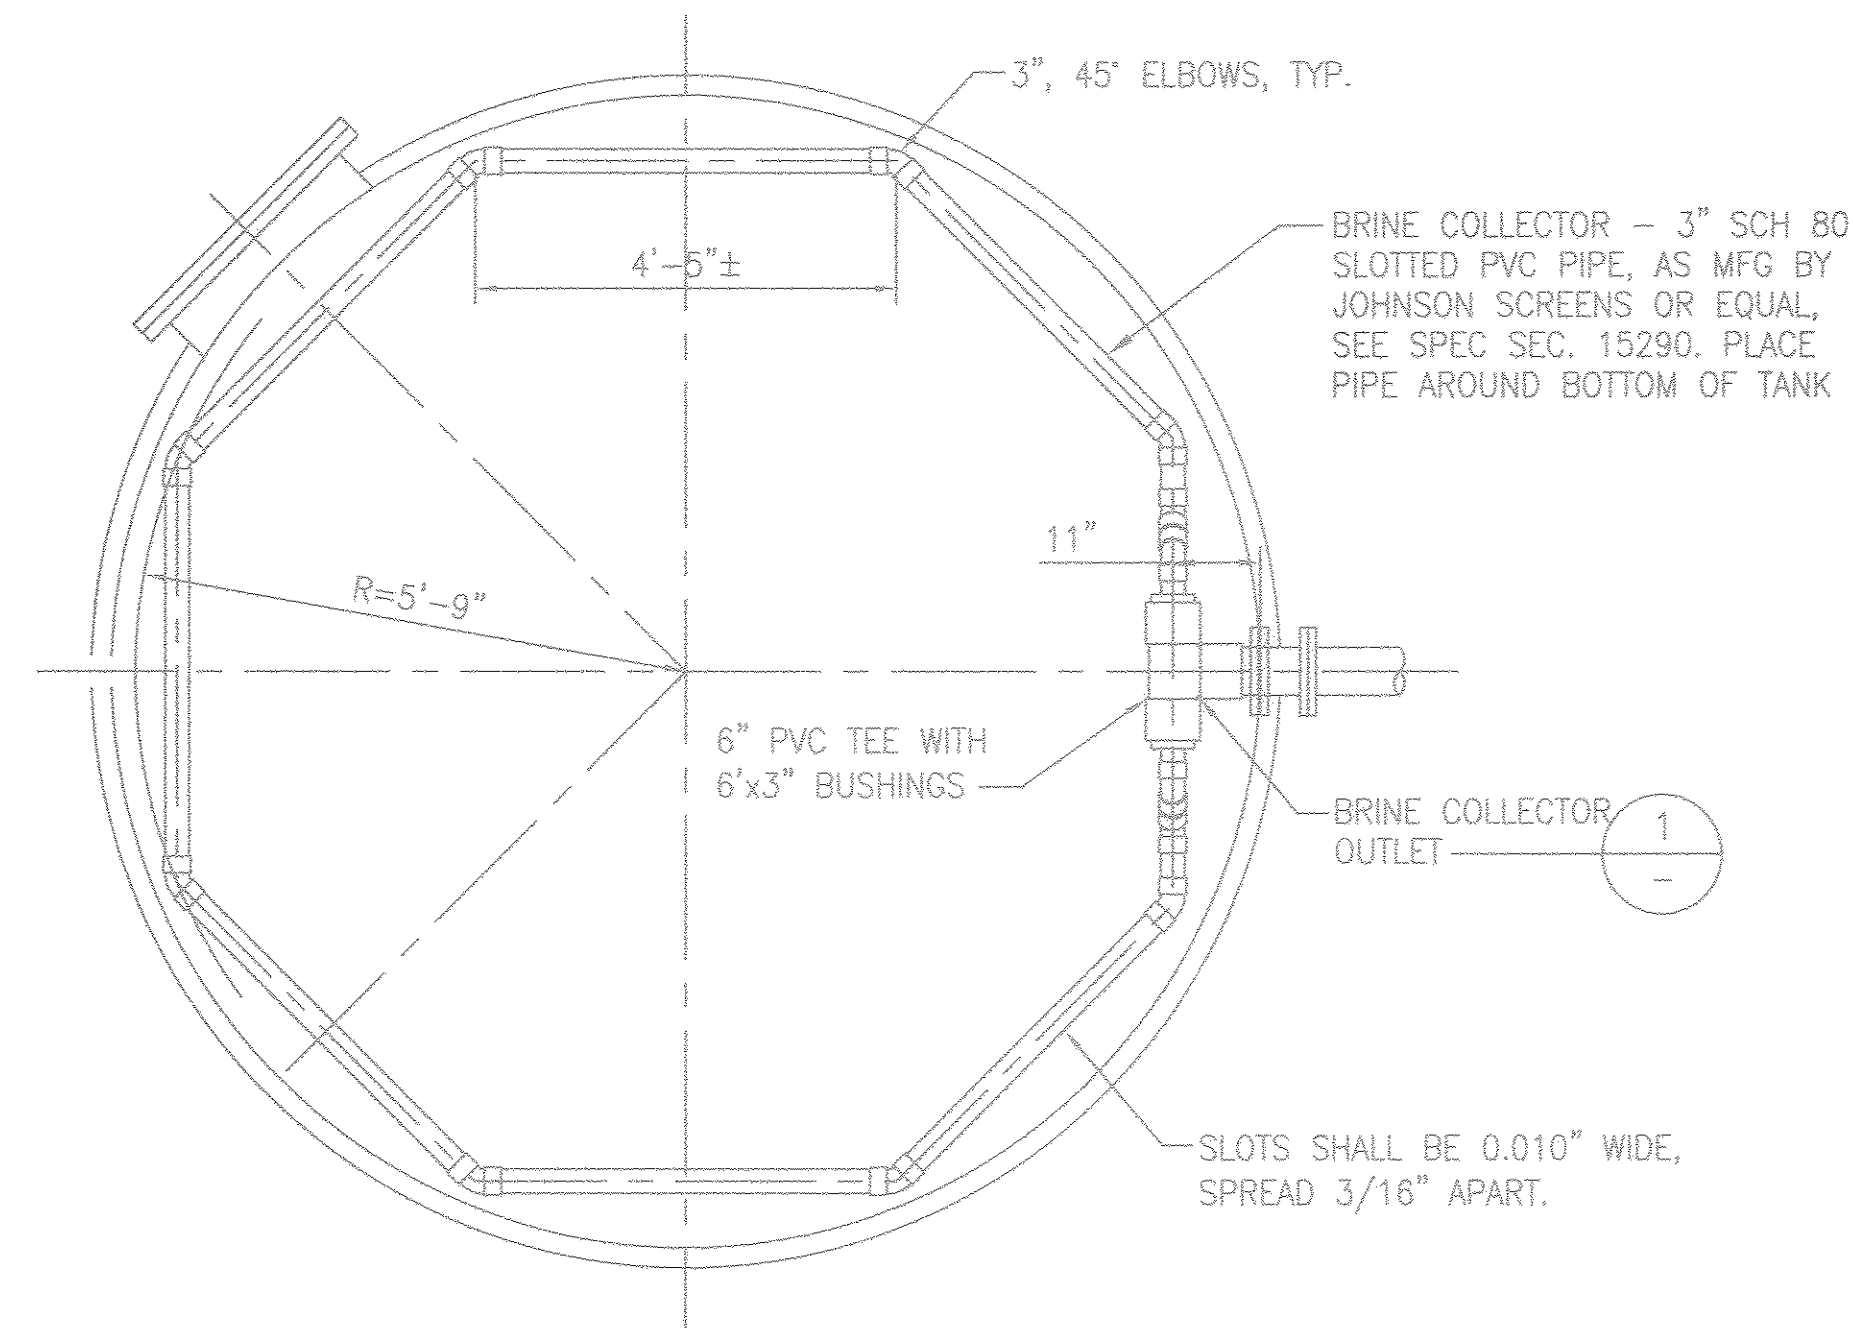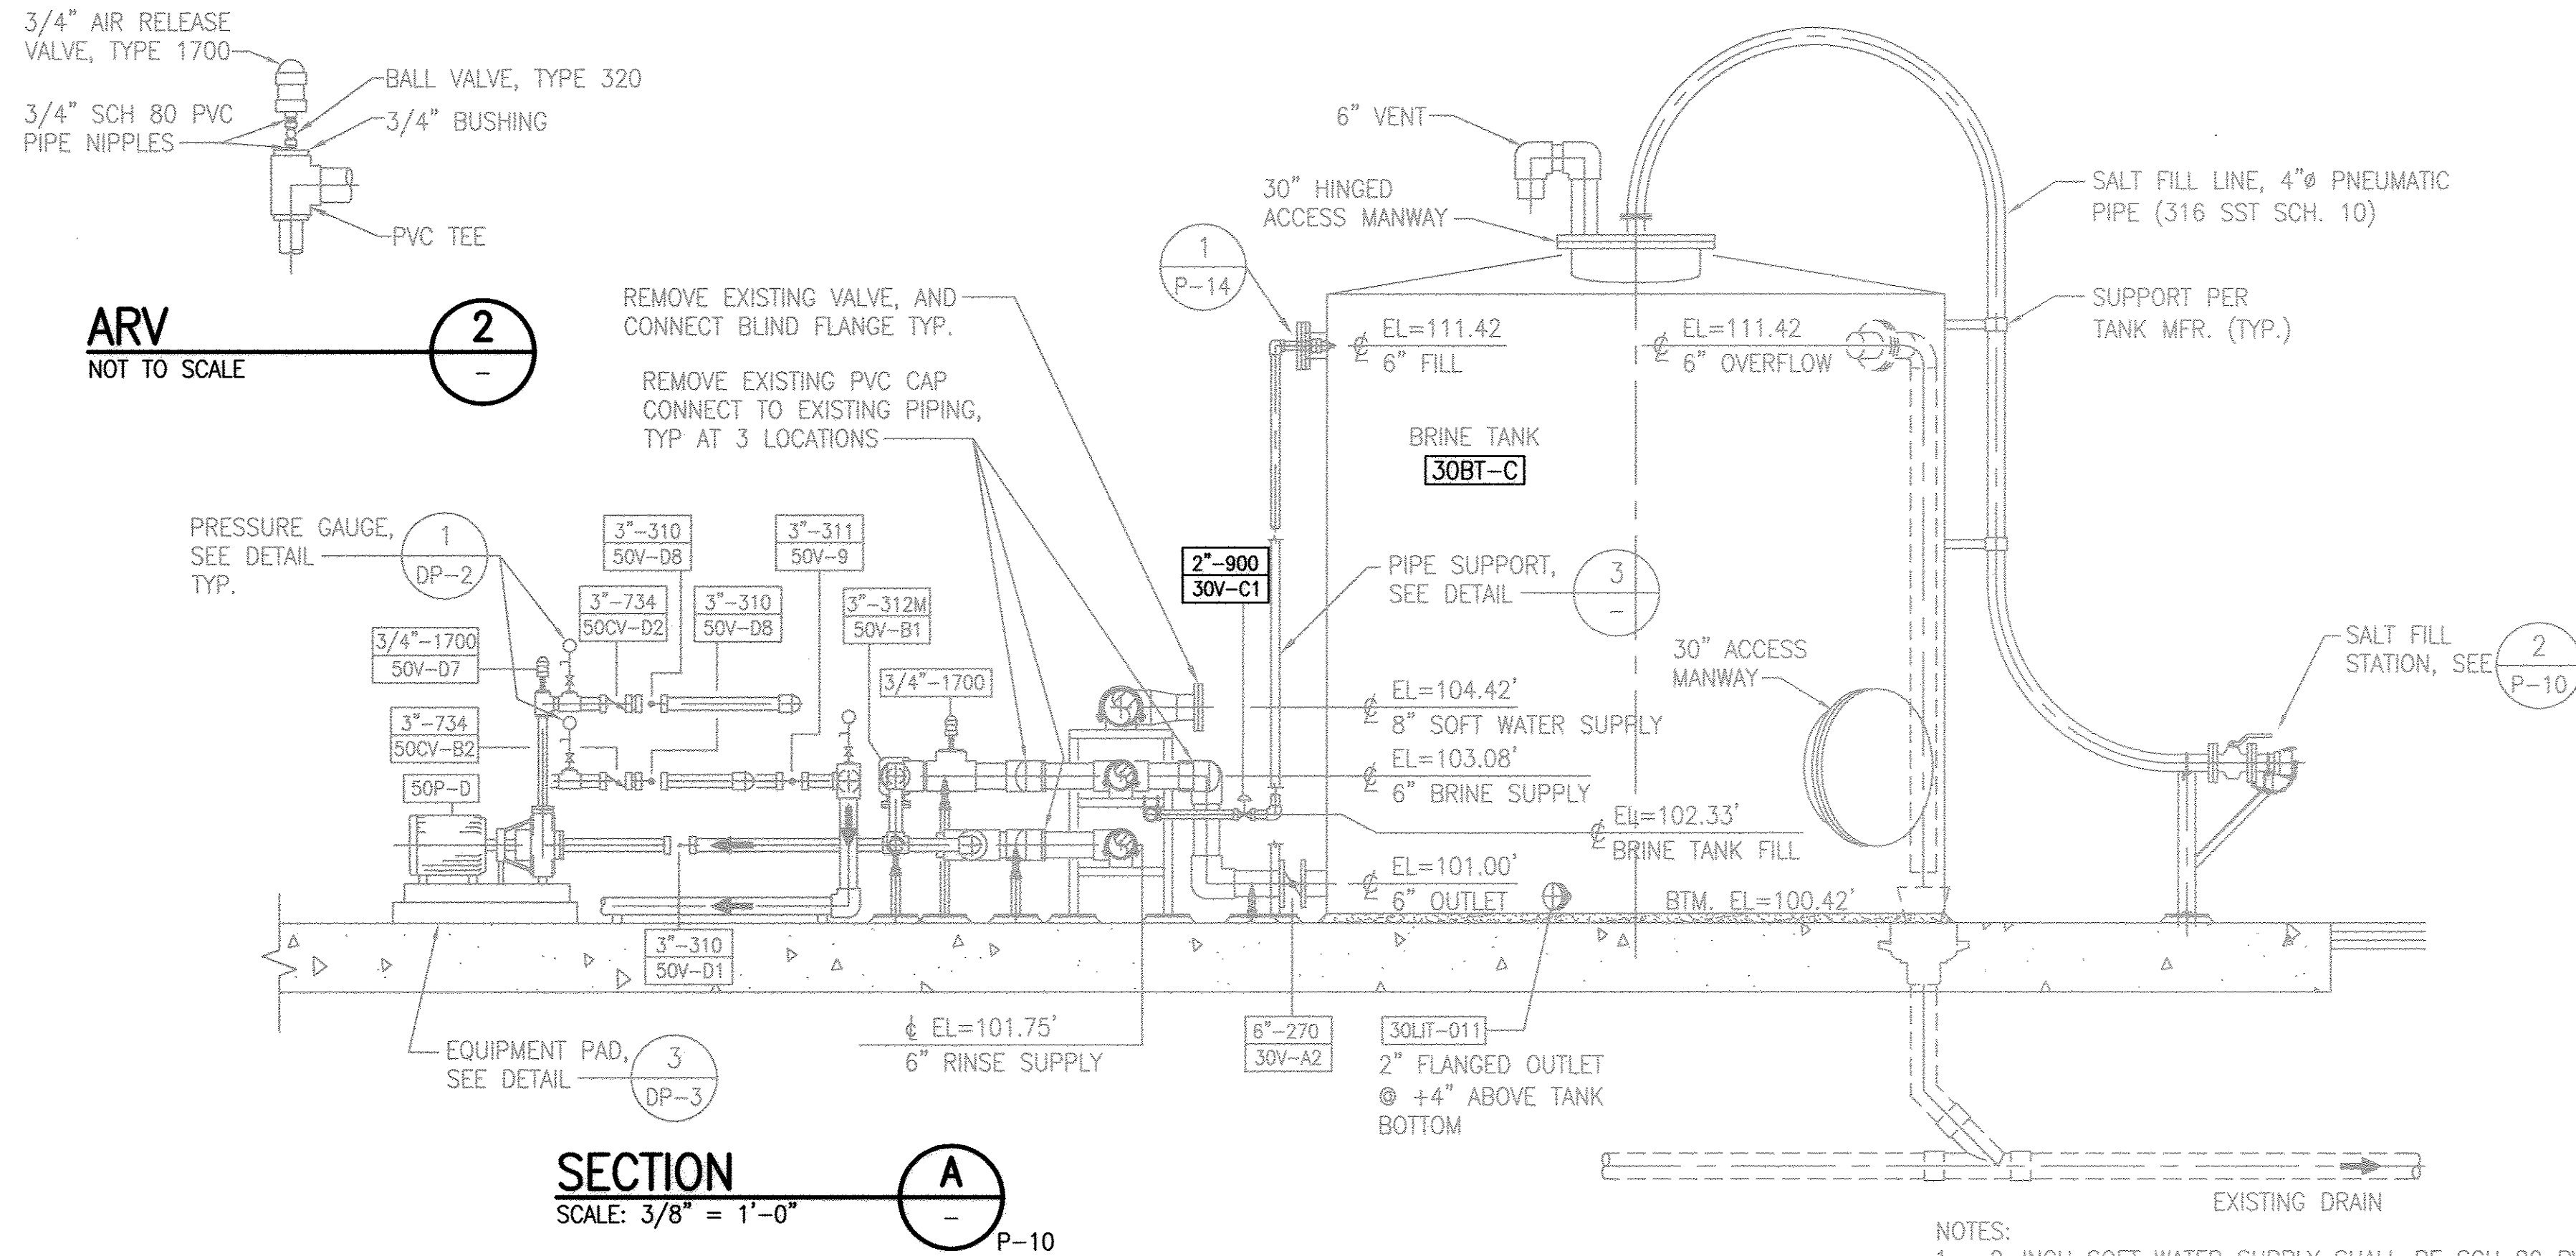





RECORD DRAWING
Date: 08-23-07
These record drawings apply only to those facilities constructed under the contract identified in the title block and have been prepared, in part, on the basis of information compiled and furnished by others. The Engineer/Architect will not be responsible for any errors or omissions which have been incorporated into this drawing as a result of the work by others.

DWG: S:\JOA\100-04-CAD (Phase III)\PlanSet\2268-P11.dwg
DATE: Nov 08, 2007 2:57pm
USER: klsford

VERIFY SCALES BAR IS ONE INCH ON ORIGINAL DRAWING 0 1 IF NOT ONE INCH ON THIS SHEET, ADJUST SCALES ACCORDINGLY	APPROVAL: DATE: DESIGN BY: CJM DRAWN BY: DTG CHECKED BY: DATE: AUGUST 2005	DATE: 5/10/06 CHANGE ORDER 1.1 3/1/07 CHANGE ORDER 1.2	REV DATE DESCRIPTION APP
--	---	---	-----------------------------------

BOYLE ENGINEERING CORPORATION


JURUPA COMMUNITY SERVICES DISTRICT ION EXCHANGE WATER TREATMENT PLANT - PHASE III BRINE TANK PIPING SECTIONS	DRAWING NO: P-11 FILE NO: S-2268	SHEET NO: 12 OF SHEETS
--	---	---------------------------------

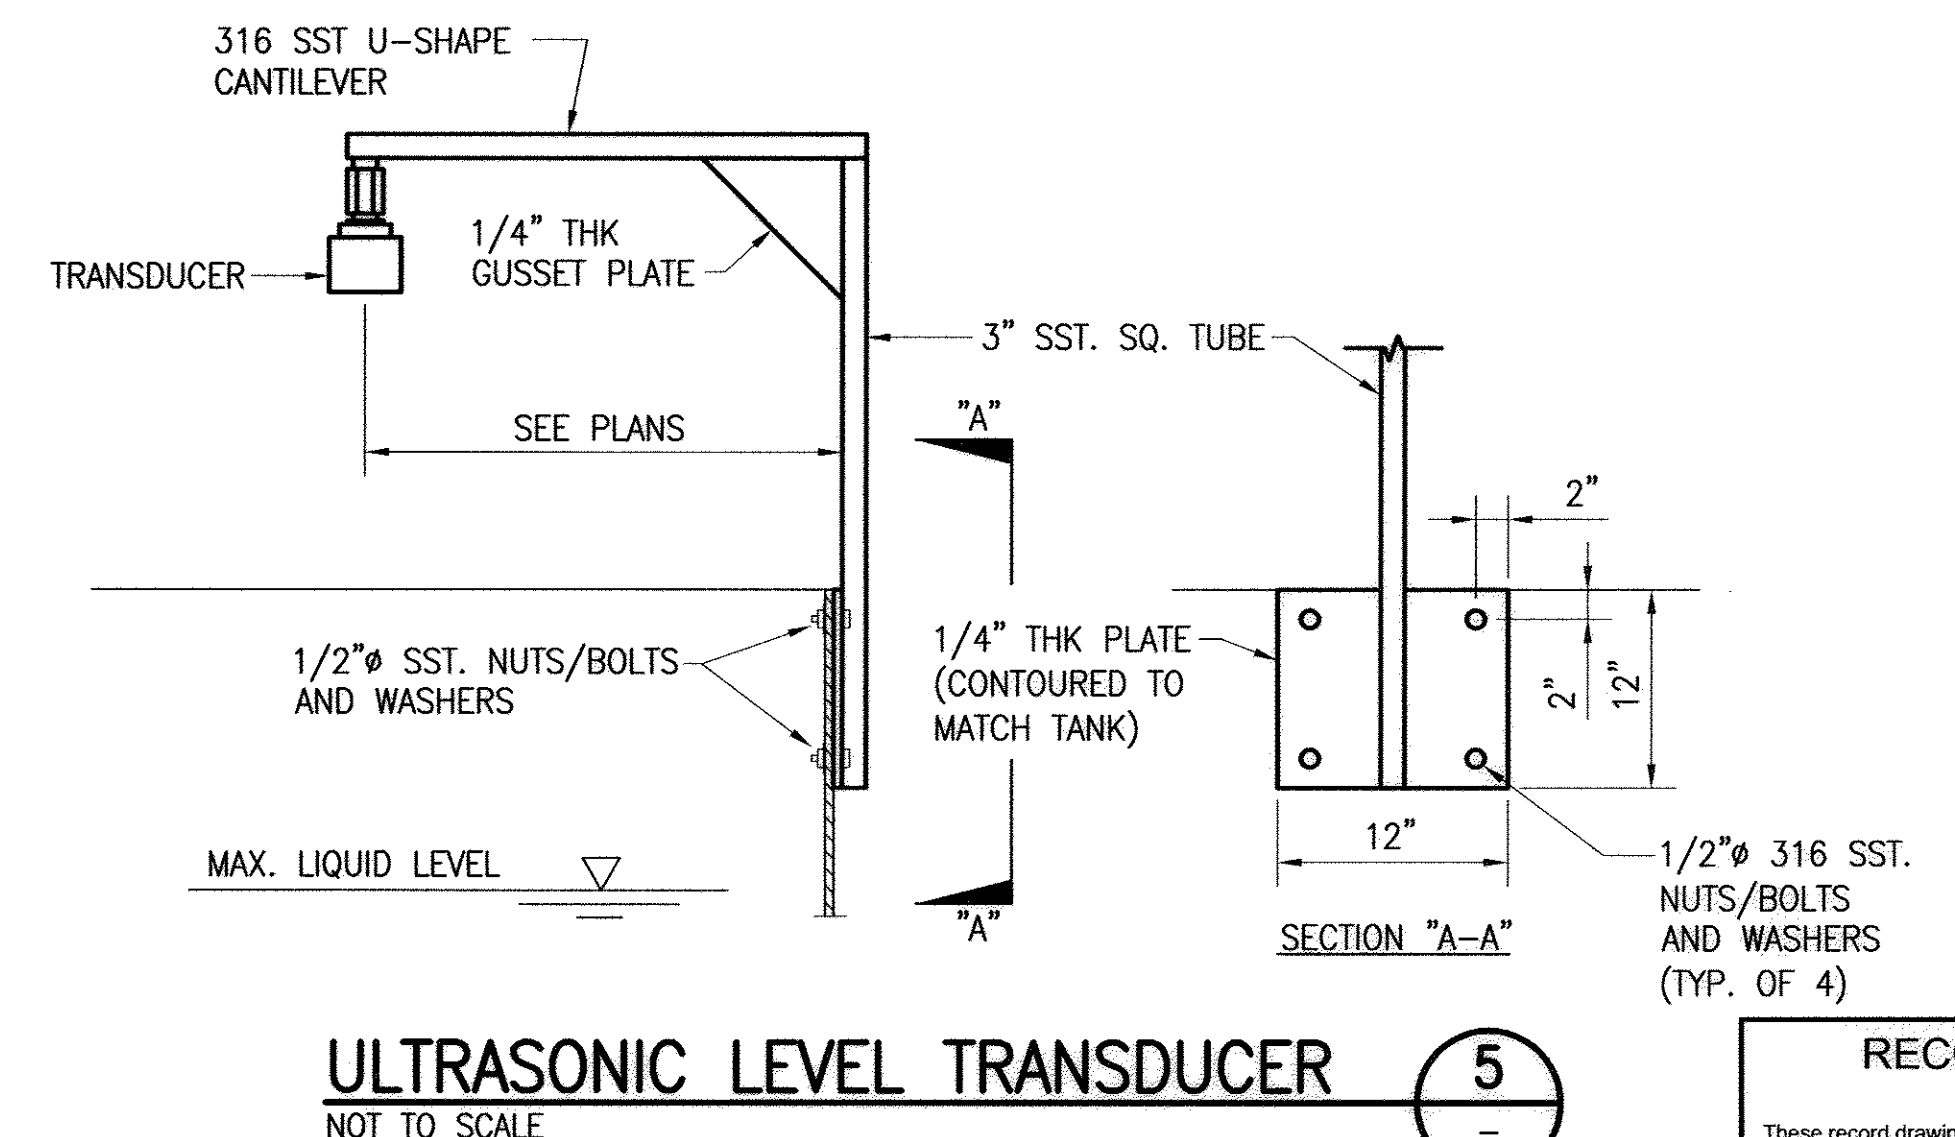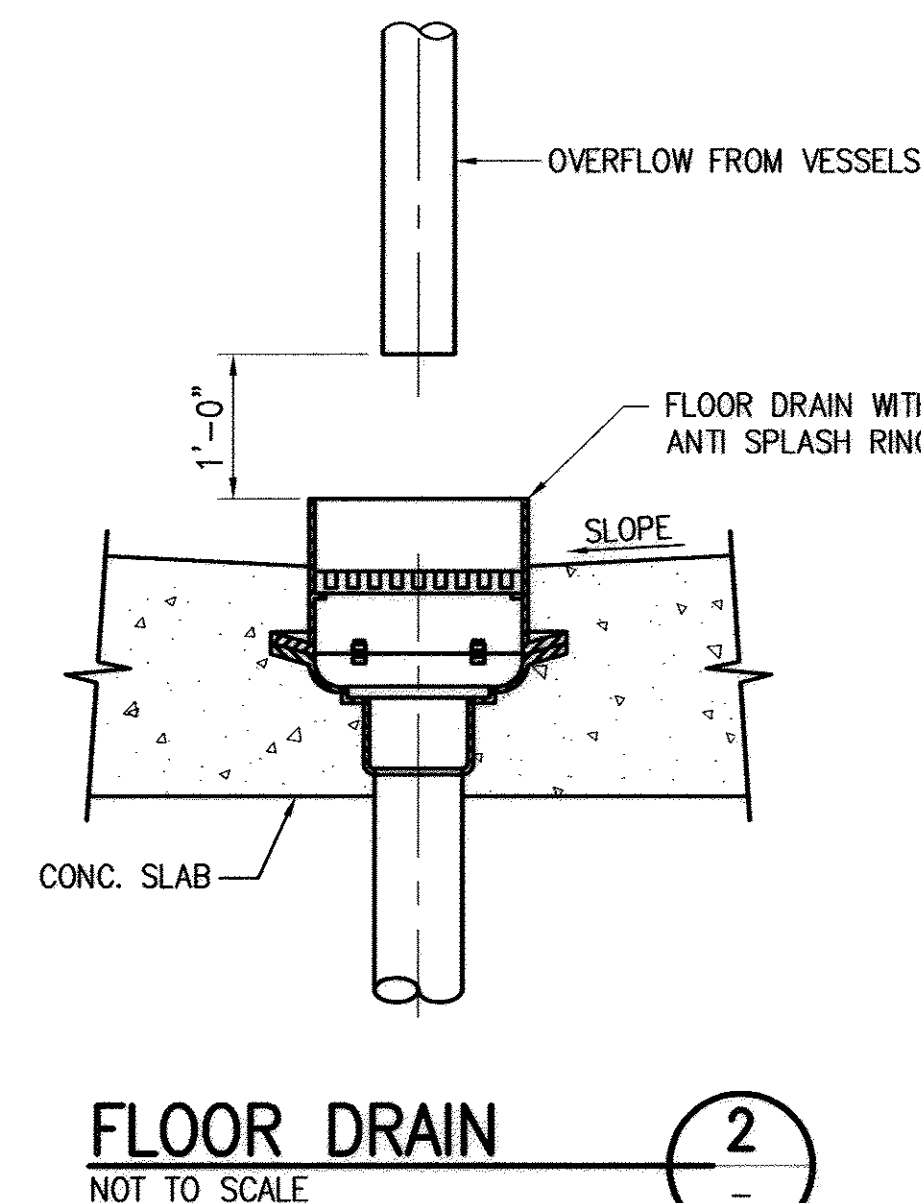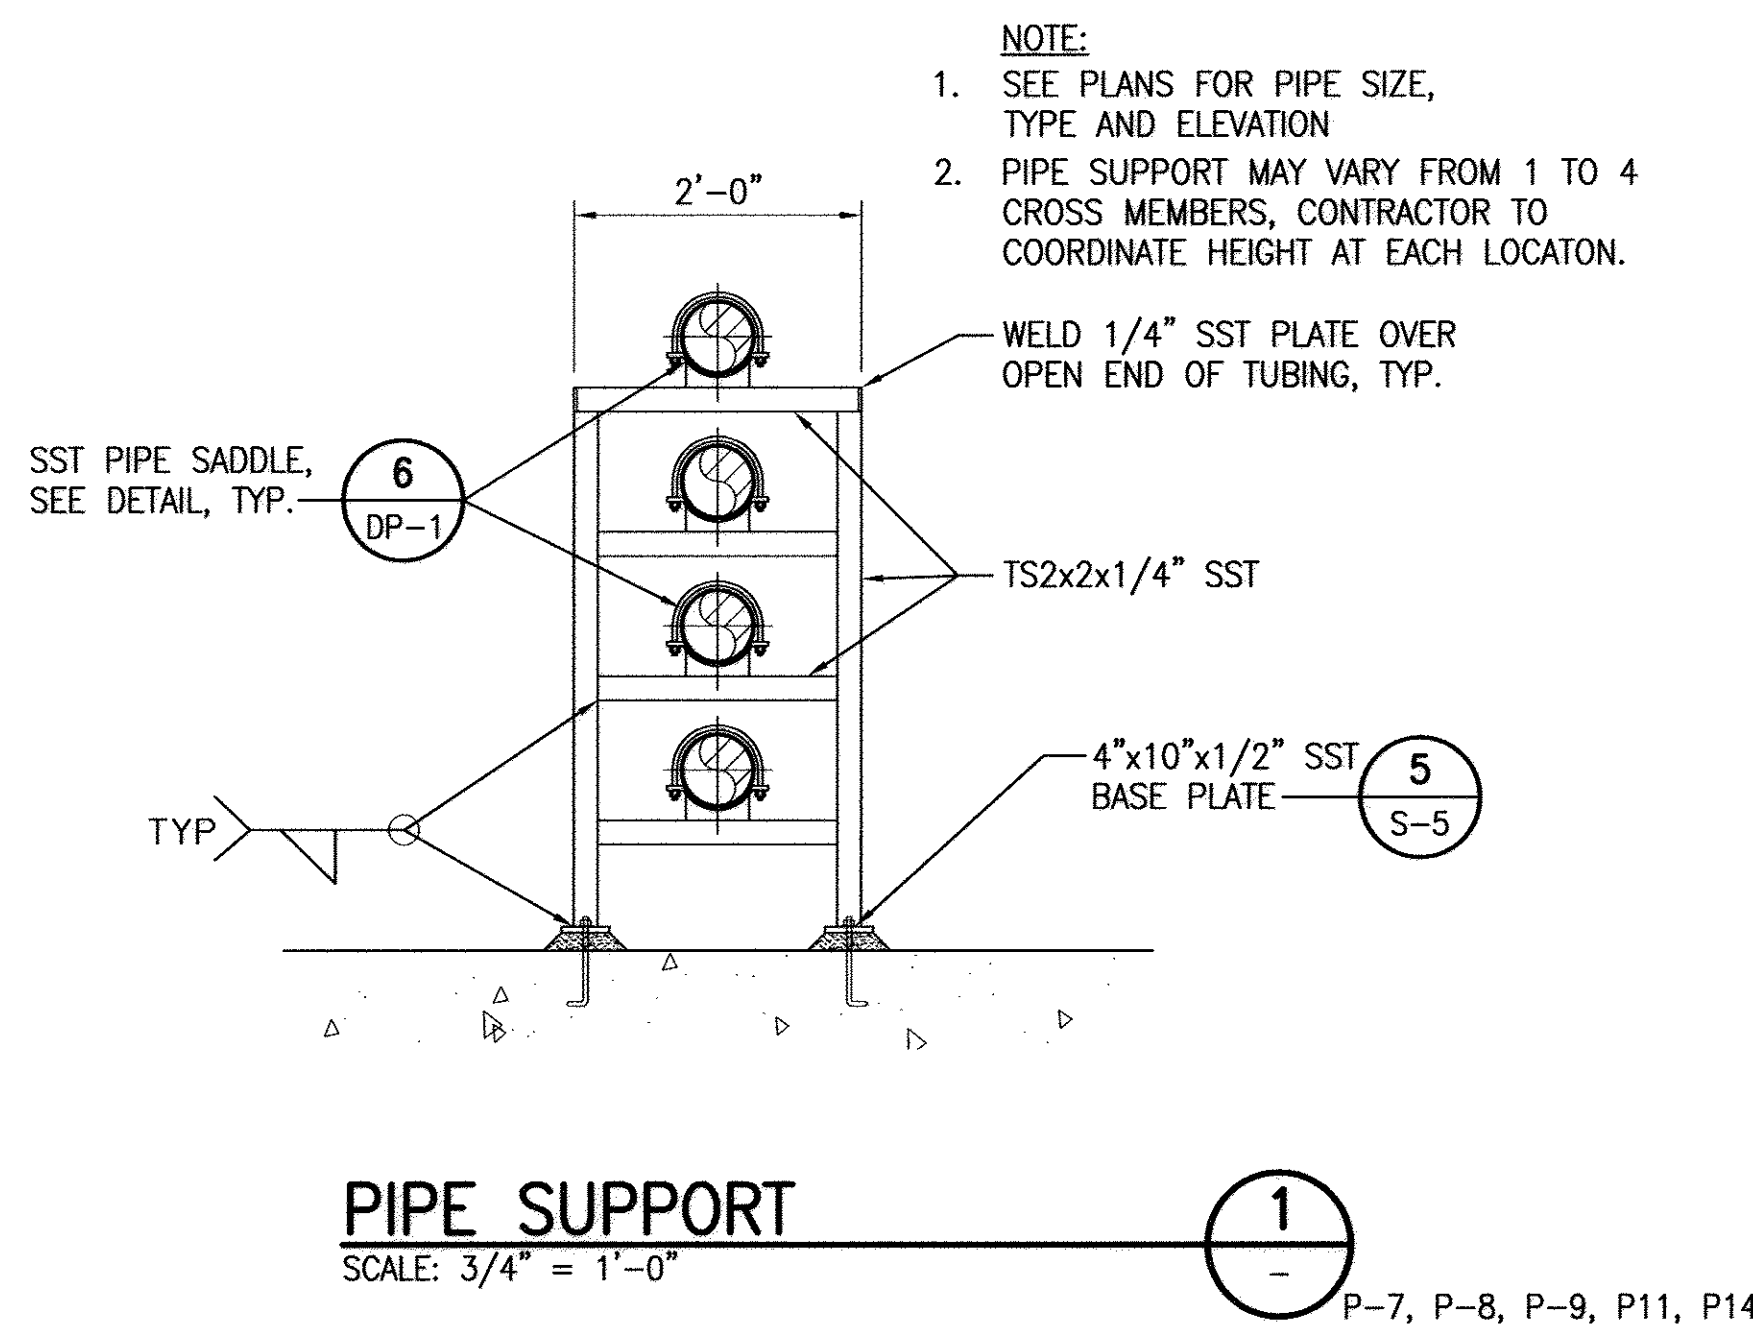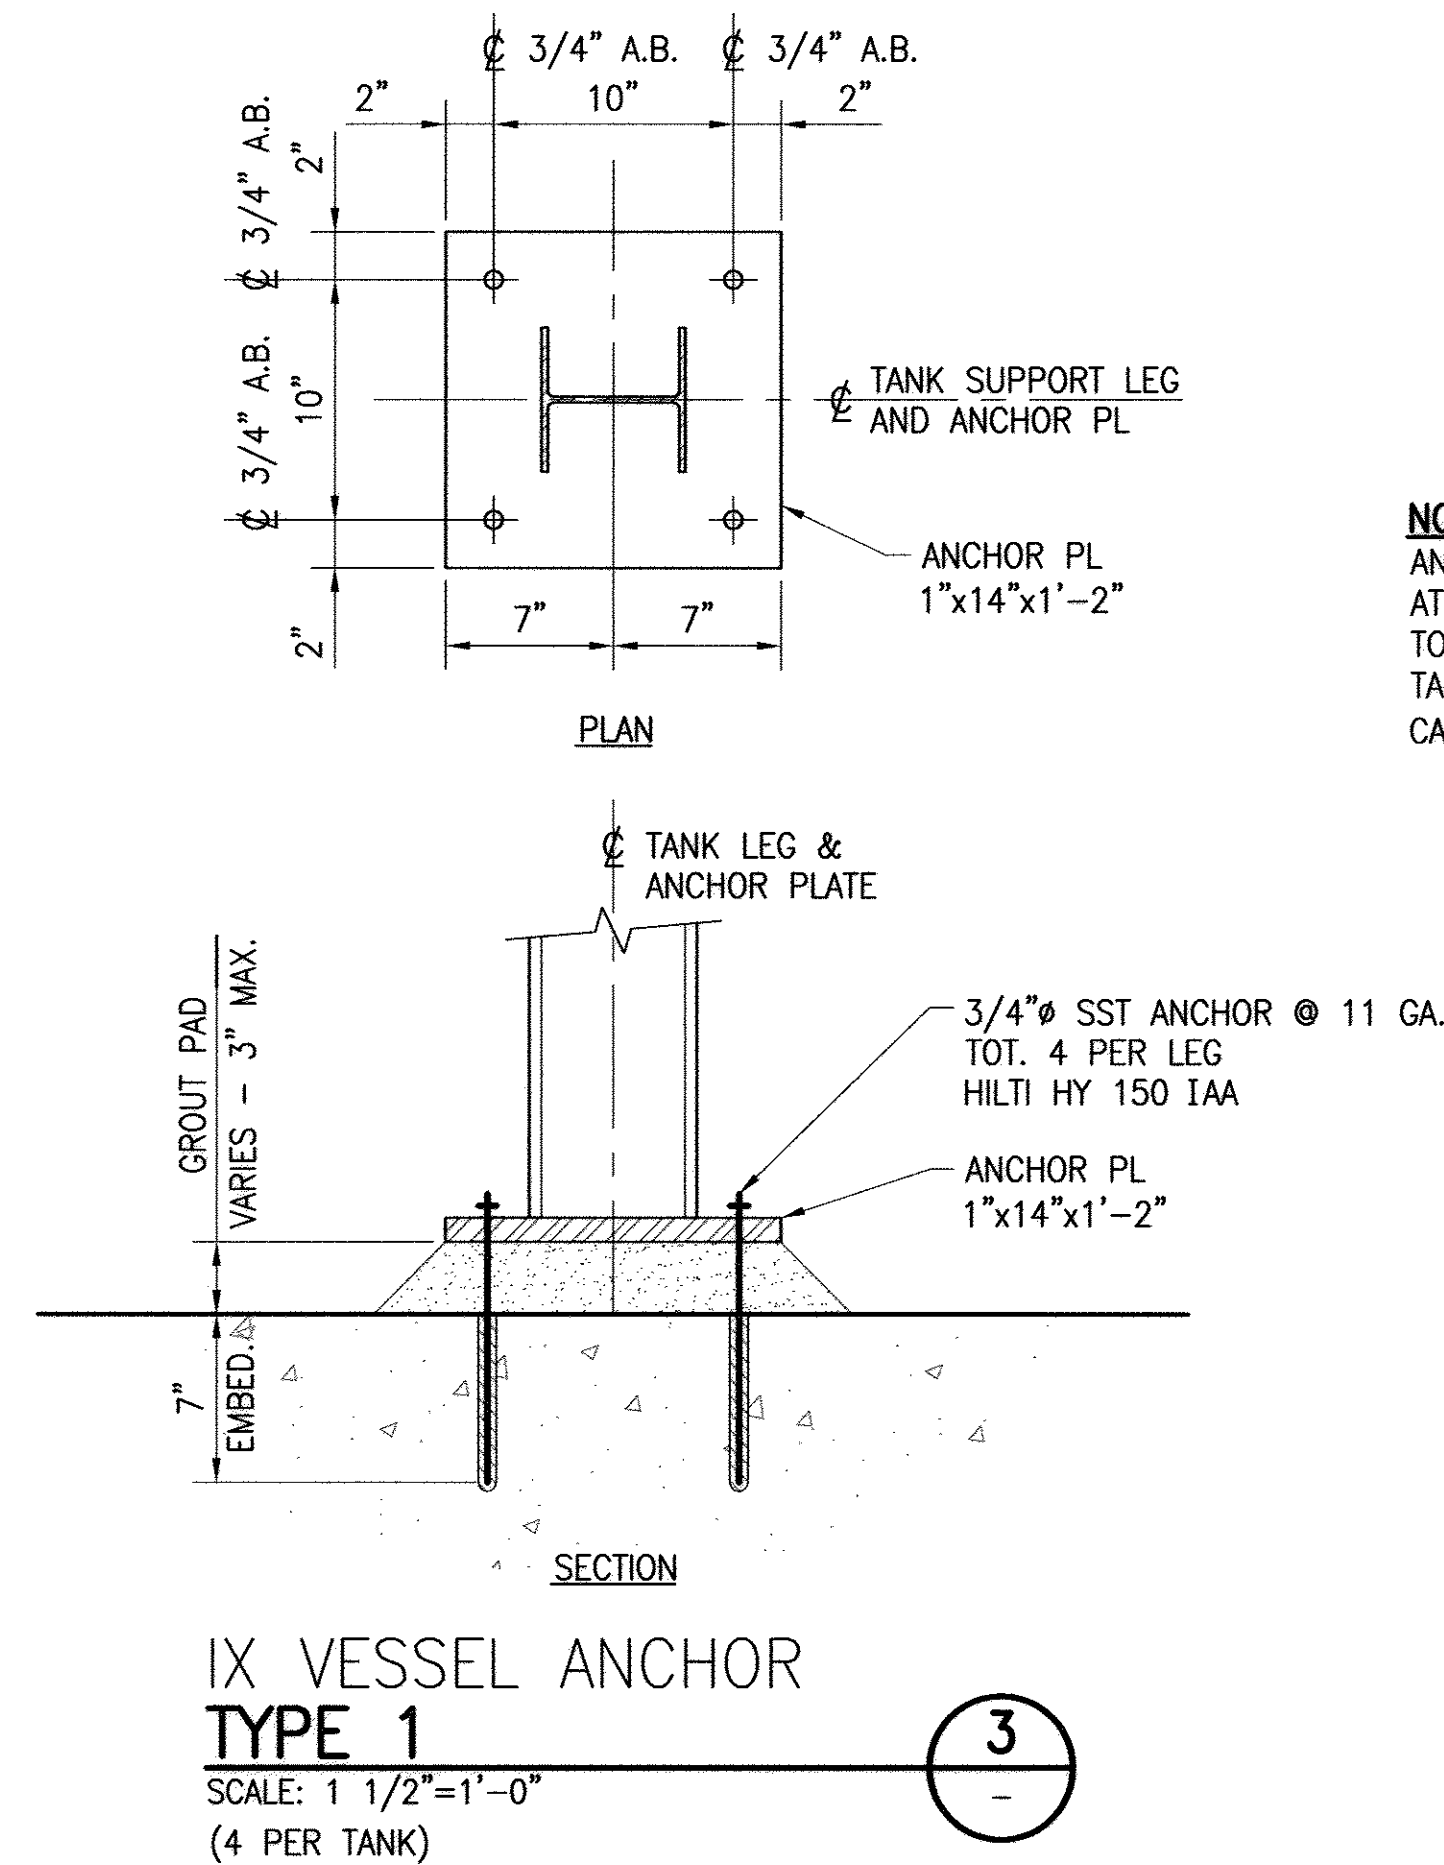

RECORD DRAWING


Date: 08-23-07

These record drawings apply only to those facilities constructed under the contract identified in the title block and have been prepared, in part, on the basis of information compiled and furnished by others. The Engineer/Architect will not be responsible for any errors or omissions which have been incorporated into this drawing as a result of the work by others.

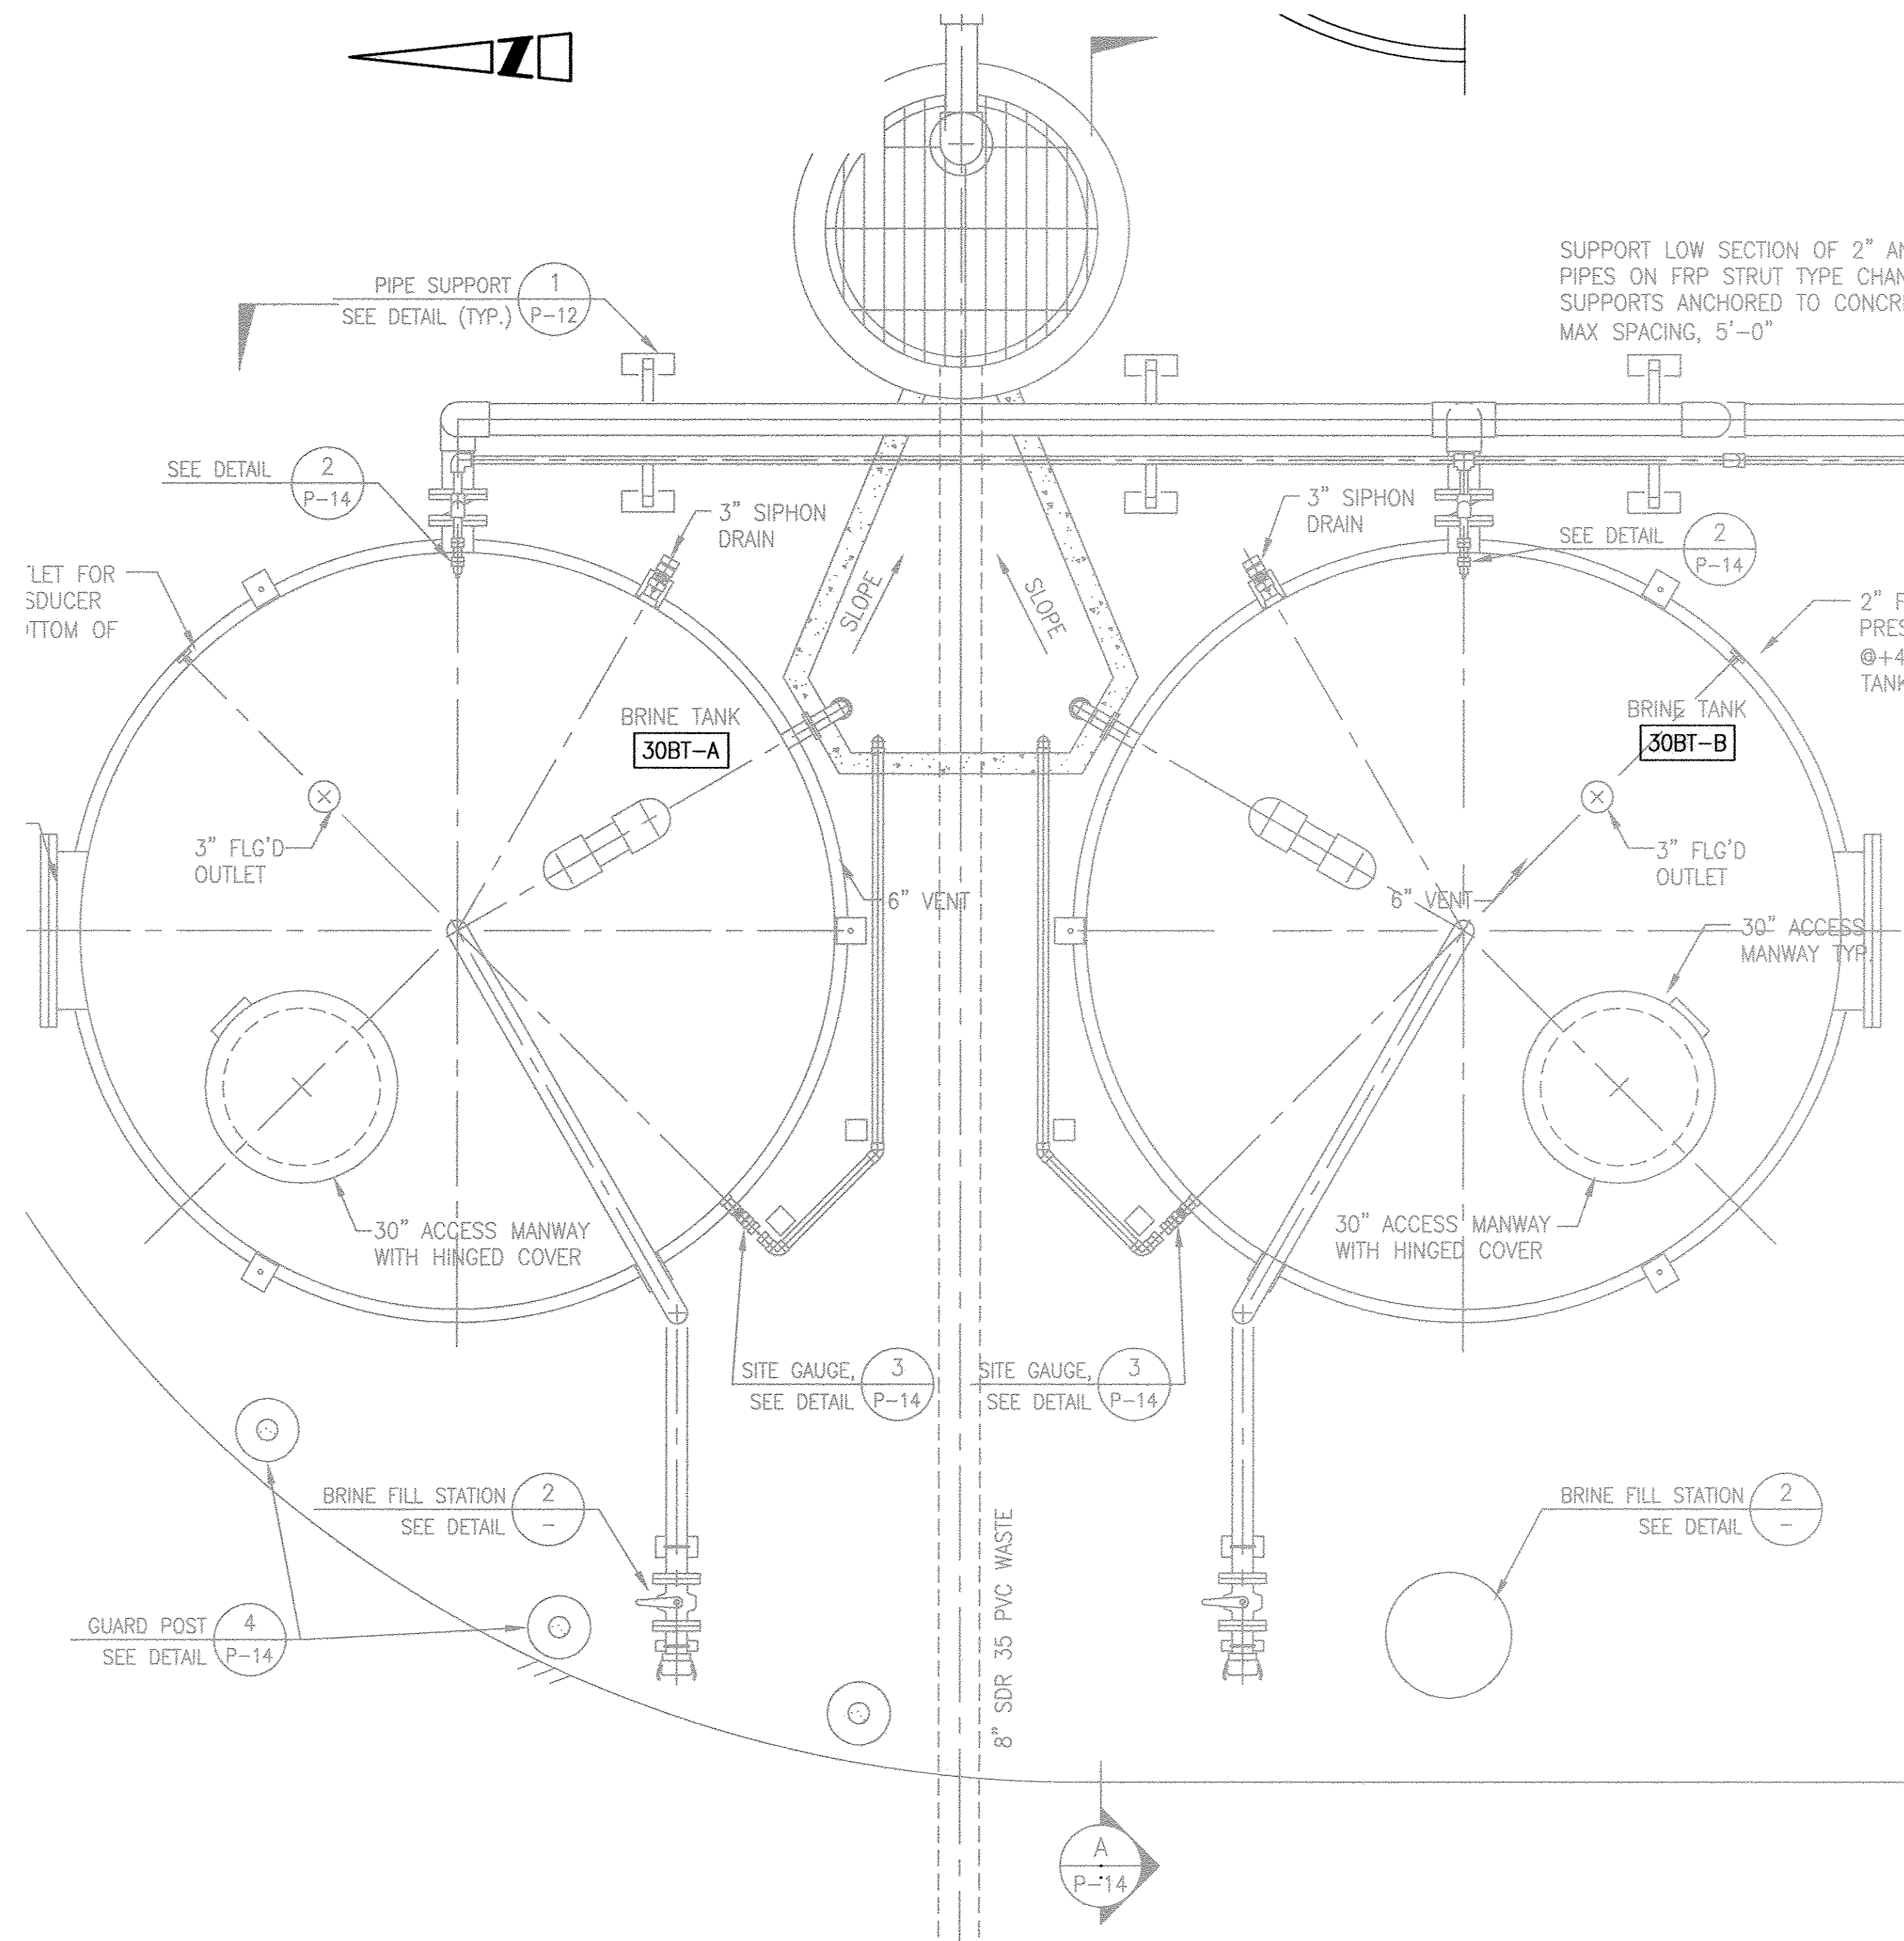

BRINE TANK PLAN
SCALE: 1/2" = 1'-0"

1
-

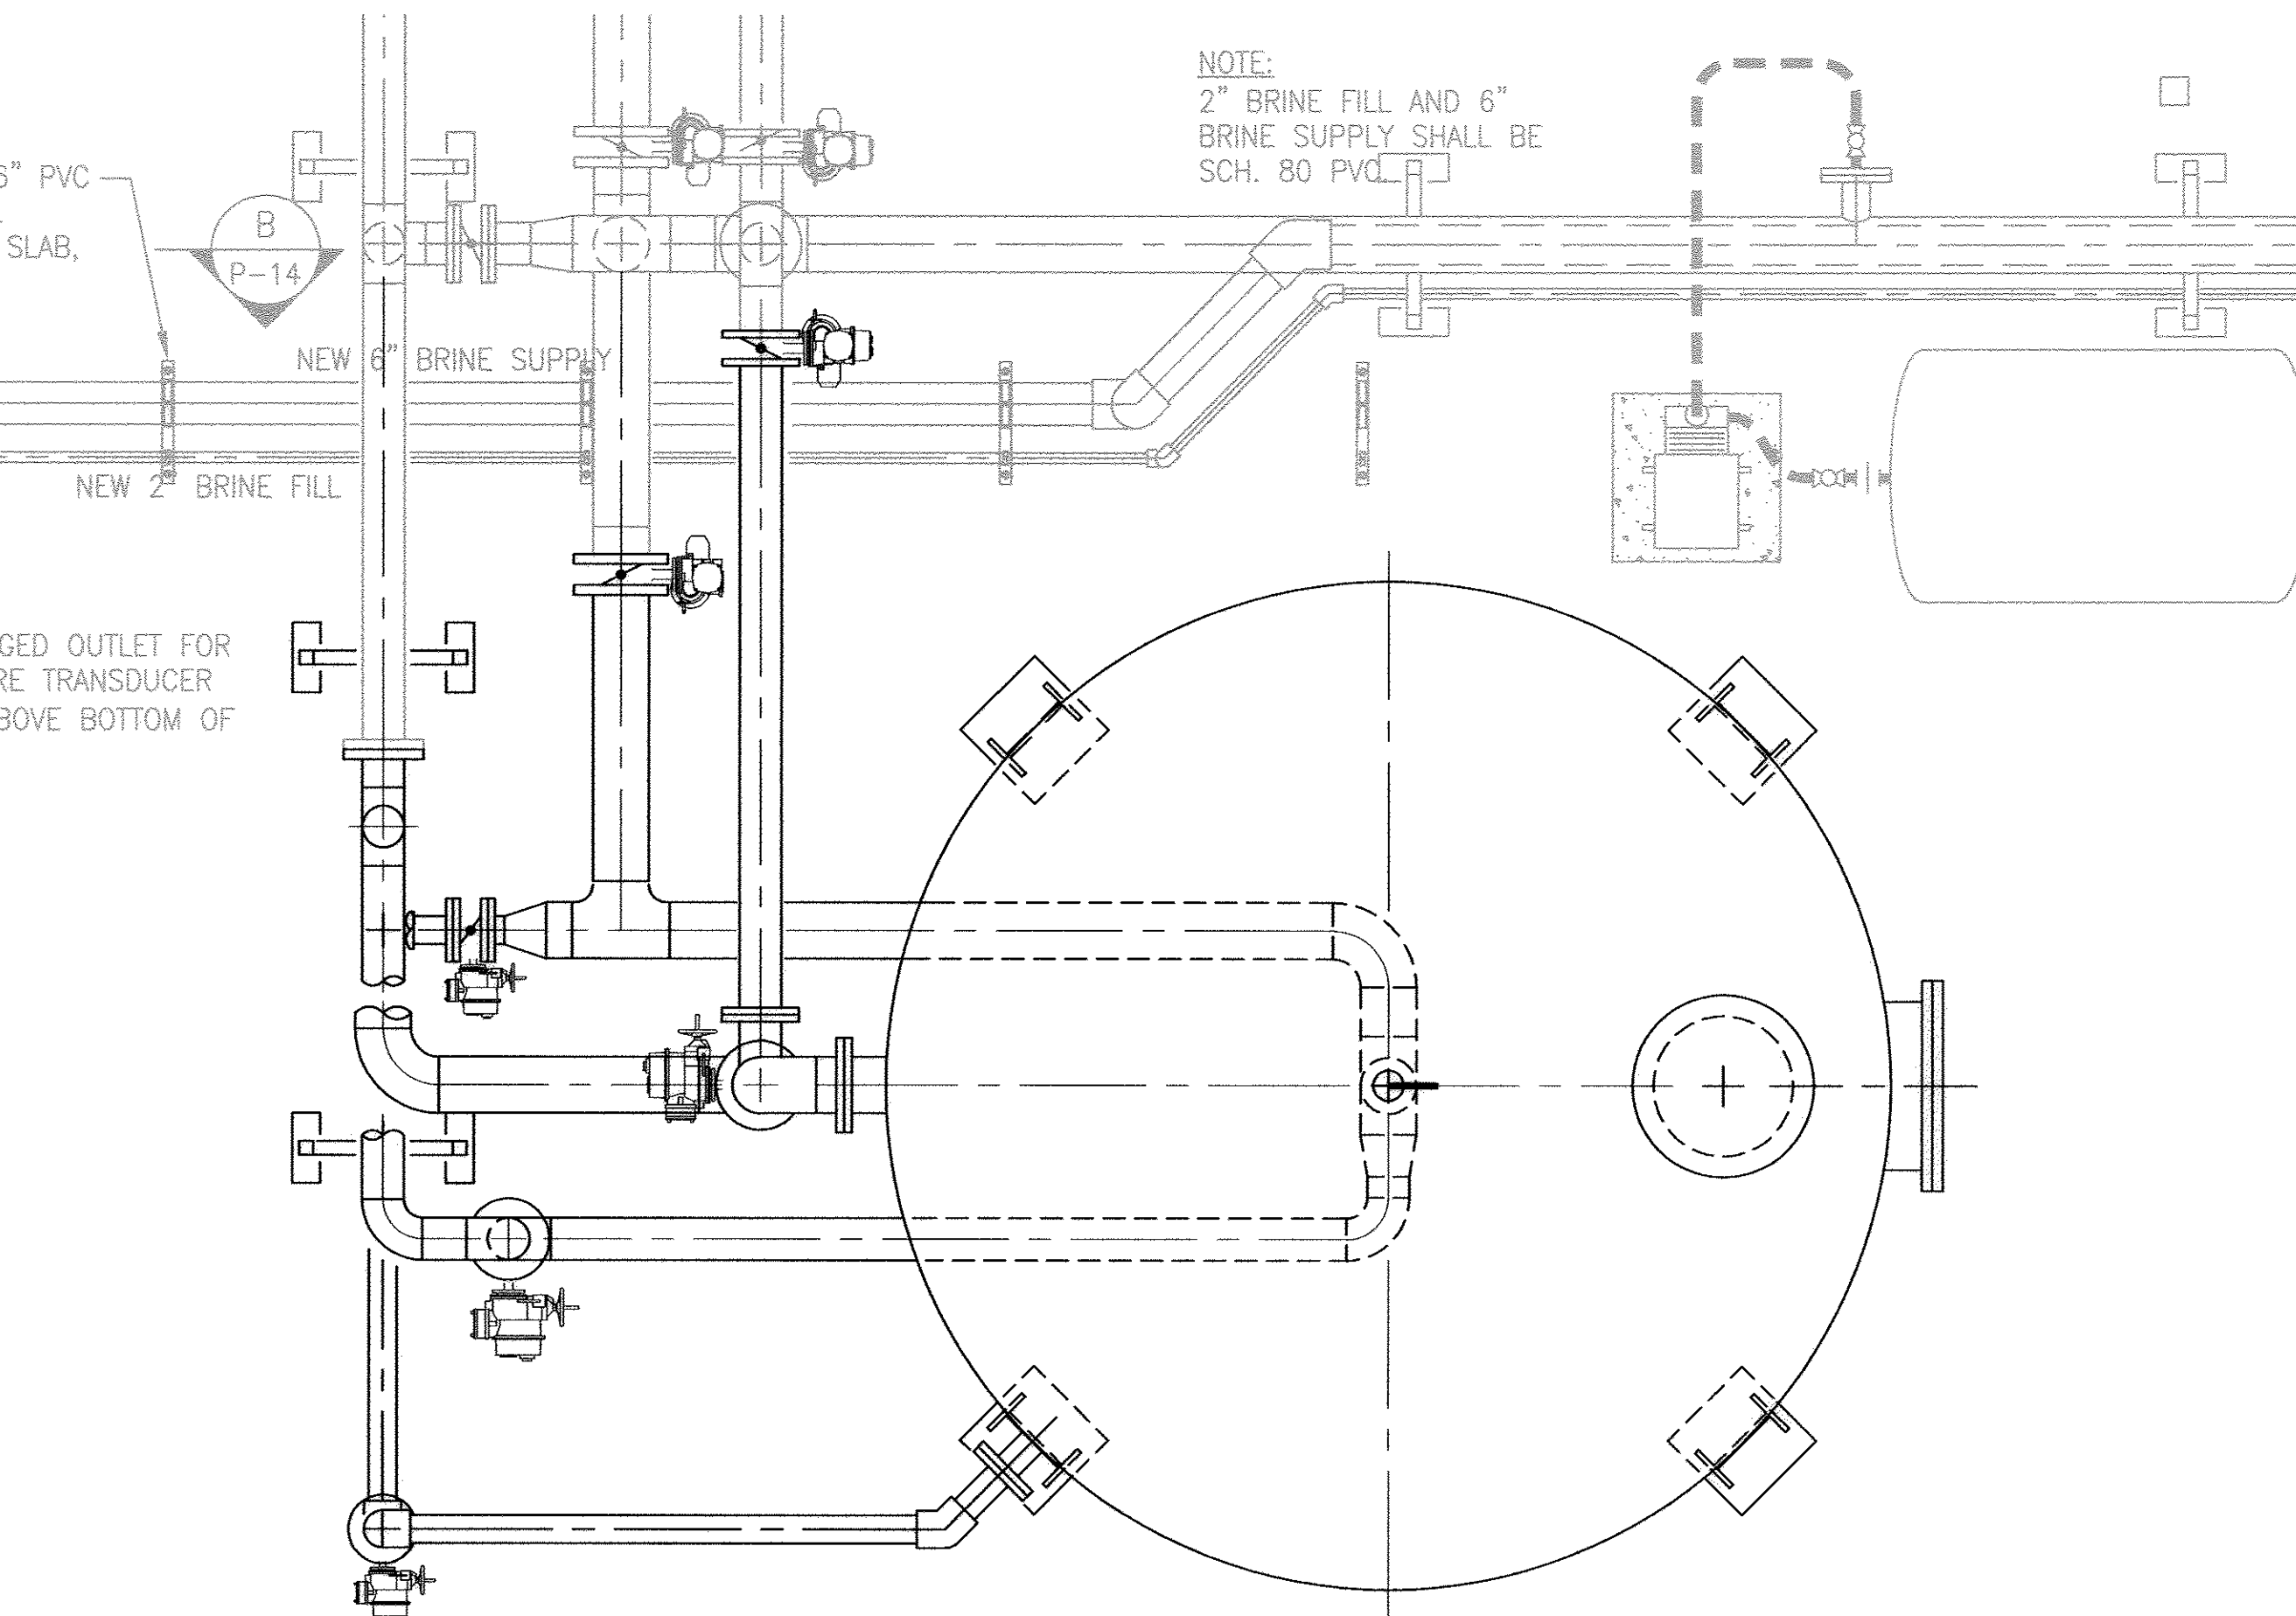


FLANGE SCHEDULE			30BT-B	30BT-A
SALT FILL LINE	4"	ELEV. (CENTERLINE) ROOF (CENTER)	-	-
SITE GAUGE (TOP)	2"	6" BELOW TOP OF SIDEWALL	60'	300'
SITE GAUGE (BOTTOM)	2"	8" ABOVE TANK FLOOR	60'	300'
VENT	6"	ROOF (24" FROM CENTER)	120'	240'
OVERFLOW	3"	6" BELOW TOP OF SIDEWALL	120'	240'
SIPHON DRAIN	3"	4" ABOVE TANK FLOOR	150'	210'
2" BRINE FILL	2"	6" BELOW TOP OF SIDEWALL	180'	180'
BRINE OUTLET	6"	8" ABOVE TANK FLOOR	180'	180'
LEVEL TRANSMITTER	3"	ROOF (36" FROM CENTER)	240'	120'
PRESSURE TRANSDUCER	2"	4" ABOVE TANK FLOOR	240'	120'
MANWAY	30"	30" ABOVE TANK FLOOR	270'	90'
MANWAY	30"	ROOF (48" FROM CENTER)	315'	45'

* SUPPORT FOR BRINE FILL LINE SHALL SPAN NO MORE THAN 5' APART. SEE DETAIL

A
P-14

* INSTALL BRINE COLLECTORS WITHIN NEW BRINE TANKS. SEE DETAIL

C
P-11

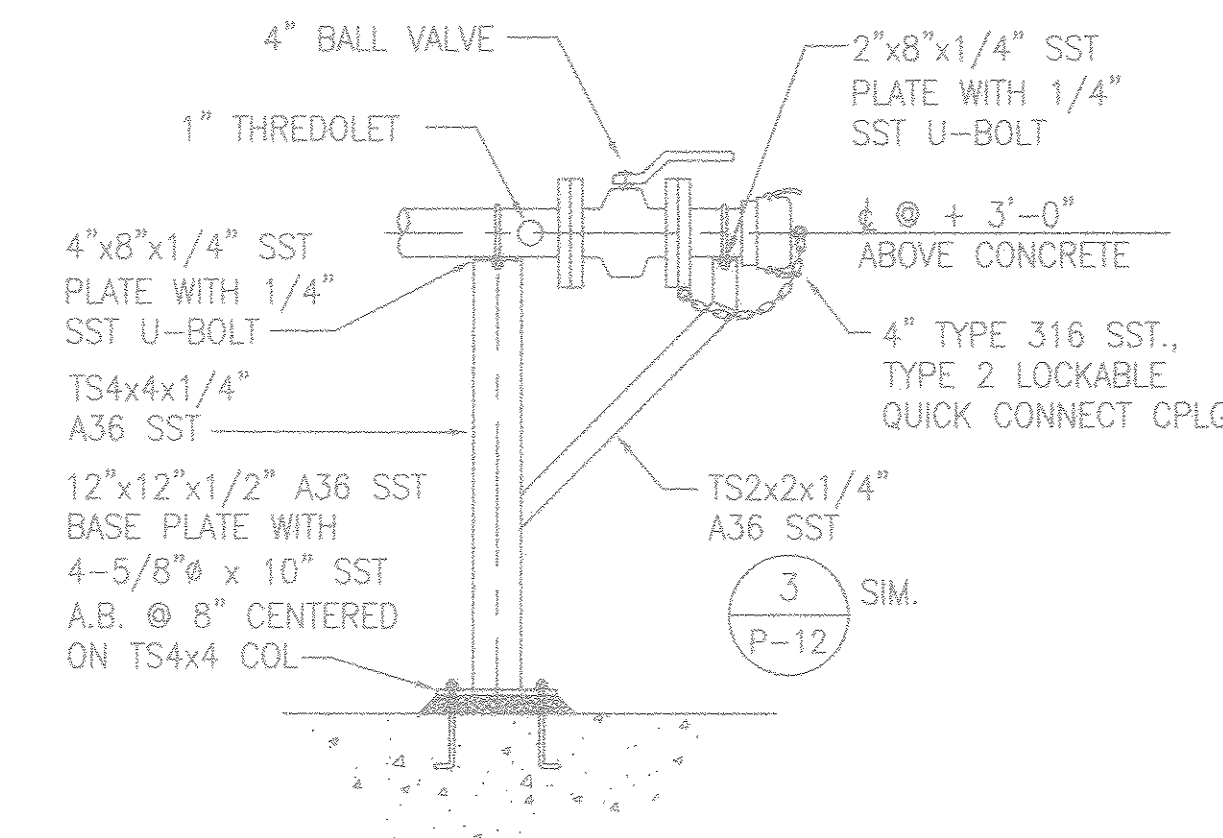

SALT FILL STATION DETAIL
SCALE: 3/4" = 1'-0"

2
-

DWG: S:\DATA\100-04-CAD (press) \11\PlanSet\S2268-P13.dwg USER: kbsford
 DATE: Nov 08, 2007 3:18pm XREFS: S2268DR

VERIFY SCALES
BAR IS ONE INCH ON ORIGINAL DRAWING
0 1
IF NOT ONE INCH ON THIS SHEET,
ADJUST SCALES ACCORDINGLY


APPROVAL: _____ DATE: _____
 APPROVAL: _____ DATE: _____
 APPROVAL: _____ DATE: _____

DESIGN BY: CJM 5/10/06 CHANGE ORDER
 DRAWN BY: ECM 3/01/07 CHANGE ORDER 1.2
 CHECKED BY: _____
 DATE: APRIL 2006


BOYLE ENGINEERING CORPORATION

JURUPA COMMUNITY SERVICES DISTRICT
 ION EXCHANGE WATER TREATMENT PLANT - PHASE III
NEW BRINE TANKS


DRAWING NO: **P-13** SHEET NO: **14**
 FILE NO: S-2268

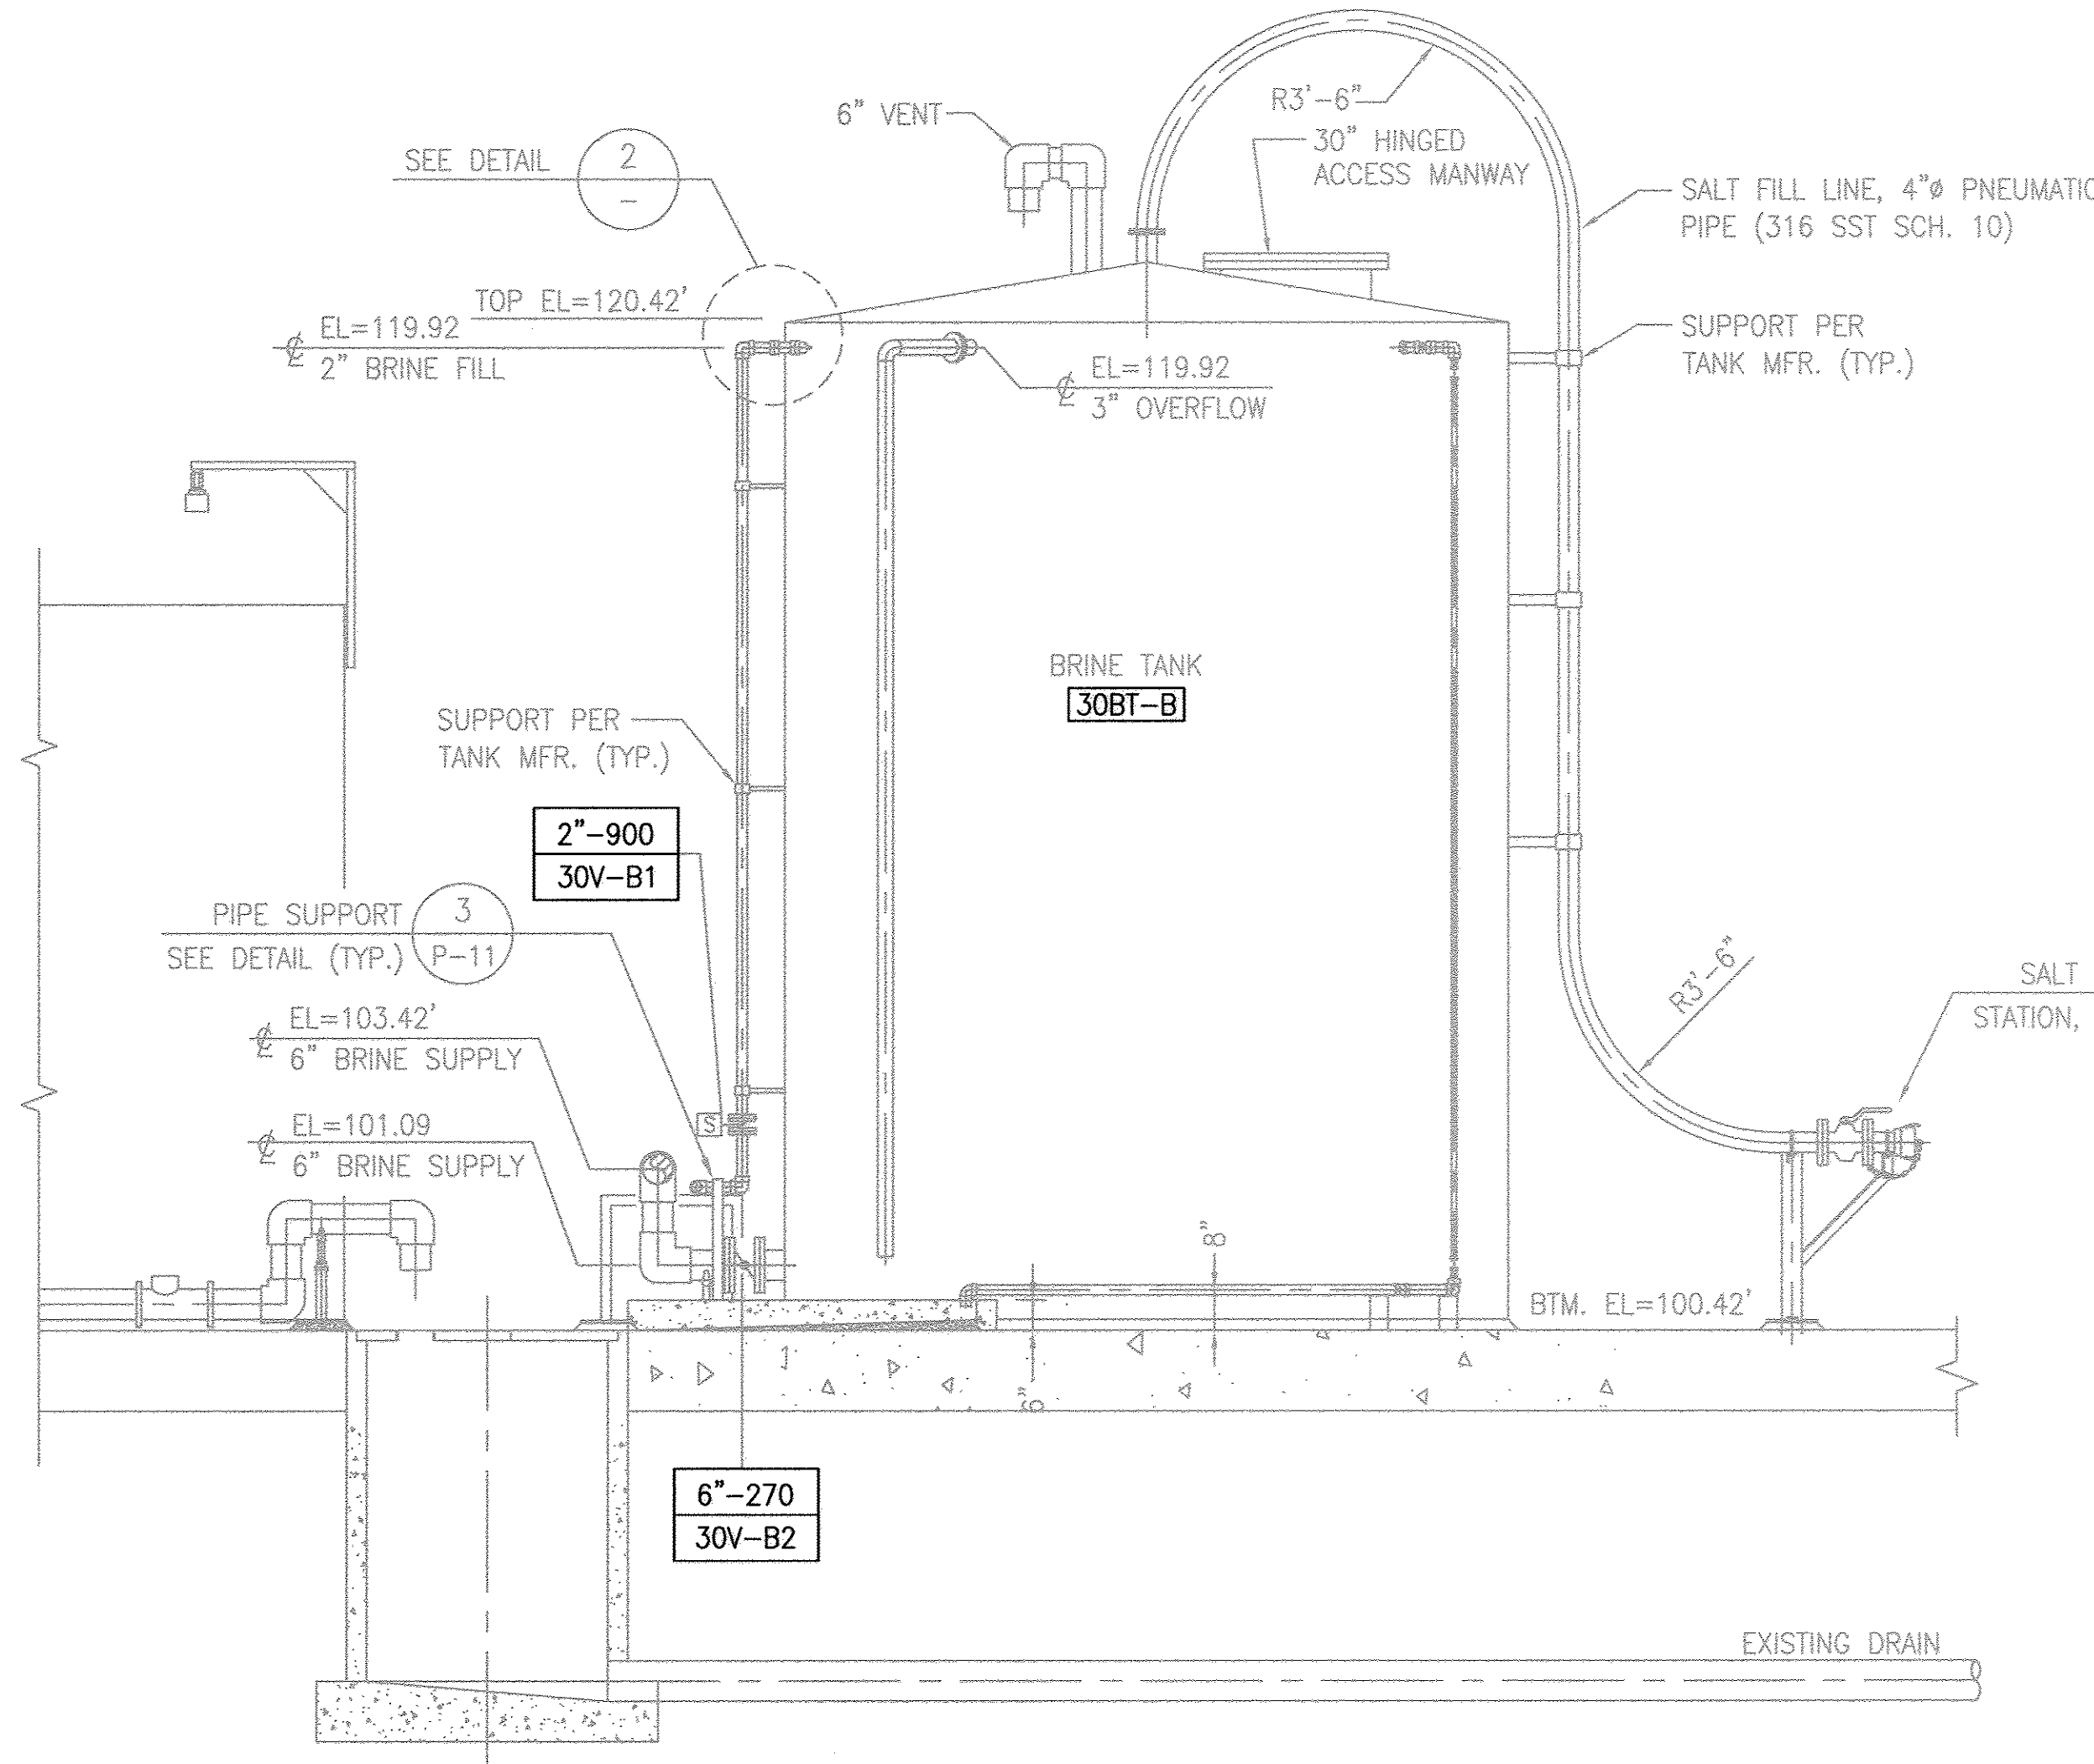

SECTION A
SCALE: 3/8" = 1'-0"

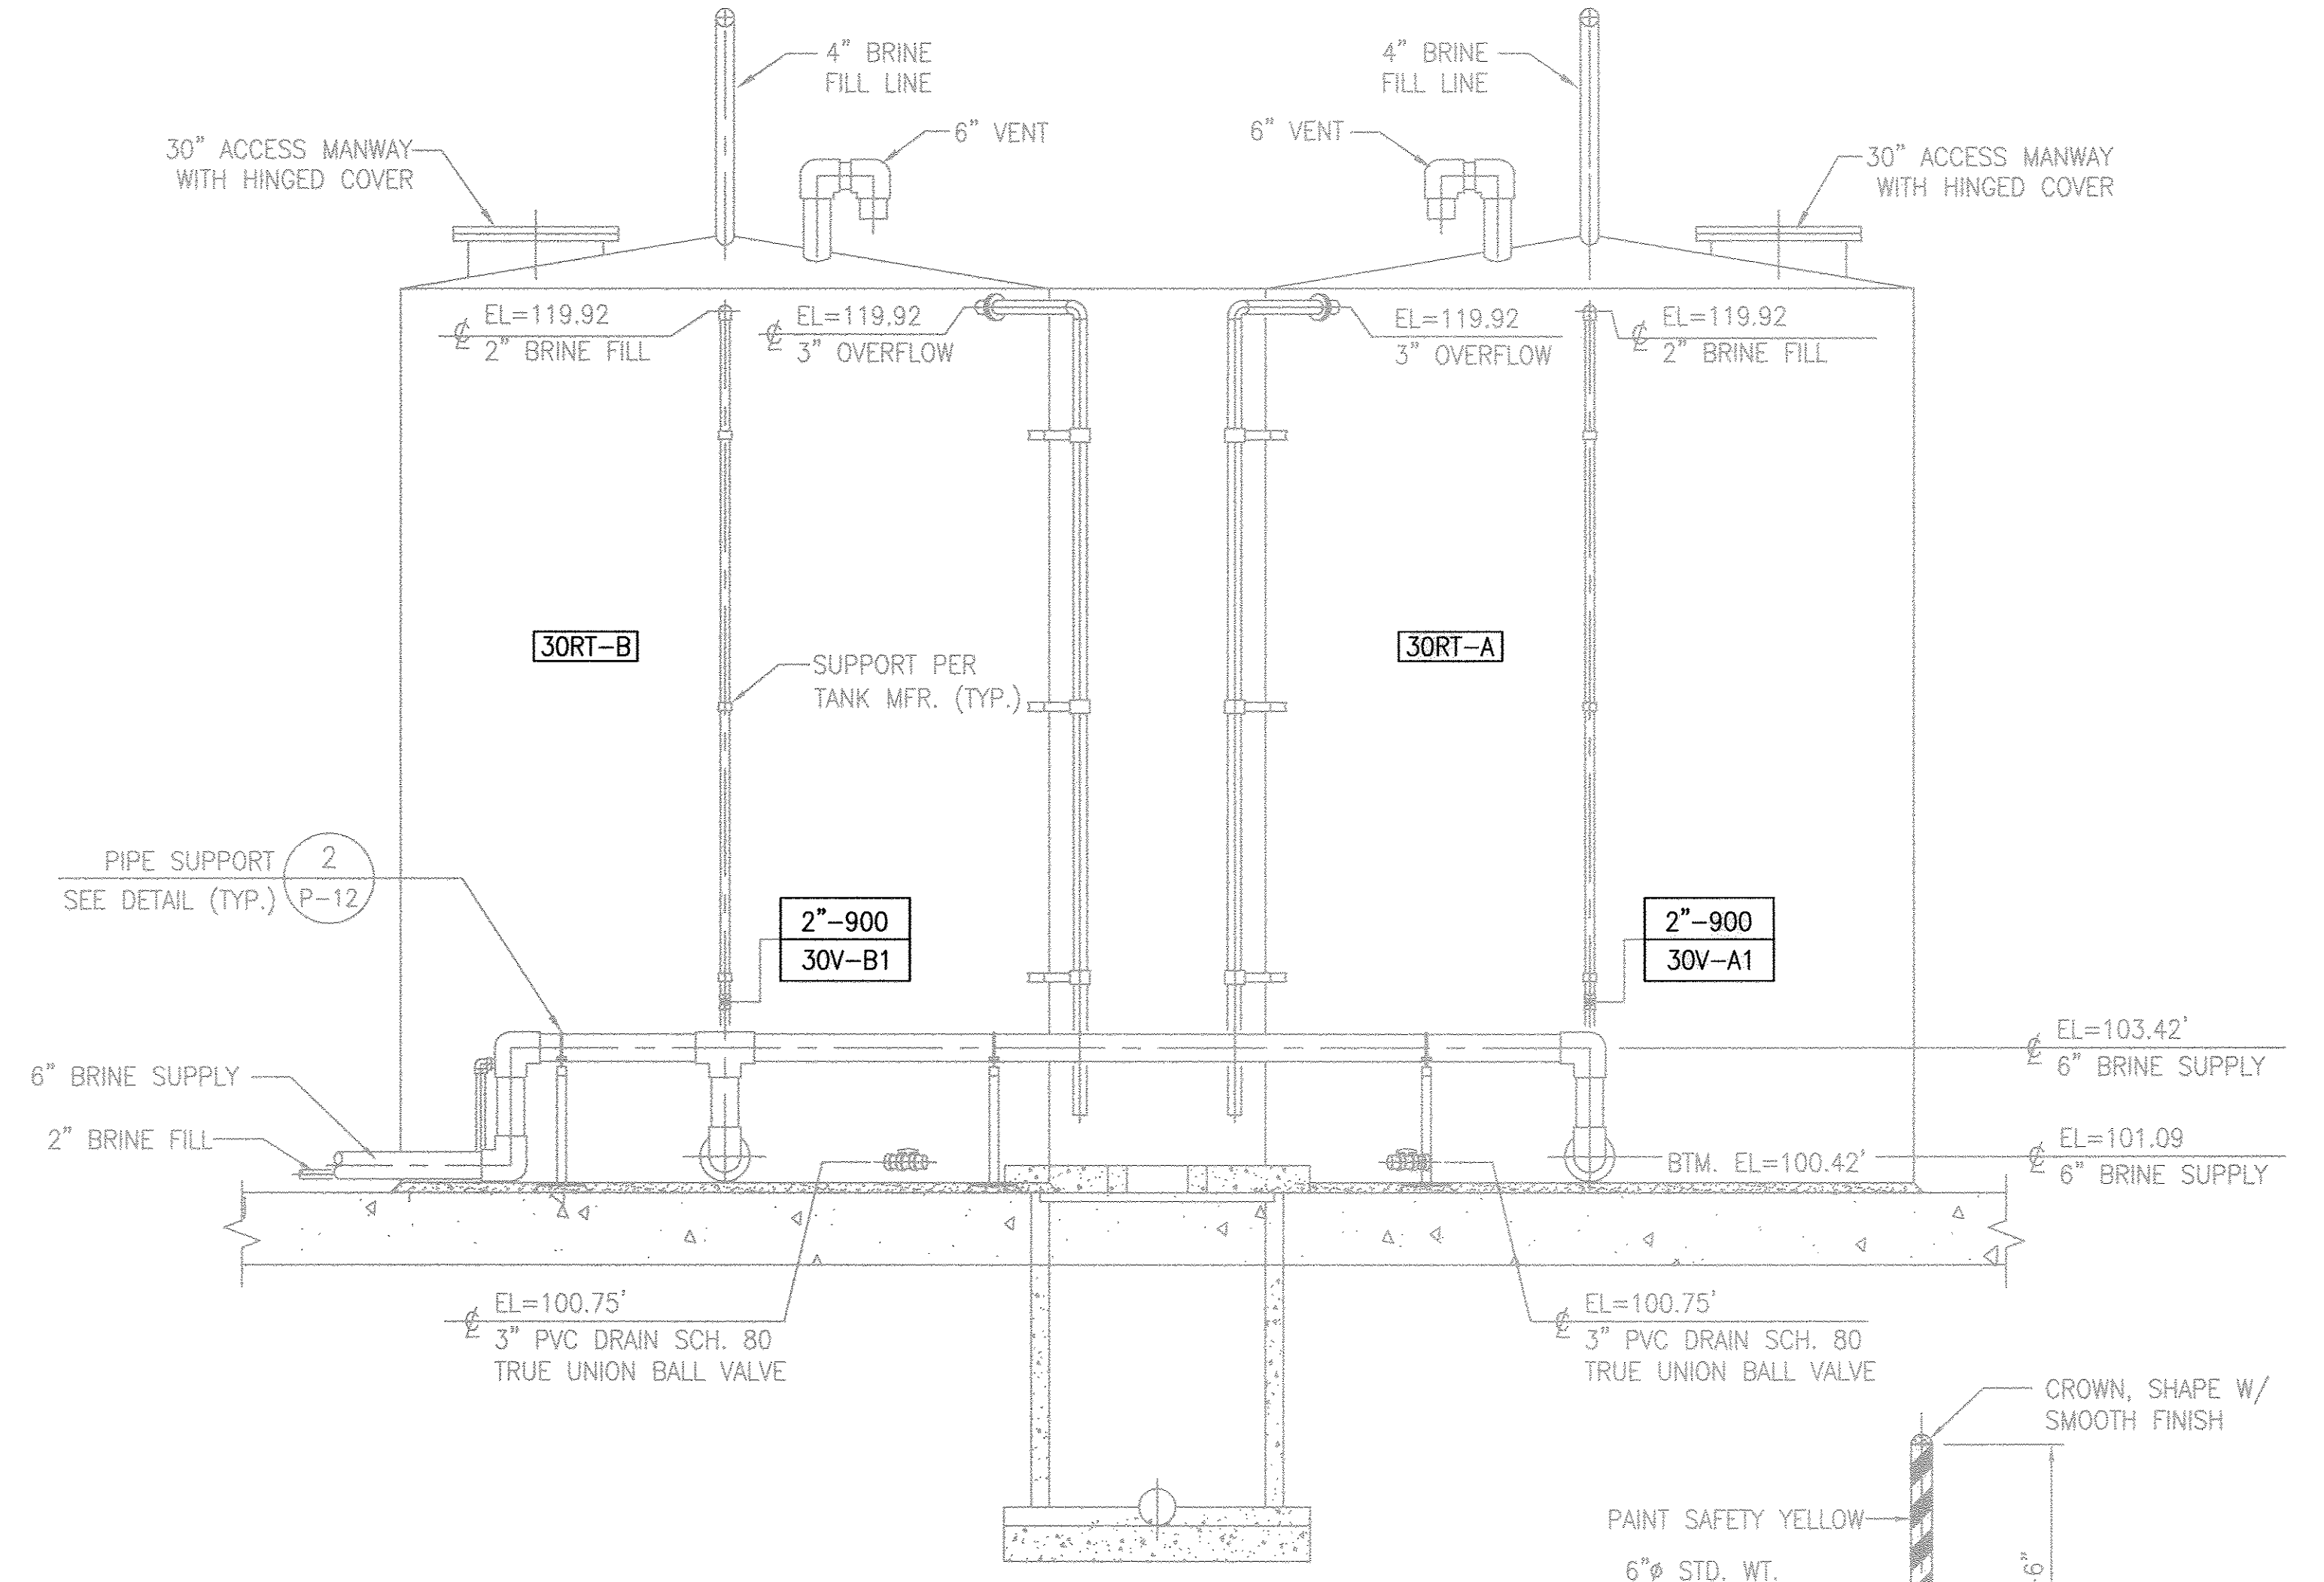


SECTION B
SCALE: 3/8" = 1'-0"

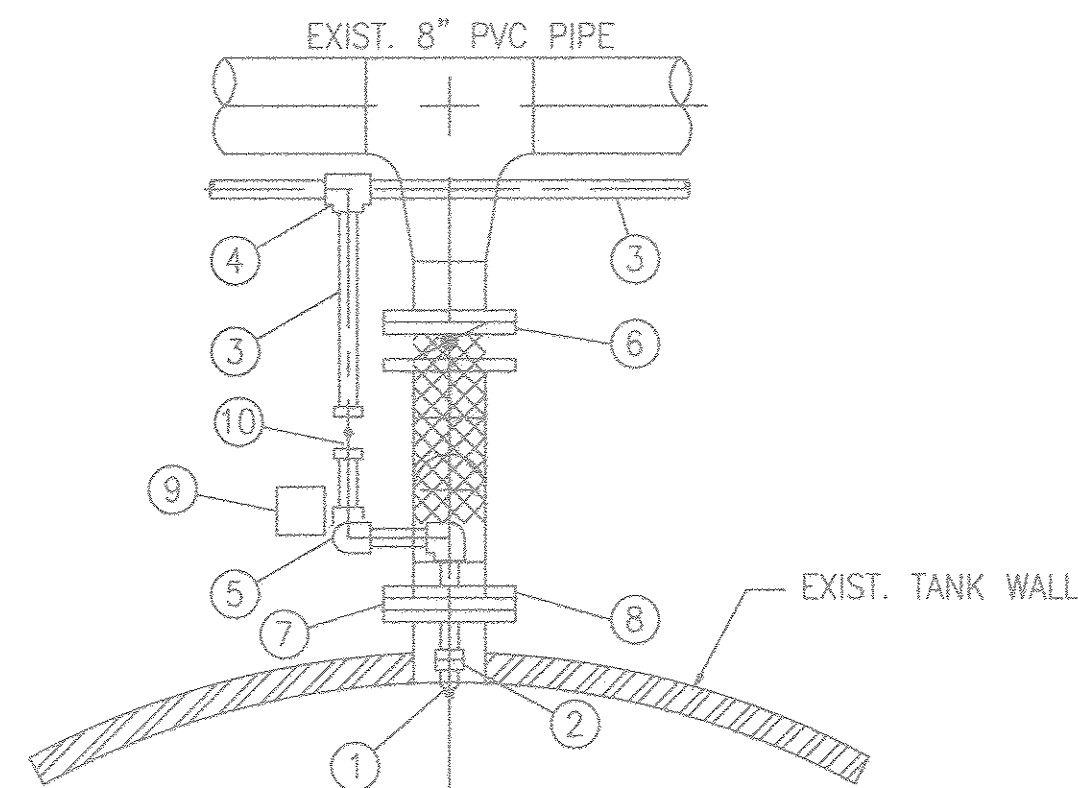


DETAIL 1
SCALE: 3/4" = 1'-0"


- MATERIAL LIST:**
- 1 1/2" TIDFLEX SERIES 35-1 FLANGED CHECK VALVE 1 1/2"
 - 1 1/2" FLANGE
 - 2" PVC PIPE, SCH. 80
 - 2" PVC TEE, SCH. 80
 - 2" PVC ELBOW, SCH. 80
 - 6" BLIND FLANGE
 - 6"x1 1/2" RED FLANGE
 - 6"x2" REDUCER FLANGE
 - PIPE SUPPORT UNDER VALVE SEE P-11
 - 2" SOLENOID VALVE

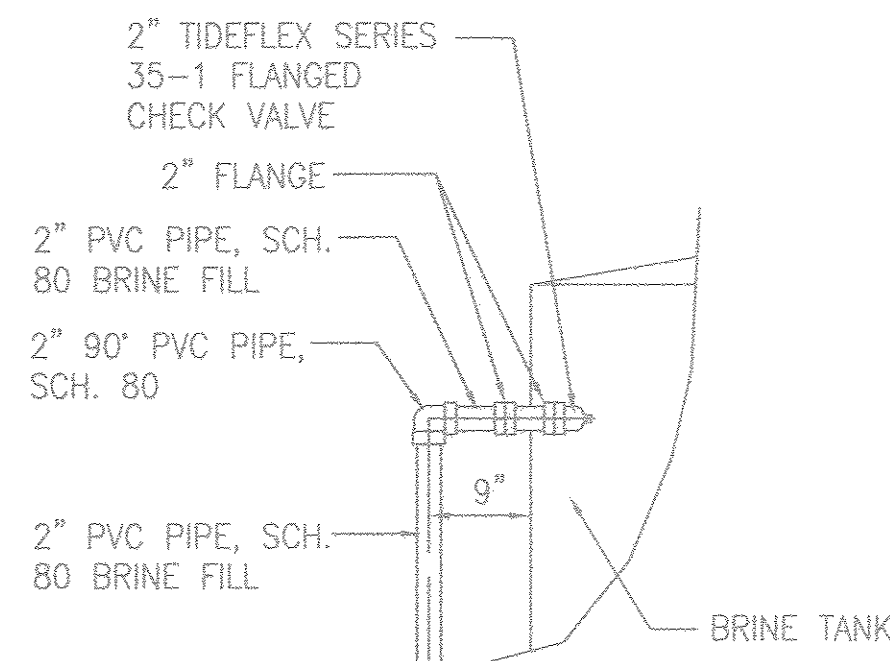

DETAIL 2
SCALE: 3/4" = 1'-0"

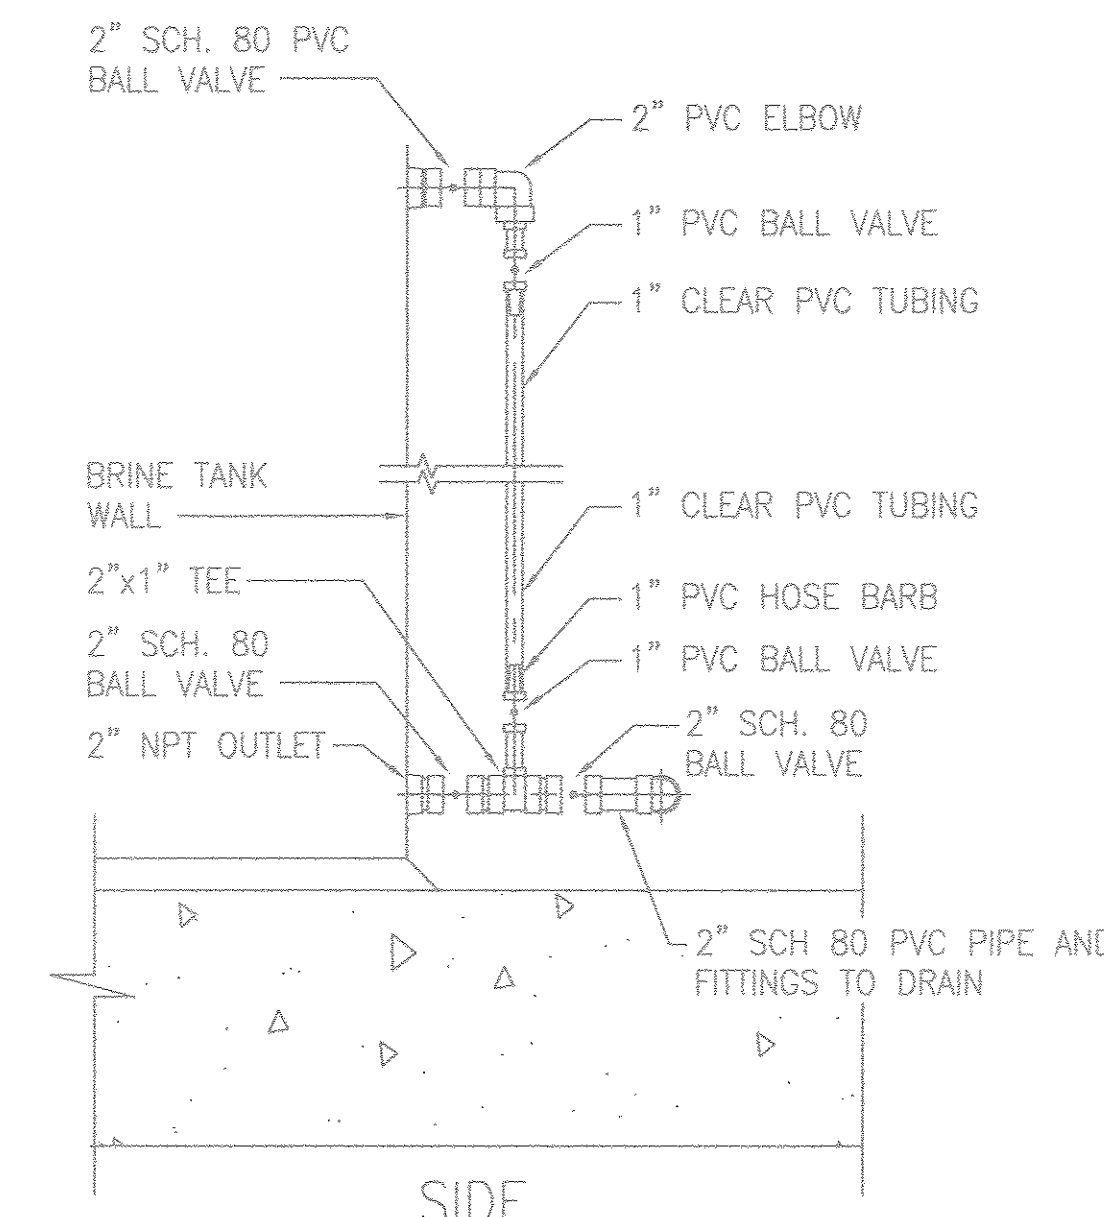

BRINE TANK DRAIN AND SITE LEVEL
NOT TO SCALE

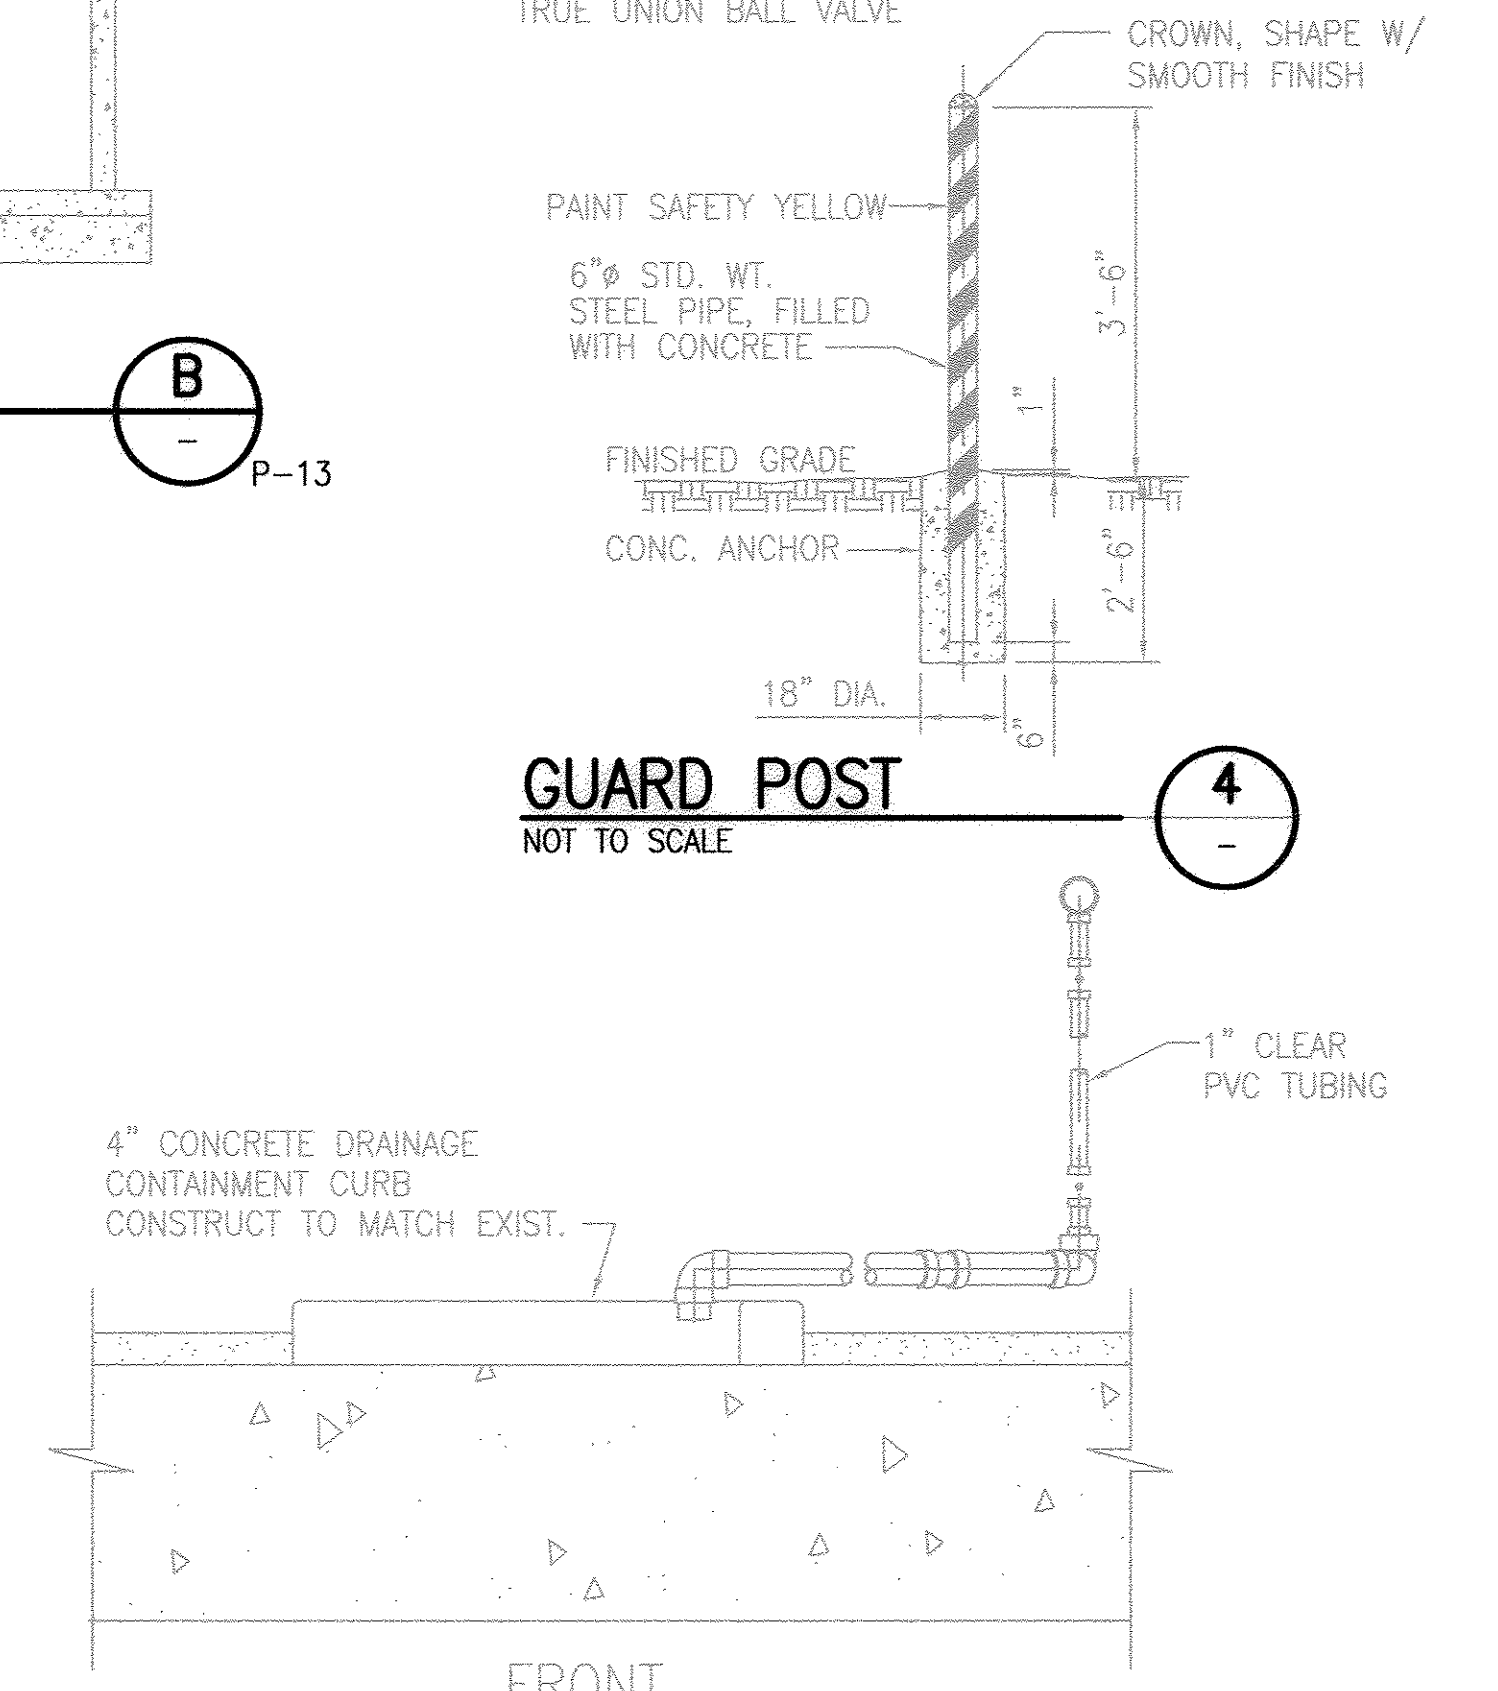

GUARD POST 4
NOT TO SCALE

RECORD DRAWING
Date: 08-23-07
These record drawings apply only to those facilities constructed under the contract identified in the title block and have been prepared, in part, on the basis of information compiled and furnished by others. The Engineer/Architect will not be responsible for any errors or omissions which have been incorporated into this drawing as a result of the work by others.

VERIFY SCALES
BAR IS ONE INCH ON ORIGINAL DRAWING
0 1
IF NOT ONE INCH ON THIS SHEET,
ADJUST SCALES ACCORDINGLY


APPROVAL:	DATE:	DESIGN BY: CJM	5/10/06	CHANGE ORDER 1.1
APPROVAL:	DATE:	DRAWN BY: ECM	3/1/07	CHANGE ORDER 1.2
APPROVAL:	DATE:	CHECKED BY:		
APPROVAL:	DATE:	DATE: APRIL 2006	REV	DATE DESCRIPTION APP

BOYLE ENGINEERING CORPORATION

JURUPA COMMUNITY SERVICES DISTRICT
ION EXCHANGE WATER TREATMENT PLANT - PHASE III
BRINE TANK SECTIONS AND DETAILS

DRAWING NO: P-14
SHEET NO: 15
OF 48 SHEETS
FILE NO: S-2268


DWG: S:\JURUPA\100-04-CAD (Phase III)\Pilot\SW\2268-P14.dwg
DATE: Nov 08, 2007 3:18pm
USER: khsford
XREFS: S2268BDR

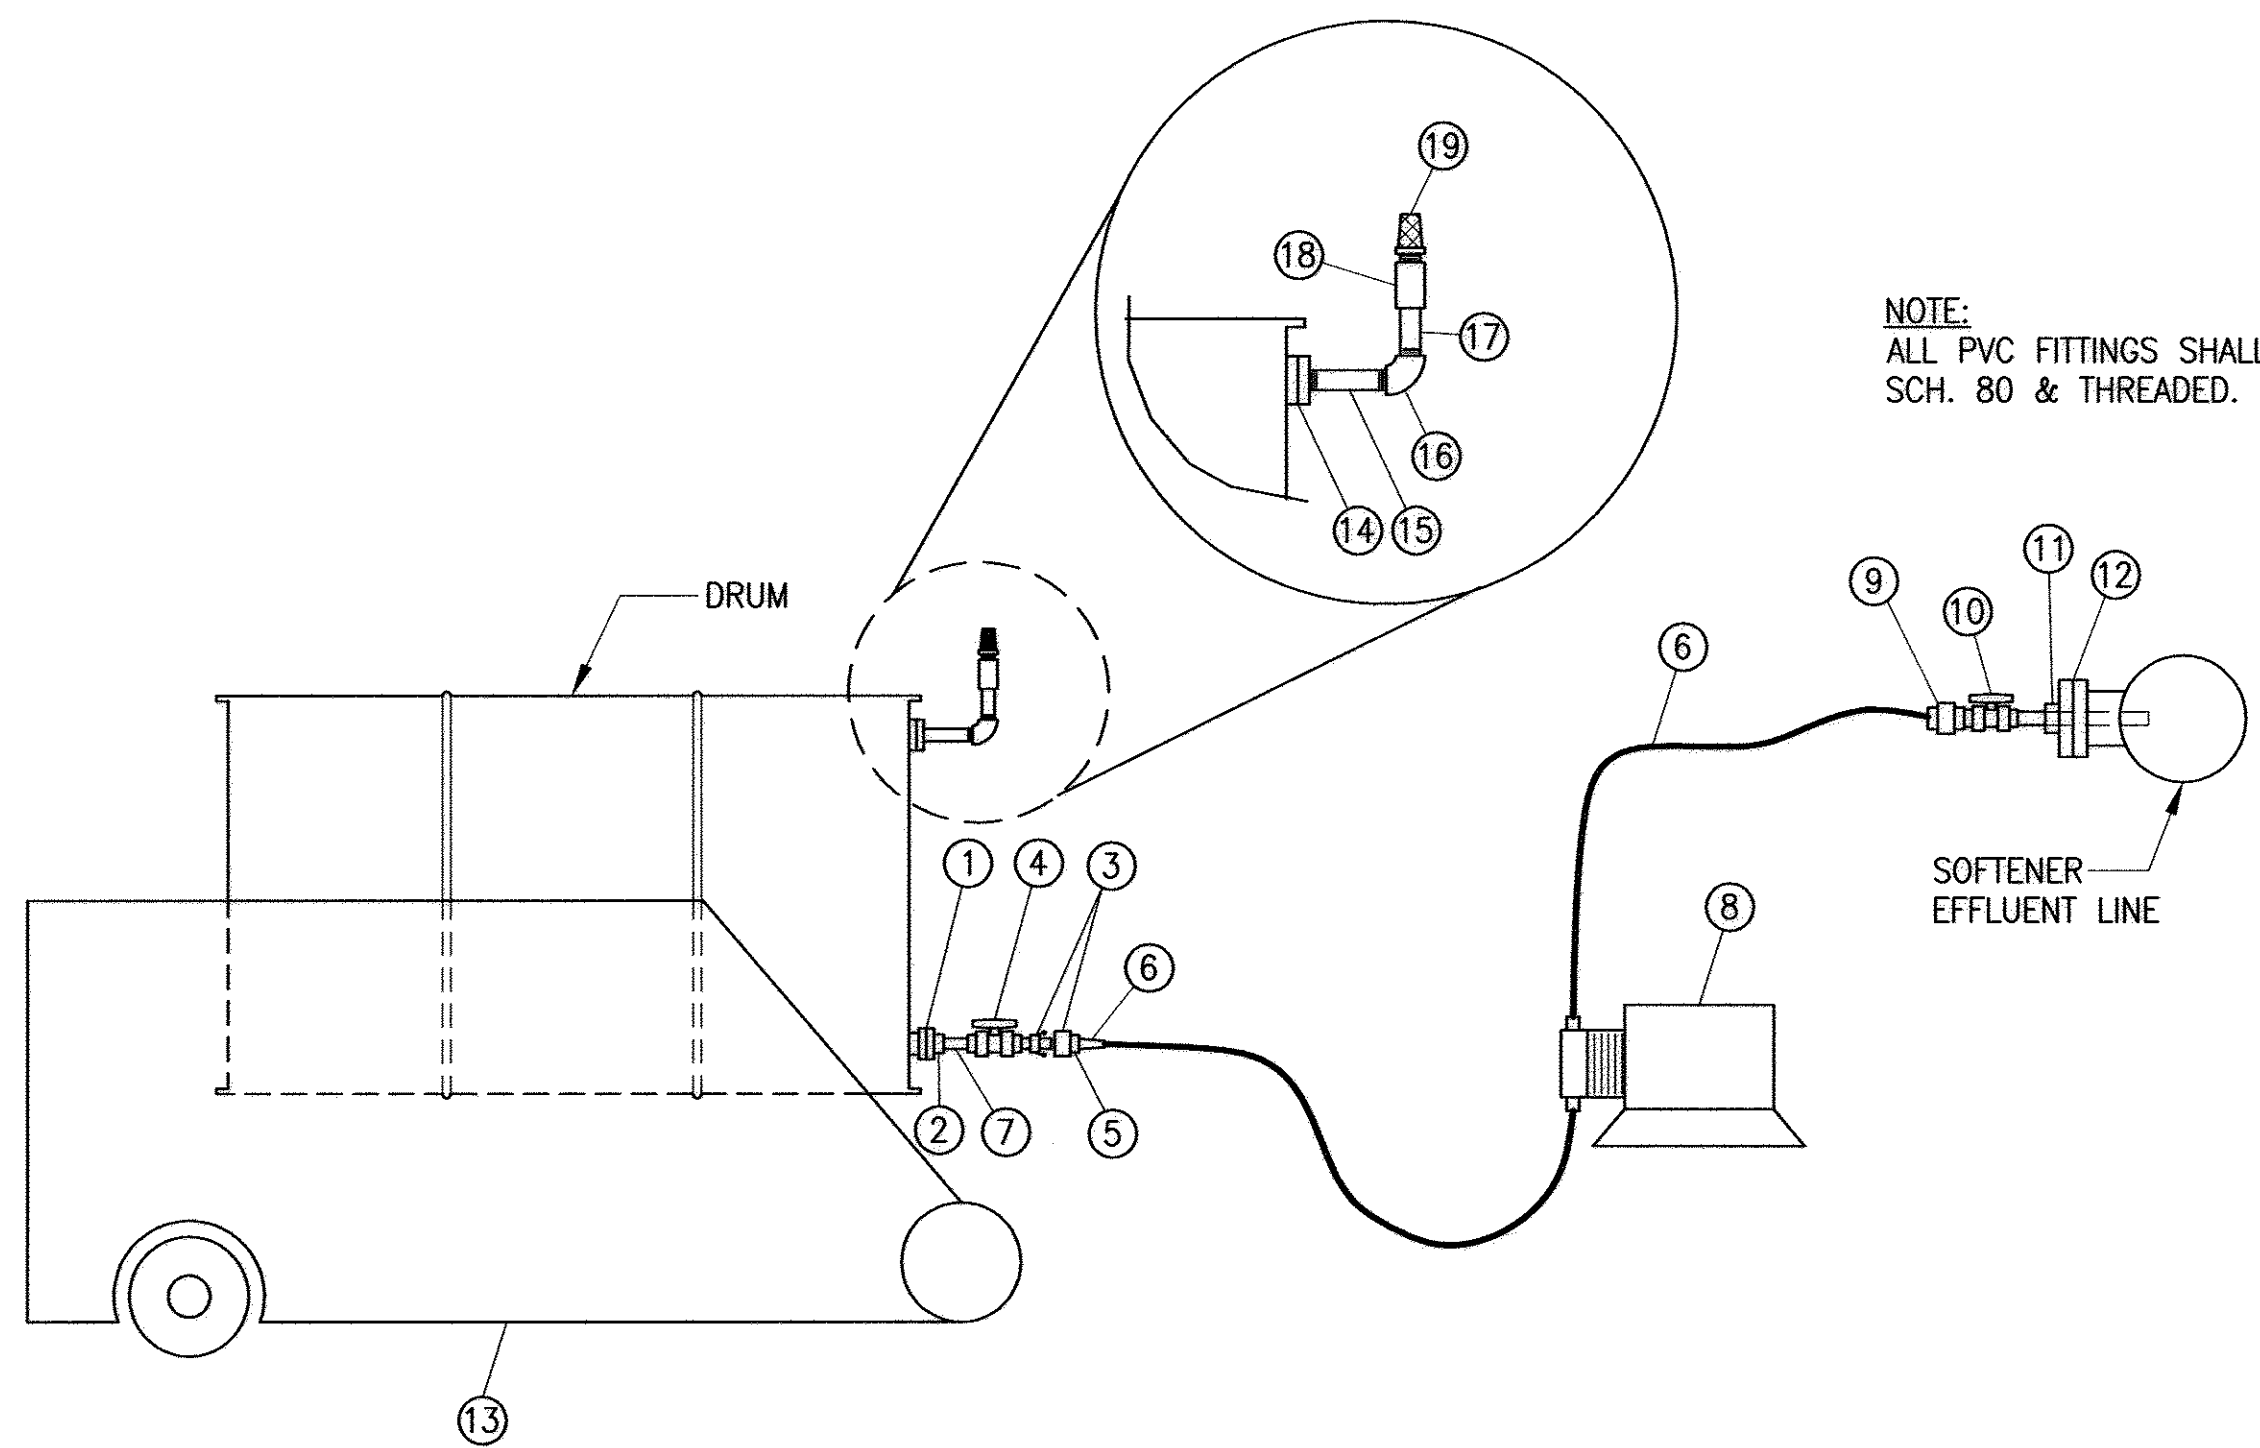

MATERIAL LIST:

- | | |
|--|--|
| ① 2" BUTTRESS TO 3/4" FPT DRUM ADAPTER | ⑪ 1" x 4" SCH. 80 PVC ADAPTER FITTINGS |
| ② 3/4"x1/2" THREADED ADAPTER PVC OR POLYETHYLENE | ⑫ 1" THREADED HOLE THROUGH CENTERS 4" VANSTONE FLANGE W/ THREADED NPT POST |
| ③ 1/2" CAMLOCK COUPLING, MALE & FEMALE, PVDF | ⑬ POLY DOLLY FROM US PLASTIC CORP. TEL 1800-537-9724 |
| ④ 1/2" PVC BALL VALVE, VENTED BALL | ⑭ 3/4" NPT BUSHING |
| ⑤ 1/2" NPT TO TUBING ADAPTER | ⑮ 3/4" PVC NIPPLE, 2" LONG |
| ⑥ 1/2" F.E.P. TUBING, BLACK | ⑯ 3/4 ELBOW |
| ⑦ 1/2" PVC NIPPLE, THREADED | |
| ⑧ PULSAFEEDER METERING PUMP SKID, CROWLEY CO., IRVINDALE, CA. (626) 856-5656
SKID = SP-151-211-101-100-000
PUMP = LD03PA - V V C9-XXX
DEGASSING HEAD = L9906901 | |
| ⑨ 3/4" PVC INJECTOR BY SAF-T-FLO; QUILL LENGTH=12" MIN. WITH SAF-T-SEAL TIP, VERIFY IN FIELD | |
| ⑩ 1" SCH. 80 PVC BALL VALVE, VENTED | |
| ⑪ 1" x 4" SCH. 80 PVC ADAPTER FITTINGS | |
| ⑫ 1" THREADED HOLE THROUGH CENTERS 4" VANSTONE FLANGE W/ THREADED NPT POST | |
| ⑬ POLY DOLLY FROM US PLASTIC CORP. TEL 1800-537-9724 | |
| ⑭ 3/4" NPT BUSHING | |
| ⑮ 3/4" PVC NIPPLE, 2" LONG | |
| ⑯ 3/4 ELBOW | |

- | |
|----------------------------|
| ⑰ 3/4" PVC NIPPLE, 6" LONG |
| ⑱ 3/4" THREADED COUPLING |
| ⑲ PVC FOOT VALVE SCREEN |

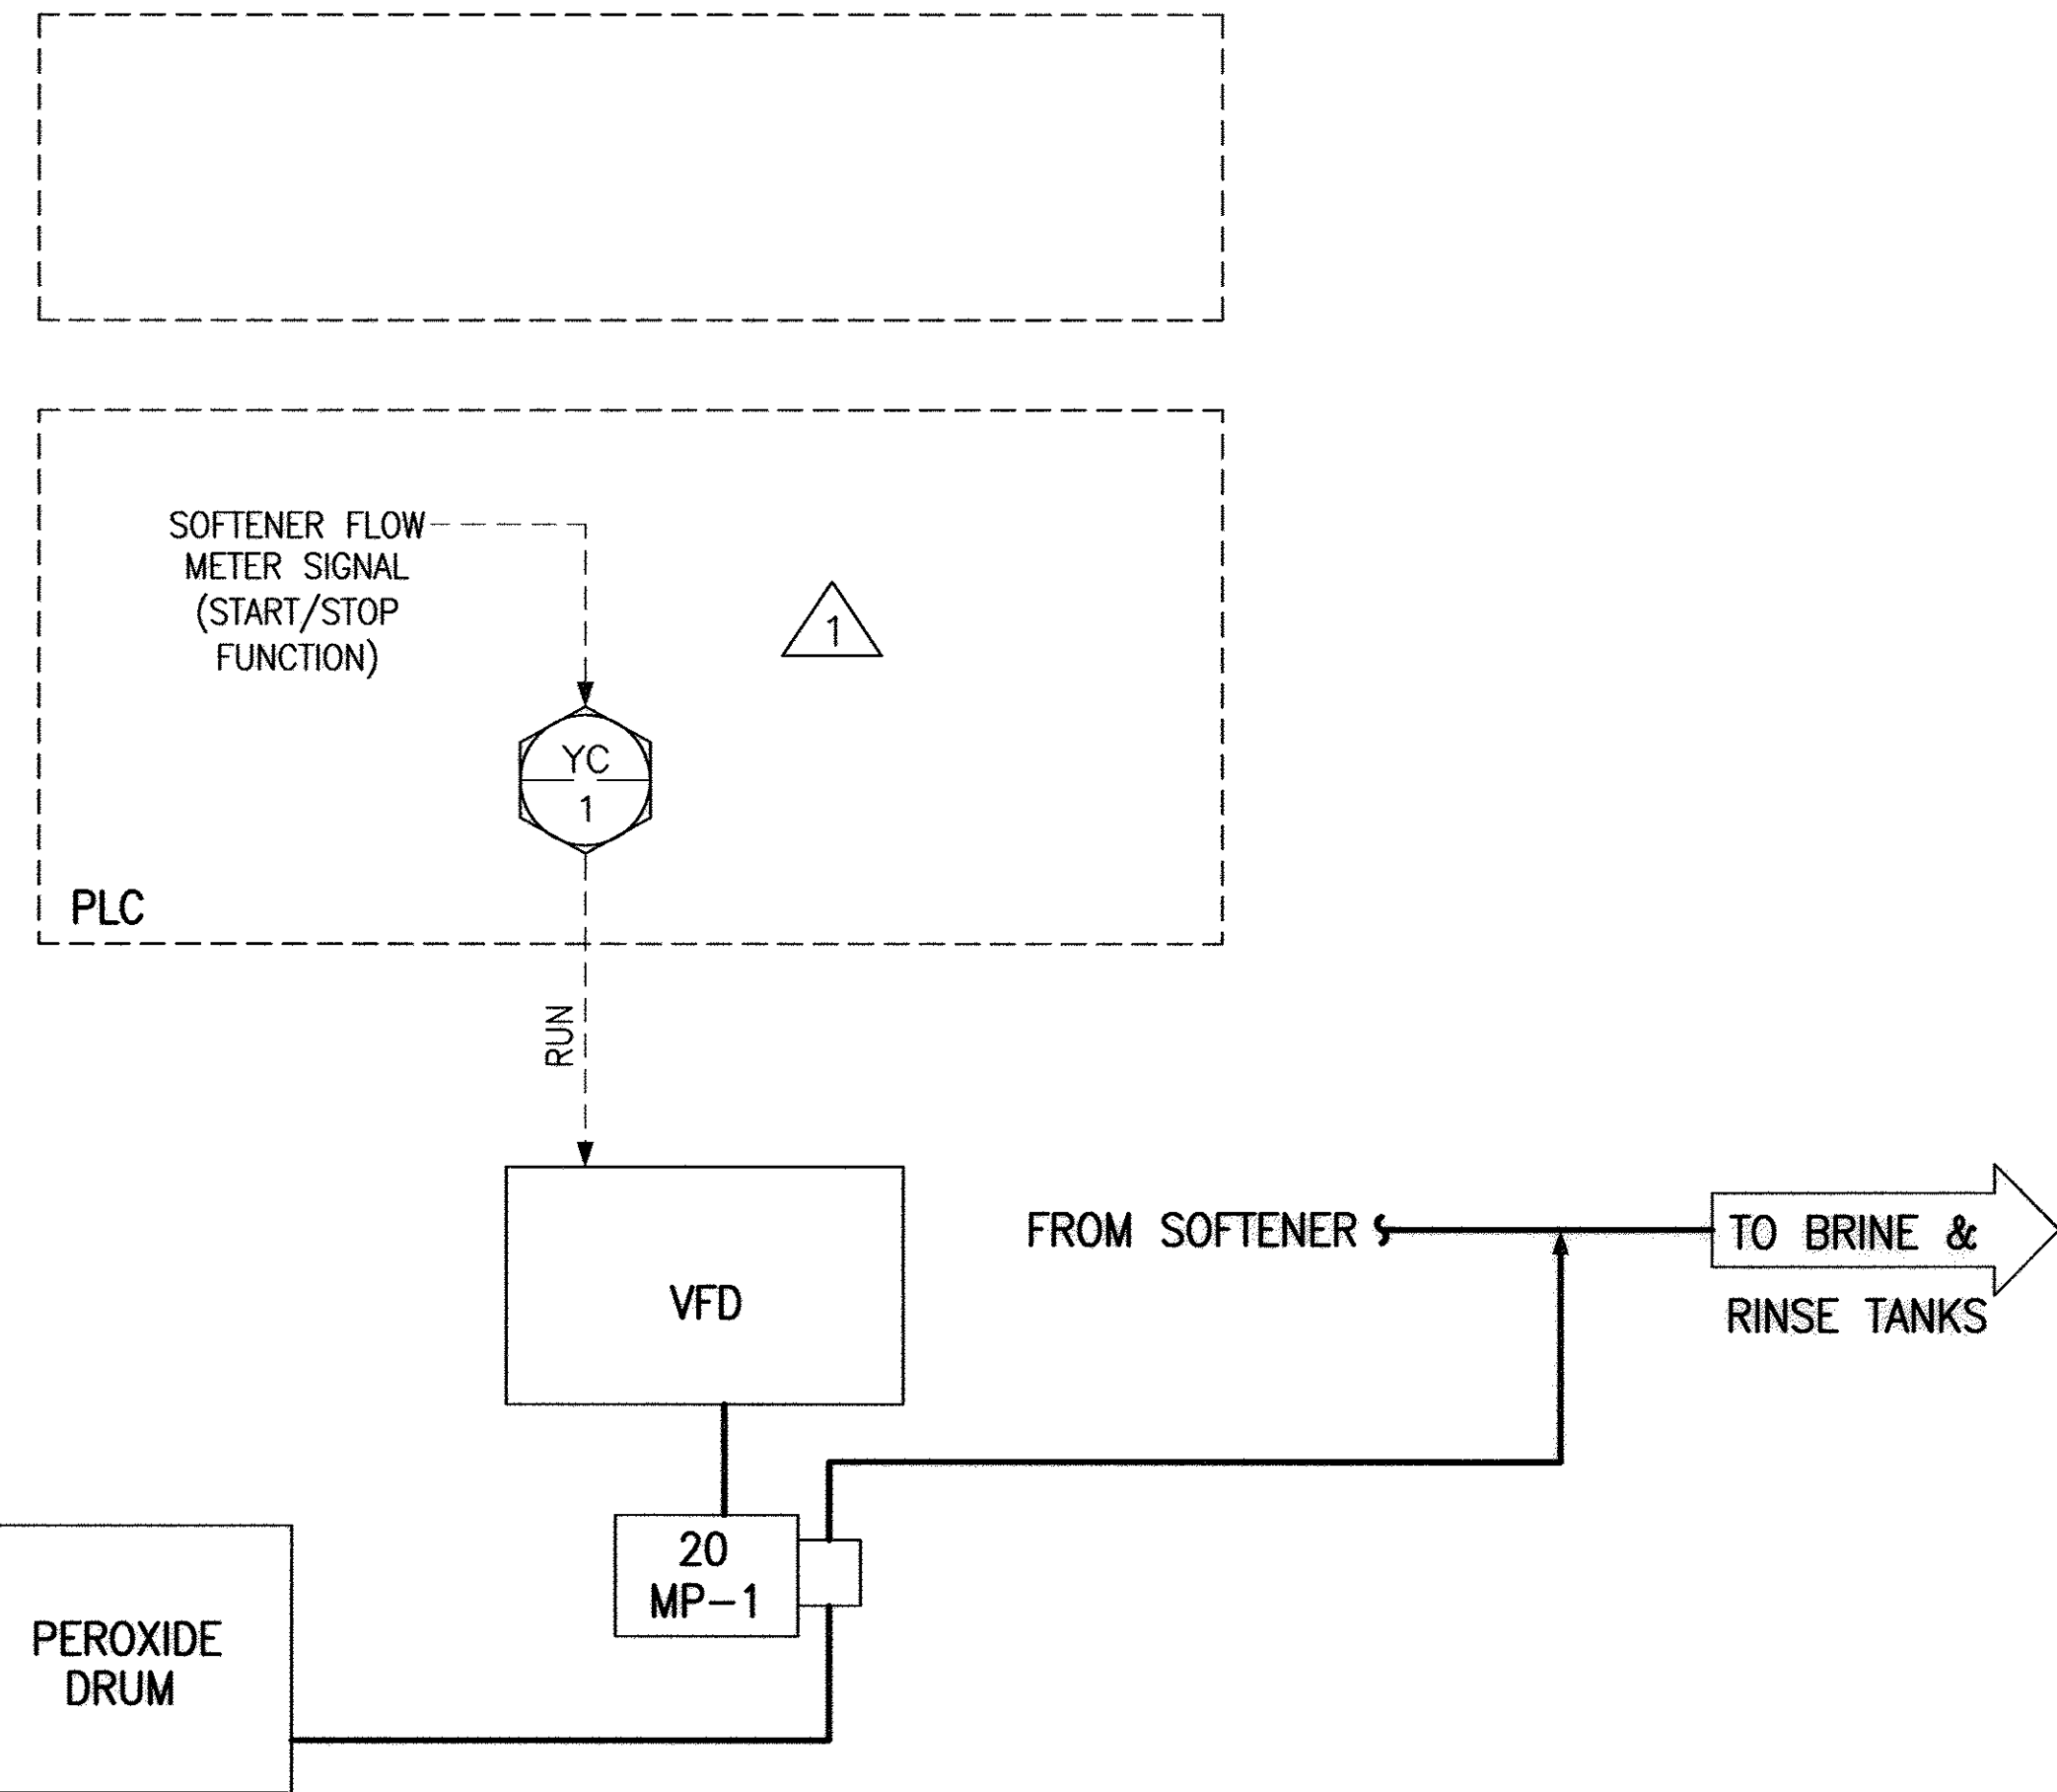

RECORD DRAWING
Date: 08-23-07

These record drawings apply only to those facilities constructed under the contract identified in the title block and have been prepared, in part, on the basis of information compiled and furnished by others. The Engineer/Architect will not be responsible for any errors or omissions which have been incorporated into this drawing as a result of the work by others.

DWG: S:\JDA\100-04-CAD (Phase III)\PlanSet\S2268-P15.dwg
DATE: Nov 08, 2007 3:20pm
USER: kcozford
XREFS: S2268DR









VERIFY SCALES
BAR IS ONE INCH ON ORIGINAL DRAWING
0 1
IF NOT ONE INCH ON THIS SHEET,
ADJUST SCALES ACCORDINGLY


APPROVAL:	DATE:	DESIGN BY:	CJM	5/10/06	CHANGE ORDER 1.1
APPROVAL:	DATE:	DRAWN BY:	DTG		
APPROVAL:	DATE:	CHECKED BY:			
	DATE:				
	AUGUST 2005				
	REV	DATE	DESCRIPTION	APP	

BOYLE ENGINEERING CORPORATION

JURUPA COMMUNITY SERVICES DISTRICT
ION EXCHANGE WATER TREATMENT PLANT - PHASE III
HYDROGEN PEROXIDE INJECTION SYSTEM

DRAWING NO:	SHEET NO:
P-15	16
FILE NO:	OF 48 SHEETS
	S-2268

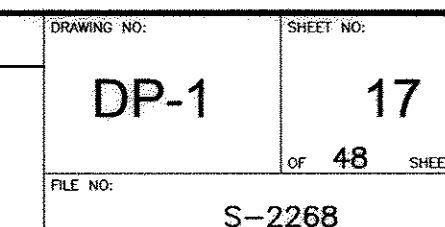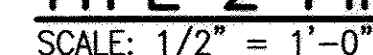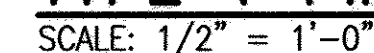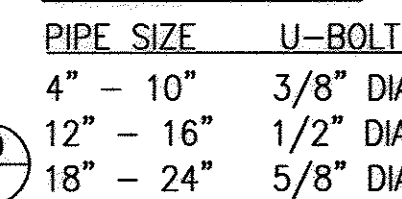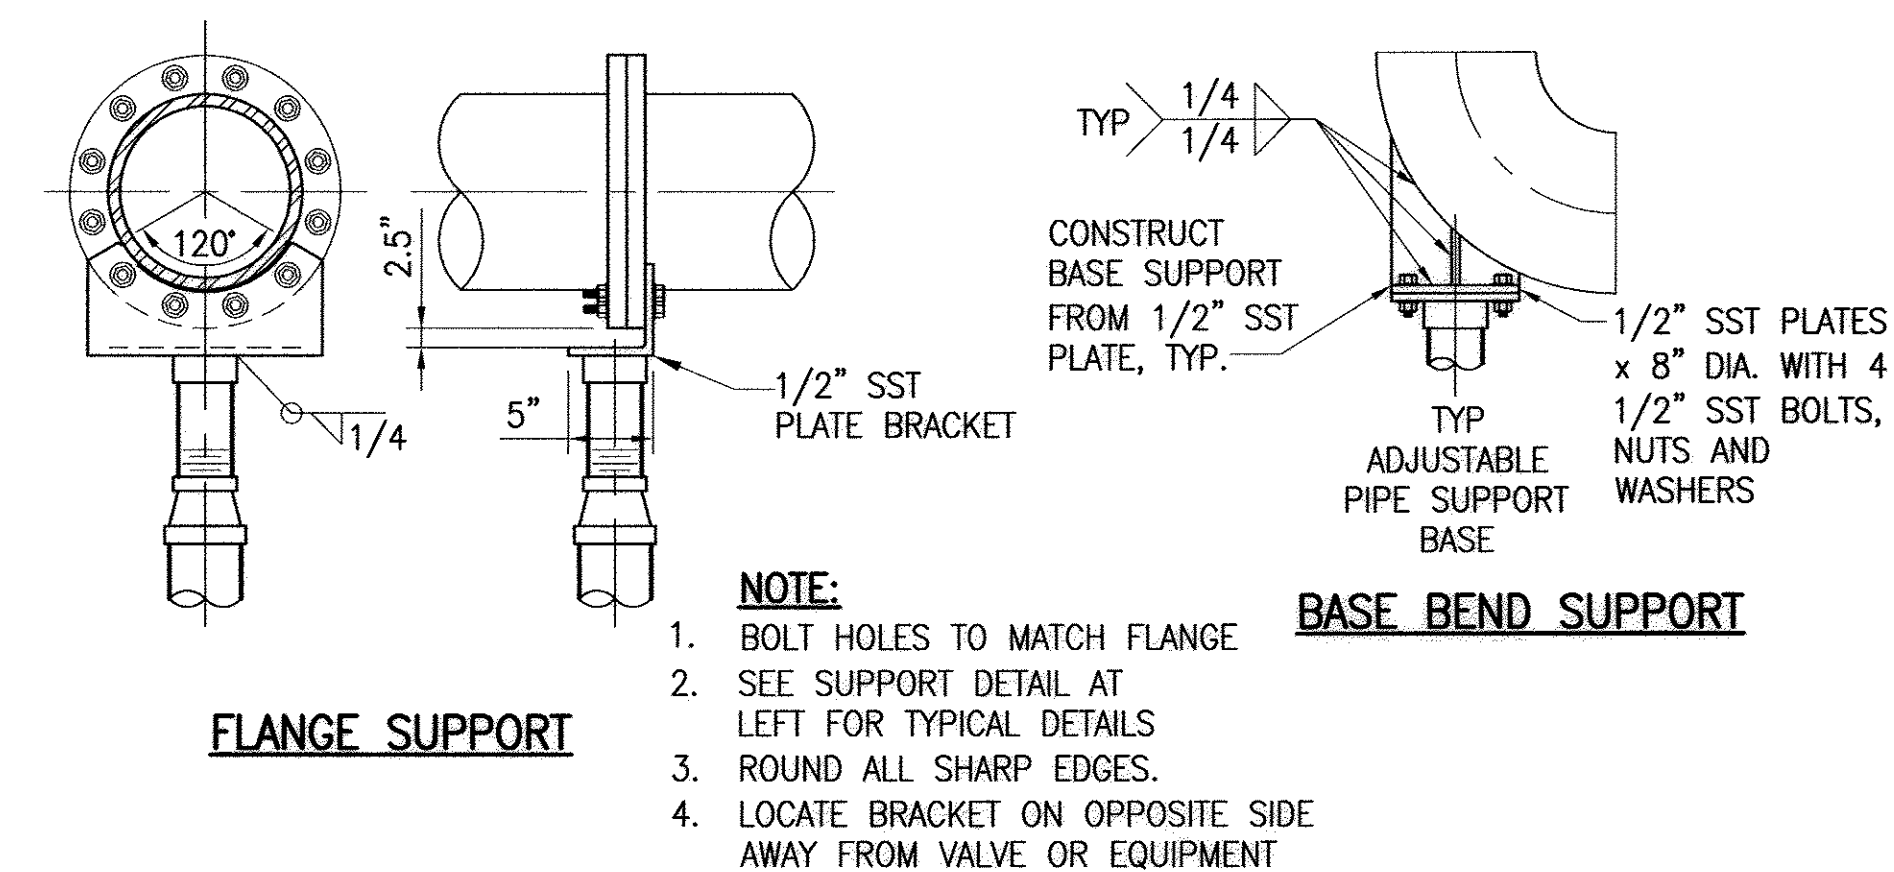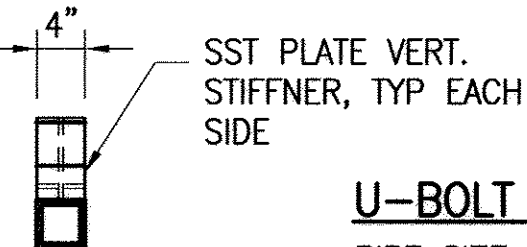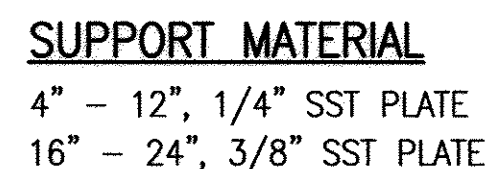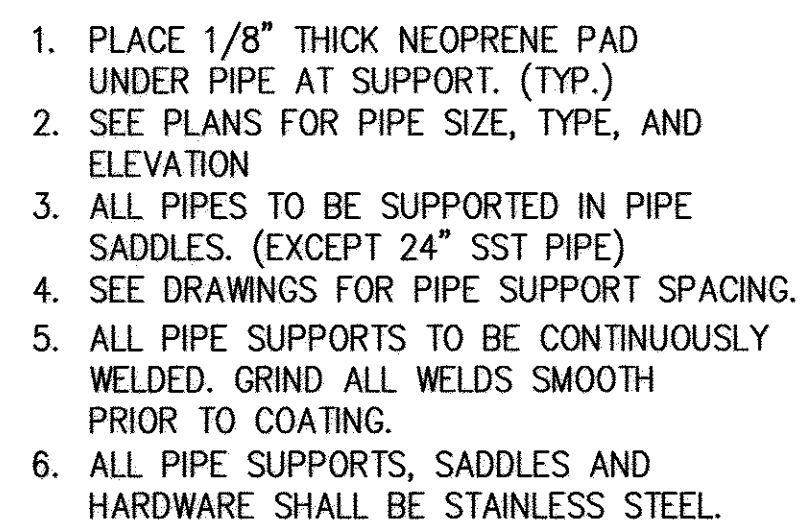

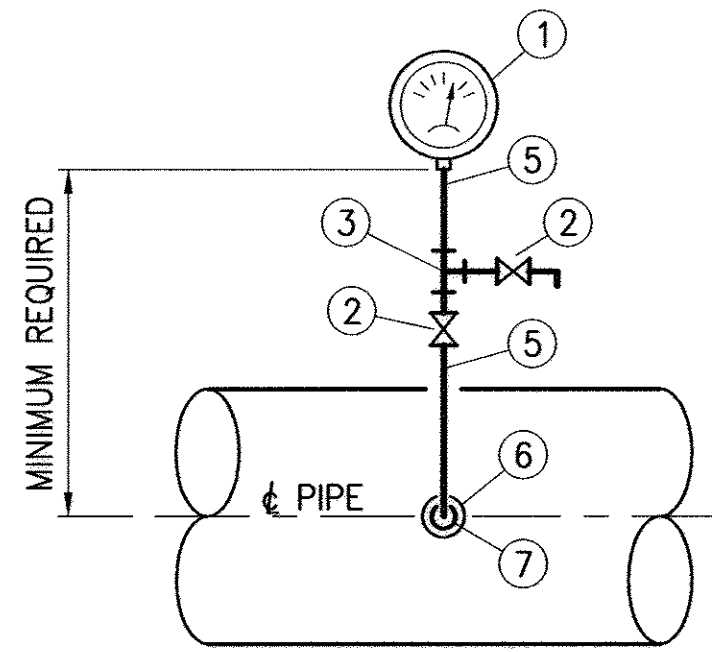


PRESSURE GAUGE 1
NOT TO SCALE

MATERIALS LIST


- ① PRESSURE GAUGES SHALL BE 2 1/2" DIA. TYPE 6 UNLESS OTHERWISE NOTED ON THE DRAWINGS
- ② 1/2" TYPE 320 BALL VALVE
- ③ 1/2" TYPE 316 SST TEE
- ④ 1/2" 90° TYPE 316 SST ELBOW
- ⑤ 1/2" TYPE 316 SST PIPING AND FITTINGS
- ⑥ VERIFY OUTLET SIZE AND MATERIAL
- ⑦ BUSHING TO MATCH OUTLET SIZE x 1/2"

NOTES: FOR DETAIL


1. ALL PRESSURE GAUGE FITTINGS AND NIPPLES TO BE TYPE 316 SST.
2. INSTALL PRESSURE GAUGE W/ 90° ELBOW WITH SIDE MOUNT UNLESS OTHERWISE SHOWN ON THE PLANS.
3. WHEN OWNER SUPPLIES GAUGE, THE CONTRACTOR SHALL SUPPLY THE VALVES AND FITTINGS

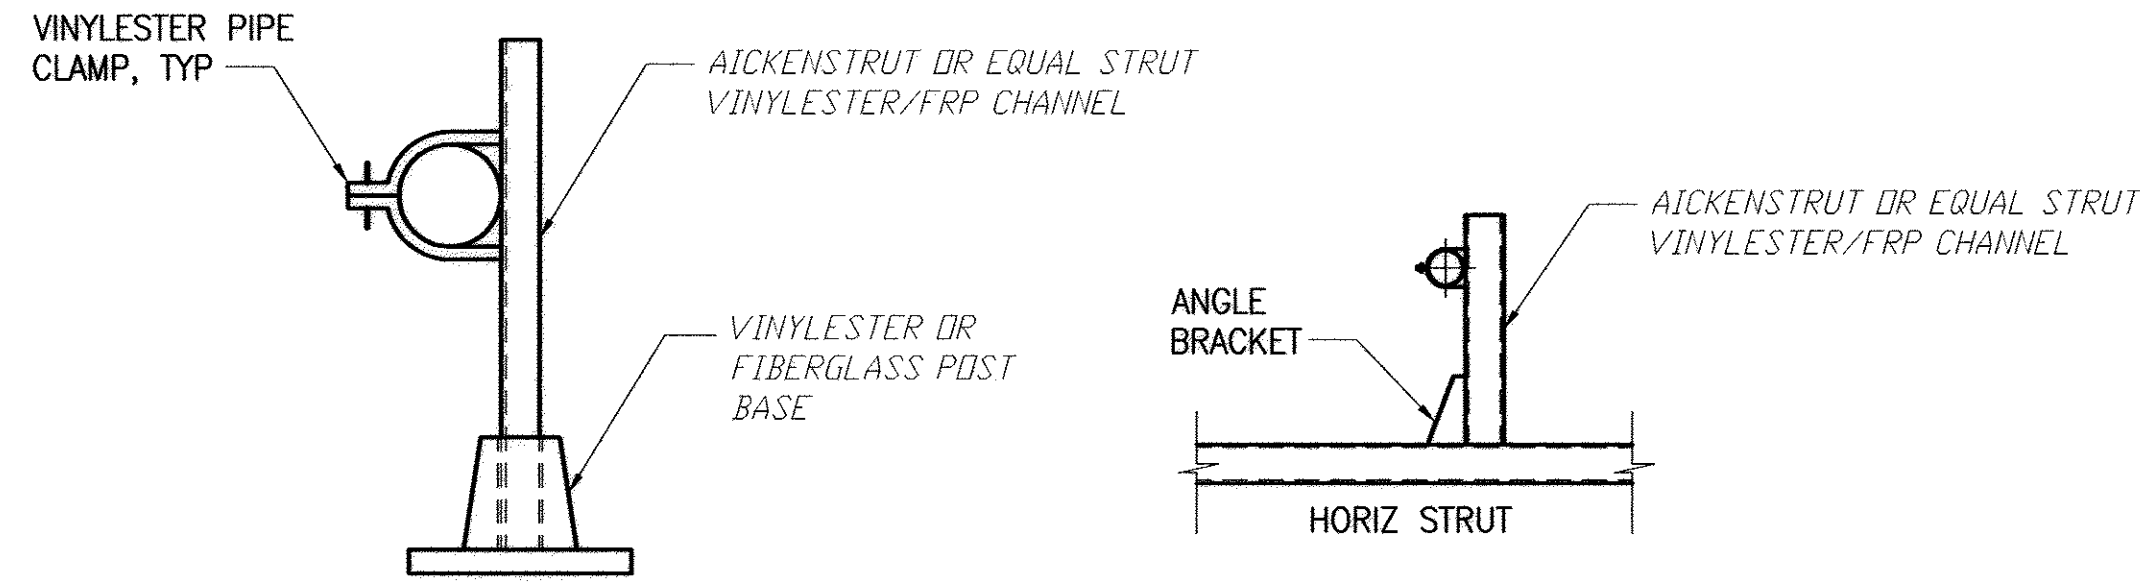

FRP PIPE SUPPORT 2
SCALE: N.T.S.

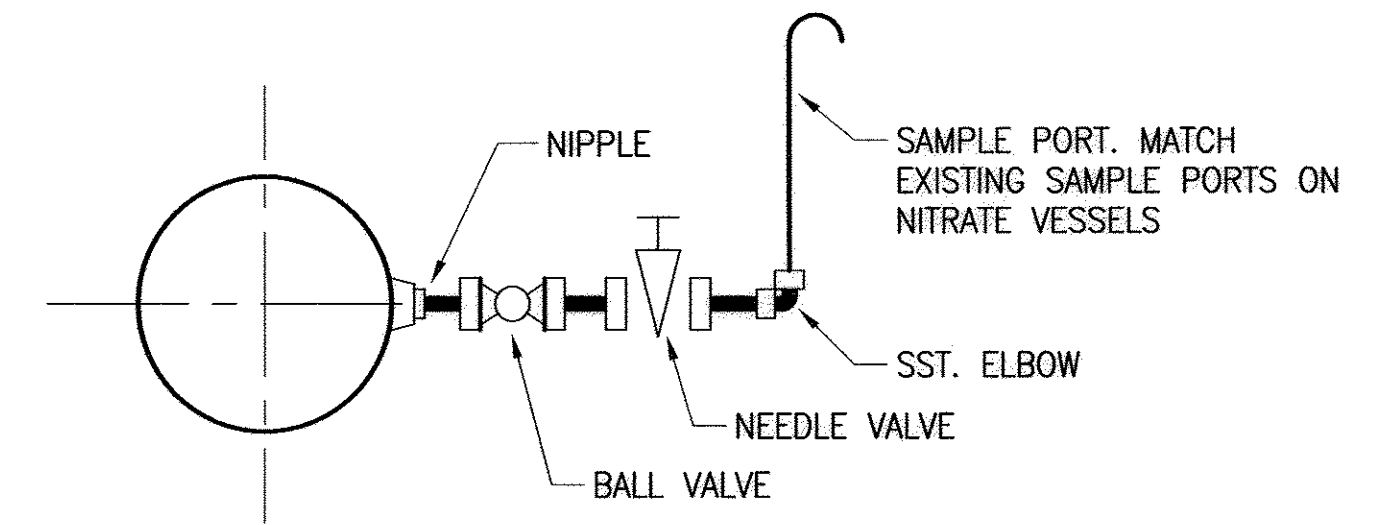


SAMPLE PORT DETAIL 3
NOT TO SCALE

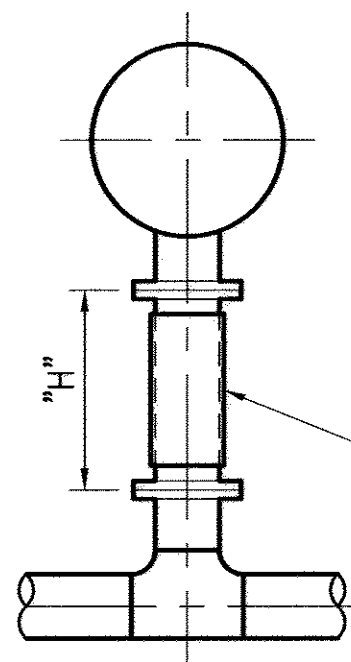

DIA.	DESC.	"H"-MIN.
3"	AIR SUPPLY LINE	16"
6"	BW SUPPLY	20"
8"	BW OUT/DRAIN	20"
8"	WELL/TREATED	25"

FLEXIBLE HOSE CONNECTOR, SEE SPEC. SEC. 15122


FLEXIBLE HOSE CONNECTION 4
SCALE: 1/2"=1'-0"

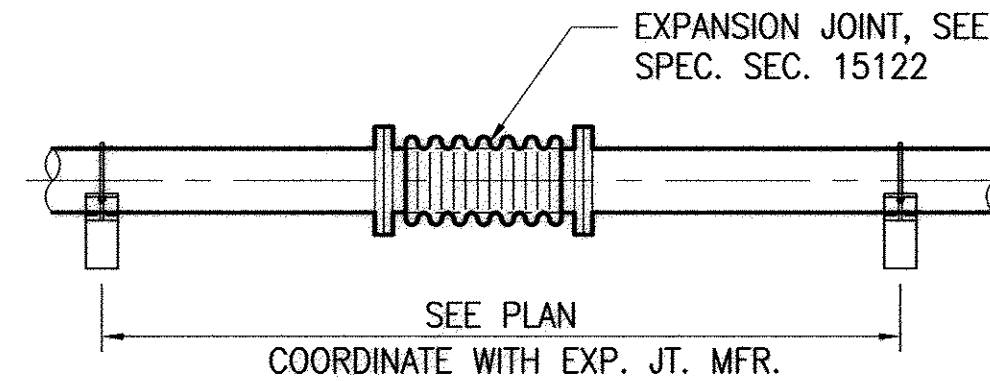


NOTES:

1. EXPANSION JOINTS INSTALLED IN PVC PIPE SHALL BE CONSTRUCTED OF PVC.
2. EXPANSION JOINTS INSTALLED IN SST PIPE SHALL BE CONSTRUCTED OF SST.

EXPANSION JOINT DETAIL 5
SCALE: 1/2"=1'-0"

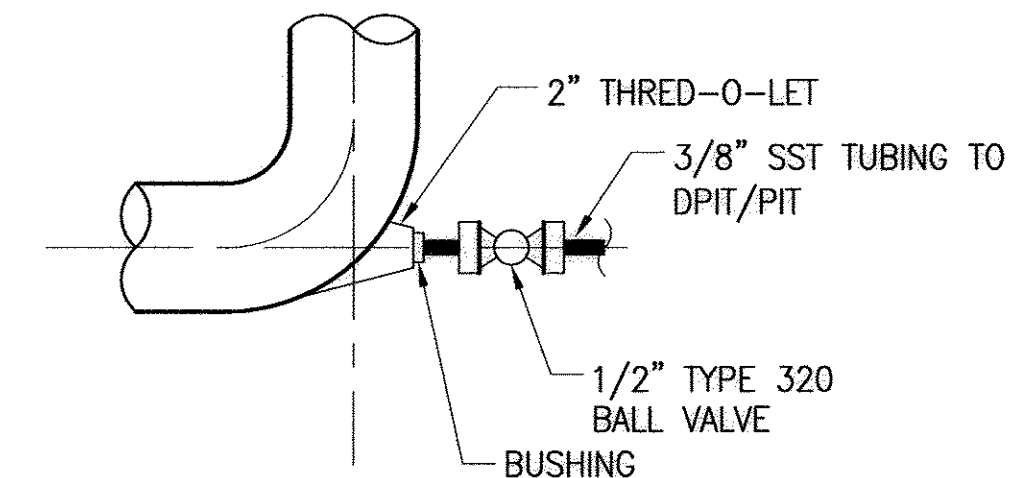


PRESSURE TAP 7
SCALE: N.T.S.

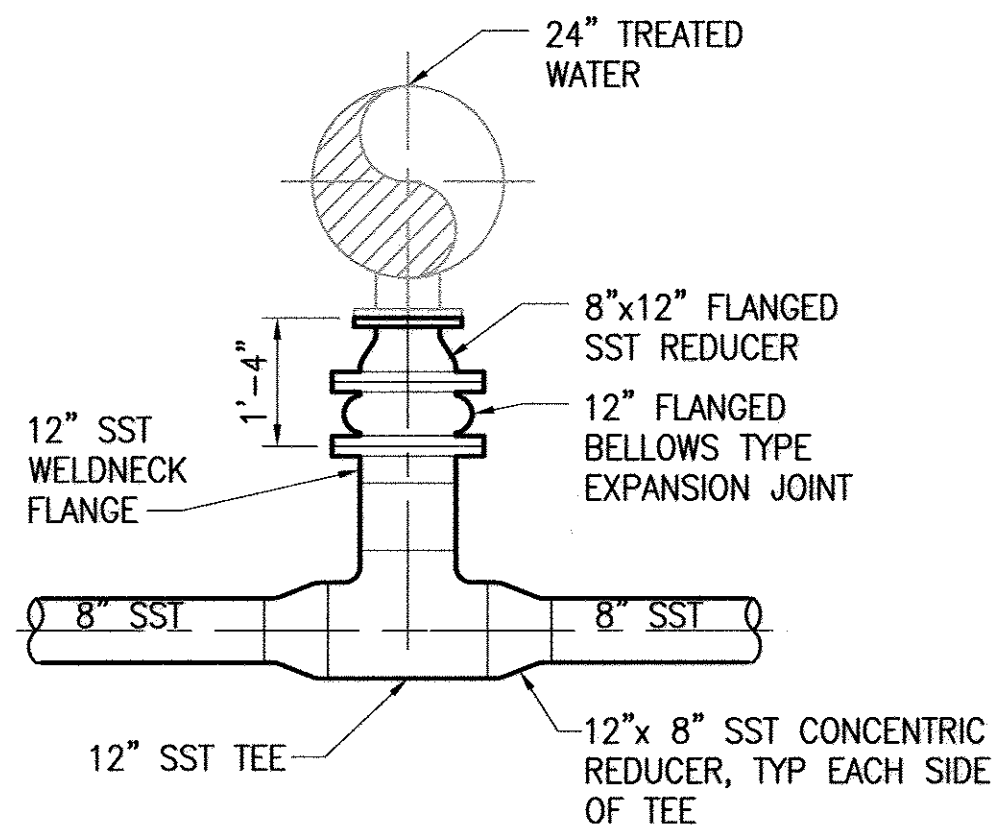

FLEXIBLE BELLOWS TYPE CONNECTION 4A
SCALE: 1/2"=1'-0"

NOTE:
CONNECTION FOR 24" RAW WATER TO NITRATE VESSELS IS SIMILAR.

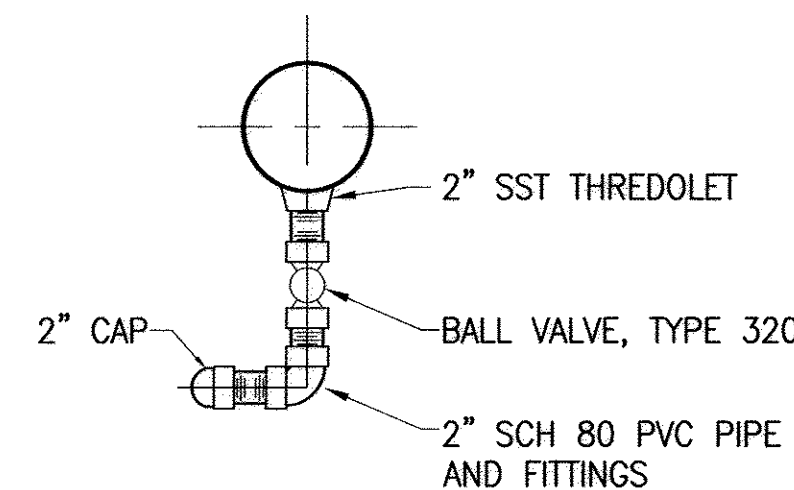

DRAIN 6
SCALE: 1 1/2"=1'-0"

RECORD DRAWING
Date: 08-23-07

These record drawings apply only to those facilities constructed under the contract identified in the title block and have been prepared, in part, on the basis of information compiled and furnished by others. The Engineer/Architect will not be responsible for any errors or omissions which have been incorporated into this drawing as a result of the work by others.

PWS: S:\VBA\100-041-000 Phase III\PlanSet\Specs-DP2.dwg
 DATE: Nov 08, 2007 3:42 pm
 USER: kbadford
 PWS: S:\VBA\100-041-000 Phase III\PlanSet\Specs-DP2.dwg
 DATE: Nov 08, 2007 3:42 pm
 USER: kbadford

VERIFY SCALES
BAR IS ONE INCH ON ORIGINAL DRAWING
0 1
IF NOT ONE INCH ON THIS SHEET,
ADJUST SCALES ACCORDINGLY

APPROVAL:
DATE:
APPROVAL:
DATE:
APPROVAL:
DATE:


DESIGN BY: CJM
DRAWN BY: DTG
CHECKED BY:
DATE: AUGUST 2005

REV	DATE	DESCRIPTION	APP


BOYLE ENGINEERING CORPORATION

JURUPA COMMUNITY SERVICES DISTRICT
ION EXCHANGE WATER TREATMENT PLANT - PHASE III
MISCELLANEOUS DETAILS


DRAWING NO: DP-2
SHEET NO: 18
FILE NO: S-2268
OF 48 SHEETS

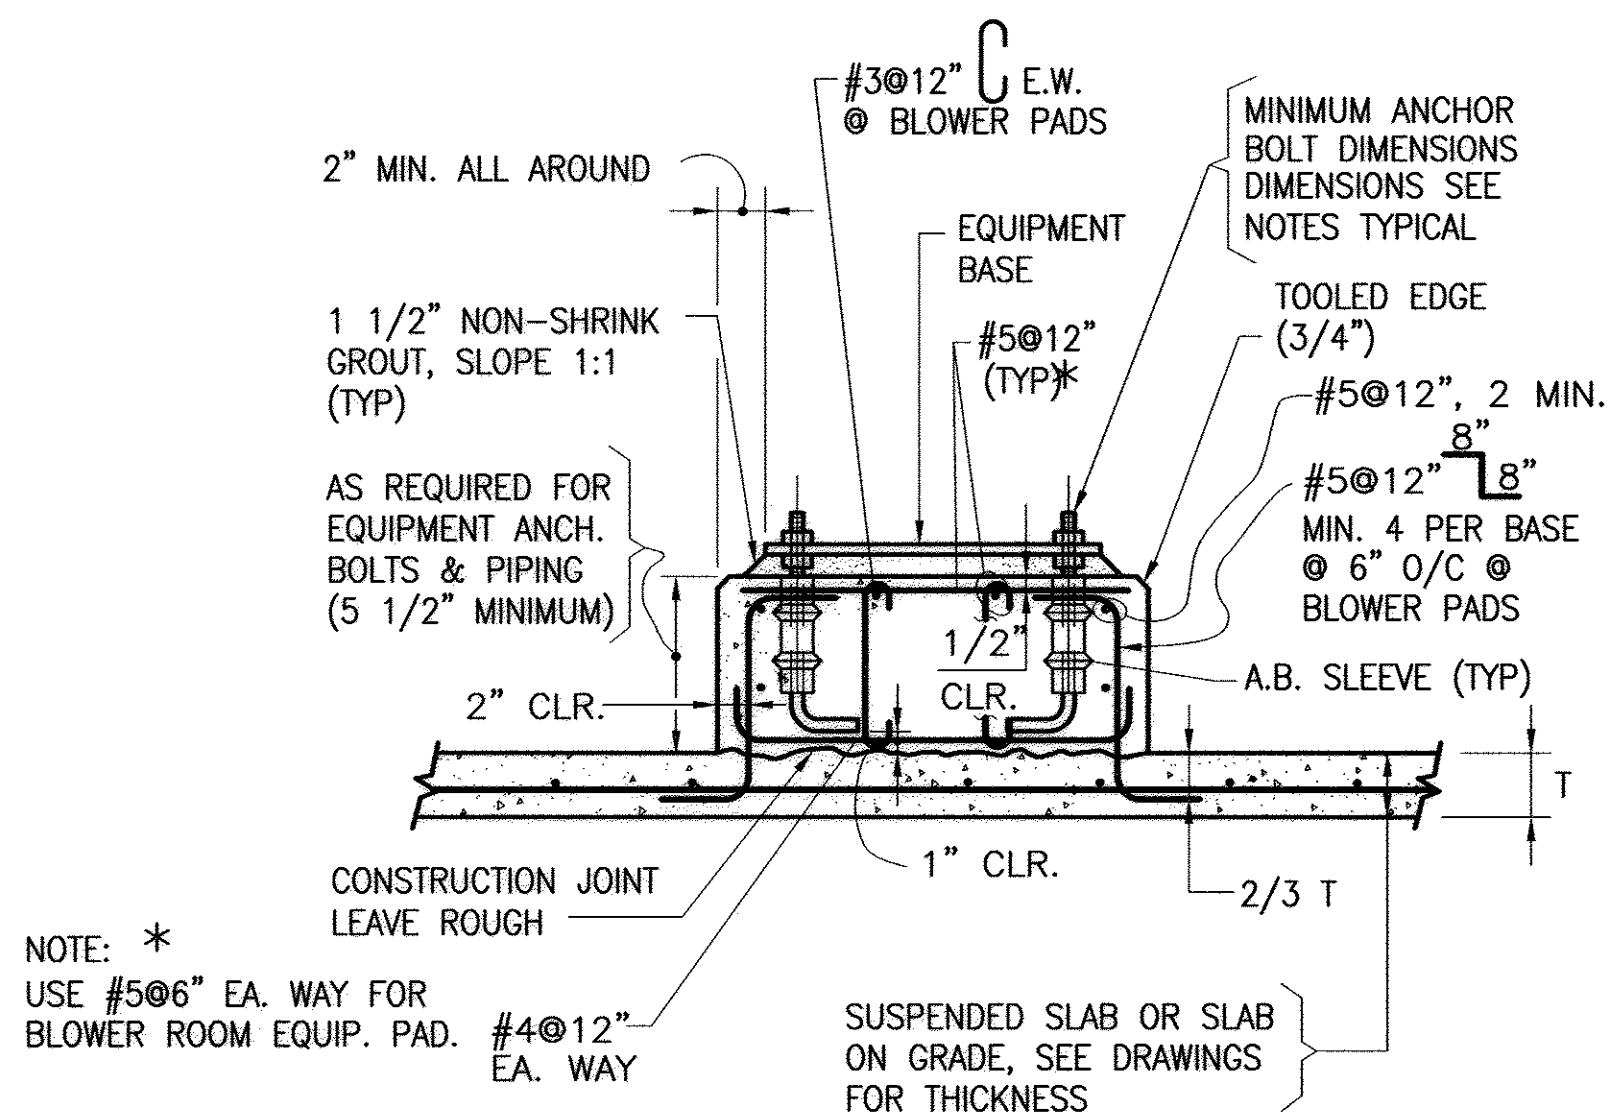


EQUIPMENT PAD DETAIL 3
NOT TO SCALE

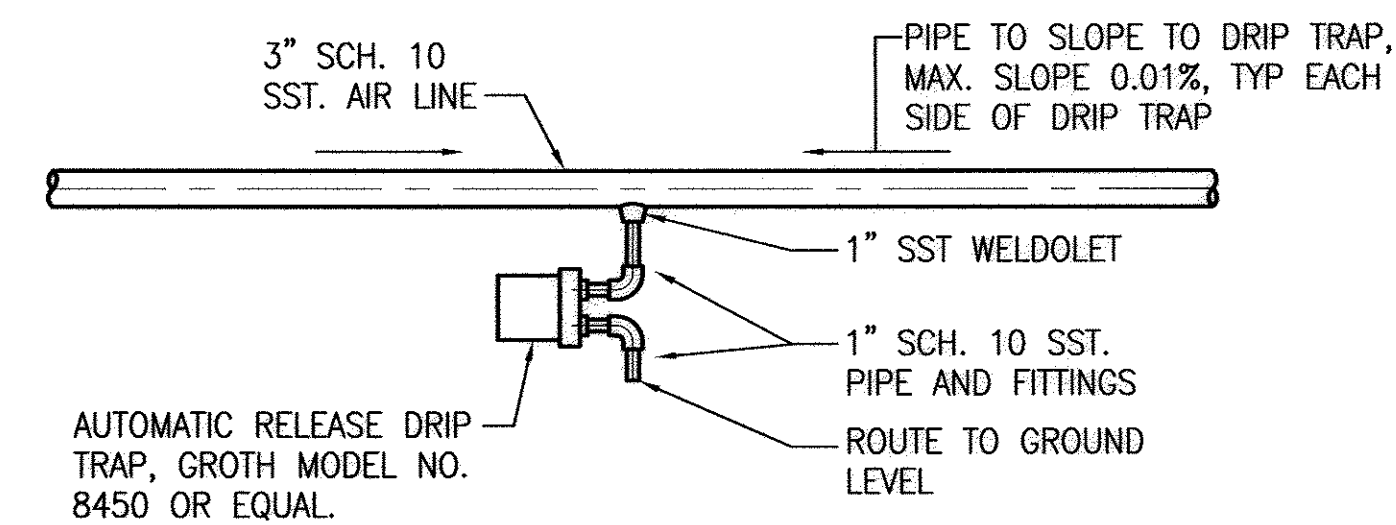


WATER TRAP DETAIL 4
NOT TO SCALE

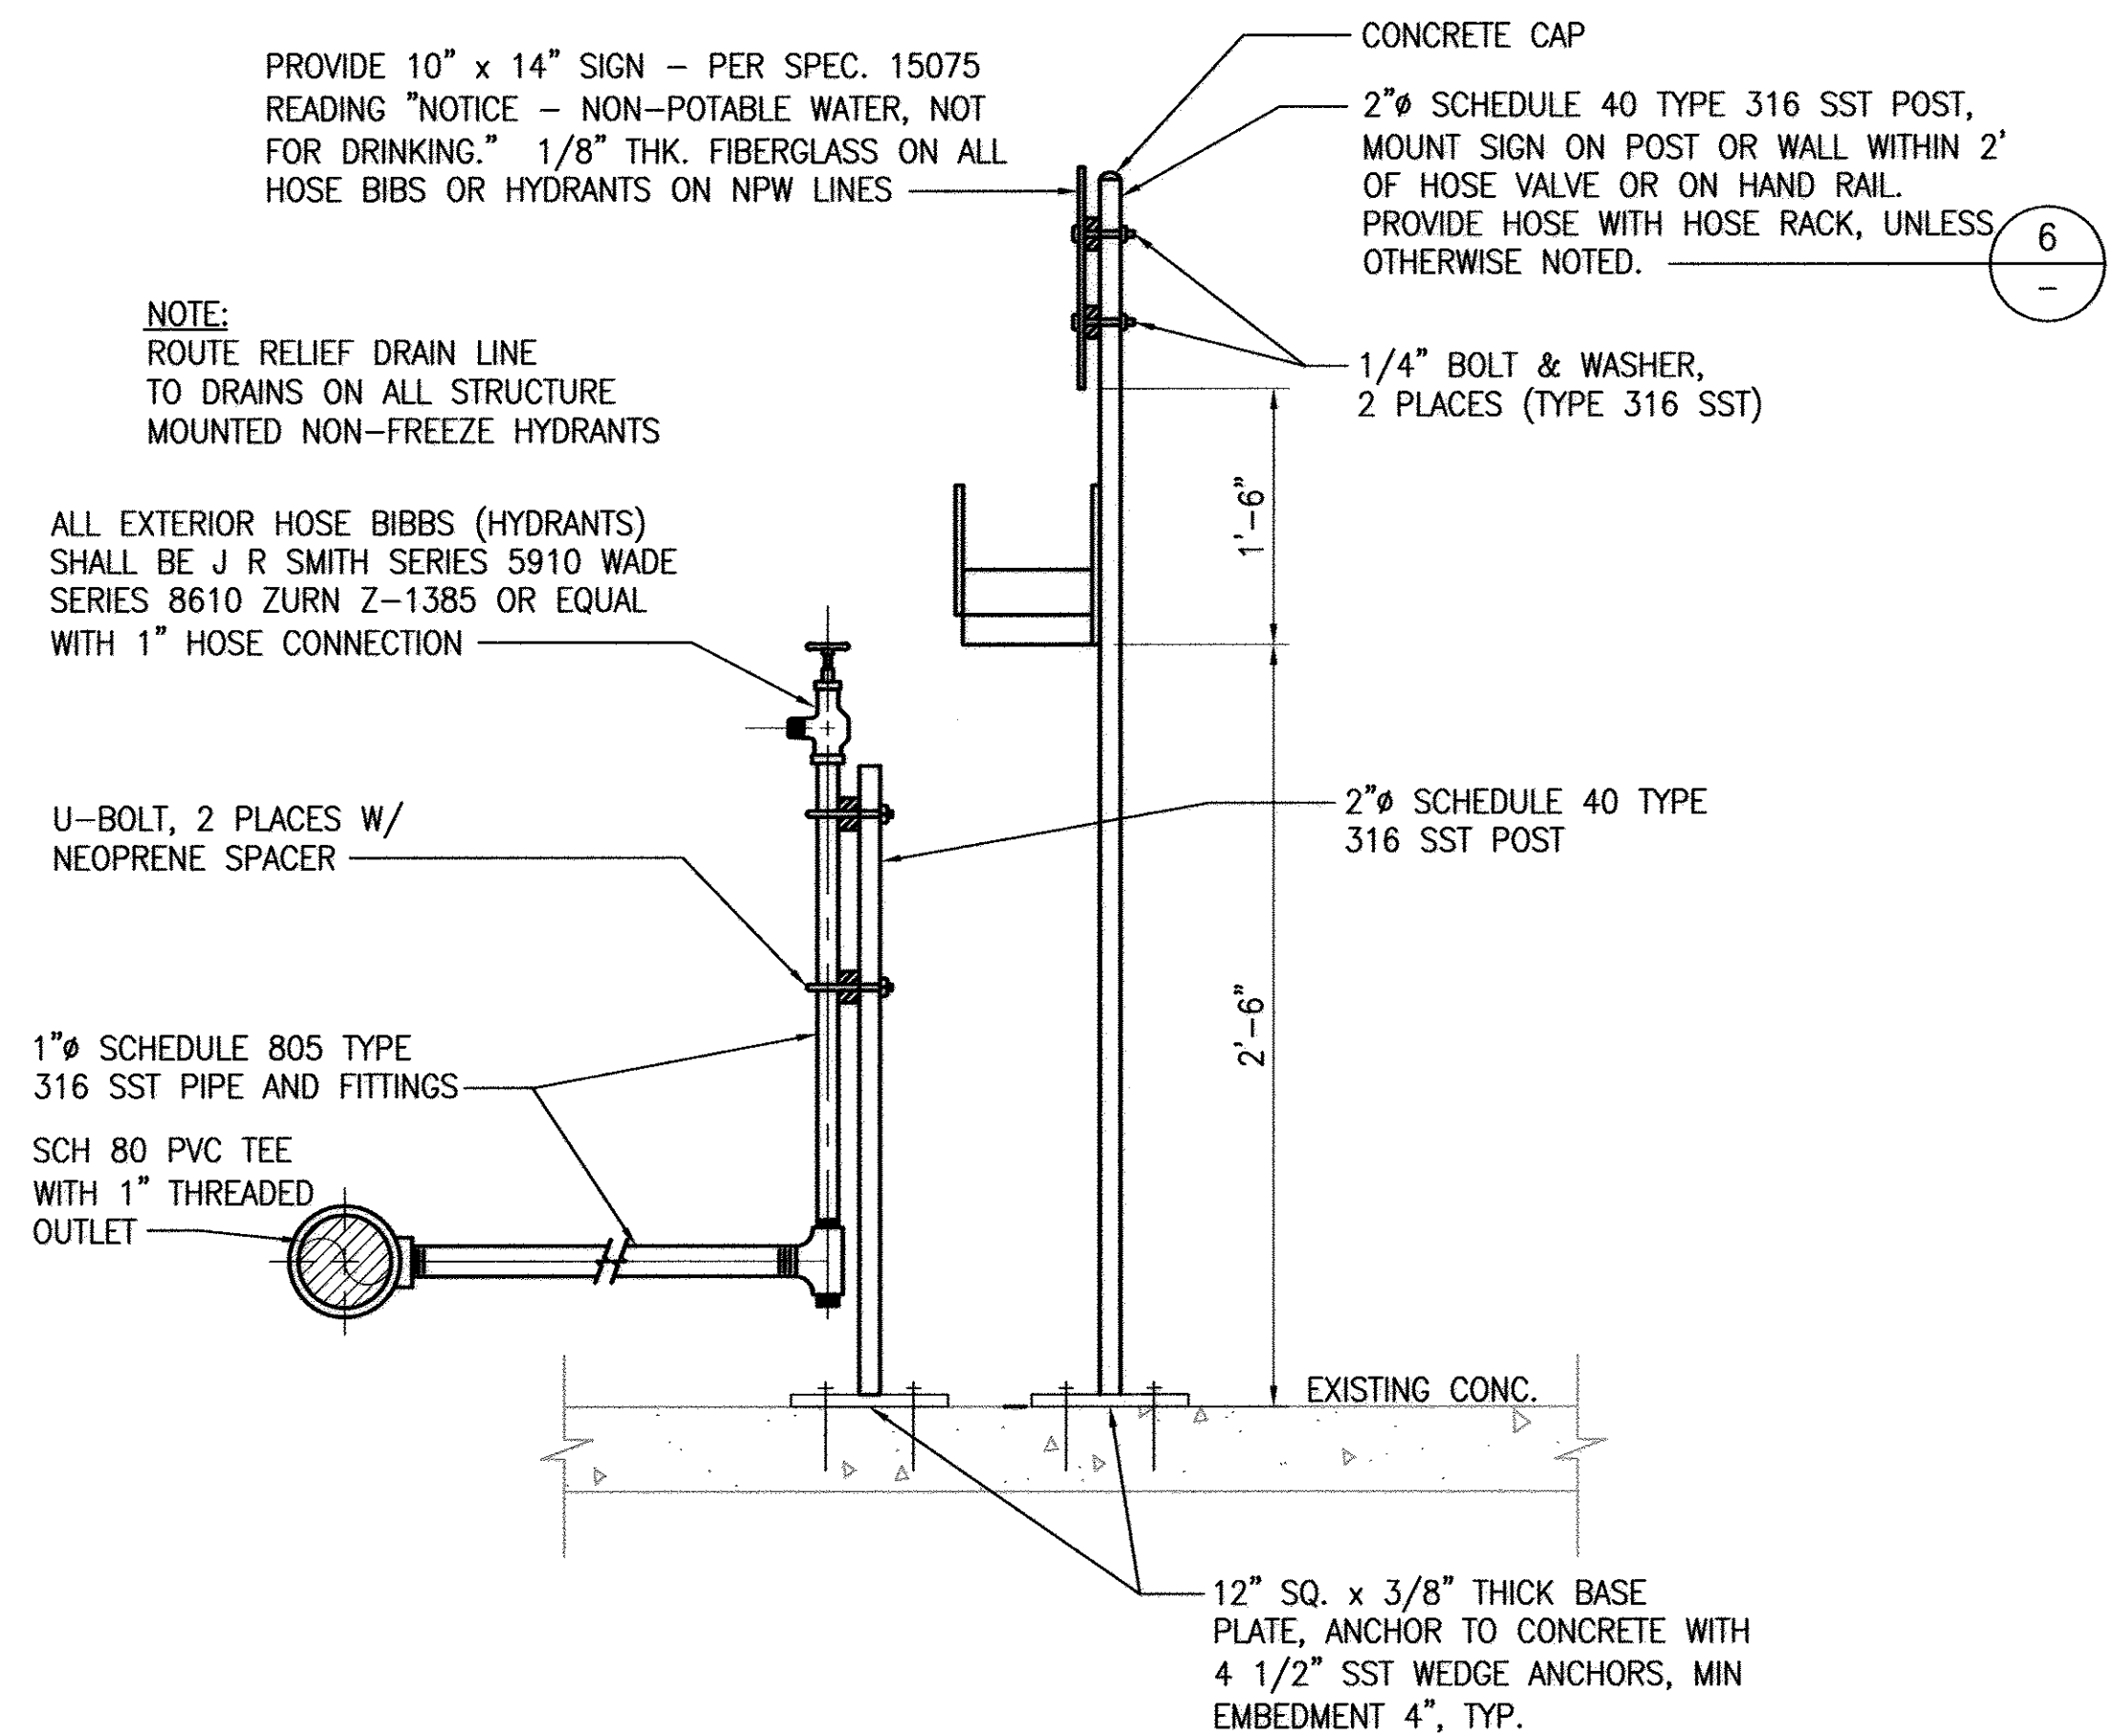

EXTERIOR NON-FREEZE HOSE VALVE & SIGN 2
NOT TO SCALE

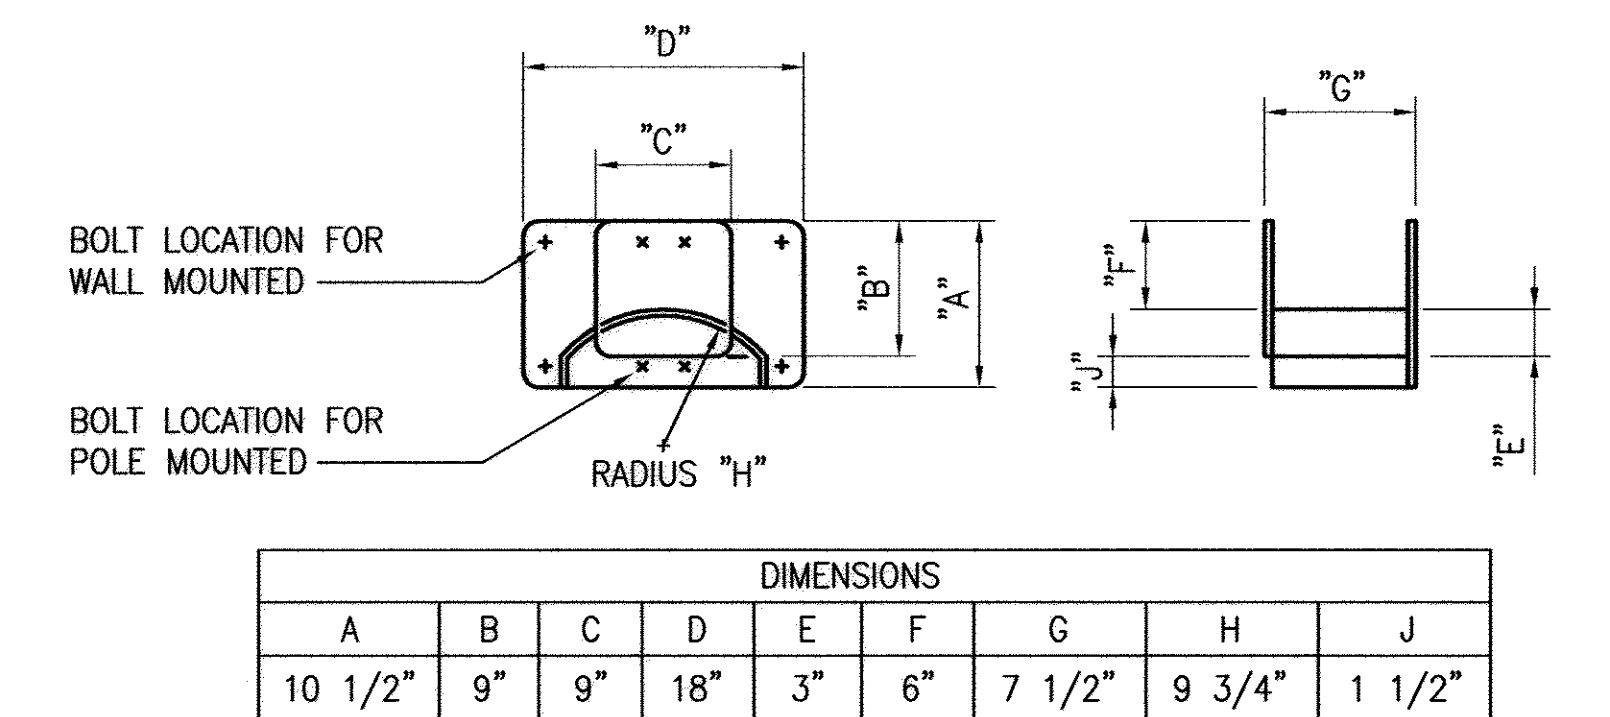

- NOTES:**
1. FABRICATE UNITS FROM 1/8" TYPE 316L SST PLATE
 2. PROVIDE EA. HOSE RACK W/ 50' OF HOSE
- WALL MOUNTED - ATTACH TO CONCRETE WALL WITH (4) 3/8" SST STUD TYPE WEDGE ANCHORS.
- POLE MOUNTED - INCLUDES POSTS, HANDRAILS, STANCHIONS, ETC... SEE BELOW

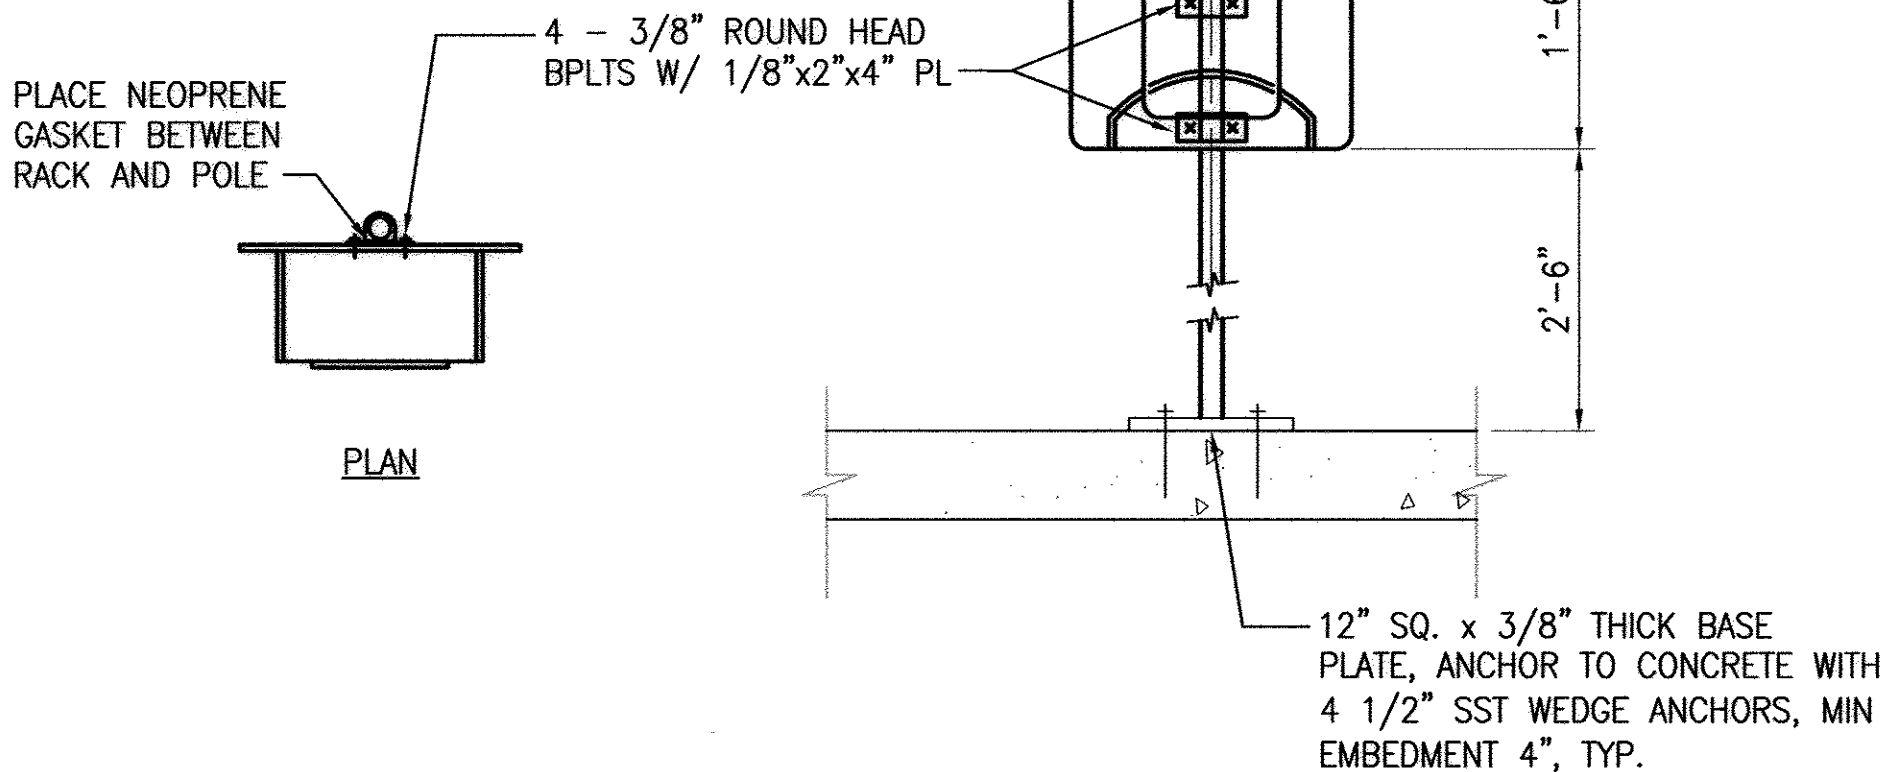

HOSE RACK DETAIL 6
NOT TO SCALE


DWG: S:\04\100-04-CAD (phase II)\PlanSet\S2268-DP3.dwg
 DATE: Nov 05, 2007 3:22pm
 USER: kbsford

VERIFY SCALES BAR IS ONE INCH ON ORIGINAL DRAWING 0 1 IF NOT ONE INCH ON THIS SHEET, ADJUST SCALES ACCORDINGLY	APPROVAL: _____ APPROVAL: _____ APPROVAL: _____	DATE: _____ DATE: _____ DATE: _____	DESIGN BY: LRM DRAWN BY: DTG CHECKED BY: _____ DATE: AUGUST 2005	REV _____ DATE _____ DESCRIPTION _____ APP _____
--	--	--	---	---



JURUPA COMMUNITY SERVICES DISTRICT ION EXCHANGE WATER TREATMENT PLANT - PHASE III MISCELLANEOUS DETAIL SHEET	DRAWING NO: _____ SHEET NO: DP-3 19 OF 48 SHEETS FILE NO: _____ S-2268
--	--

RECORD DRAWING
 Date: 08-23-07
 These record drawings apply only to those facilities constructed under the contract identified in the title block and have been prepared, in part, on the basis of information compiled and furnished by others. The Engineer/Architect will not be responsible for any errors or omissions which have been incorporated into this drawing as a result of the work by others.

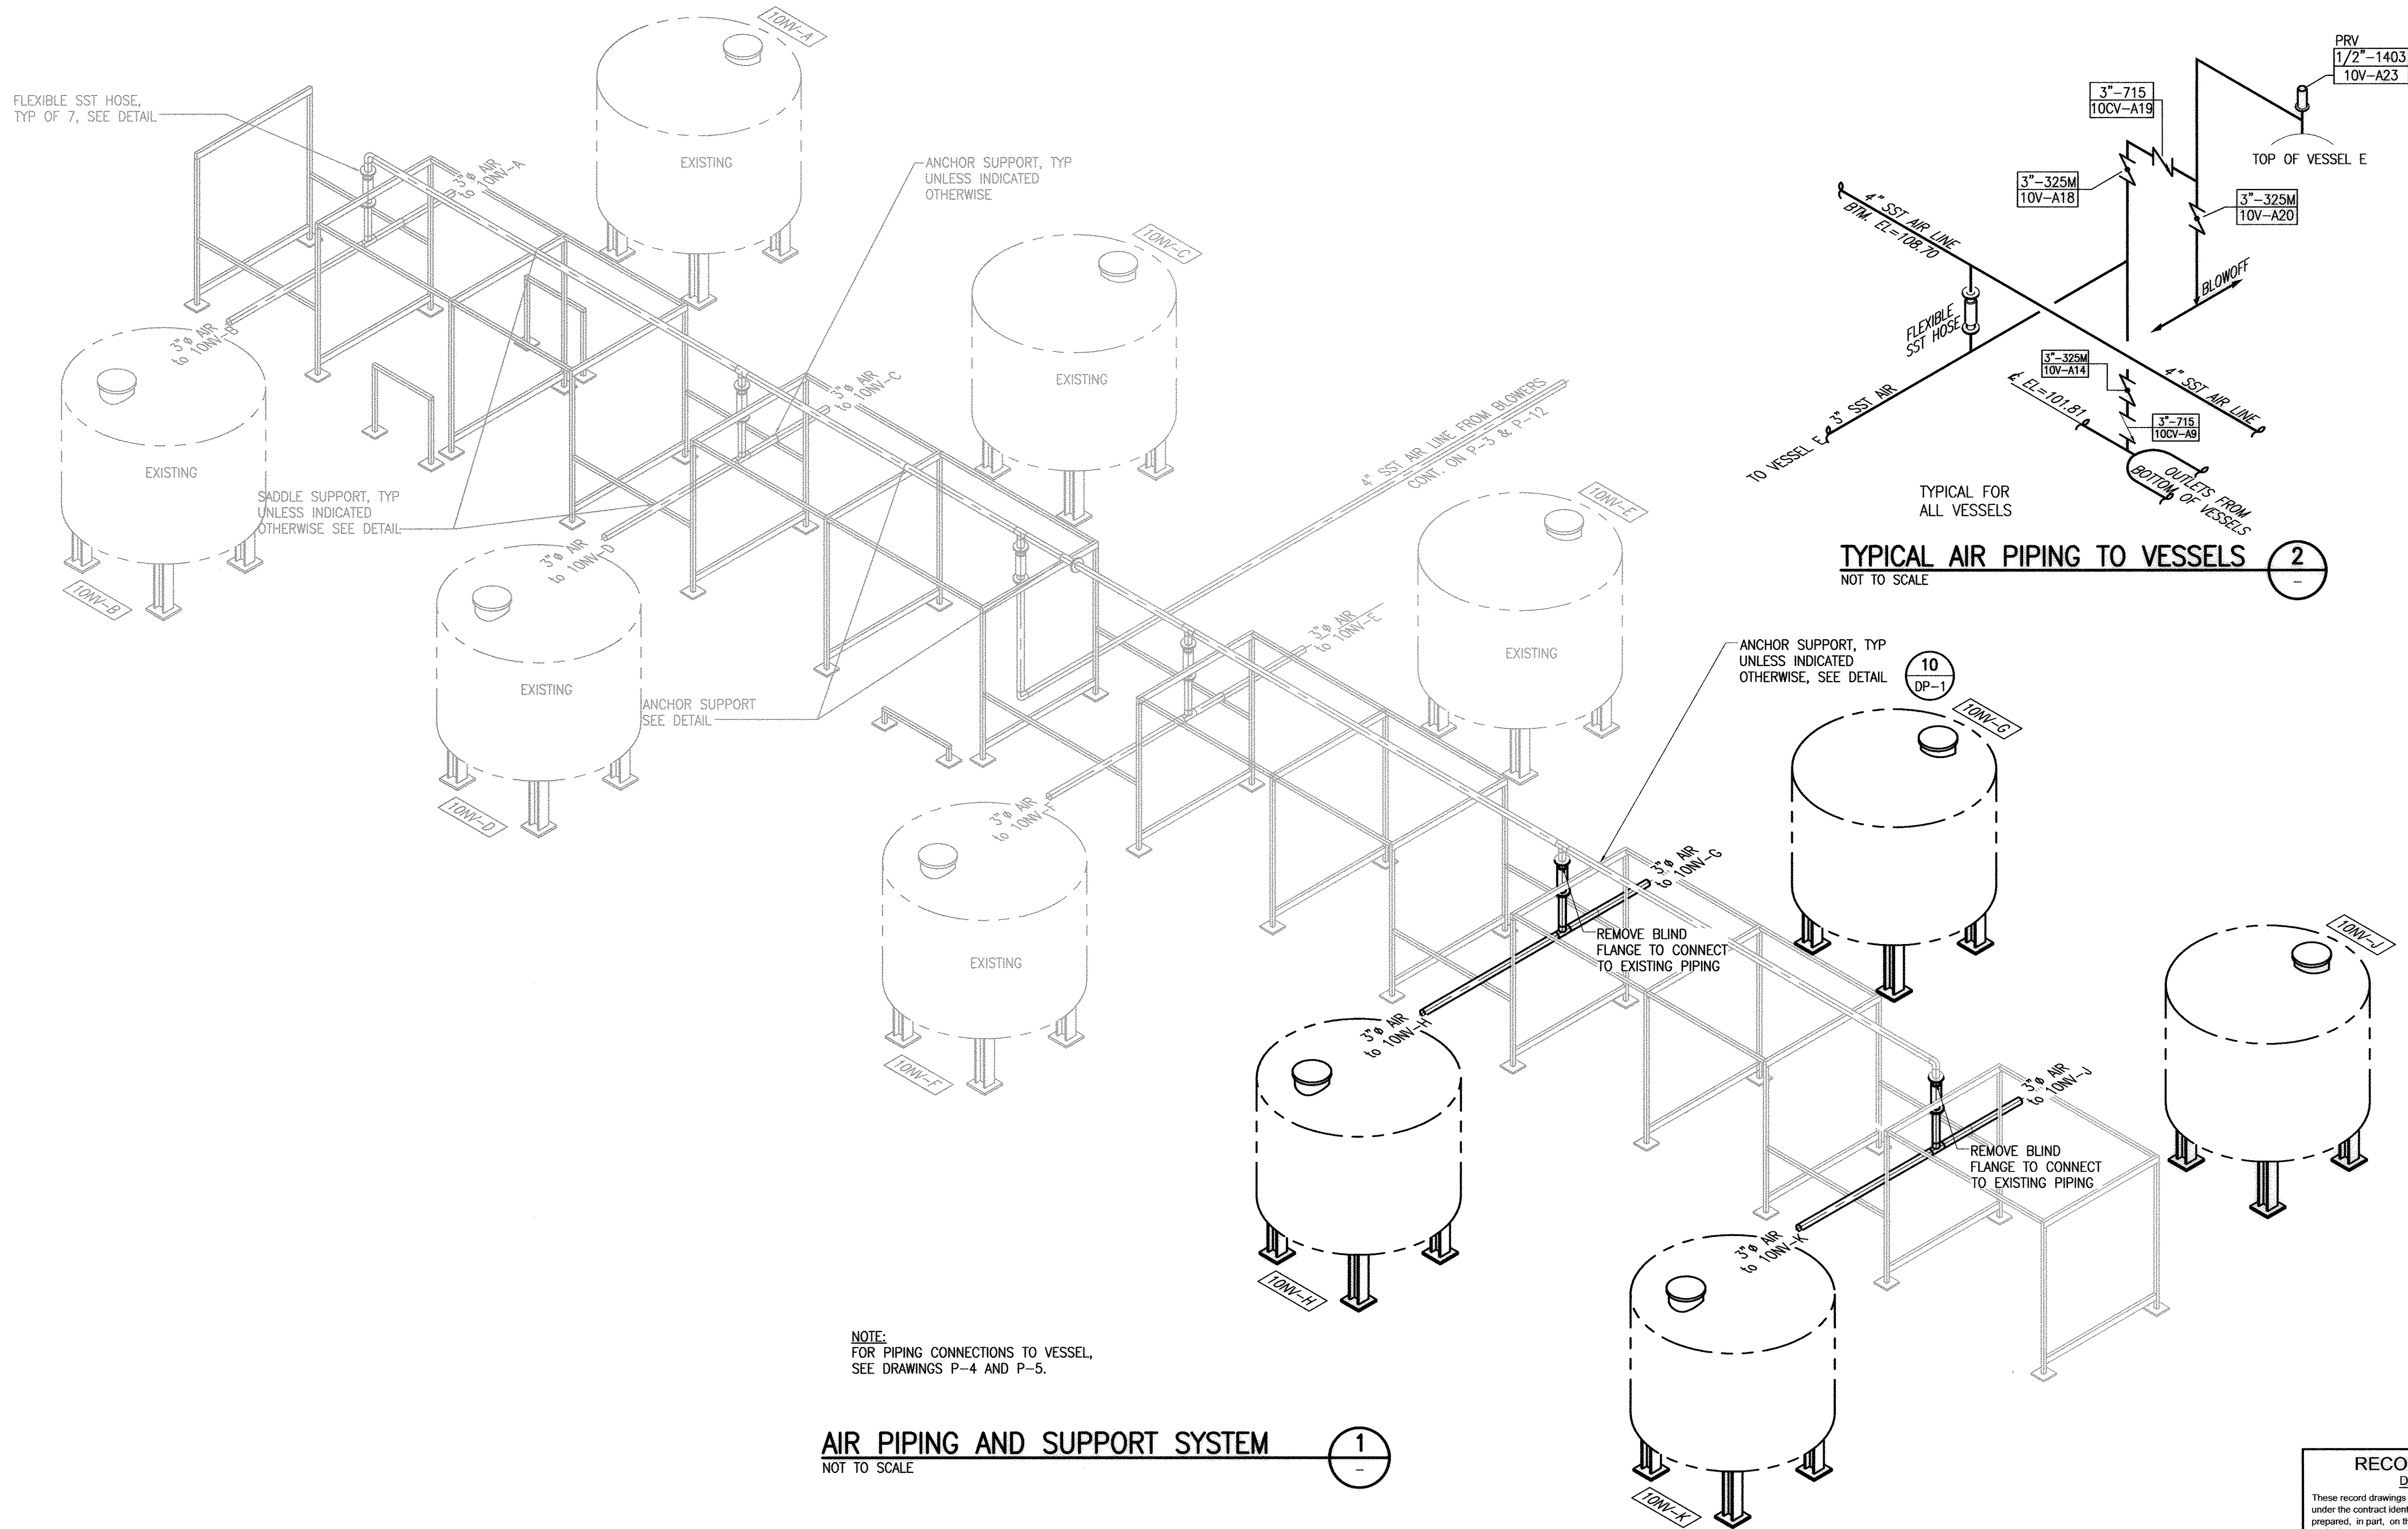

AIR PIPING AND SUPPORT SYSTEM
NOT TO SCALE

TYPICAL AIR PIPING TO VESSELS
NOT TO SCALE

RECORD DRAWING
Date: 08-23-07
These record drawings apply only to those facilities constructed under the contract identified in the title block and have been prepared, in part, on the basis of information compiled and furnished by others. The Engineer/Architect will not be responsible for any errors or omissions which have been incorporated into this drawing as a result of the work by others.

DWG: S:\J04\100-04-CAD (Phase III)\PlanSet\2268-DPE.dwg
DATE: Nov 08, 2007 3:24pm
USER: kkeeford
XREFS: 2268BDR


VERIFY SCALES
BAR IS ONE INCH ON ORIGINAL DRAWING
0 1
IF NOT ONE INCH ON THIS SHEET,
ADJUST SCALES ACCORDINGLY

APPROVAL:	DATE:	DESIGN BY:	CJM						
APPROVAL:	DATE:	DRAWN BY:	DTG						
APPROVAL:	DATE:	CHECKED BY:							
	DATE:		AUGUST 2005	REV	DATE	DESCRIPTION	APP		



JURUPA COMMUNITY SERVICES DISTRICT
ION EXCHANGE WATER TREATMENT PLANT - PHASE III
AIR LINE SCHEMATIC

DRAWING NO:	SHEET NO:
DP-6	22
FILE NO:	OF 48 SHEETS
	S-2268

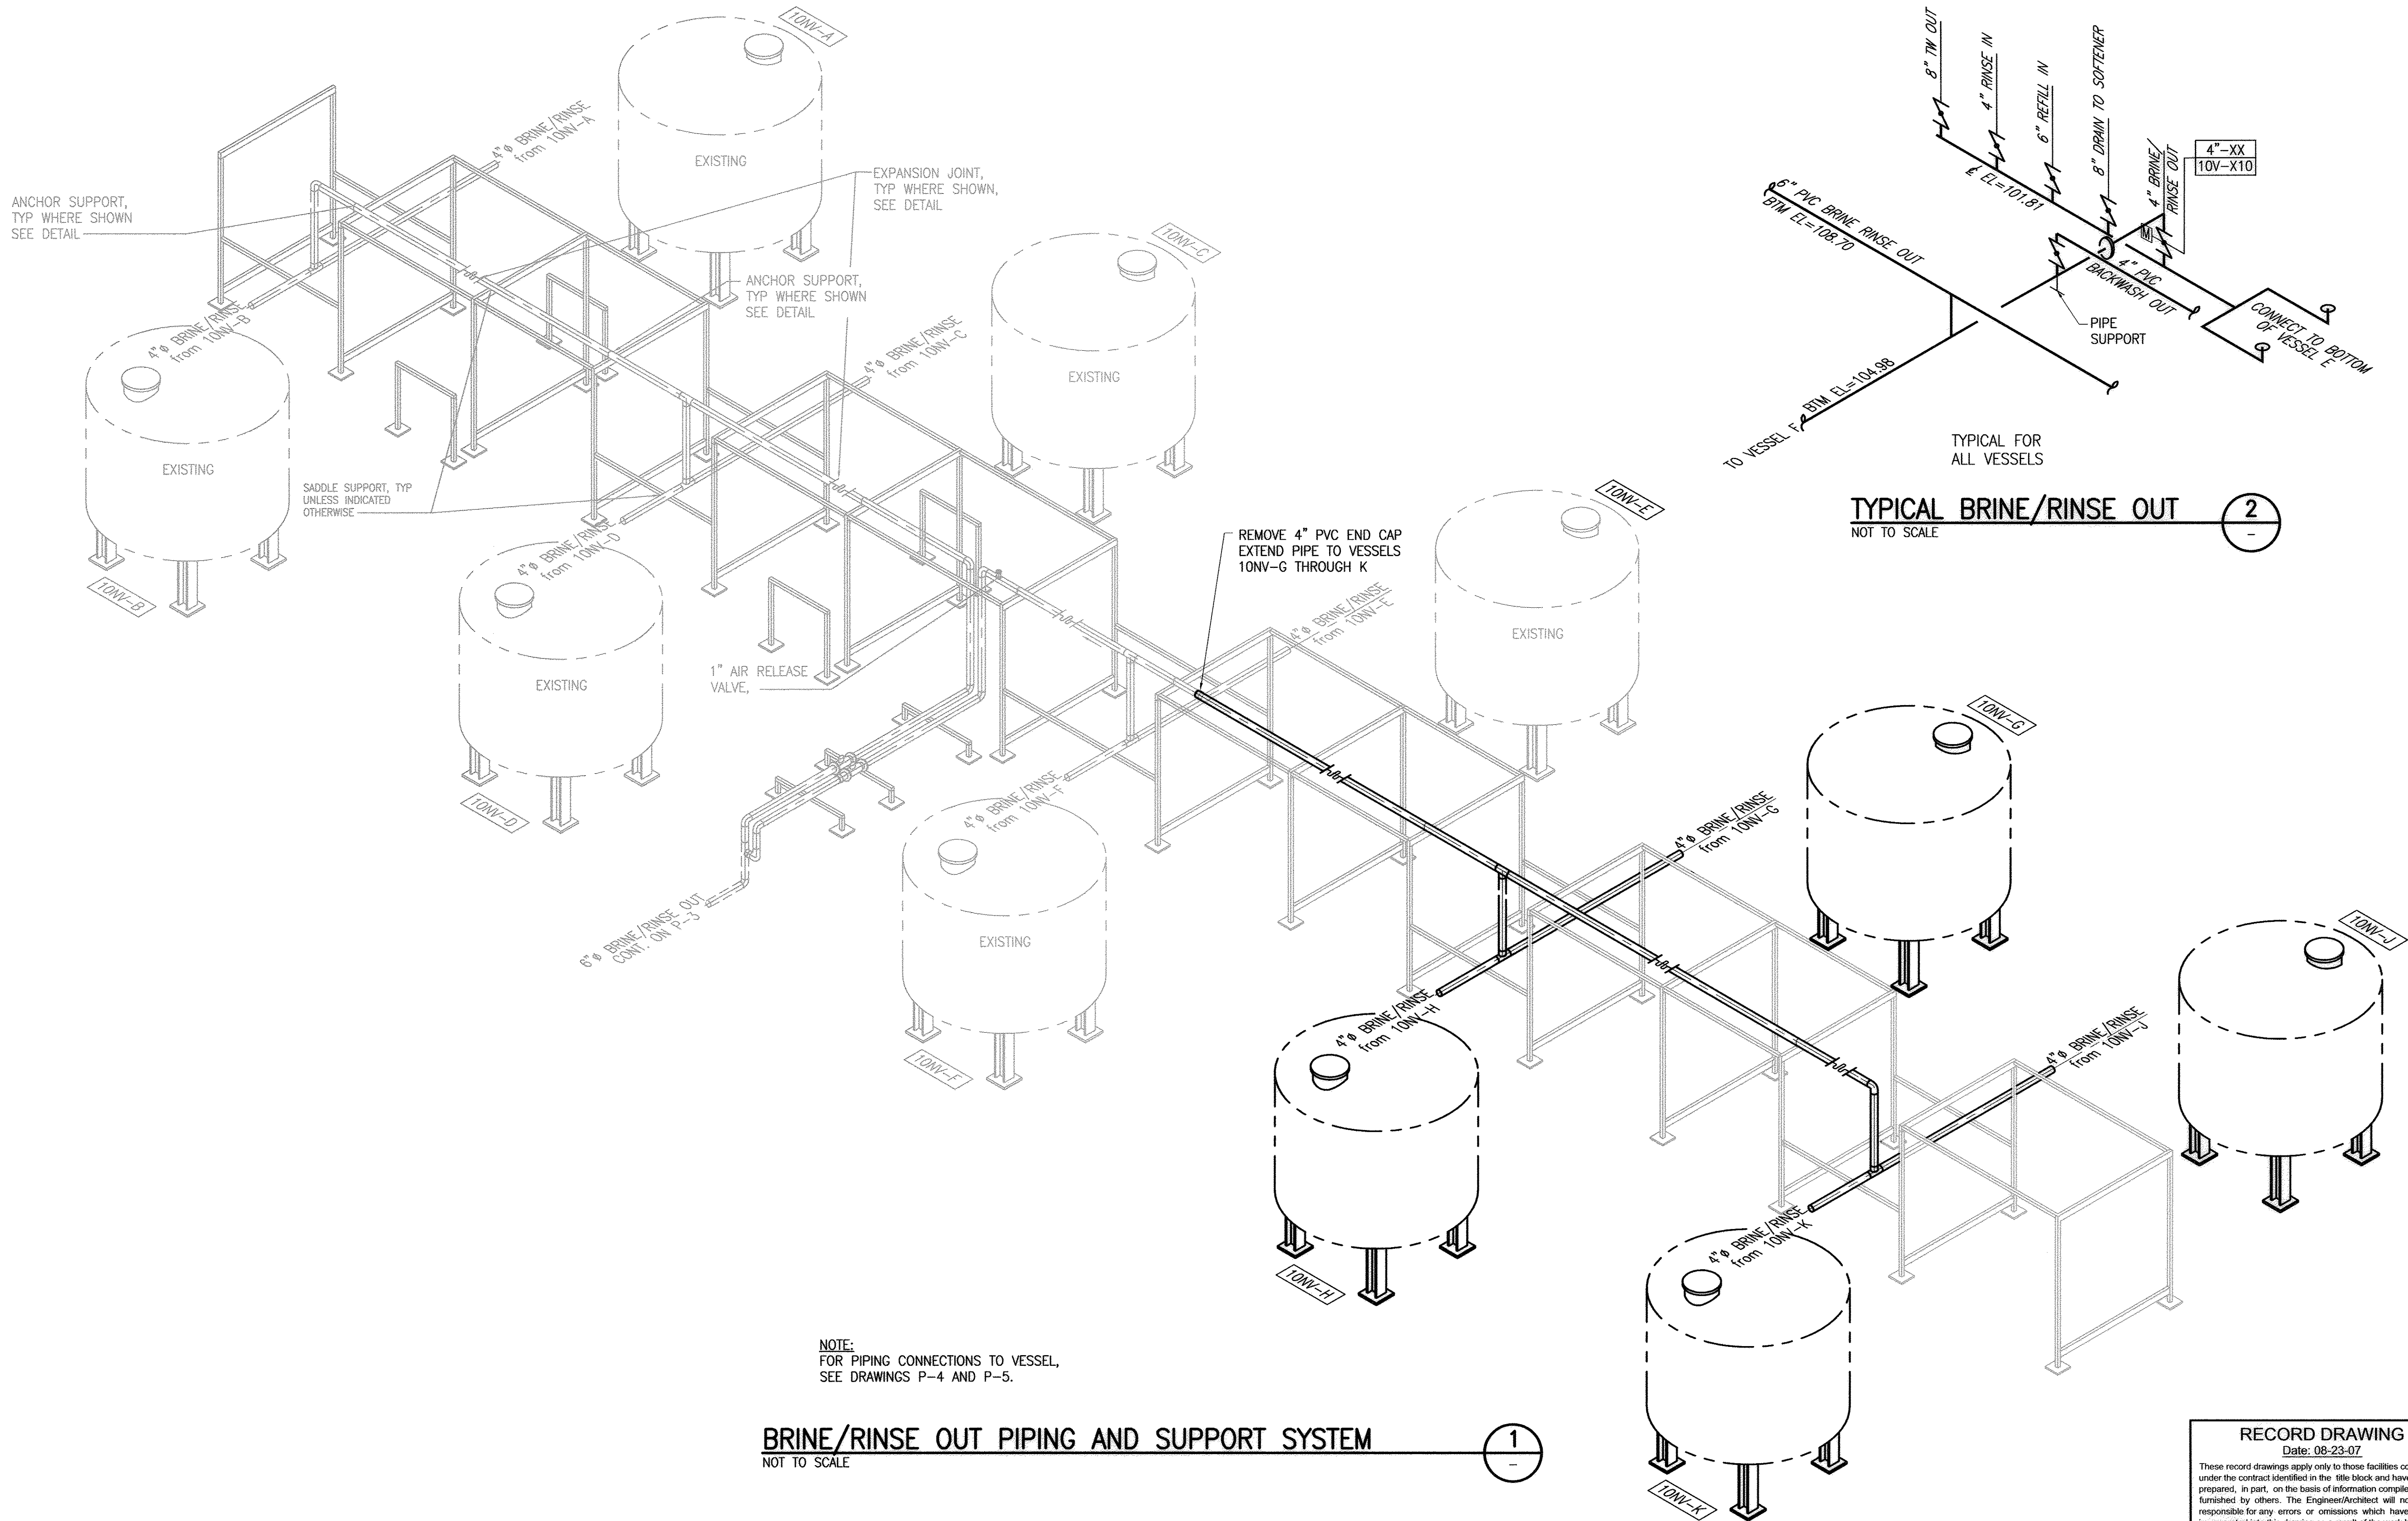

NOTE:
FOR PIPING CONNECTIONS TO VESSEL,
SEE DRAWINGS P-4 AND P-5.

BRINE/RINSE OUT PIPING AND SUPPORT SYSTEM
NOT TO SCALE

TYPICAL BRINE/RINSE OUT
NOT TO SCALE

2
-

RECORD DRAWING
Date: 08-23-07
These record drawings apply only to those facilities constructed under the contract identified in the title block and have been prepared, in part, on the basis of information compiled and furnished by others. The Engineer/Architect will not be responsible for any errors or omissions which have been incorporated into this drawing as a result of the work by others.

DWG: S:\J04\100-04-CAD (Phase III)\Plans\52268-DPE.dwg USER: kbsford
DATE: Nov 08, 2007 3:26pm XREFS: 52268DR


VERIFY SCALES
BAR IS ONE INCH ON ORIGINAL DRAWING
0 1
IF NOT ONE INCH ON THIS SHEET,
ADJUST SCALES ACCORDINGLY

APPROVAL:	DATE:	DESIGN BY:	CJM						
APPROVAL:	DATE:	DRAWN BY:	DTG						
APPROVAL:	DATE:	CHECKED BY:							
APPROVAL:	DATE:	DATE:	AUGUST 2005	REV	DATE	DESCRIPTION	APP		

BOYLE ENGINEERING CORPORATION

JURUPA COMMUNITY SERVICES DISTRICT
ION EXCHANGE WATER TREATMENT PLANT - PHASE III
BRINE/RINSE OUT SCHEMATIC

DRAWING NO: SHEET NO:
DP-8 **24**
OF 48 SHEETS
FILE NO: S-2268

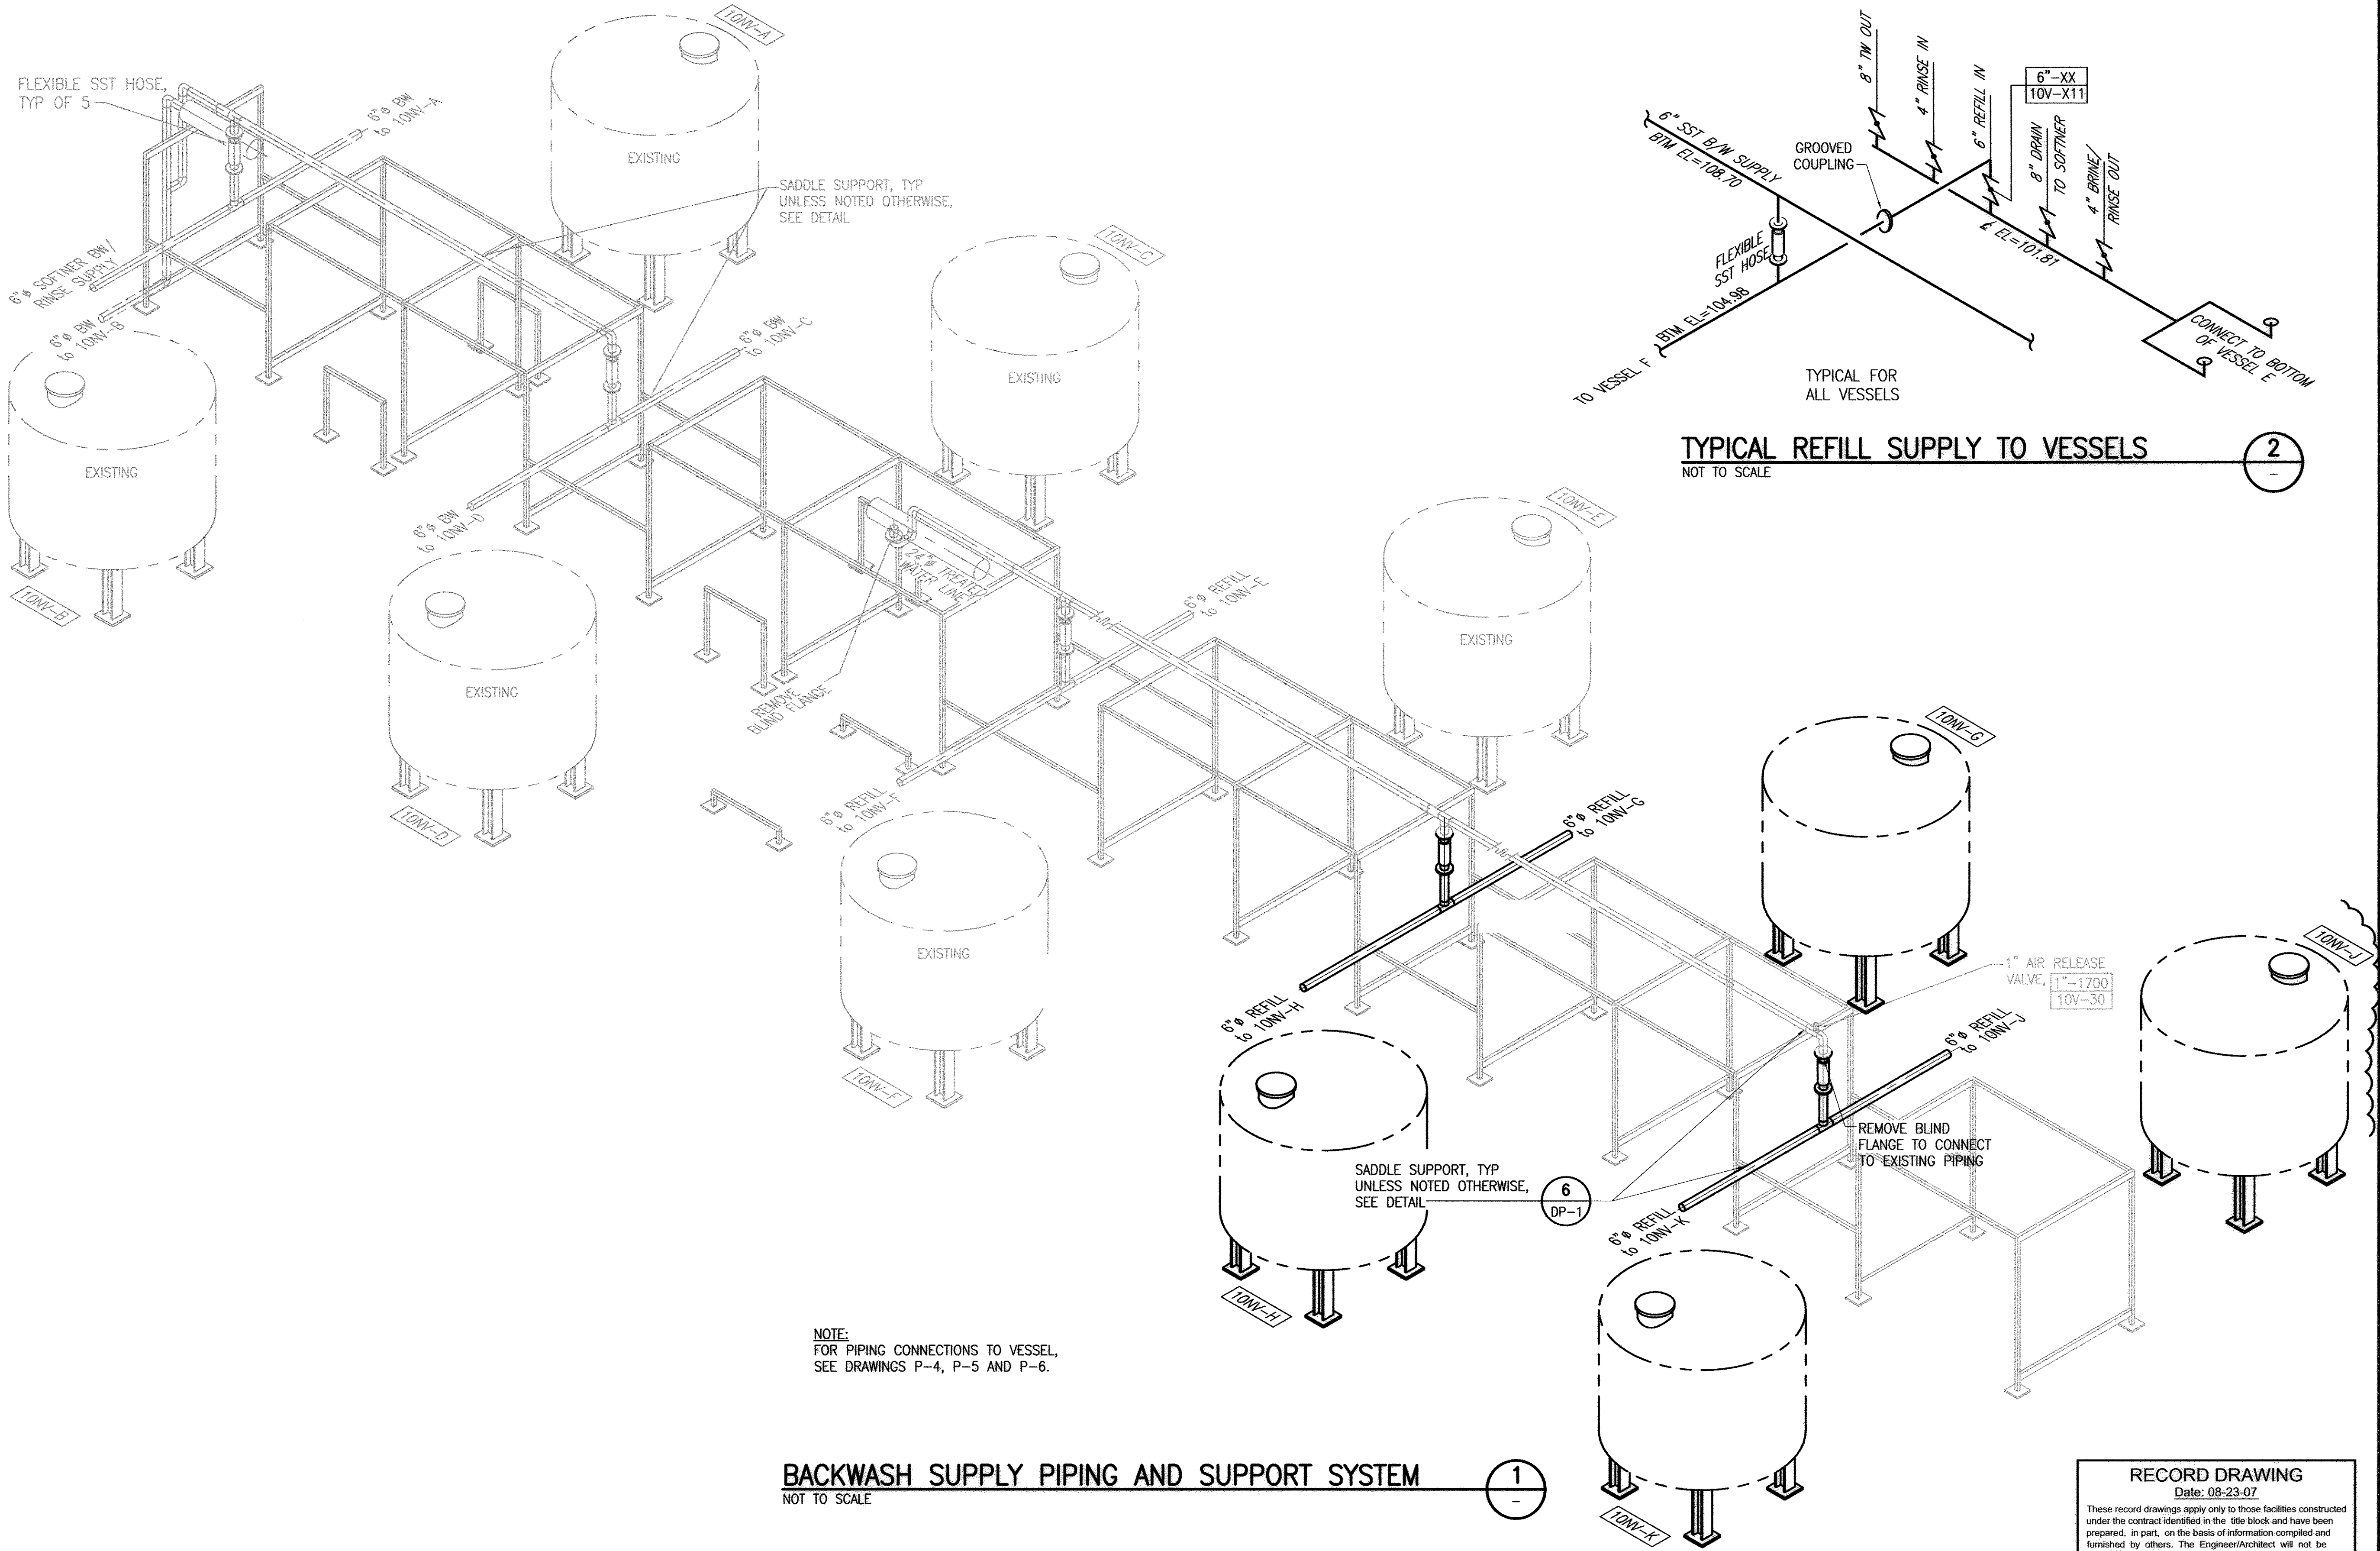

BACKWASH SUPPLY PIPING AND SUPPORT SYSTEM
NOT TO SCALE

TYPICAL REFILL SUPPLY TO VESSELS
NOT TO SCALE

2


RECORD DRAWING
Date: 08-23-07
These record drawings apply only to those facilities constructed under the contract identified in the title block and have been prepared, in part, on the basis of information compiled and furnished by others. The Engineer/Architect will not be responsible for any errors or omissions which have been incorporated into this drawing as a result of the work by others.

PLG: SJUWA 100-040 C00 (Phase III) Rev 5/04 SCS-08-DP3.dwg
DATE: Nov 03, 2007 1:53pm
USER: kseford
PROJECT: 5226808

VERIFY SCALES BAR IS ONE INCH ON ORIGINAL DRAWING 0 1 IF NOT ONE INCH ON THIS SHEET, ADJUST SCALES ACCORDINGLY		APPROVAL:	DATE:	DESIGN BY: CJM					
		APPROVAL:	DATE:	DRAWN BY: DTG					
		APPROVAL:	DATE:	CHECKED BY:					
		APPROVAL:	DATE:	DATE: AUGUST 2005	REV	DATE	DESCRIPTION	APP	

BOYLE ENGINEERING CORPORATION

JURUPA COMMUNITY SERVICES DISTRICT ION EXCHANGE WATER TREATMENT PLANT - PHASE III		DRAWING NO:	SHEET NO:
REFILL SUPPLY SCHEMATIC		DP-9	25
		FILE NO:	OF 48 SHEETS
		S-2268	

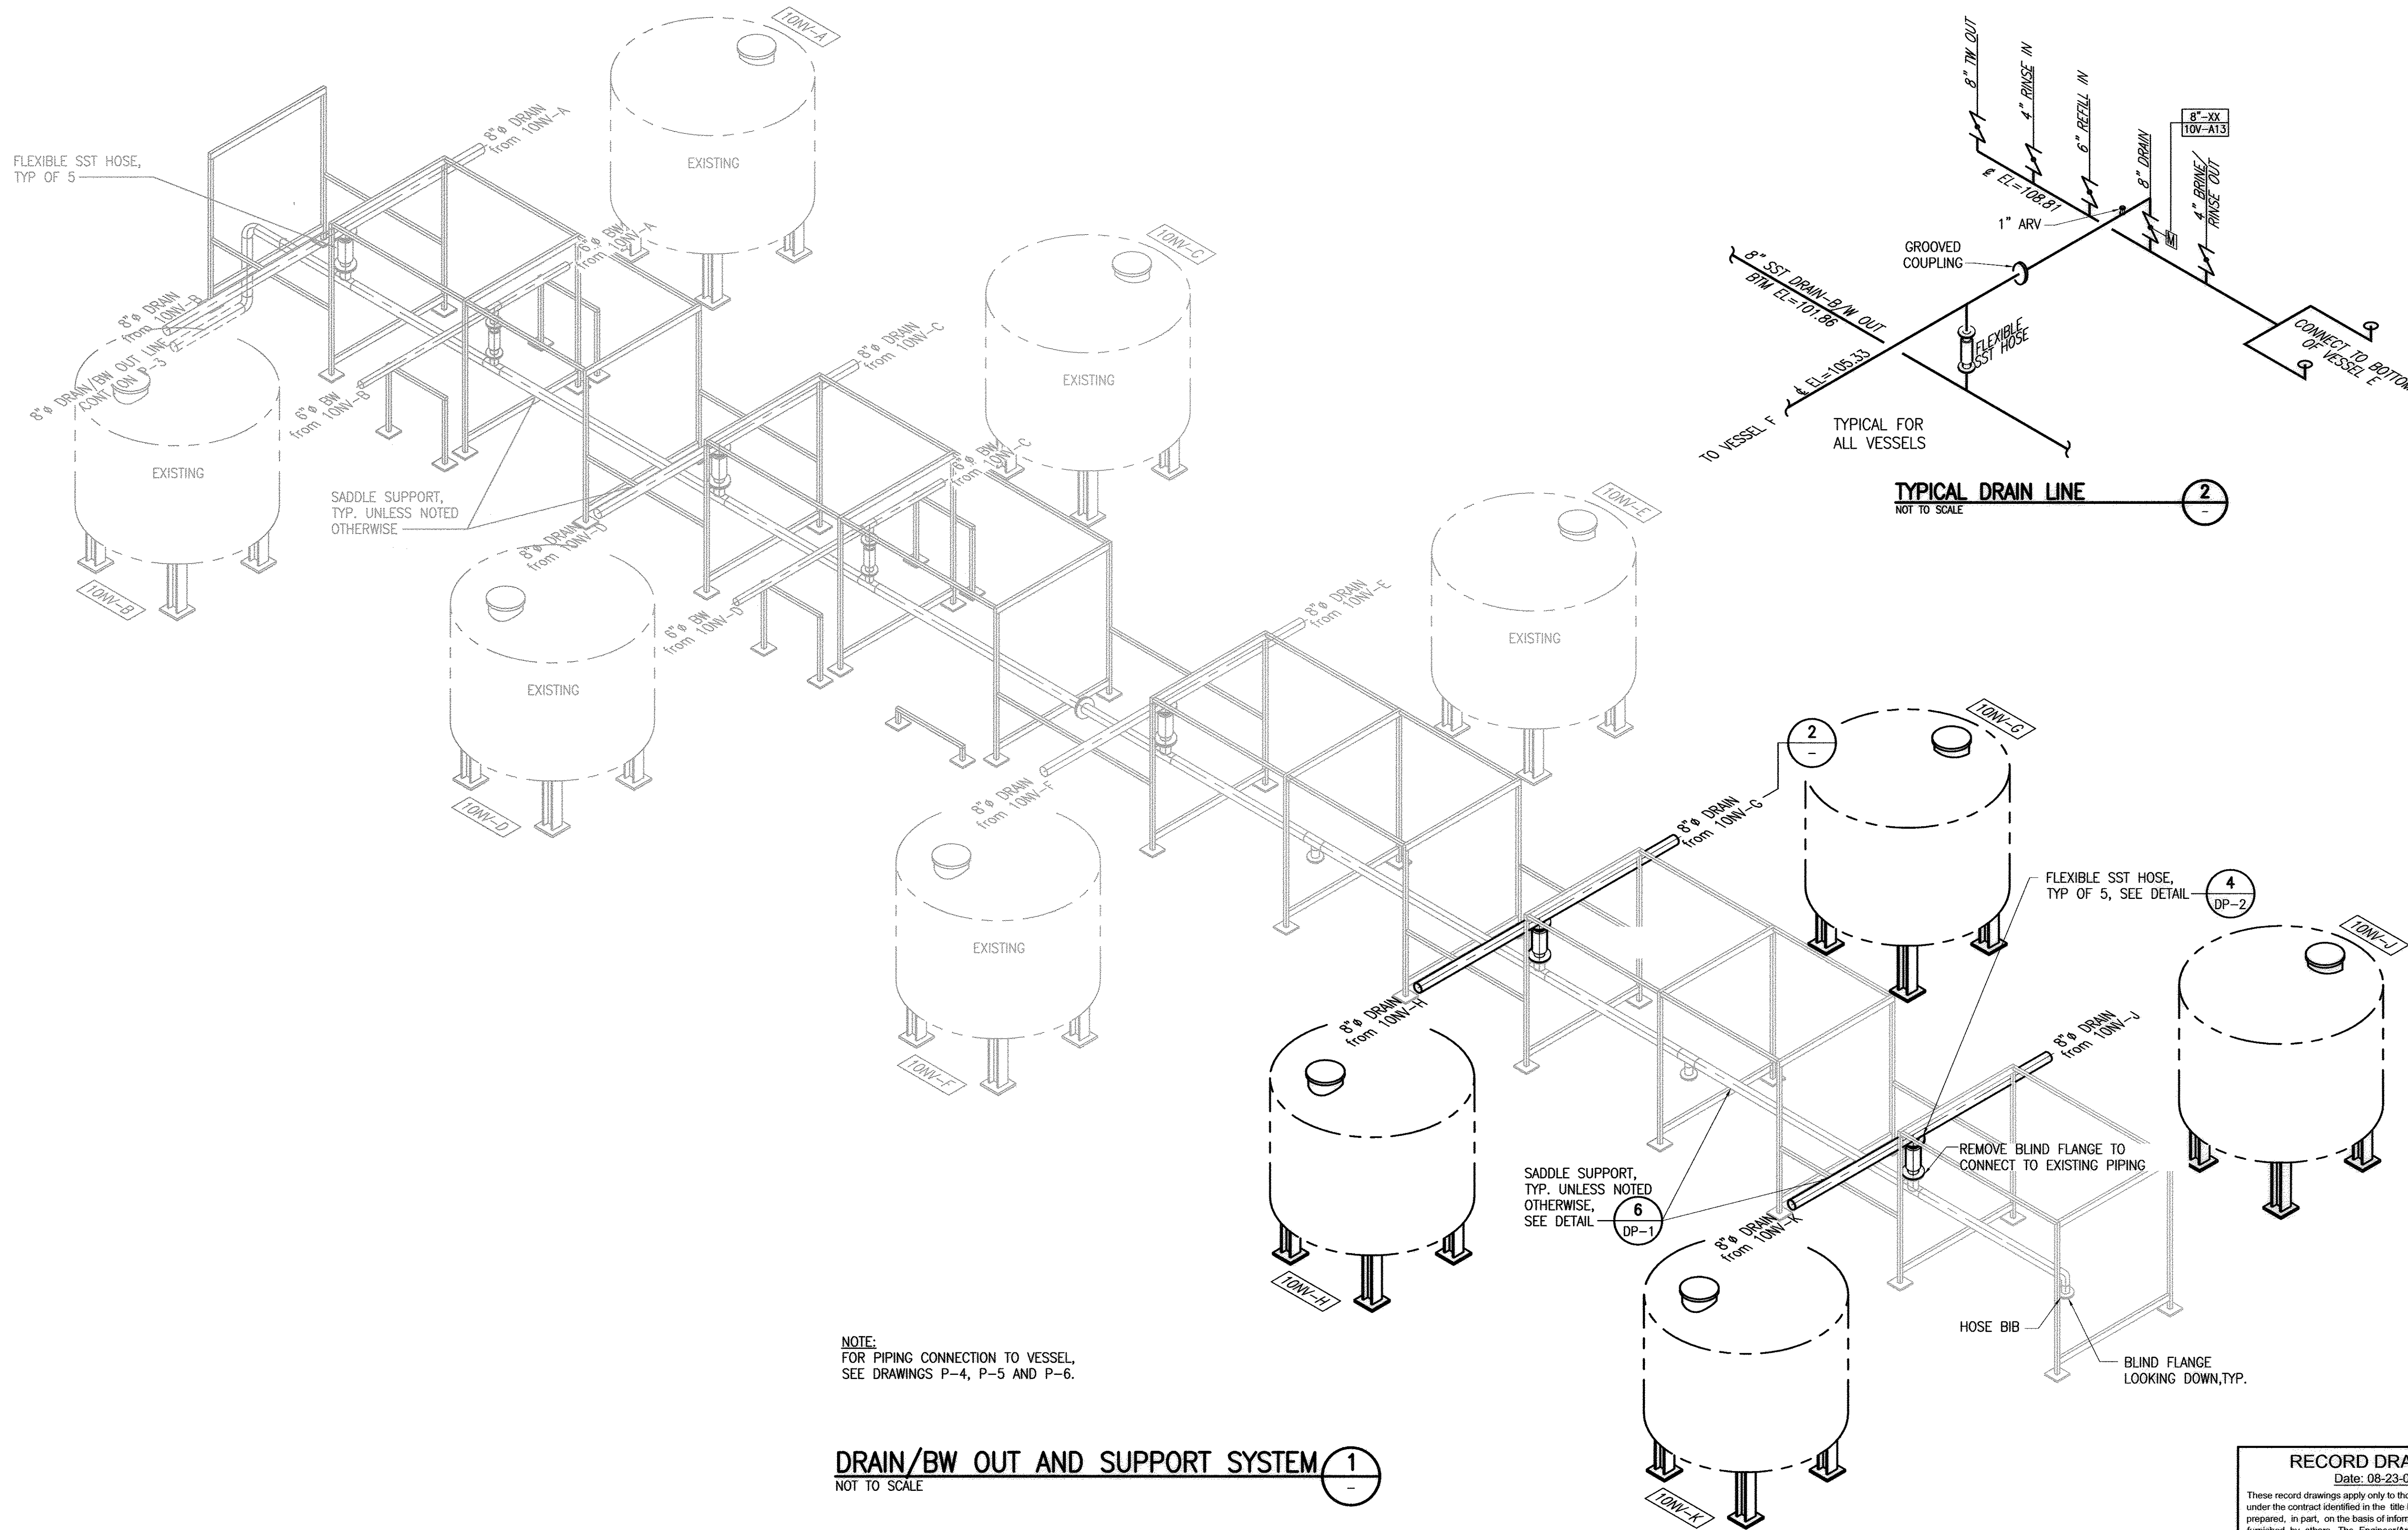

DRAIN/BW OUT AND SUPPORT SYSTEM 1
NOT TO SCALE

RECORD DRAWING
Date: 08-23-07
These record drawings apply only to those facilities constructed under the contract identified in the title block and have been prepared, in part, on the basis of information compiled and furnished by others. The Engineer/Architect will not be responsible for any errors or omissions which have been incorporated into this drawing as a result of the work by others.


D:\CADD\100-04-CAD (Phase 1)\100-04-CAD\100-04-CAD.dwg
 DATE: Nov 03, 2007 3:21 pm
 USER: kbedford
 XREFS: S2268.dwg

VERIFY SCALES
BAR IS ONE INCH ON ORIGINAL DRAWING
0 1
IF NOT ONE INCH ON THIS SHEET,
ADJUST SCALES ACCORDINGLY


APPROVAL:	DATE:	DESIGN BY: CJM			
APPROVAL:	DATE:	DRAWN BY: DTG			
APPROVAL:	DATE:	CHECKED BY:			
	DATE:	DATE: AUGUST 2005	REV	DATE	DESCRIPTION
					APP

BOYLE ENGINEERING CORPORATION


JURUPA COMMUNITY SERVICES DISTRICT		DRAWING NO:	SHEET NO:
ION EXCHANGE WATER TREATMENT PLANT - PHASE III		DP-10	26
DRAIN/BW OUT SCHEMATIC		FILE NO:	OF 48 SHEETS
		S-2268	

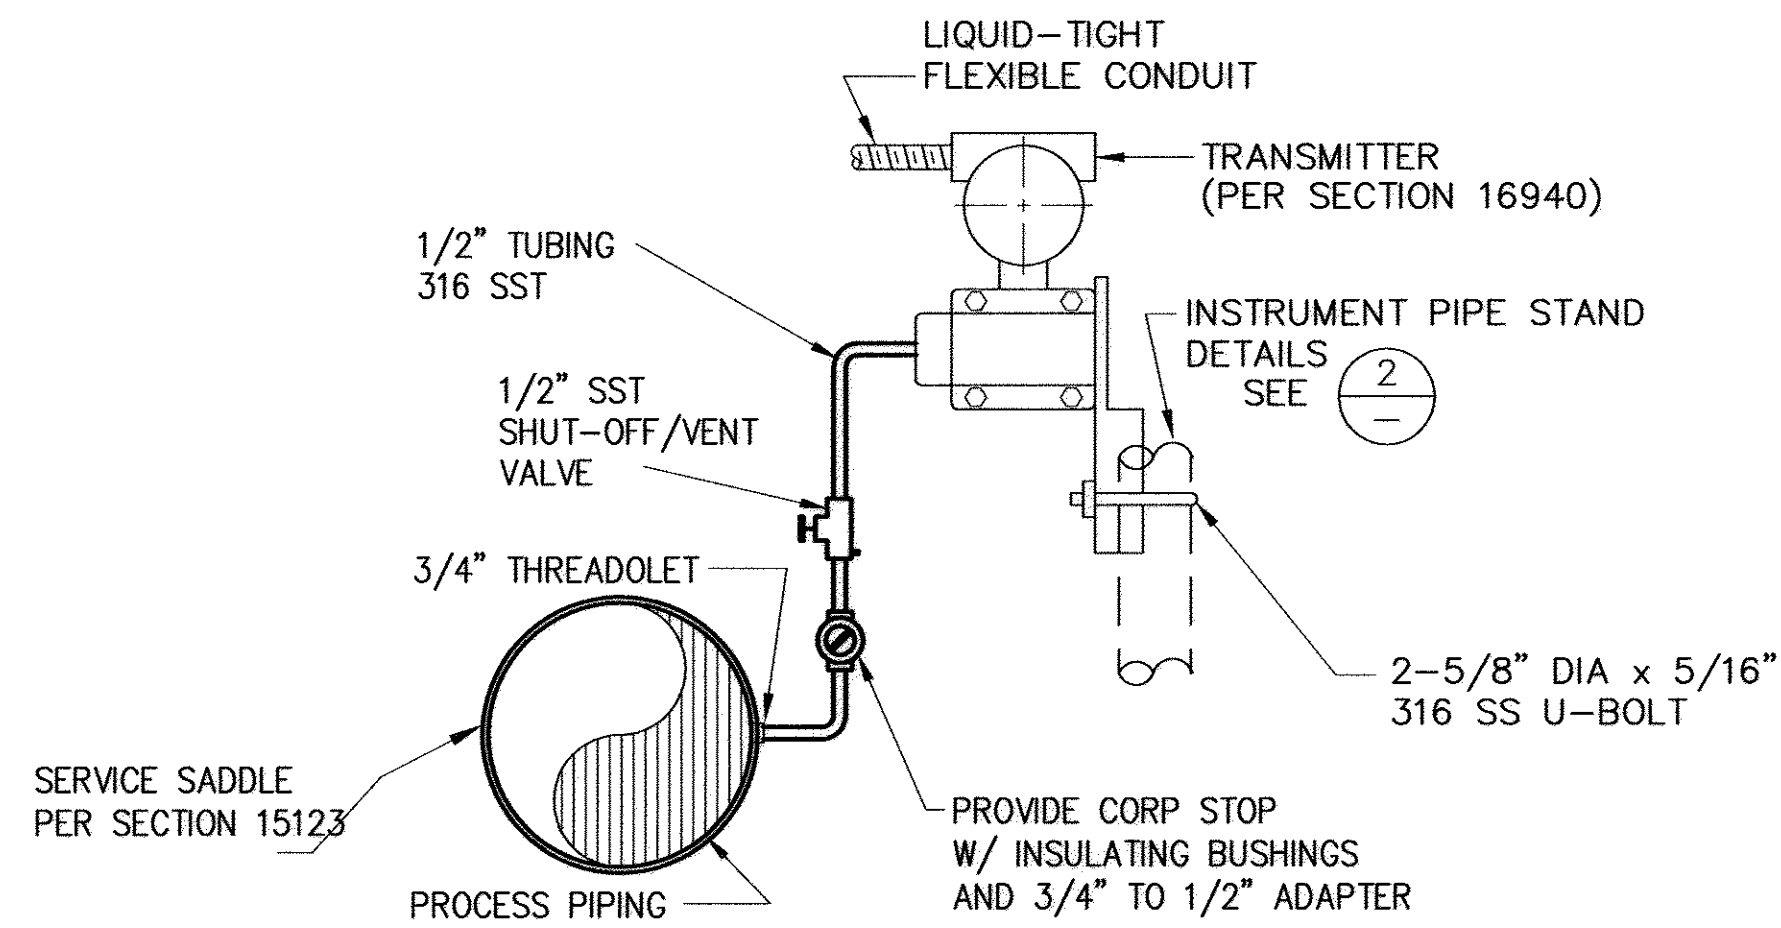


PRESSURE INDICATING TRANSMITTER (1)
NTS

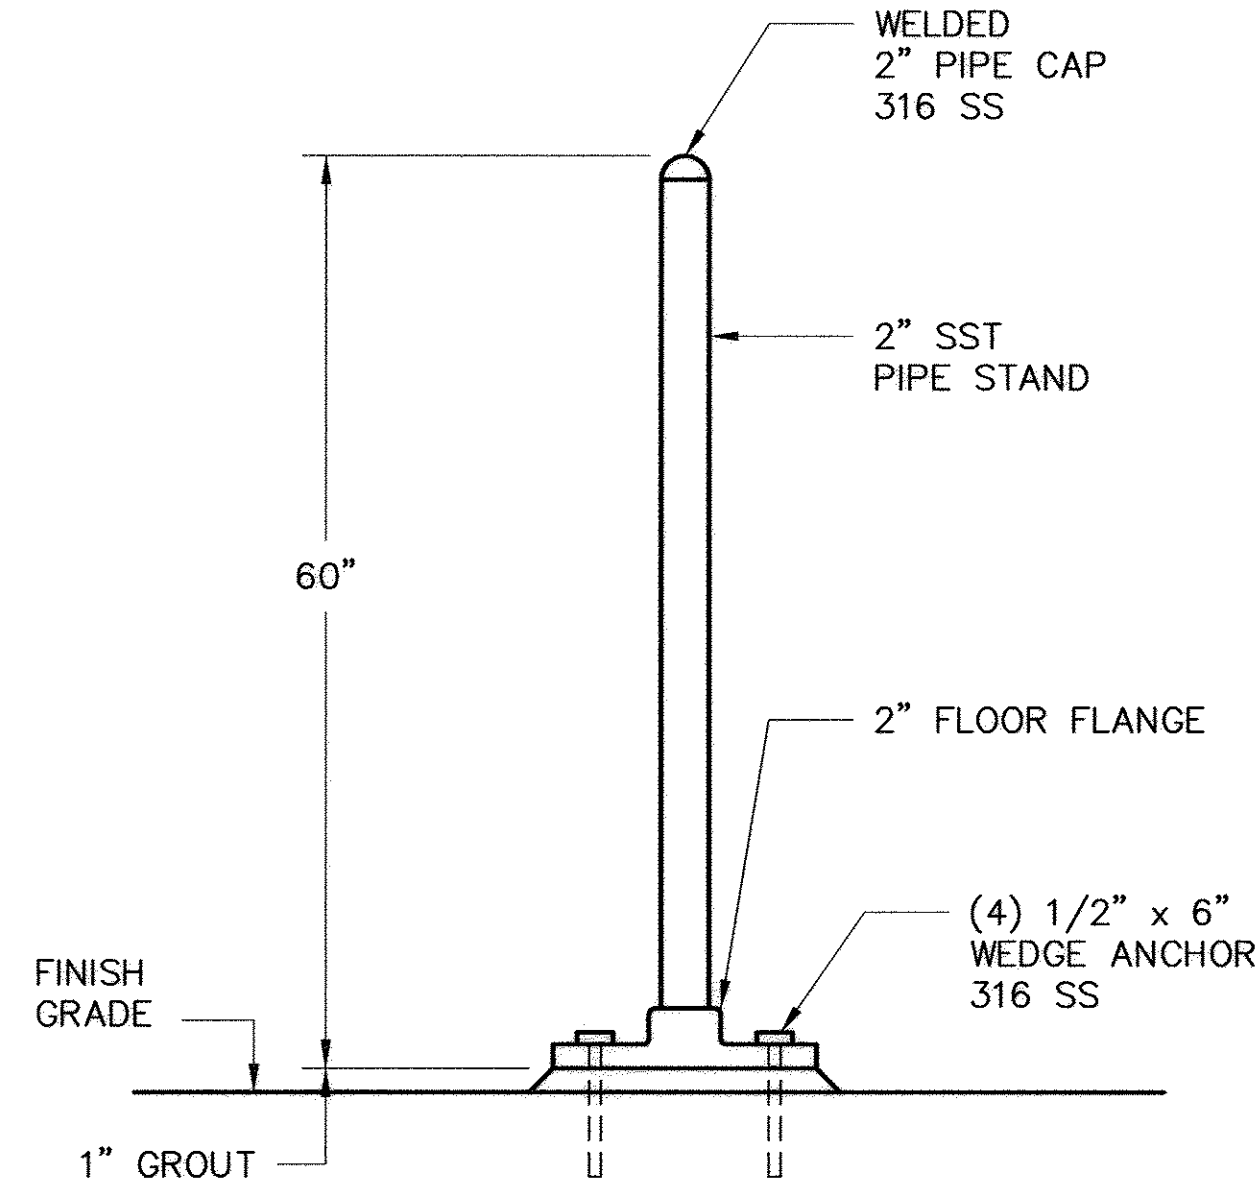

INSTRUMENT PIPE STAND (2)
NTS

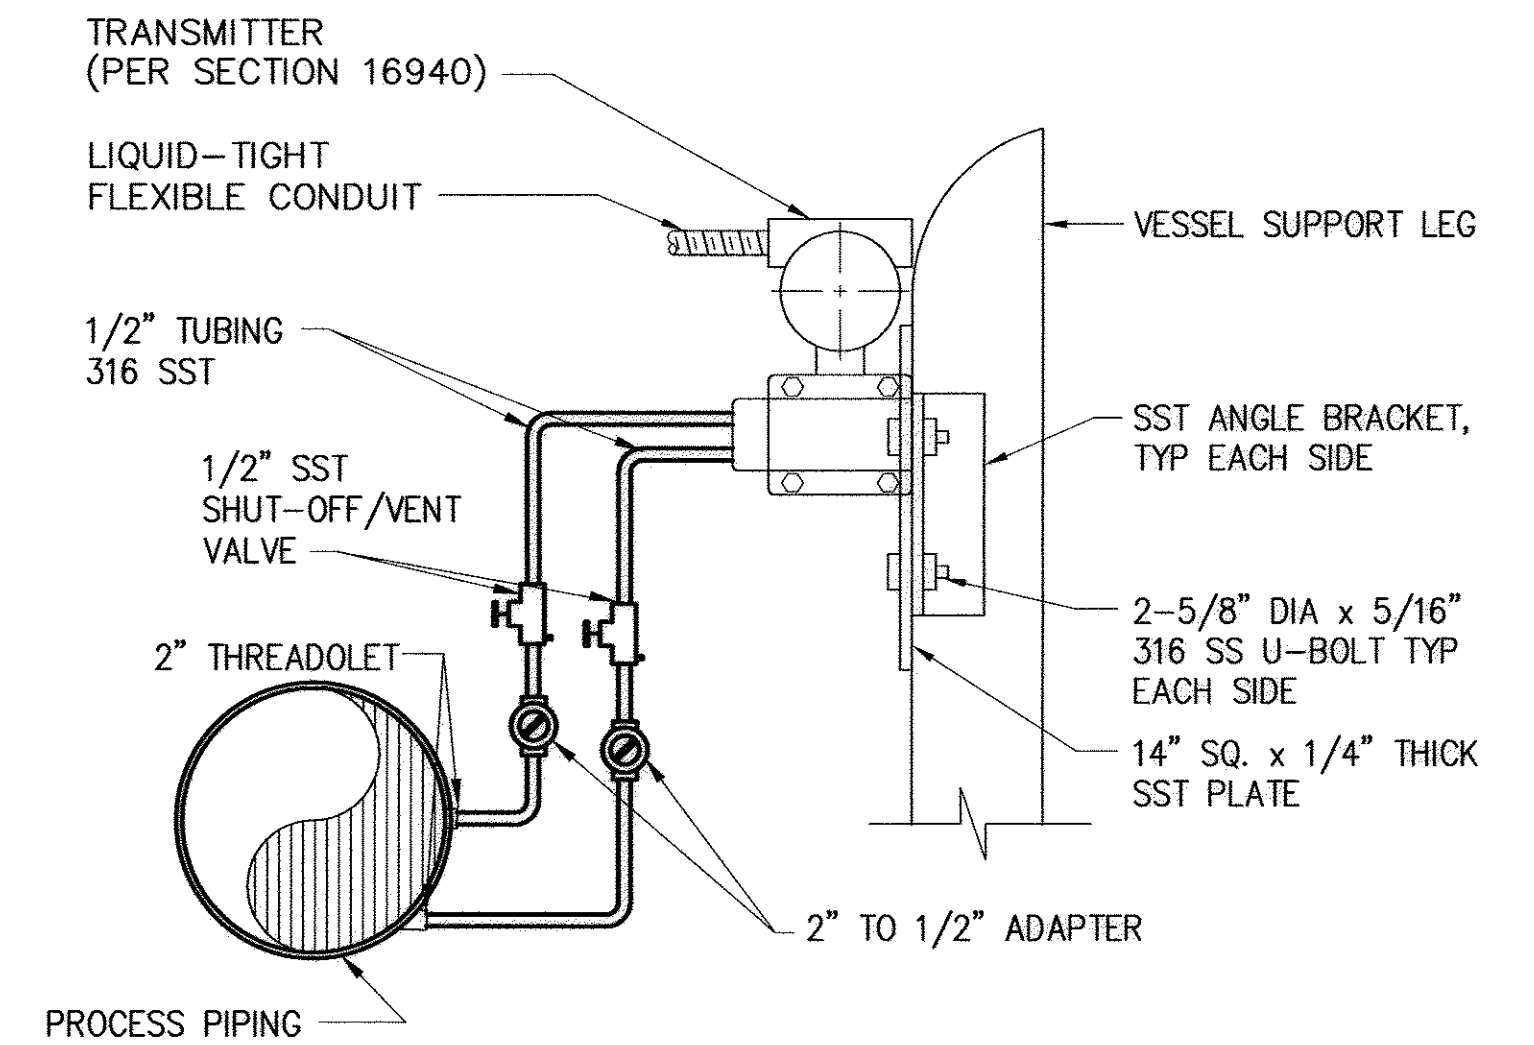

DIFFERENTIAL PRESSURE INDICATING TRANSMITTER (3)
NTS

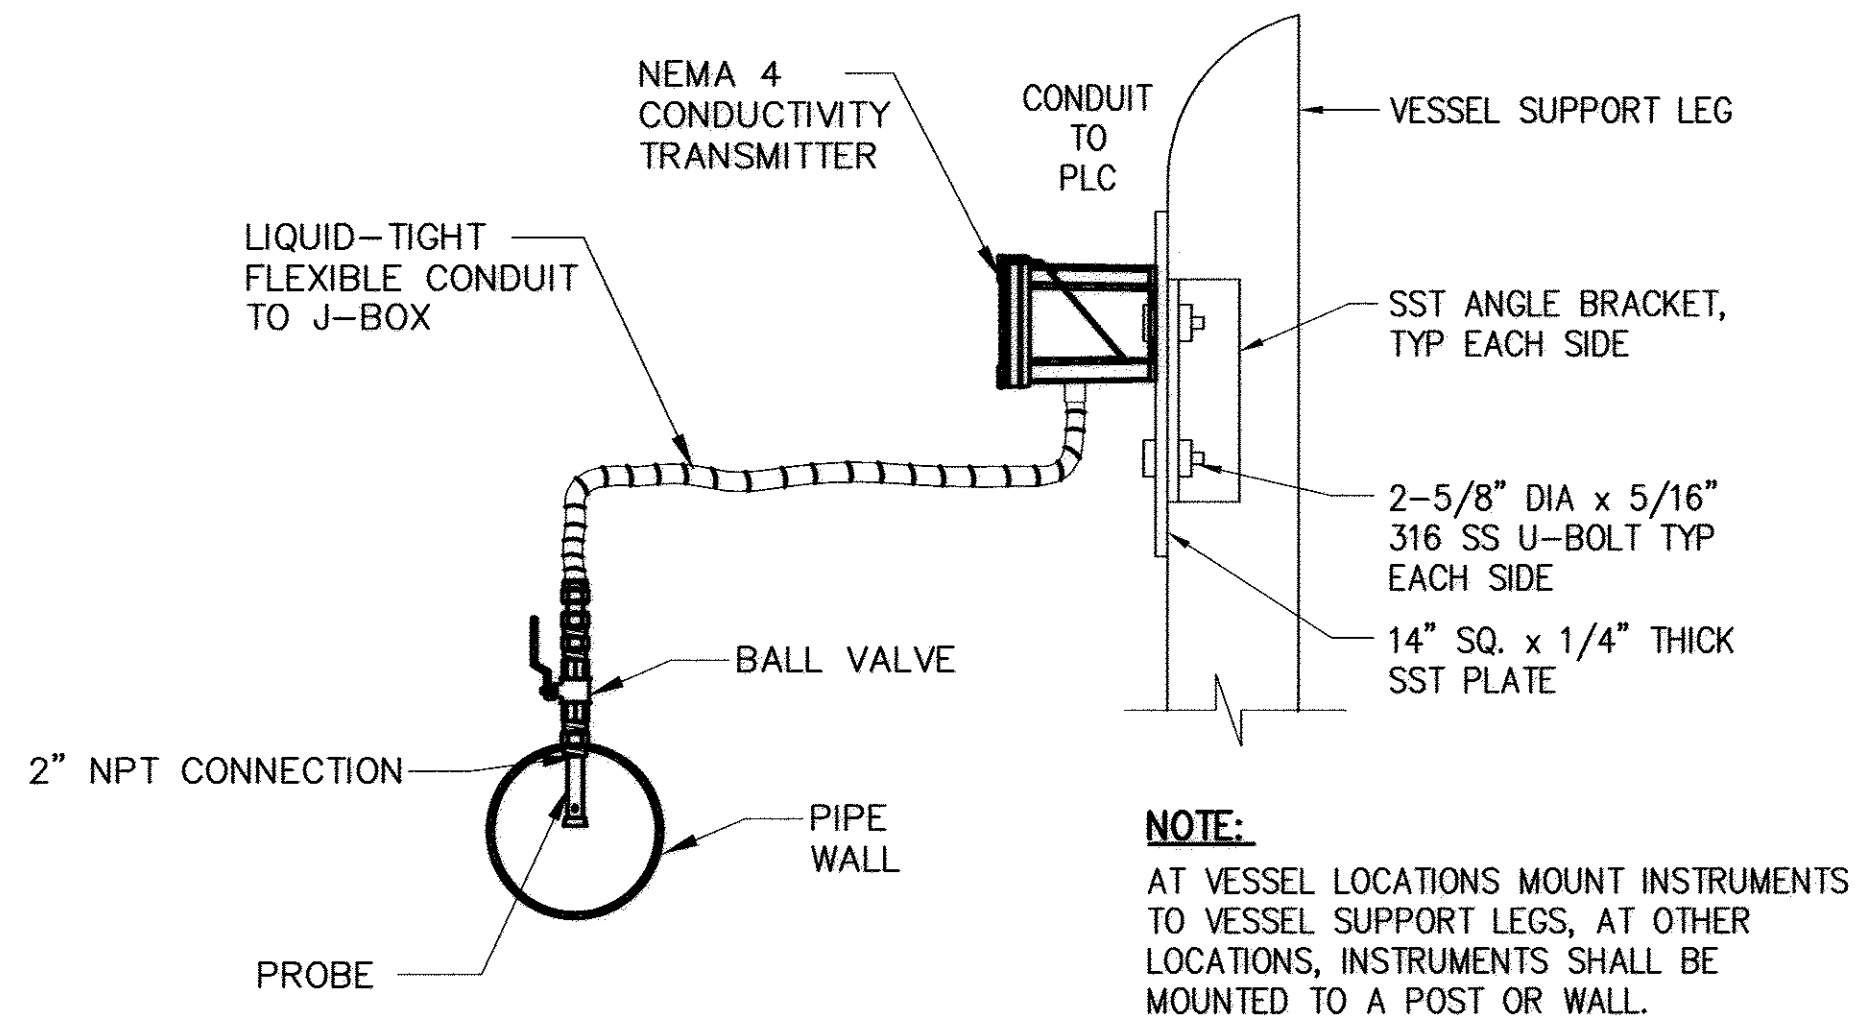

NOTE:
AT VESSEL LOCATIONS MOUNT INSTRUMENTS TO VESSEL SUPPORT LEGS, AT OTHER LOCATIONS, INSTRUMENTS SHALL BE MOUNTED TO A POST OR WALL.

CONDUCTIVITY SENSORS (4)
NTS

DWG: S:\J04\100-04-CAD (phase III)\Plans\2268-DP12.dwg
DATE: Nov 08, 2007 3:41pm
USER: kbedford
XREFS: 2268DR

VERIFY SCALES BAR IS ONE INCH ON ORIGINAL DRAWING 0 1 IF NOT ONE INCH ON THIS SHEET, ADJUST SCALES ACCORDINGLY		APPROVAL:	DATE:	DESIGN BY: CJM					
		APPROVAL:	DATE:	DRAWN BY: CDC					
		APPROVAL:	DATE:	CHECKED BY:					
			DATE:	AUGUST 2005	REV	DATE	DESCRIPTION	APP	



JURUPA COMMUNITY SERVICES DISTRICT ION EXCHANGE WATER TREATMENT PLANT - PHASE III		DRAWING NO:	SHEET NO:
INSTRUMENT MOUNTING DETAILS		DP-12	27
		FILE NO:	OF 48 SHEETS
		S-2268	

RECORD DRAWING
Date: 08-23-07
These record drawings apply only to those facilities constructed under the contract identified in the title block and have been prepared, in part, on the basis of information compiled and furnished by others. The Engineer/Architect will not be responsible for any errors or omissions which have been incorporated into this drawing as a result of the work by others.

PWS: S:\JDA\105-040 CUD (phase 1)\PWS-A ELECTRICAL\22268-ED1.dwg USER: lbedford
DATE: Nov 08, 2007 3:45pm ACCESS: EDITOR

ELECTRICAL SYMBOLS – SINGLE LINE DIAGRAM	
	POWER TRANSFORMER
	CIRCUIT BREAKER 100A=TRIP RATING IN AMPS 3P=NUMBER OF POLES
	MOTOR CIRCUIT PROTECTOR 30A=CONTINUOUS-CURRENT RATING
	FUSE
	MOTOR, 10 HORSEPOWER
	LIGHTNING ARRESTER
	GROUND
	DELTA CONNECTION
	WYE CONNECTION
	MOTOR CONTROL CENTER CUBICLE REFERENCE

ELECTRICAL SYMBOLS – PLANS	
	DUPLEX RECEPTACLE *
	JUNCTION BOX, UON
	HANDHOLE, 11"x17"x12"D, UON OR AS REQUIRED BY NEC.
	PULLBOX, 24"x36"x30"D, UON OR AS REQUIRED BY NEC.
	NON-FUSED SWITCH, 30A, 3P U.O.N.
	C SUPPORT CHANNEL

ELECTRICAL SYMBOLS – PLANS CONT.	
	CONDUIT DESIGNATION, SEE CONDUIT SCHEDULE.
	CONDUIT CONCEALED IN WALLS OR CEILINGS
	CONDUIT IN SLAB OR UNDER GROUND
	QUANTITY #12 WIRE, 2#12 IF NO SLASHES SHOWN, UON (PROVIDE ONE GROUND CONDUCTOR OF SAME SIZE, NOT SHOWN IN COUNT.)
	WIRE SIZE OTHER THAN #12 (PROVIDE ONE GROUND CONDUCTOR OF SAME SIZE, NOT SHOWN IN COUNT.)
	GROUNDING CONDUCTOR 30" BELOW GRADE
	EXOTHERMIC WELD CONNECTION
	CONDUIT BENDS TOWARD OBSERVER
	CONDUIT BENDS AWAY FROM OBSERVER
	CONDUIT STUB-OUT AND CAPPED
	FLEXIBLE CONDUIT CONNECTION
	MOTOR CONNECTION
	GROUND WELL
	PANELBOARD
	SEE NOTE INDICATED
	INDICATES HEIGHT FROM FINISHED FLOOR GRADE TO CENTERLINE OF DEVICE
	+ 12" UON
	+ 48" UON

ELECTRICAL ABBREVIATIONS			
A	AMPERES	ICP	INSTRUMENT CONTROL PANEL
AC	ALTERNATING CURRENT	JB	JUNCTION BOX
AFF	ABOVE FINISHED FLOOR	KA	KILOAMPERES
AFG	ABOVE FINISHED GRADE	KAICS	KILOAMPERES INTERRUPTING CAPACITY, SYMMETRICAL
AMPS	AMPERES	kcmil	THOUSAND CIRCULAR MILS
AWG	AMERICAN WIRE GAUGE	KVA	KILOVOLT-AMPERE
		KW	KILOWATT
BC	BARE COPPER		
C	CONDUIT	LA	LIGHTNING ARRESTER
CB	CIRCUIT BREAKER	LTC	LIGHTING
CEC	CALIFORNIA ELECTRICAL CODE	LOS	LOCKOUT STOP PUSHBUTTON
CKT	CIRCUIT	LS	LIMIT SWITCH
CO	CONDUIT ONLY		
CPT	CONTROL POWER TRANSFORMER	MA	MILLIAMPERE
CT	CURRENT TRANSFORMER	MAX	MAXIMUM
		MCC	MOTOR CONTROL CENTER
DB	DIRECT BURIED DRAWING	MH	MANHOLE
		MIN	MINIMUM
ELEV	ELEVATION	MTD	MOUNTED
ENCL	ENCLOSED	MTG	MOUNTING
ETM	ELAPSED TIME METER		
(E)	EXISTING	N	NEUTRAL
		NC	NORMALLY CLOSED
FLEX	FLEXIBLE	NEC	NATIONAL ELECTRICAL CODE
G, GND	GROUND	NO	NORMALLY OPEN
GFI	GROUND FAULT INTERRUPTER	NO.	NUMBER
		NTS	NOT TO SCALE
HH	HANDHOLE	OL'S	MOTOR OVERLOAD CONTACTS
HOA	HAND OFF AUTOMATIC		
HP	HORSEPOWER		
HZ	HERTZ		
		P	POLE
		PB	PUSHBUTTON, PULLBOX
		PH	PHASE
		POC	POINT OF CONNECTION
		PS	PRESSURE SWITCH
		PT	POTENTIAL TRANSFORMER
		PVC	POLYVINYL CHLORIDE
		REC REQ'D	RECEPTACLE REQUIRED
		SHT	SHEET
		STD	STANDARD
		SW	SWITCH
		TB	TERMINAL BOARD
		TEMP	TEMPERATURE
		TSP	TWISTED SHIELDED PAIR
		TST	TWISTED SHIELDED TRIAD
		TYP	TYPICAL
		UG	UNDERGROUND
		UGPS	UNDERGROUND PULL SECTION
		UON	UNLESS OTHERWISE NOTED
		V	VOLT
		W	WATT, WIRE
		WP	WEATHERPROOF
		XFMR	TRANSFORMER
		ø	PHASE

ELECTRICAL SYMBOLS – SCHEMATIC DIAGRAMS		
NORMALLY OPEN	NORMALLY CLOSED	DEVICE
		CONTACT
		TIMED CONTACT CONTACT ACTION RETARDED ON ENERGIZATION
		PUSH BUTTON SINGLE CIRCUIT MOMENTARY CONTACT
		LIMIT SWITCH
		PRESSURE OR VACUUM SWITCH
		SELECTOR SWITCH
		MOTOR OVERLOAD HEATER CONTACTS
		MOTOR OVERLOAD HEATER
		PILOT LIGHT R=RED, W=WHITE, G=GREEN, A=AMBER
		PILOT LIGHT, PUSH TO TEST R=RED, W=WHITE, G=GREEN, A=AMBER
		RELAY
		TIME DELAY RELAY
		STARTER COIL
		ELAPSED TIME METER
		FUSE
		CONTROL POWER TRANSFORMER
		GROUND
		WIRING IN MOTOR STARTER
		FIELD WIRING
		WIRE TERMINAL IN MOTOR STARTER
		PHASE MONITORING RELAY

CONDUIT FILL TABLE					
MAXIMUM NUMBER OF CONDUCTORS IN TRADE SIZES OF CONDUIT OR TUBING					
CONDUCTOR SIZE (AWG)	CONDUIT TRADE SIZE (INCHES)				
	3/4	1	1 1/4	1 1/2	2
14	15	24	42	60	99
12	12	16	32	42	78
10	8	12	24	32	56
8	4	6	12	16	24
6	–	4	7	10	16
4	–	3	5	7	12

RECORD DRAWING
Date: 08-23-07
These record drawings apply only to those facilities constructed under the contract identified in the title block and have been prepared, in part, on the basis of information compiled and furnished by others. The Engineer/Architect will not be responsible for any errors or omissions which have been incorporated into this drawing as a result of the work by others.

VERIFY SCALES
BAR IS ONE INCH ON ORIGINAL DRAWING
0 1
IF NOT ONE INCH ON THIS SHEET,
ADJUST SCALES ACCORDINGLY

APPROVAL:	DATE:
APPROVAL:	DATE:
APPROVAL:	DATE:


DESIGN BY: CU/JL	DATE:
DRAWN BY: RH	DATE:
CHECKED BY: PT	DATE:
DATE: 09/30/2005	

REV	DATE	DESCRIPTION	APP



JURUPA COMMUNITY SERVICES DISTRICT
JURUPA ION EXCHANGE TREATMENT PLANT – PHASE III
ELECTRICAL SYMBOLS AND ABBREVIATIONS

DRAWING NO:	SHEET NO:
E-1	28
FILE NO:	OF 48 SHEETS
	S-2268

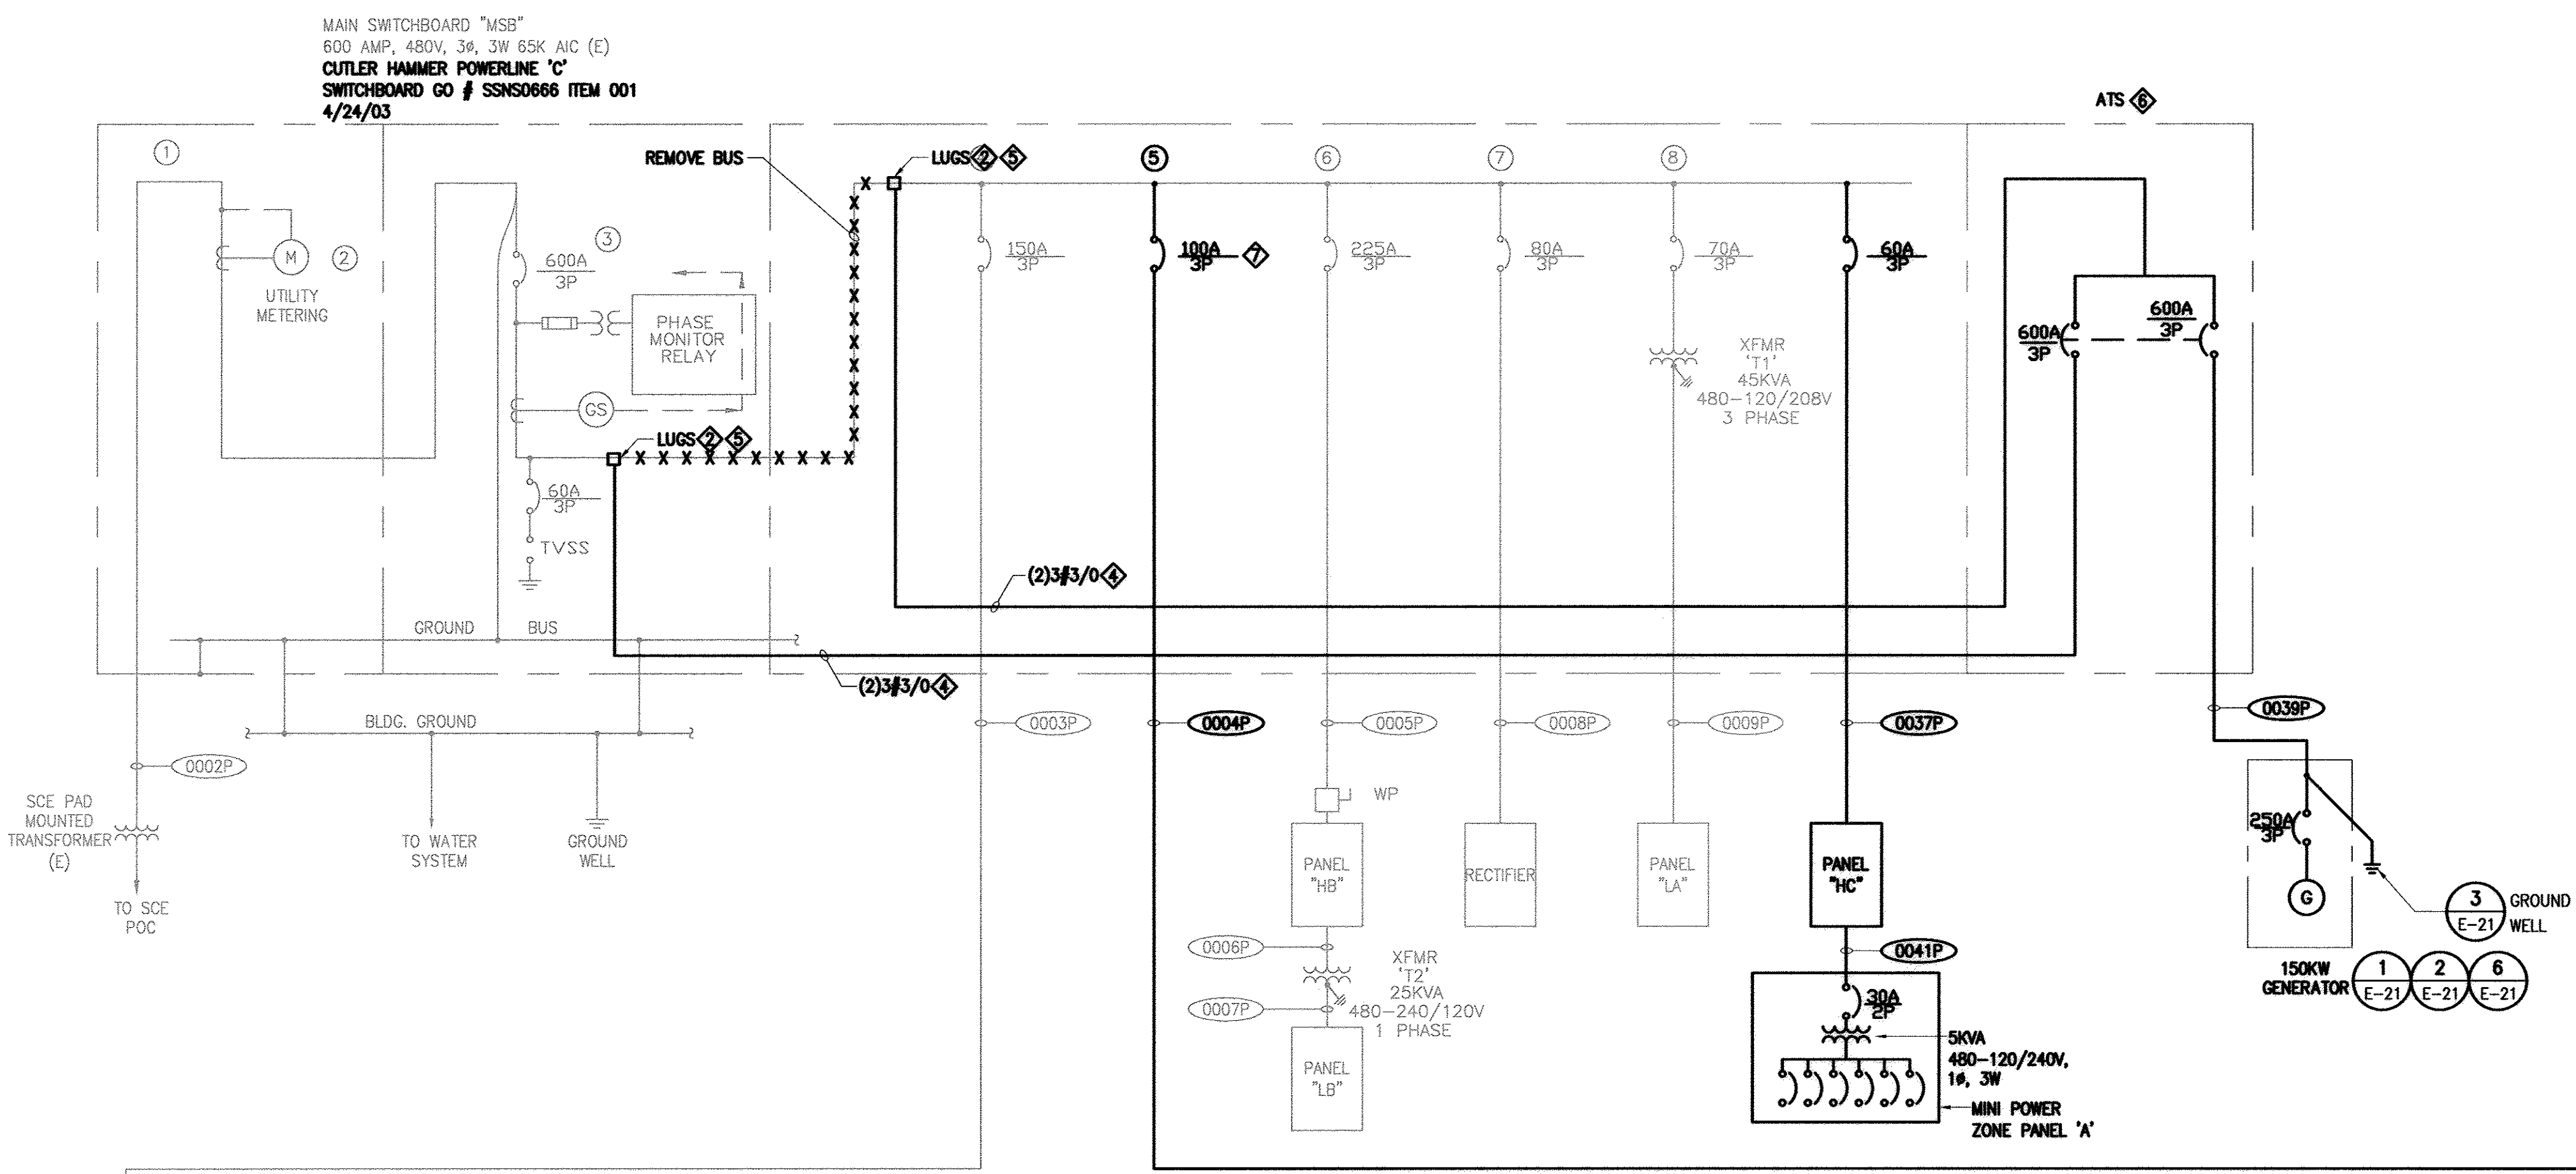



LOAD SUMMARY "MSB" (E)					
LOAD	VOLTS	PHASE	CONNECTED		
			HP	KVA	AMPS
MCC-1	460	3	.	99.2	
MCC-2	460	3	.	59.4	
PANEL "HB"	460	3	.	139.2	
RECTIFIER	460	3	.	44	
XFMR "T1"	460	3	.	45	
PANEL "HC"	460	3	.	18	
TOTAL	460	3	.	405	487

LOAD SUMMARY "MCC-2" (E)					
LOAD	VOLTS	PHASE	CONNECTED		
			HP	KVA	AMPS
60BL-A	460	3	10	11.2	
60BL-B	460	3	10	11.2	
60BL-C	460	3	.	.	
PANEL "B"			.	37	
TOTAL	460	3	.	59.4	71

* ONLY TWO BLOWERS CAN OPERATE SIMULTANEOUSLY. THE THIRD BLOWER IS STANDBY ONLY.

LOAD SUMMARY "MCC-1" (E)					
LOAD	VOLTS	PHASE	CONNECTED		
			HP	KVA	AMPS
PANEL "HA"	460	3	.	16	
40P-A	460	3	5	6.1	
40P-B	460	3	5	6.1	
40P-C	460	3	5	6.1	
40P-D	460	3	5	6.1	
50P-A	460	3	5	6.1	
50P-B	460	3	5	6.1	
50P-C	460	3	5	6.1	
50P-D	460	3	5	6.1	
80P-A	460	3	7 1/2	8.8	
80P-B	460	3	7 1/2	8.8	
100P-A	460	3	15	16.8	
TOTAL	460	3	.	99.2	125

- NUMBER NOTES
- TRANSFER SWITCH SHALL BE CIRCUIT-BREAKER TYPE AND SERVICE ENTRANCE RATED. LABEL "SERVICE DISCONNECT".
 - VERIFY PAD SIZE REQUIREMENTS WITH EQUIPMENT MANUFACTURER.
 - RUN CABLES WITHIN THE MOTOR CONTROL CENTER AND MAIN SWITCHBOARD.
 - THE REMOVAL OF THE EXISTING BUS AND INSTALLATION OF LUGS SHALL BE DONE BY AN INSTALLER THAT IS APPROVED BY THE SWITCHGEAR MANUFACTURER.
 - MOUNT ATS WITHIN EXISTING NEMA 3R ENCLOSURE.
 - REPLACE EXISTING BREAKER WITH NEW.
- GENERAL NOTES
- LIGHT LINEWORK (—) DENOTES EXISTING EQUIPMENT
 - HEAVY LINEWORK (—) DENOTES NEW EQUIPMENT

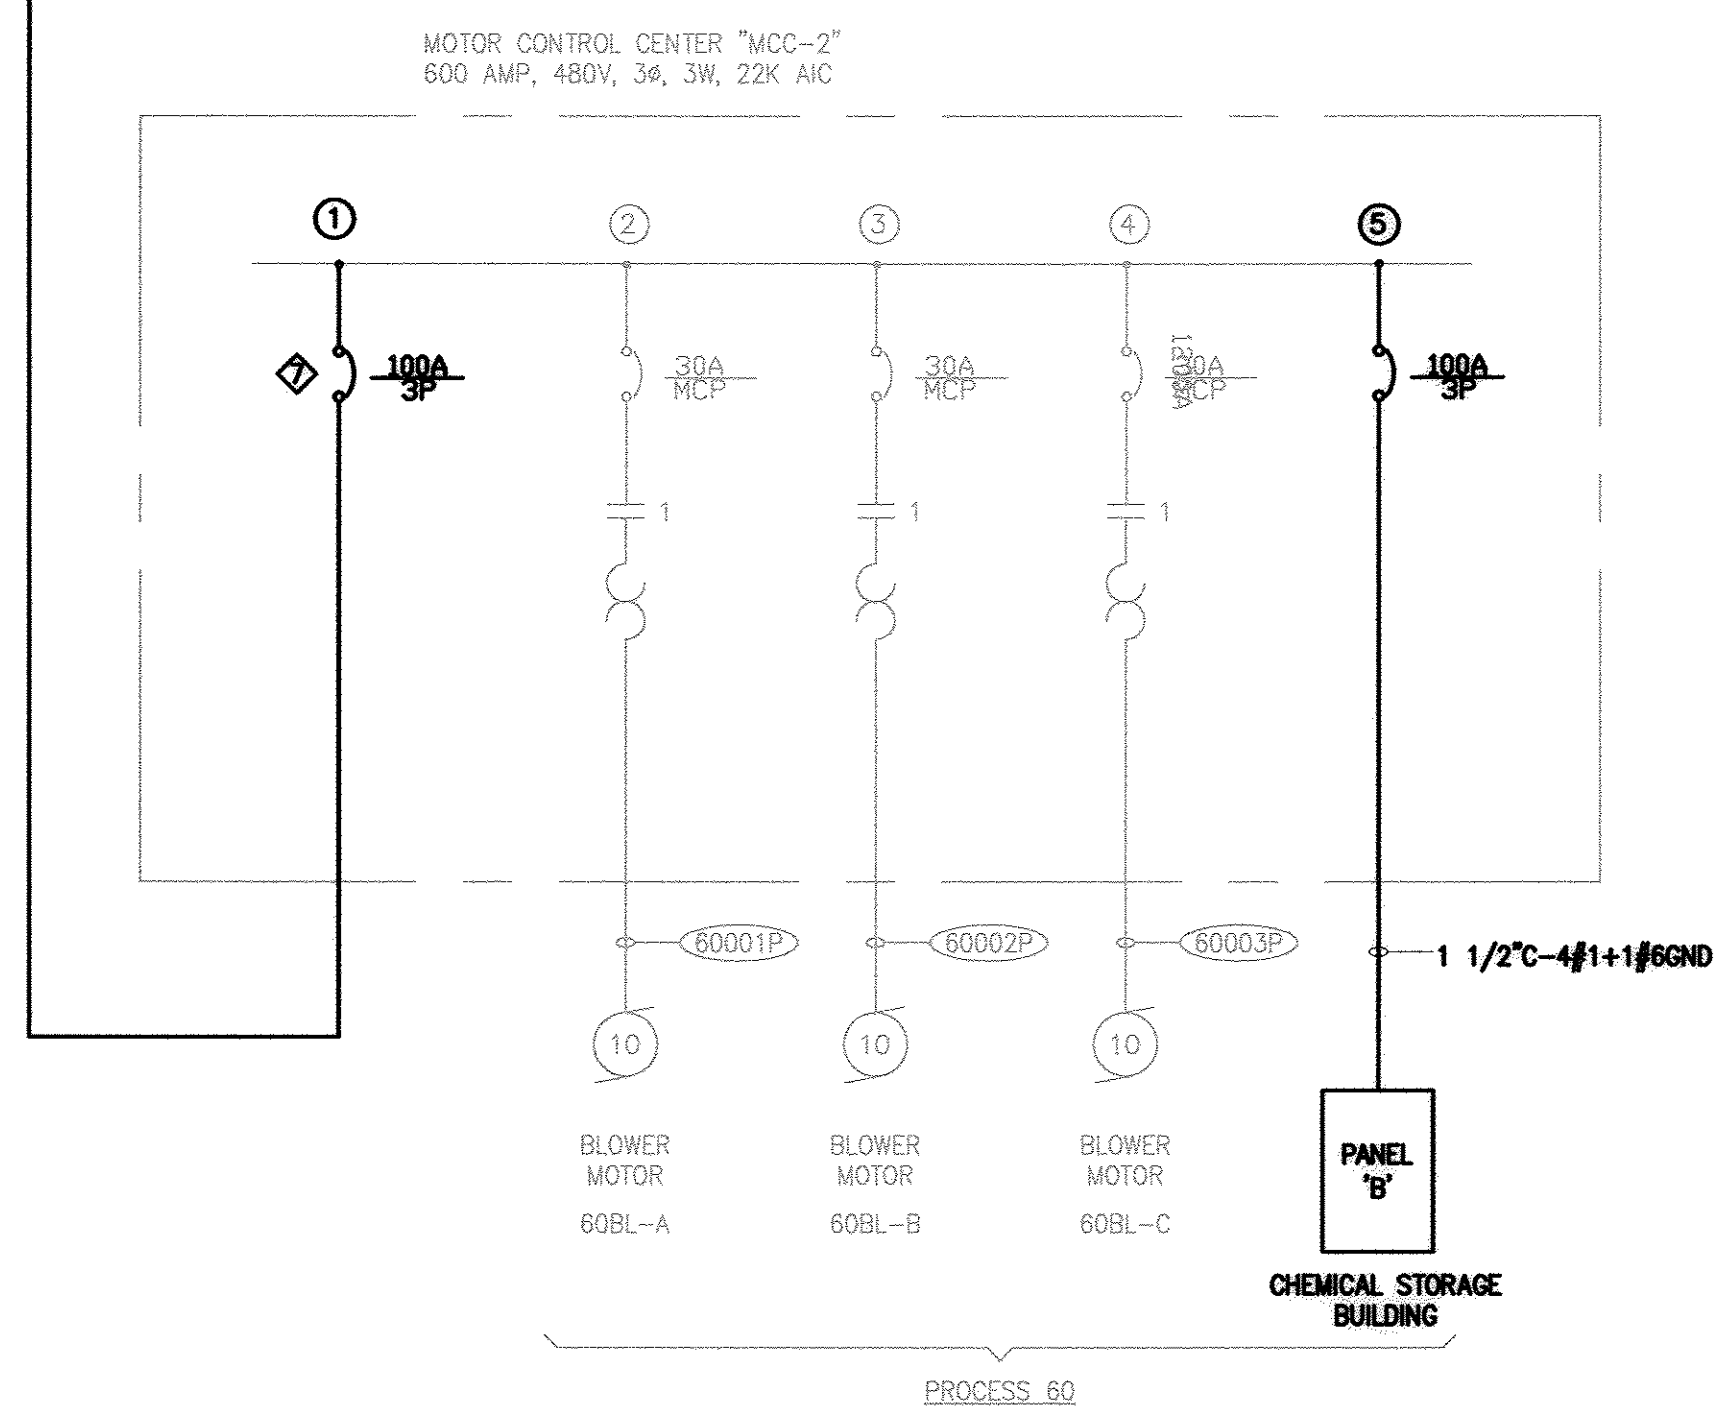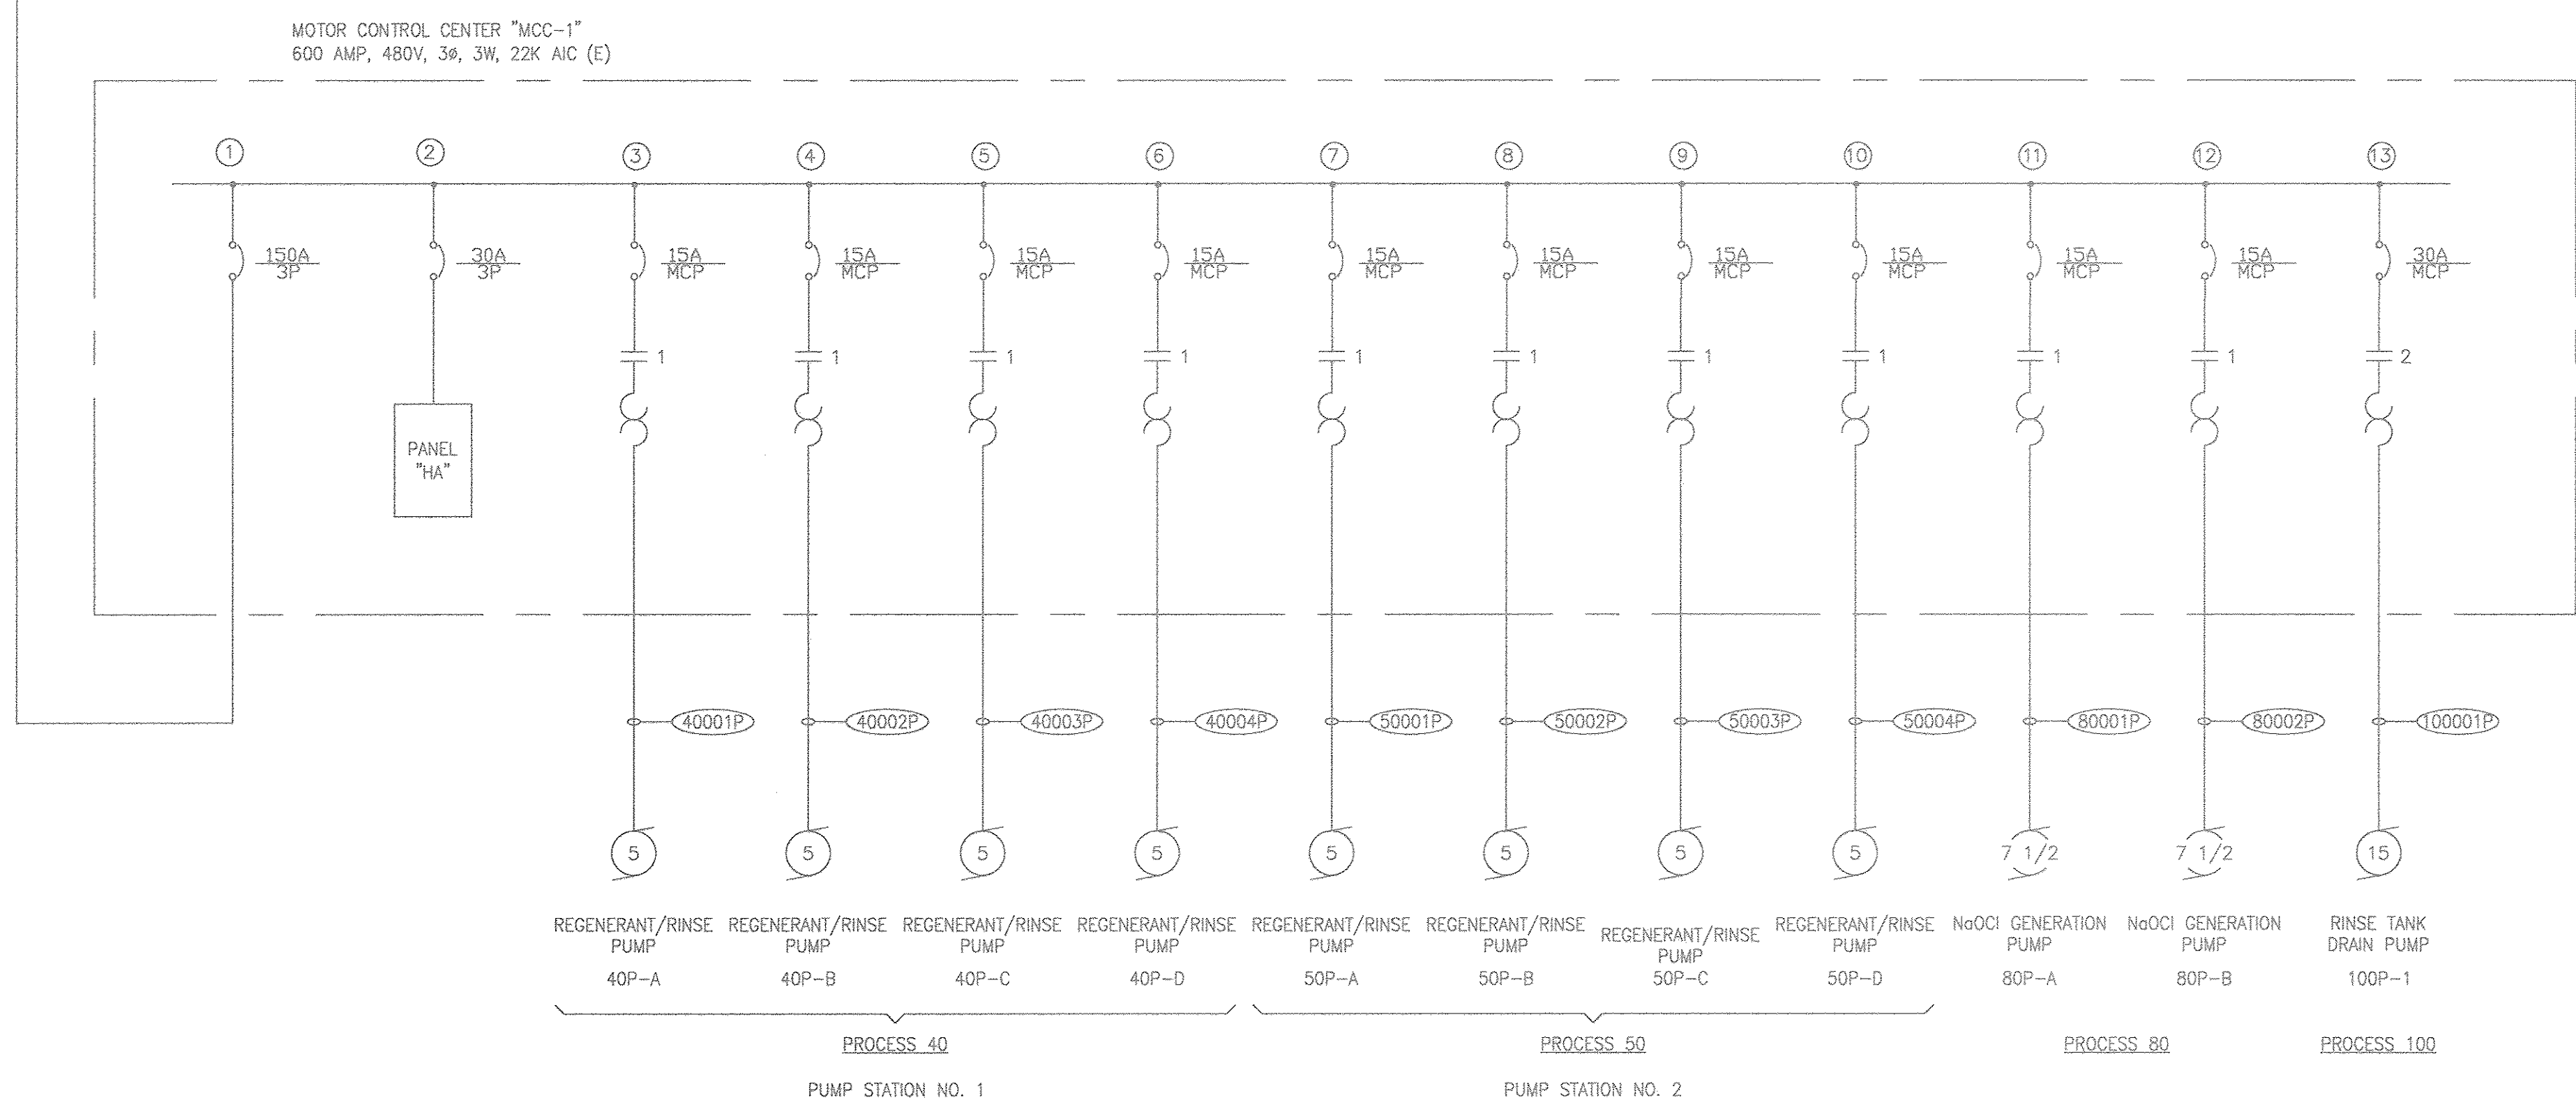

SINGLE LINE DIAGRAM
N.T.S.

PWS: S:\JWA\105-00 C&D (phase III)\JURUPA\ELECTRICAL\22265-E02.dwg
DATE: NOV 08, 2007 3:46pm
USER: bectford
PAGES: 000001

VERIFY SCALES
BAR IS ONE INCH ON ORIGINAL DRAWING
0 1
IF NOT ONE INCH ON THIS SHEET,
ADJUST SCALES ACCORDINGLY

APPROVAL:	DATE:	DESIGN BY:	CU/JL
APPROVAL:	DATE:	DRAWN BY:	RH
APPROVAL:	DATE:	CHECKED BY:	PT
APPROVAL:	DATE:	DATE:	09/30/2005
REV	DATE	DESCRIPTION	APP


BOYLE ENGINEERING CORPORATION

JURUPA COMMUNITY SERVICES DISTRICT
JURUPA ION EXCHANGE TREATMENT PLANT - PHASE III

RECORD DRAWING
Date: 08-23-07


These record drawings apply only to those facilities constructed under the contract identified in the title block and have been prepared, in part, on the basis of information compiled and furnished by others. The Engineer/Architect will not be responsible for any errors or omissions which have been incorporated into this drawing as a result of the work by others.

DRAWING NO: E-2
SHEET NO: 29
FILE NO: S-2268

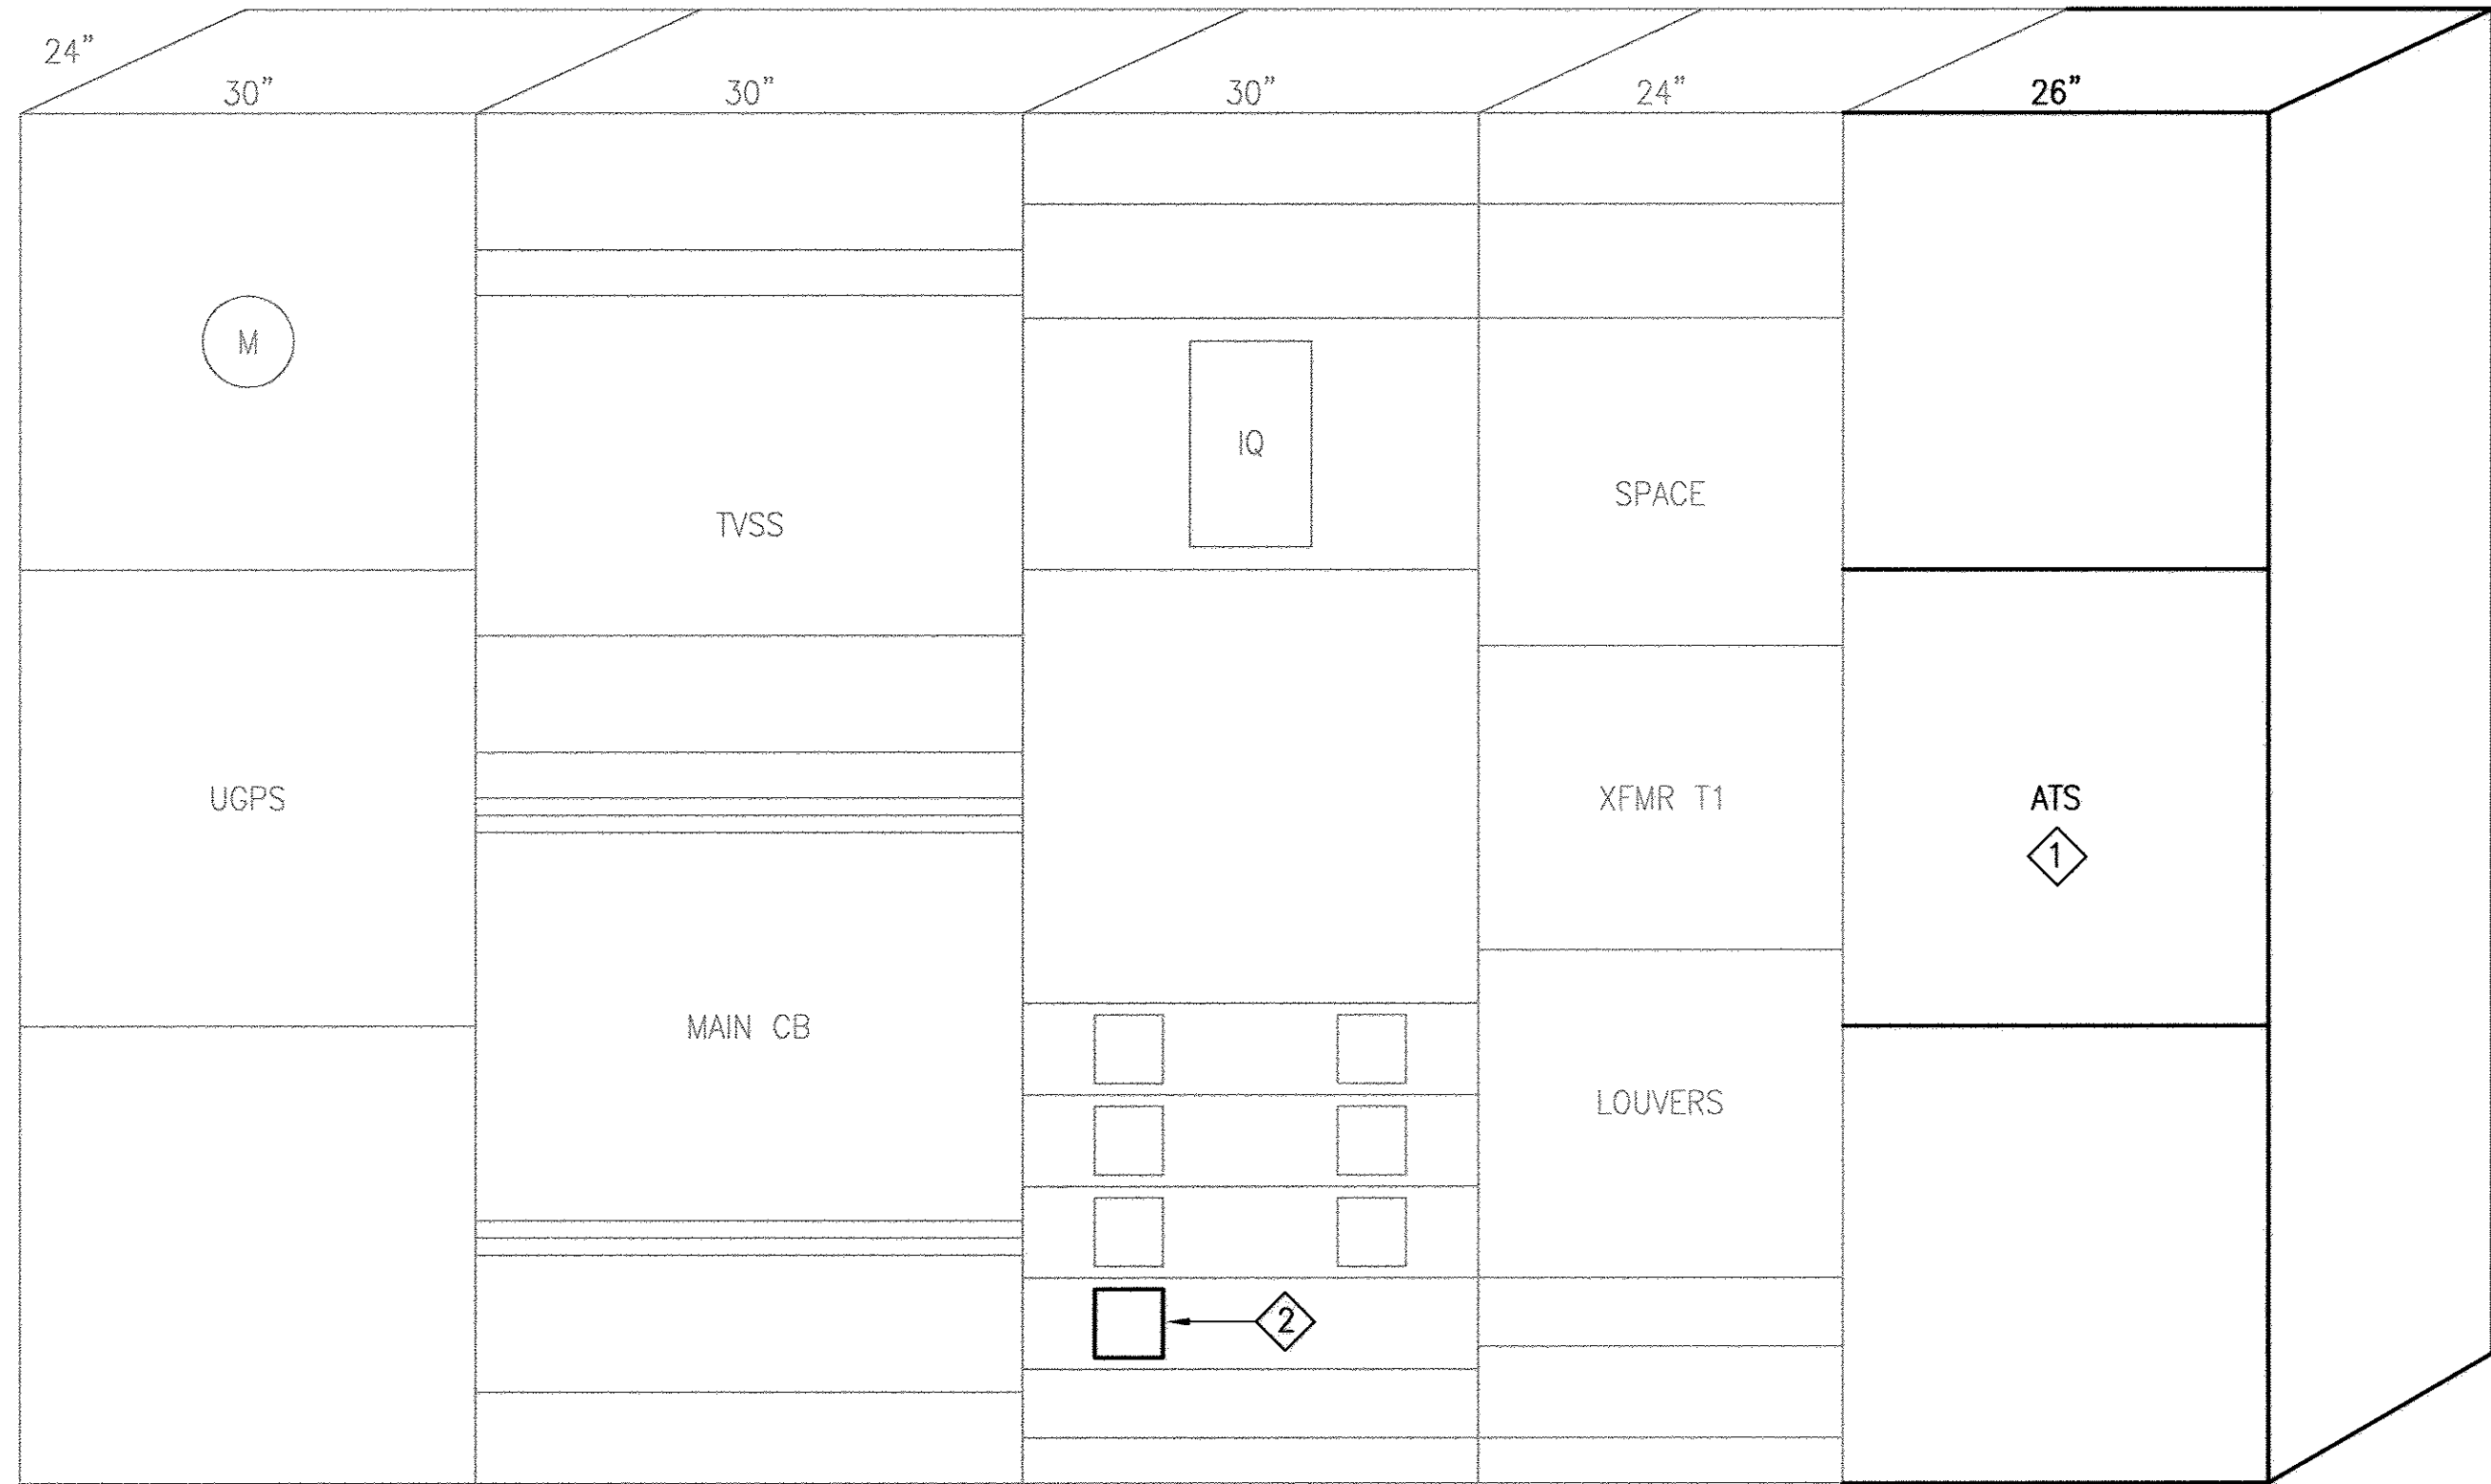


MAIN SWITCHBOARD
"MSB" ELEVATION (E)
N.T.S.

1
-

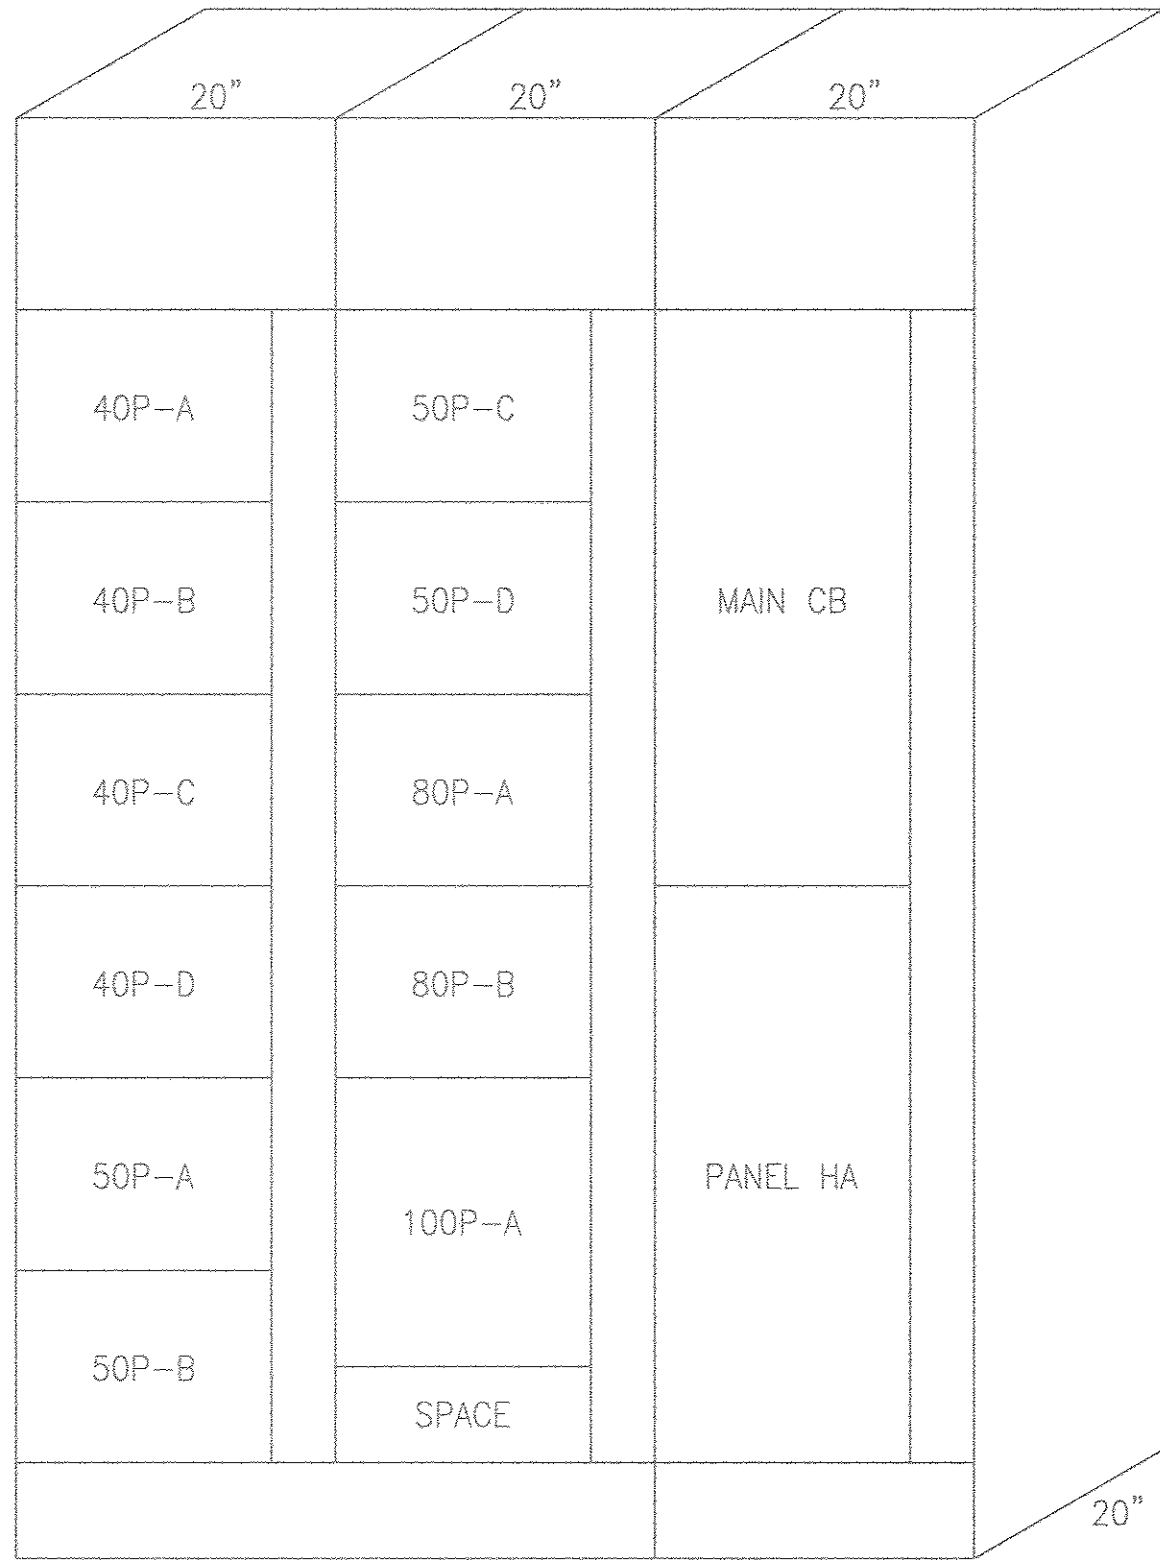

MOTOR CONTROL CENTER
"MCC-1" ELEVATION (E)
N.T.S.


2
-

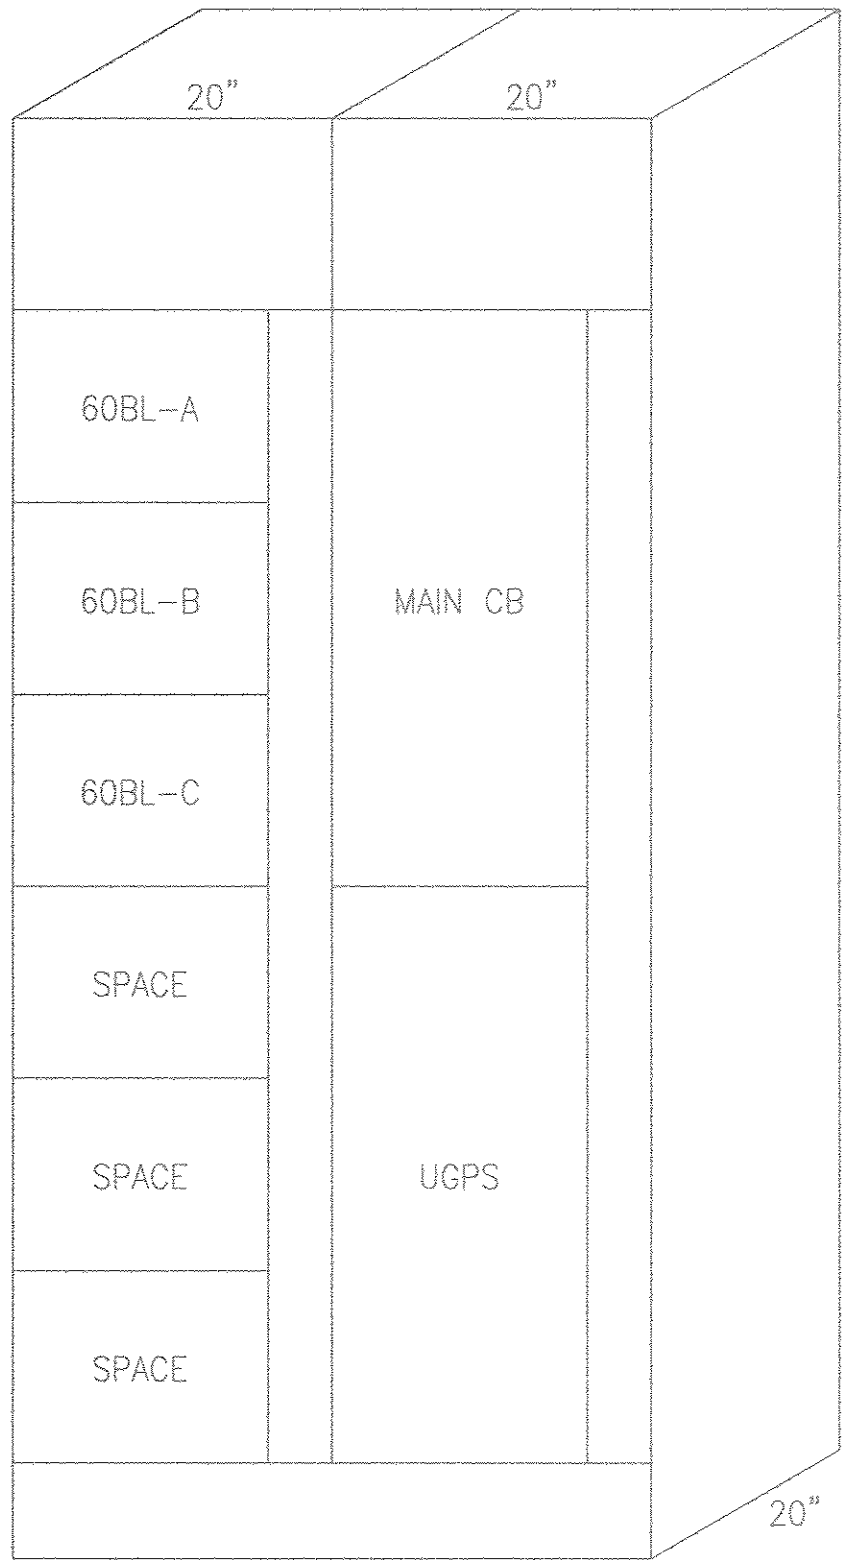

MOTOR CONTROL CENTER
"MCC-2" ELEVATION (E)
N.T.S.


3
-

- NOTES:
- 1 MOUNT ATS IN EXISTING NEMA 3R ENCLOSURE.
 - 2 CIRCUIT BREAKER FOR PANEL 'HC'
- GENERAL NOTES
- 1. LIGHT LINEWORK (——) DENOTES EXISTING EQUIPMENT
 - 2. HEAVY LINEWORK (——) DENOTES NEW EQUIPMENT

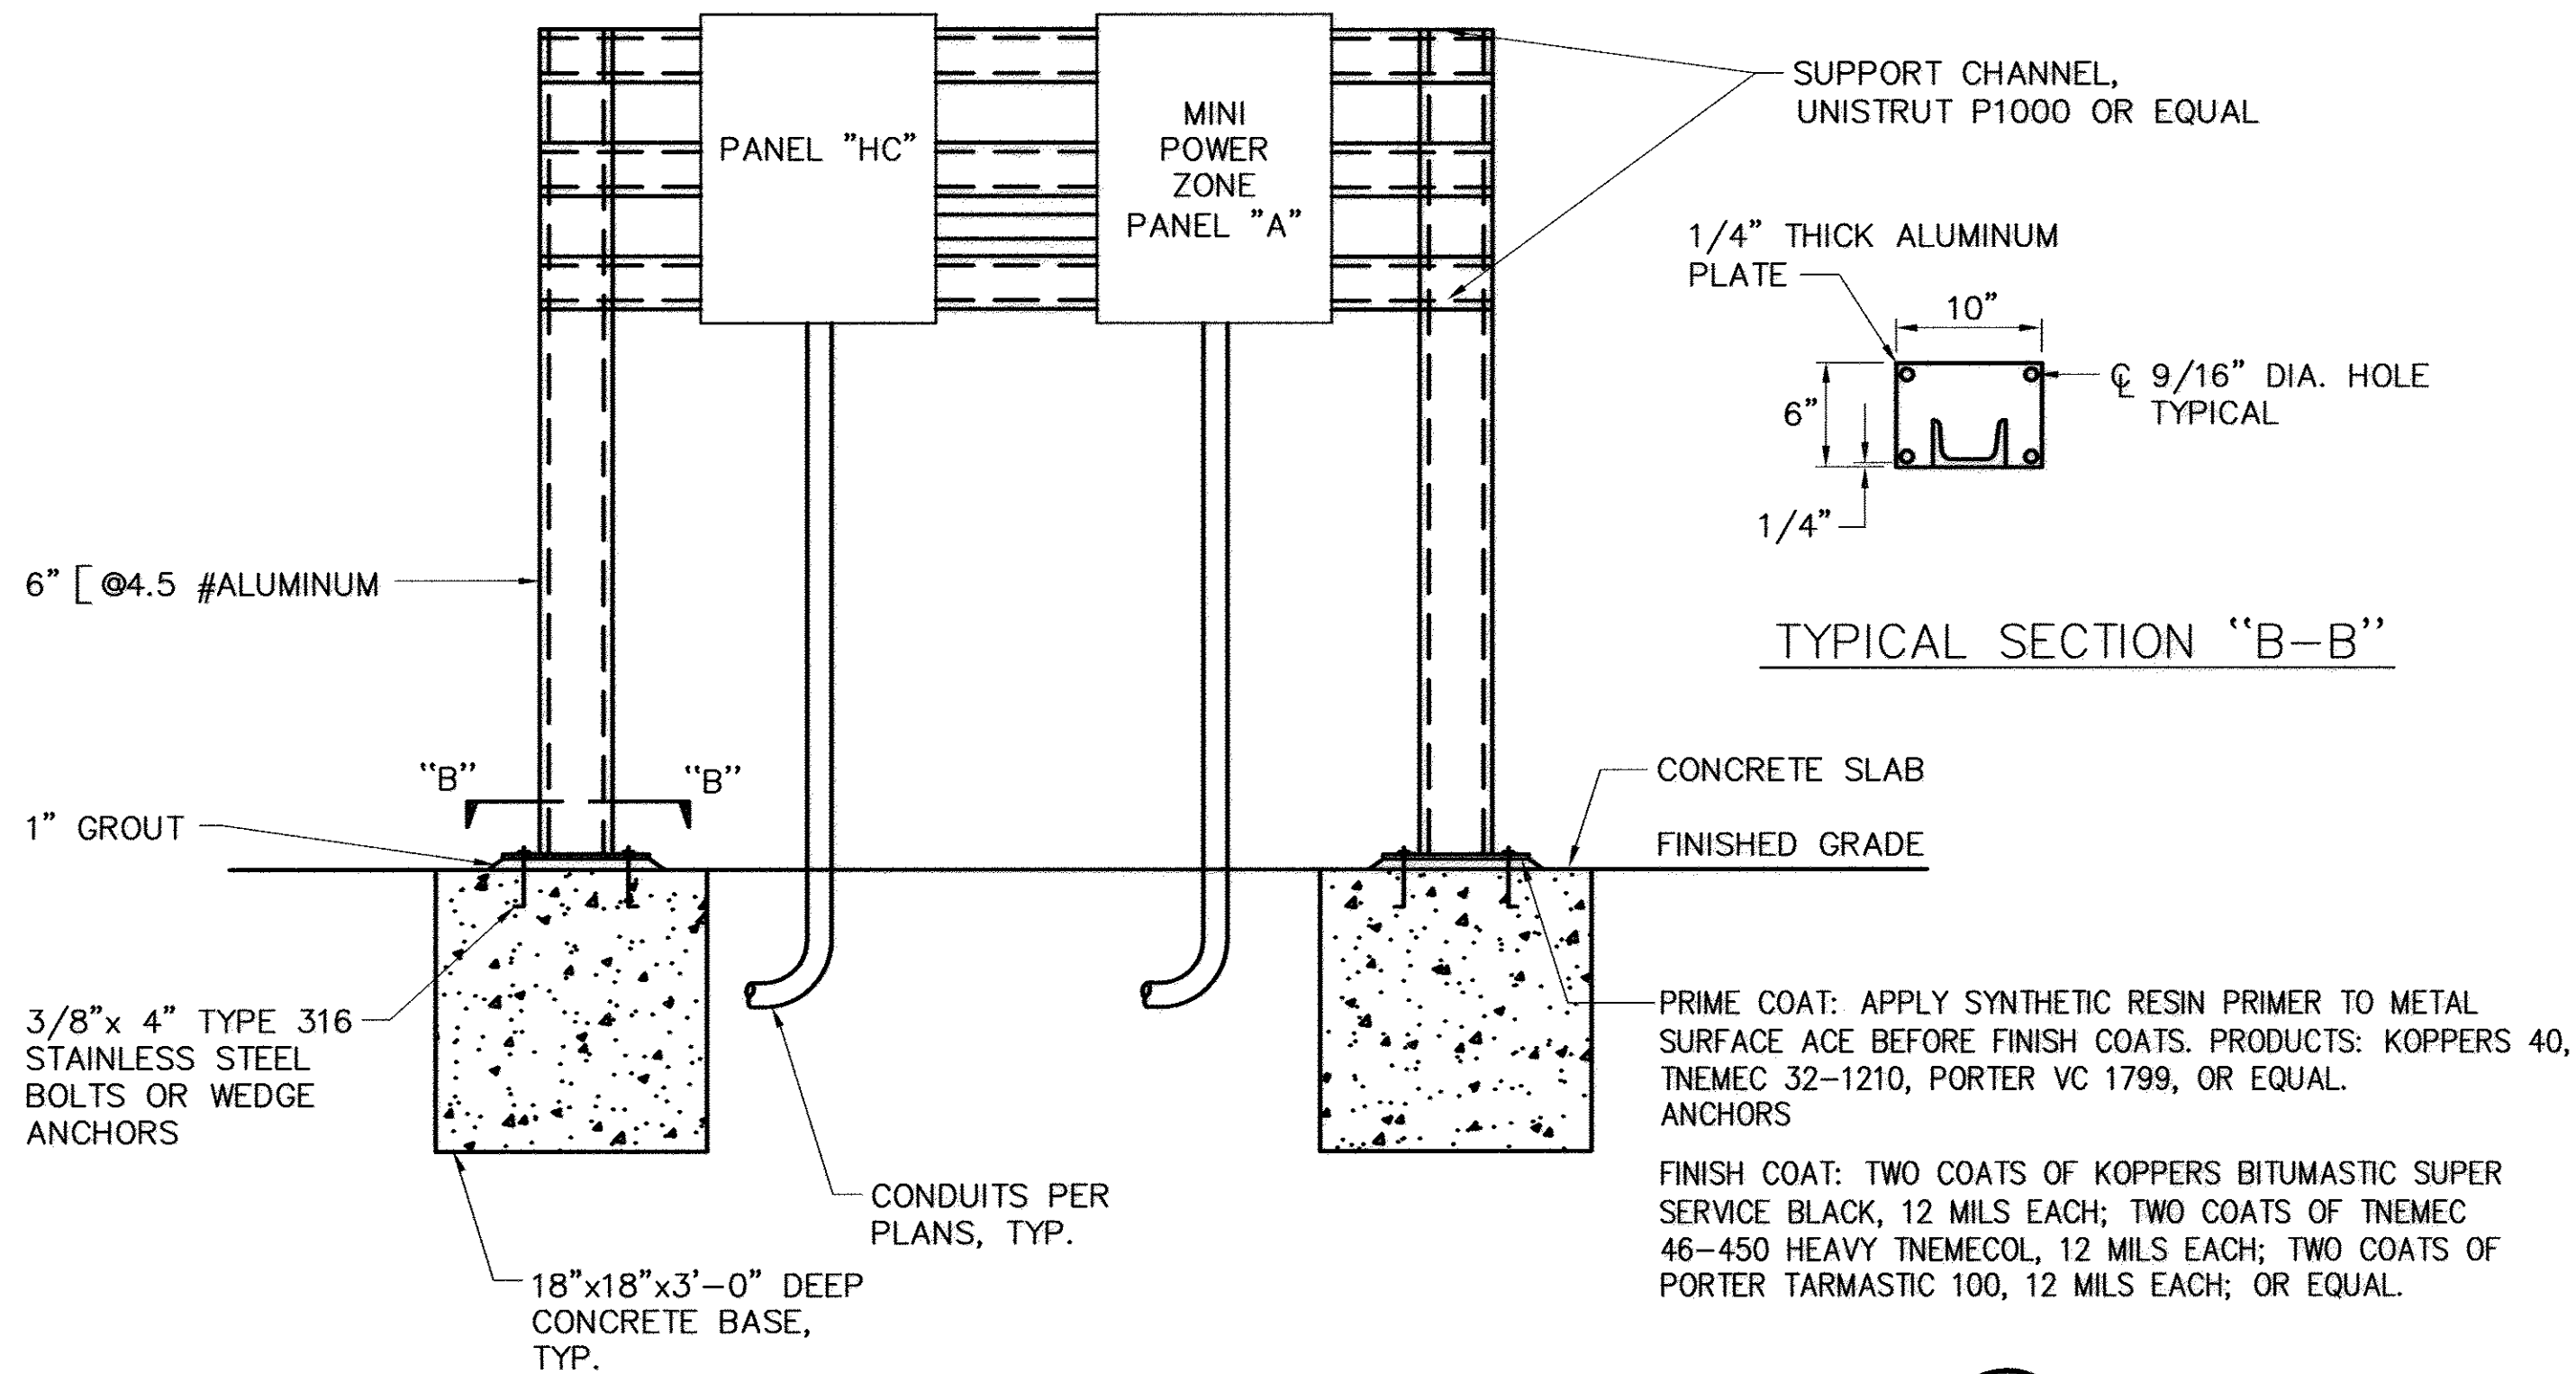

PANELBOARDS MOUNTING DETAIL
SCALE: NONE

5
-

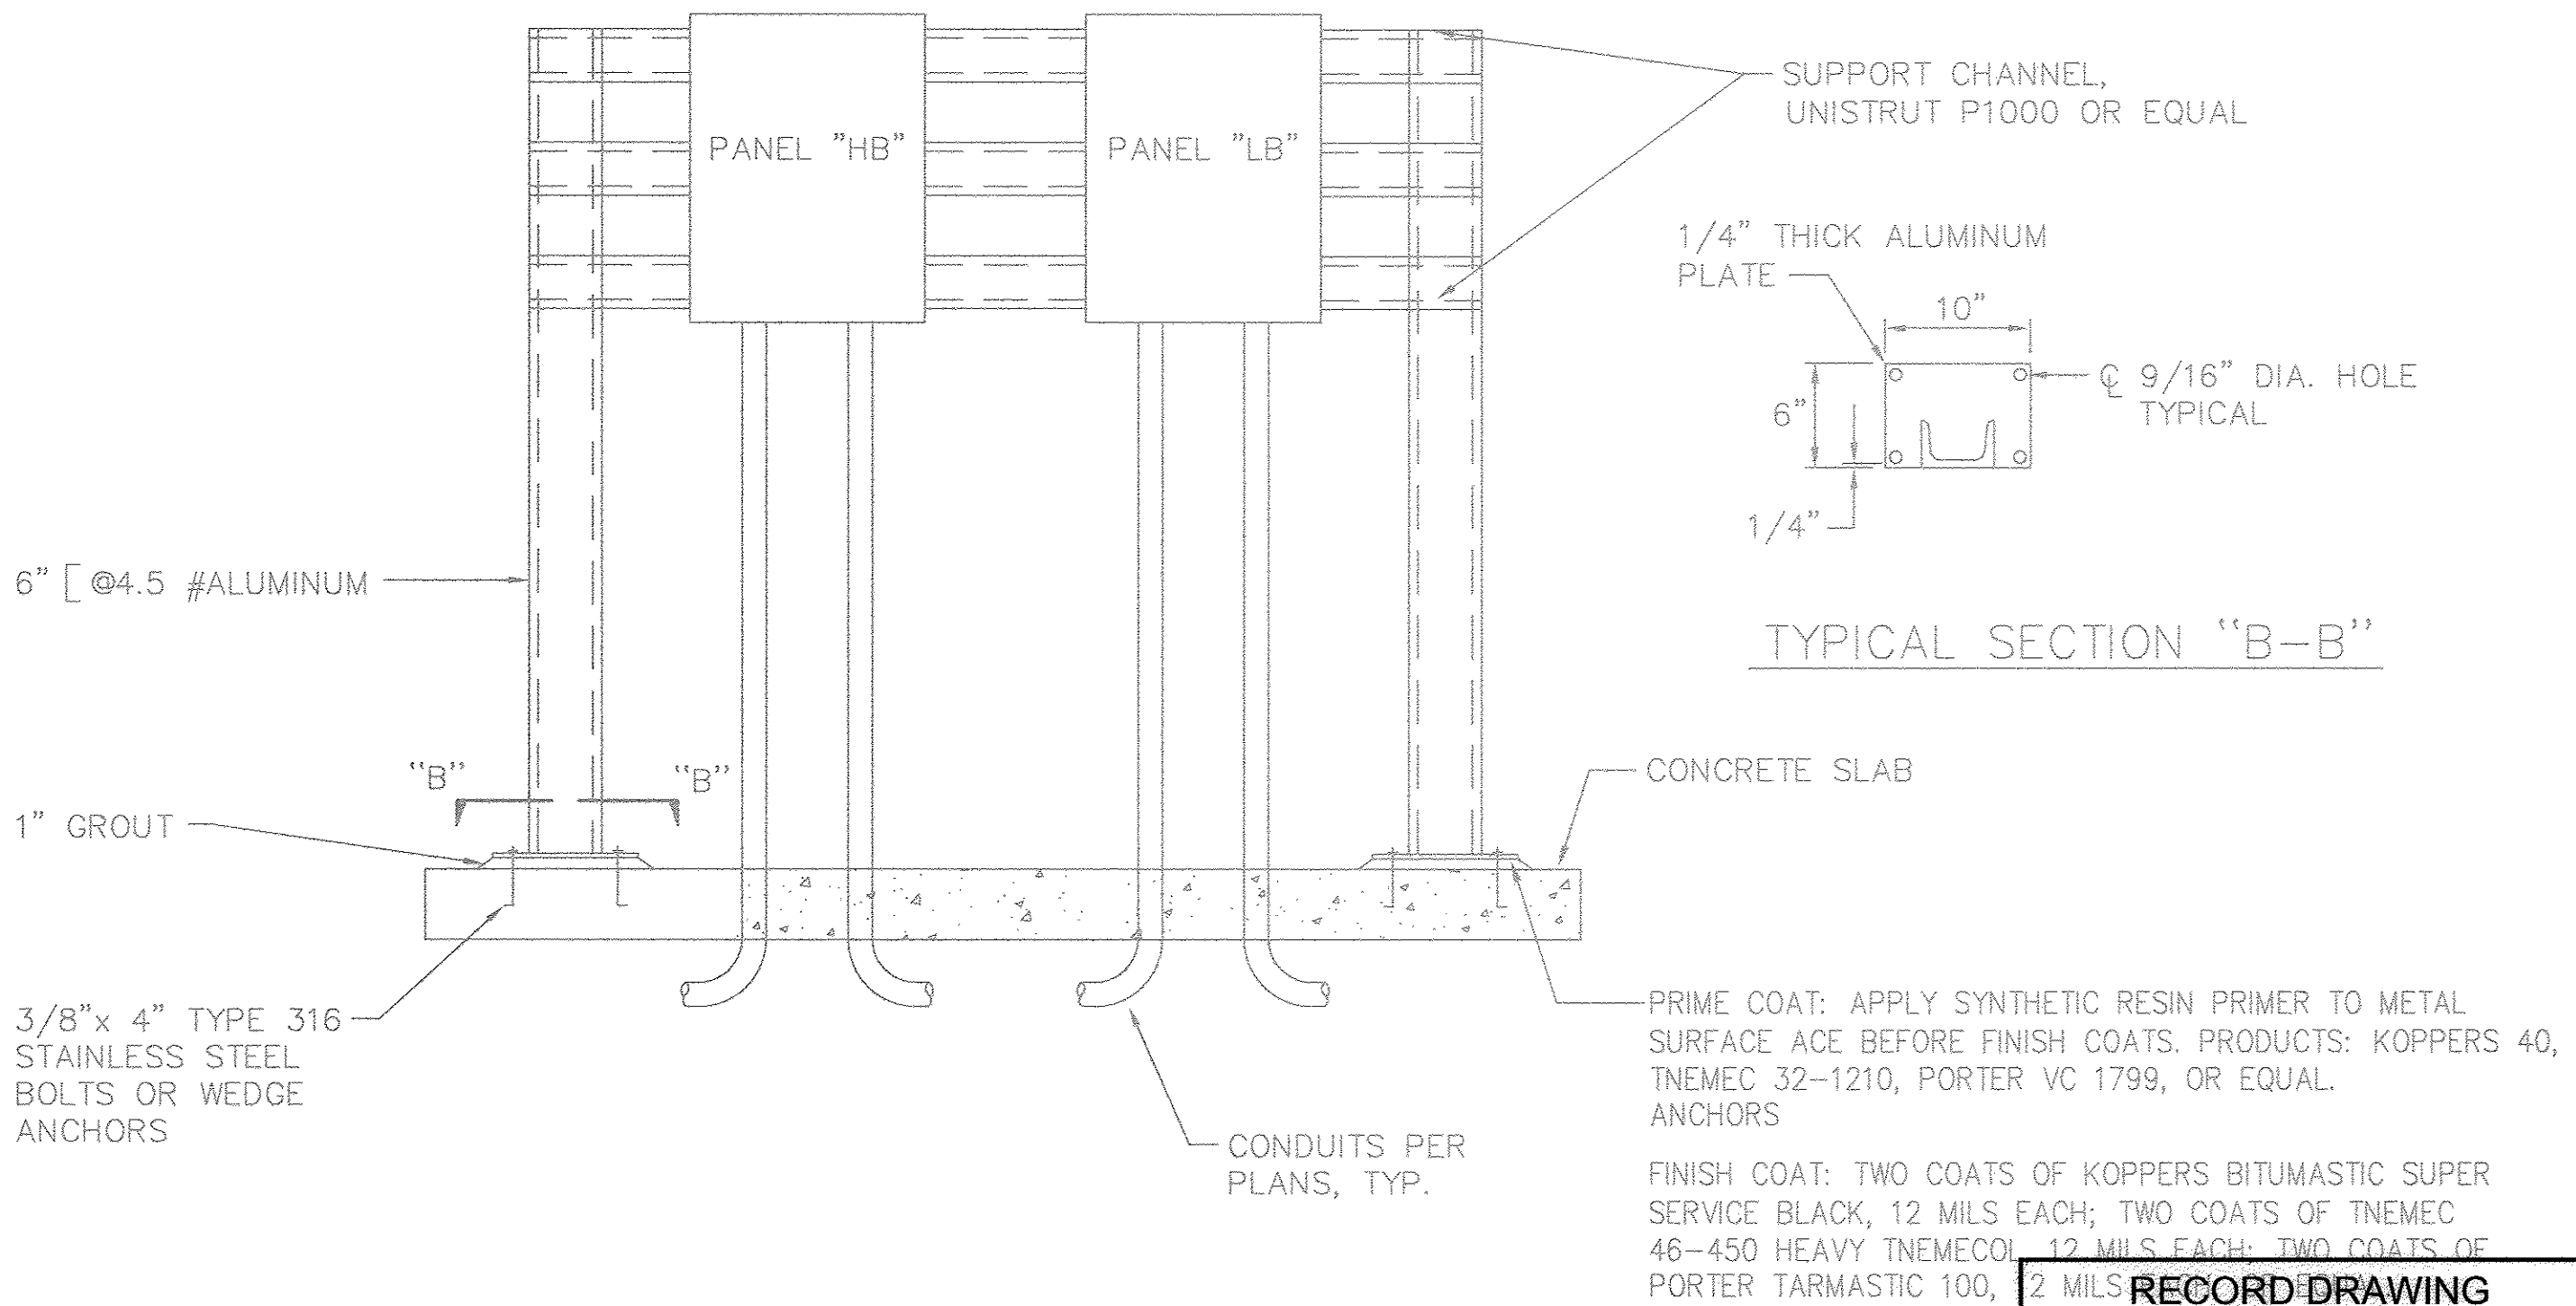

PANELBOARDS MOUNTING DETAIL
SCALE: NONE

RECORD DRAWING
Date: 08-23-07
These record drawings apply only to those facilities constructed under the contract identified in the title block and have been prepared, in part, on the basis of information compiled and furnished by others. The Engineer/Architect will not be responsible for any errors or omissions which have been incorporated into this drawing as a result of the work by others.

DWG: S:\JDA\100-04-CAD (phase III)\JURUPA\ELECTRICAL\S2268-E03.dwg
DATE: Nov 08, 2007 3:46pm
USER: baeferd
XREFS: BORDER

VERIFY SCALES
BAR IS ONE INCH ON ORIGINAL DRAWING
0 1
IF NOT ONE INCH ON THIS SHEET,
ADJUST SCALES ACCORDINGLY

APPROVAL:
APPROVAL:
APPROVAL:

DATE:
DATE:
DATE:

DESIGN BY: CU/JL
DRAWN BY: RH
CHECKED BY: PT
DATE: 09/30/2005

REV	DATE	DESCRIPTION	APP

BOYLE ENGINEERING CORPORATION

JURUPA COMMUNITY SERVICES DISTRICT
JURUPA ION EXCHANGE TREATMENT PLANT -- PHASE III
EQUIPMENT ELEVATIONS

DRAWING NO: E-3
SHEET NO: 30
OF 48 SHEETS
FILE NO: S-2268

NAMEPLATE BUS:AMPS										MTG. IN MCC										MAIN										LUGS ONLY																													
225A										VOLTS 480 VOLTS, 3ø, 3W																																																	
										WATTAGE			OUTLETS			20A/1P C/B'S 14KAIC UON			OUTLETS			WATTAGE																																					
										A	B	C	LTG	REC	MISC				LTG	REC	MISC	A	B	C																																			
ACTUATORS VESSEL 20SV-A (JB-20-P)										1600			.	.	6	1	3	4	.	.	6	1600			ACTUATORS VESSEL 20SV-B (JB-20-P)																																		
											1600		.	.	5	3	4	8	.	.	.		1600																																				
												1600	.	.	5	5	6	6	.	.	.			1600																																			
SPARE										.			.	.	7	7	8	8	.	.	4	1068			ACTUATOR PROCESS 100 & 30 (100V-1) (30V-B1 & C1) (30V-A1)																																		
										.			.	.	9	9	10	10	.	.	.		1068																																				
										.			.	.	11	11	12	12	.	.	.			1068																																			
ACTUATORS PROCESS 40 (40V-A1 & B1)										533			.	.	2	13	14	14	.	.	1	267			ACTUATOR PROCESS 70 (70V-3)																																		
											533		.	.	15	15	16	16	.	.	.		267																																				
												533	.	.	17	17	18	18	.	.	.			267																																			
ACTUATORS PROCESS 50 (50V-A1 & B1)										533			.	.	2	19	20	20	.	.	.						SPARE																																
											533		.	.	21	21	22	22	.	.	.						SPARE																																
												533	.	.	23	23	24	24	.	.	.						SPARE																																
ACTUATOR PROCESS 20 (20V-3)										267			.	.	1	25	26	26	.	.	.						SPARE																																
											267		.	.	27	27	28	28	.	.	.						SPARE																																
												267	.	.	29	29	30	30	.	.	.						SPARE																																
SPACE										.			.	.	31	31	32	32	.	.	.						SPACE																																
SPACE										.			.	.	33	33	34	34	.	.	.						SPACE																																
SPACE										.			.	.	35	35	36	36	.	.	.						SPACE																																
SPACE										.			.	.	37	37	38	38	.	.	.						SPACE																																
SPACE										.			.	.	39	39	40	40	.	.	.						SPACE																																
SPACE										.			.	.	41	41	42	42	.	.	.						SPACE																																
TOTAL LOAD										3,200	3,200	3,200											2,935	2,935	2,935	TOTAL LOAD																																	
18 KW + LCL										KW= 18										KW AT 480										VOLTS										3PH= 22										AMPS									

NAMEPLATE BUS:AMPS										MTG. SURFACE										MAIN									
225A										VOLTS 480 VOLTS, 3ø, 3W										225A 3P									
			WATTAGE			OUTLETS			20A/1P C/B'S 14KAIC UON			OUTLETS			WATTAGE														
			A	B	C	LTG	REC	MISC				LTG	REC	MISC	A	B	C												
ACTUATORS VESSEL 10NV-A (JB-10A-P)			4000			.	.	15	1	3	4	2	.	.	15	4000			ACTUATORS VESSEL 10NV-C (JB-10C-P)										
				4000		.	.	16	3	4	8	.	.	.		4000													
					4000	.	.	17	5	6	6	.	.	.			4000												
ACTUATORS VESSEL 10NV-B (JB-10B-P)			4000			.	.	15	7	8	8	.	.	15	4000			ACTUATORS VESSEL 10NV-D (JB-10D-P)											
				4000		.	.	16	9	10	10	.	.	.		4000													
					4000	.	.	17	11	12	12	.	.	.			4000												
ACTUATORS VESSEL 10NV-E (JB-10E-P)			3733			.	.	14	13	14	14	.	.	14	3733			ACTUATORS VESSEL 10NV-G (JB-10G-P)											
				3733		.	.	15	15	16	16	.	.	.		3733													
					3733	.	.	16	17	18	18	.	.	.			3733												
ACTUATORS VESSEL 10NV-F (JB-10F-P)			3733			.	.	14	19	20	20	.	.	14	3733			ACTUATORS VESSEL 10NV-H (JB-10H-P)											
				3733		.	.	15	21	22	22	.	.	.		3733													
					3733	.	.	16	23	24	24	.	.	.			3733												
ACTUATORS VESSEL 10NV-J (JB-10J-P)			3733			.	.	14	25	26	26	.	.	3	800			ACTUATORS PROCESS 60 (60V-A1, B1 & C1)											
				3733		.	.	15	27	28	28	.	.	.		800													
					3733	.	.	16	29	30	30	.	.	.			800												
ACTUATORS VESSEL 10NV-K (JB-10K-P)			3733			.	.	14	31	32	32	.	.	4	1067			ACTUATORS PROCESS 10 (10V-12, 15, 18 & 20)											
				3733		.	.	15	33	34	34	.	.	.		1067													
					3733	.	.	16	35	36	36	.	.	.			1067												
XFMR "T2"			8500			.	.	1	37	70	38	.	.	.				SPARE											
				8500		.	.	2	39	40	40	.	.	.				SPARE											
SPARE						.	.	3	41	42	42	.	.	.				SPARE											
TOTAL LOAD			31,432	31,432	22,932										17333	17333	17333	TOTAL LOAD											
138 KW + LCL			KW= 138			KW AT 480			VOLTS			3PH= 166			AMPS														

NAMEPLATE BUS:AMPS										MTG. RECESSED										MAIN 125									
225A										VOLTS 120/208 VOLTS, 3ø, 4W																			
			WATTAGE			OUTLETS			20A/1P C/B'S 10KAIC UON			OUTLETS			WATTAGE														
			A	B	C	LTG	REC	MISC				LTG	REC	MISC	A	B	C												
RECEPTACLES			900			.	.	5	1	3	4	.	.	9	832			INTERIOR LTG											
RECEPTACLES				1080		.	.	6	3	4	8	.	.	4		280		EXTERIOR LTG											
RECEPTACLES					720	.	.	4	5	6	8	.	.	6		480		INTERIOR LTG											
RECEPTACLES			540			.	.	3	7	8	10	.	.	1	360			TEL. OUTLET											
RECEPTACLES				360		.	.	2	9	10	12	.	.	1	500			PLC-1											
RECEPTACLES					360	.	.	2	11	12	14	.	.	2	1200			30LIT001/002/003 PEROXIDE PUMP											
CLORTEC PLC			4500			.	.	1	13	14	16	.	.	1	300			30LIT004											
				4500		.	.	2	15	16	18	.	.	1	300			30LIT005											
10A1T011					300	.	.	1	17	18	20	.	.	1	300			31LIT001											
10A1T003			300			.	.	1	19	20	22	.	.	1	300			31LIT002											
10A1T009				300		.	.	1	21	22	24	.	.	1	300			70LIT101											
10A1T008					300	.	.	1	23	24	26	.	.	1	300			70LIT102											
FUTURE			300			.	.	1	25	26	28	.	.	1	300			90LIT101											
10A1T010				300		.	.	1	27	28	30	.	.	1	300			90LIT102											
10C1T005					300	.	.	1	29	30	32	.	.	1	300			40C1T120											
HP-1			3200			.	.	1	31	32	34	.	.	1	300			50C1T120											
				3200		.	.	2	33	34	36	.	.	1	1300			WATER HEATER											
HP-2					3200	.	.	1	35	36	38	.	.	2	600			10FIT--002/10FIT--005											
			3200			.	.	2	37	38	40	.	.	1	500			ACTUATOR 10V-16											
						.	.	3	39	40	42	.	.	1	500			ACTUATOR 10V-17											
TOTAL LOAD			12,940	9,740	5180										2,892	3,480	3340	TOTAL LOAD											
37.5 KW + LCL			1	KW= 38.5			KW AT 208			VOLTS			3PH= 112			AMPS													

DWG: S:\JWA\100-04 CAD (Phase III)\JWA\ELECTRICAL\2248-E05.dwg
DATE: Nov 03, 2007 3:47pm
USER: bedford

CONDUIT SCHEDULE						
CONDUIT NO.	CONDUIT	CONDUCTORS		FROM	TO	REMARKS
		POWER	CONTROL			
0001P	4"	CO	.	SCE POC	SCE TRANSFORMER	CONDUCTORS BY SCE
0002P	(2) 5"	CO	.	SCE TRANSFORMER	"MSB"	CONDUCTORS BY SCE
0003P	2"	3#1/0+1#6 GND	.	"MSB"	MCC-1	
0004P	1 1/4"	3#1+1#6 GND	.	"MSB"	MCC-2	REUSE EXISTING CONDUIT. PULL OUT EXISTING WIRE AND PULL NEW WIRE.
0005P	2 1/2"	3#4/0+1#4 GND	.	"MSB"	PANEL "HB"	
0006P	1 1/4"	2#4	.	PANEL "HB"	XFMR "T2"	
0007P	2"	3#1/0+1#6 GND	.	XFMR "T2"	PANEL "LB"	
0008P	1 1/2"	3#2+1#8 GND	.	"MSB"	RECTIFIER	
0009P	2"	4#1/0+1#6 GND	.	"MSB"	PANEL "LA"	
0010	2"	.	.	PULL BOX	TELEPHONE CABINET	PACBELL
0011	2"	.	.	ANTENNA	PLC	
0021	2"	.	CO	PLC-1	PLC-6	
0022	2"	.	CO	PLC-2	PLC-3	
0023	2"	.	CO	PLC-3	PLC-4	
0024	2"	.	CO	PLC-4	PLC-5	
0025	2"	.	CO	PLC-5	PLC-6	
0026	1 1/2"C	.	48#14	PLC-1	MCC-1	
0027	1 1/2"C	.	34#14	PLC-1	MCC-1	
0028	1"C	.	18#14	PLC-1	MCC-2	
0029	2"C	.	CO	PLC-1	CLORTEC PLC	
0031P	3/4"	2#12+1#12 GND		PANEL "LA"	PLC-1	
0032P	3/4"	2#12+1#12 GND		PANEL "LB"	PLC-2	
0033P	3/4"	2#12+1#12 GND		PANEL "LB"	PLC-3	
0034P	3/4"	2#12+1#12 GND		PANEL "LB"	PLC-4	
0035P	3/4"	2#12+1#12 GND		PANEL "LB"	PLC-5	CONDUIT IS EXISTING
0036P	3/4"	2#12+1#12 GND		PANEL "LB"	PLC-6	CONDUIT IS EXISTING
0037P	1"	4#4+1#6 GND		"MSB"	PANEL "HC"	INTERCEPT EXISTING CONDUIT
0038D	1"	.	8#14	"ATS"	GENERATOR	START/STOP SIGNAL (8#14 ARE SPARES) INTERCEPT EXISTING CONDUIT
0039P	3"	3#350KCML+1#1 GND	.	"ATS"	GENERATOR	INTERCEPT EXISTING CONDUIT
0040P	3/4"	4#12+1#12 GND	.	MINI POWER ZONE	GENERATOR	BATTERY CHARGER, JACKET HEATER
0041P	3/4"	2#10+1#10 GND	.	PANEL "HC"	MINI POWER ZONE	
1001A	3/4"		1#18TSP	PLC-1	10AIT011	
1002D	3/4"		2#14	PLC-1	10AIT011	
1003A	3/4"		1#18TSP	PLC-1	10AIT003	
1004D	3/4"		2#14	PLC-1	10AIT003	
1005A	3/4"		1#18TSP	PLC-1	10AIT009	
1006D	3/4"		2#14	PLC-1	10AIT009	
1007A	3/4"		1#18TSP	PLC-1	10AIT008	
1008D	3/4"		2#14	PLC-1	10AIT008	
1011A	3/4"		1#18TSP	PLC-1	10AIT010	
1012D	3/4"		2#14	PLC-1	10AIT010	
1031P	3/4"	4#12+1#12 GND		PANEL "LA"	10V-16, 10V-17	
1031A	3/4"		2#18TSP	PLC-1	10FIT002/10PIT004	
1032P	3/4"	3#12+1#12 GND		PANEL "HB"	10V-12, 10V-15, 10V-18, 10V-20	
1032D	3/4"		4#14	PLC-1	10FIT002/10CIT005	

GENERAL NOTES

1. LIGHT LINEWORK (——) DENOTES EXISTING EQUIPMENT
2. HEAVY LINEWORK (——) DENOTES NEW EQUIPMENT

* PROVIDE WIRE ONLY, USE EXISTING CONDUIT.
PROVIDE FLEX CONDUIT TO EQUIPMENT WHERE APPLICABLE.

CONDUIT SCHEDULE						
CONDUIT NO.	CONDUIT SIZE	CONDUCTORS		FROM	TO	REMARKS
		POWER	CONTROL			
10033A	3/4"	.	2#18TSP	PLC-1	10PIT005/10FIT006	
10034D	3/4"	.	4#14	PLC-1	10FIT006/10CIT007	
10035A	1 1/4"	.	4#18TSP	PLC-1	10HS016A/10ZIT016-10HS017A/10ZIT017	10V-16, 10V-17
10036D	1"	.	14#14	PLC-1	10HS016A/10ZIT016-10HS017A/10ZIT017	10V-16, 10V-17 (4#14 SPARES)
10037A	1"	.	3#18TSP	PLC-1	10HS012A/10ZS012-10FIT014	10V-12
10038D	3/4"	.	12#14	PLC-1	10HS012A/10ZS012-10FIT014	10V-12 (4#14 SPARES)
10039A	3/4"	.	3#18TSP	PLC-1	10HS015A/10ZS015-10FIT017, 10CIT102	10V-15 *
10040D	3/4"	.	13#14	PLC-1	10HS015A/10ZS015-10FIT017, 10CIT102	10V-15 *
10041A	1 1/4"	.	4#18TSP	PLC-1	10HS018A/10ZIT018-10HS020A/10ZIT020-10FIT019-10FIT021	10V-18, 10V-20
10042D	1"	.	24#14	PLC-1	10HS018A/10ZS018-10HS020A/10ZS020-10FIT019-10FIT021	10V-18, 10V-20
10043A	1"		1#18TSP	PLC-1	10CIT005	
10044A	1"		1#18TSP	PLC	10CIT007	
10045A	1"	.	1#18TSP	PLC-1	10CIT102	
10040D	1"	.	2#14	PLC-1	10CIT102	
10001P	3/4"	3#12+1#12 GND		PANEL "HB"	JB-10A-P	10V-A1,A2
10001S	1"	CO		PANEL "HB"	JB-10A-P	SPARE
10001D	1"		20#14	PLC-2	10HS101A/10ZS101-10HS102A/10ZS102	10V-A1,10V-A2
10002P	3/4"	3#12+1#12 GND		JB-10A-P	JB'S	10V-A3, A4, A5, A6, A7, A8, A10, A11, A12, A13, A14, A18, A20
10002D	3/4"	.	10#14	PLC-2	10HS103A/10ZS103	10V-A3
10003P	3/4"	2#12+1#12 GND		PANEL "LB"	10CIT116	
10003D	3/4"	.	10#14	PLC-2	10HS104A/10ZS104	10V-A4
10004D	3/4"	.	10#14	PLC-2	10HS105A/10ZS105	10V-A5
10005D	1 1/4"	.	30#14	PLC-2	10HS106A/10ZS106 10HS111A/10ZS111-10HS112A/10ZS112	10V-A6, 10V-A11, 10V-A12
10006A	3/4"	.	2#18TSP	PLC-2	10HS107A/10ZIT107	10V-A7
10007D	1"	.	20#14	PLC-2	10HS107A/10ZS107-10HS108A/10ZS108	10V-A7, 10V-A8 (4#14 SPARES)
10008D	1 1/4"	.	30#14	PLC-2	10HS110A/10ZS110 10HS113A/10ZS113-10HS114A/10ZS114	10V-A10, 10V-A13, 10V-A14
10009D	1"	.	20#14	PLC-2	10HS118A/10ZS118-10HS120A/10ZS120	10V-A18, 10V-A20
10010A	3/4"	.	1#18TSP	PLC-2	10PIT118	
10011A	3/4"	.	2#18TSP	PLC-2	10CIT116-10DPIT117	
10012D	3/4"	.	2#14	PLC-2	10CIT116	
10013A	3/4"	.	1#18TSP	PLC-2	10FIT115	
10014D	3/4"	.	2#14	PLC-2	10FIT115	
10015	3/4"	.	CO	10CIT116	SENSOR	
10021P	3/4"	3#12+1#12 GND		PANEL "HB"	JB-10B-P	10V-B1,B2
10021S	1"	CO		PANEL "HB"	JB-10B-P	SPARE
10021D	1"	.	20#14	PLC-2	10HS201A/10ZS201-10HS202A/10ZS202	10V-B1,10V-B2
10022P	3/4"	3#12+1#12 GND		JB-10B-P	JB'S	10V-B3, B4, B5, B6, B7, B8, B10, B11, B12, B13, B14, B18, B20
10022D	3/4"	.	10#14	PLC-2	10HS203A/10ZS203	10V-B3
10023P	3/4"	2#12+1#12 GND		PANEL "LB"	10CIT216	
10023D	3/4"	.	10#14	PLC-2	10HS204A/10ZS204	10V-B4
10024D	3/4"	.	10#14	PLC-2	10HS205A/10ZS205	10V-B5
10025D	1 1/4"	.	30#14	PLC-2	10HS206A/10ZS206 10HS211A/10ZS211-10HS212A/10ZS212	10V-B6, 10V-B11, 10V-B12
10026A	3/4"	.	2#18TSP	PLC-2	10HS207A/10ZIT207	10V-B7

CONDUIT SCHEDULE						
CONDUIT NO.	CONDUIT SIZE	CONDUCTORS		FROM	TO	REMARKS
		POWER	CONTROL			
10027D	1"	.	20#14	PLC-2	10HS207A/10ZS207-10HS208A/10ZS208	10V-B7, 10V-B8 (4#14 SPARES)
10028D	1 1/4"	.	30#14	PLC-2	10HS210A/10ZS210 10HS213A/10ZS213-10HS214A/10ZS214	10V-B10, 10V-B13, 10V-B14
10029D	1"	.	20#14	PLC-2	10HS218A/10ZS218-10HS220A/10ZS220	10V-B18, 10V-B20
10030A	3/4"	.	1#18TSP	PLC-2	10PIT218	
10031A	3/4"	.	2#18TSP	PLC-2	10CIT216-10DPIT217	
10032D	3/4"	.	2#14	PLC-2	10CIT216	
10033A	3/4"	.	1#18TSP	PLC-2	10FIT215	
10034D	3/4"	.	2#14	PLC-2	10FIT215	
10035	3/4"	.	CO	10CIT216	SENSOR	
10041P	3/4"	3#12+1#12 GND		PANEL "HB"	JB-10C-P	10V-C1,C2
10041S	1"	CO		PANEL "HB"	JB-10C-P	SPARE
10041D	1"	.	20#14	PLC-3	10HS301A/10ZS301-10HS302A/10ZS302	10V-C1,10V-C2
10042P	3/4"	3#12+1#12 GND		JB-10C-P	JB'S	10V-C3, C4, C5, C6, C7, C8, C10, C11, C12, C13, C14, C18, C20
10042D	3/4"	.	10#14	PLC-3	10HS303A/10ZS303	10V-C3
10043P	3/4"	2#12+1#12 GND		PANEL "LB"	10CIT316	
10043D	3/4"	.	10#14	PLC-3	10HS304A/10ZS304	10V-C4
10044D	3/4"	.	10#14	PLC-3	10HS305A/10ZS305	10V-C5
10045D	1 1/4"	.	30#14	PLC-3	10HS406A/10ZS406 10HS411A/10ZS411-10HS412A/10ZS412	10V-C6, 10V-C11, 10V-C12
10046A	3/4"	.	2#18TSP	PLC-3	10HS307A/10ZIT307	10V-C7
10047D	1"	.	20#14	PLC-3	10HS307A/10ZS307-10HS308A/10ZS308	10V-C7, 10V-C8 (4#14 SPARES)
10048D	1 1/4"	.	30#14	PLC-3	10HS310A/10ZS310 10HS313A/10ZS313-10HS314A/10ZS314	10V-C10, 10V-C13, 10V-C14
10049D	1"	.	20#14	PLC-3	10HS318A/10ZS318-10HS320A/10ZS320	10V-C18, 10V-C20
10050A	3/4"	.	1#18TSP	PLC-3	10PIT318	
10051A	3/4"	.	2#18TSP	PLC-3	10CIT316-10DPIT317	
10052D	3/4"	.	2#14	PLC-2	10CIT316	
10053A	3/4"	.	1#18TSP	PLC-3	10FIT315	
10054D	3/4"	.	2#14	PLC-3	10FIT315	
10055	3/4"	.	CO	10CIT316	SENSOR	
10061P	3/4"	3#12+1#12 GND		PANEL "HB"	JB-10D-P	10V-D1,D2
10061S	1"	CO		PANEL "HB"	JB-10D-P	SPARE
10061D	1"	.	20#14	PLC-3	10HS401A/10ZS401-10HS402A/10ZS402	10V-D1,10V-D2
10062P	3/4"	3#12+1#12 GND		JB-10D-P	JB'S	10V-D3, D4, D5, D6, D7, D8, D10, D11, D12, D13, D14, D18, D20
10062D	3/4"	.	10#14	PLC-3	10HS403A/10ZS403	10V-D3
10063P	3/4"	2#12+1#12 GND		PANEL "LB"	10CIT416	
10063D	3/4"	.	10#14	PLC-3	10HS404A/10ZS404	10V-D4
10064D	3/4"	.	10#14	PLC-3	10HS405A/10ZS405	10V-D5
10065D	1 1/4"	.	30#14	PLC-3	10HS408A/10ZS408 10HS411A/10ZS411-10HS412A/10ZS412	10V-D6, 10V-D11, 10V-D12
10066A	3/4"	.	2#18TSP	PLC-3	10HS407A/10ZIT407	10V-D7
10067D	1"	.	20#14	PLC-3	10HS407A/10ZS407-10HS408A/10ZS408	10V-D7, 10V-D8 (4#14 SPARES)
10068D	1 1/4"	.	30#14	PLC-3	10HS410A/10ZS410 10HS413A/10ZS413-10HS414A/10ZS414	10V-D10, 10V-D13, 10V-D14
10069D	1"	.	20#14	PLC-3	10HS418A/10ZS418-10HS420A/10ZS420	10V-D18, 10V-D20
10070A	3/4"	.	1#18TSP	PLC-3	10PIT418	
10071A	3/4"	.	2#18TSP	PLC-3	10CIT416-10DPIT417	

RECORD DRAWING
Date: 08-23-07

These record drawings apply only to those facilities constructed under the contract identified in the title block and have been prepared, in part, on the basis of information compiled and furnished by others. The Engineer/Architect will not be responsible for any errors or omissions which have been incorporated into this drawing as a result of the work by others.

VERIFY SCALES
BAR IS ONE INCH ON ORIGINAL DRAWING
0 1
IF NOT ONE INCH ON THIS SHEET,
ADJUST SCALES ACCORDINGLY

APPROVAL:
APPROVAL:
APPROVAL:

DATE:
DATE:
DATE:

DESIGN BY: CU/JL
DRAWN BY: RH
CHECKED BY: PT
DATE: 09/30/2005

REV
DATE

DESCRIPTION

APP

BOYLE ENGINEERING CORPORATION

JURUPA COMMUNITY SERVICES DISTRICT
JURUPA ION EXCHANGE TREATMENT PLANT - PHASE III

CONDUIT SCHEDULE

DRAWING NO.

SHEET NO.

E-5

32

FILE NO.

OF 48 SHEETS

S-2268

DWG: S:\J4\100-04-CAD (phase III)\Pilot\Set\ELECTRICAL\SZ268-F06.dwg
DATE: Nov 08, 2007 3:46pm
USER: hcardford
XREFS: BORDER

CONDUIT SCHEDULE						
CONDUIT NO.	CONDUIT SIZE	CONDUCTORS		FROM	TO	REMARKS
		POWER	CONTROL			
10072D	3/4"	.	2#14	PLC-2	10CIT416	
10073A	3/4"	.	1#18TSP	PLC-3	10FIT415	
10074D	3/4"	.	2#14	PLC-3	10FIT415	
10075	3/4"	.	CO	10CIT416	SENSOR	
10081P	3/4"	3#12+1#12 GND		PANEL "HB"	JB-10E-P	10V-E1
10081S	1"	CO		PANEL "HB"	JB-10E-P	SPARE
10081D	1"	.	10#14	PLC-4	10HS501A/10ZS501	10V-E1
10082P	3/4"	3#12+1#12 GND		JB-10E-P	JB'S	10V-E3, E4, E5, E6, E7, E8, E10, E11, E12, E13, E14, E16, E20
10082D	3/4"	.	10#14	PLC-4	10HS503A/10ZS503	10V-E3
10083P	3/4"	2#12+1#12 GND		PANEL "LB"	10CIT516	
10083D	3/4"	.	10#14	PLC-4	10HS504A/10ZS504	10V-E4
10084D	3/4"	.	10#14	PLC-4	10HS505A/10ZS505	10V-E5
10085D	1 1/4"	.	30#14	PLC-4	10HS506A/10ZS506 10HS511A/10ZS511- 10HS512A/10ZS512	10V-E6, 10V-E11, 10V-E12
10086A	3/4"	.	2#18TSP	PLC-4	10HS507A/10ZIT507	10V-E7
10087D	1"	.	20#14	PLC-4	10HS507A/10ZS507- 10HS508A/10ZS508	10V-E7, 10V-E8 (4#14 SPARES)
10088D	1 1/4"	.	30#14	PLC-4	10HS510A/10ZS510 10HS513A/10ZS513- 10HS514A/10ZS514	10V-E10, 10V-E13, 10V-E14
10089D	1"	.	20#14	PLC-4	10HS518A/10ZS518- 10HS520A/10ZS520	10V-E18, 10V-E20
10090A	3/4"	.	1#18TSP	PLC-4	10PIT518	
10091A	3/4"	.	2#18TSP	PLC-4	10CIT516-10DPIT517	
10092D	3/4"	.	2#14	PLC-4	10CIT516	
10093A	3/4"	.	1#18TSP	PLC-4	10FIT515	
10094D	3/4"	.	2#14	PLC-4	10FIT515	
10095	3/4"	.	CO	10CIT516	SENSOR	
10101P	3/4"	3#12+1#12 GND		PANEL "HB"	JB-10F-P	10V-F1
10101S	1"	CO		PANEL "HB"	JB-10F-P	SPARE
10101D	1"	.	10#14	PLC-4	10HS601A/10ZS601	10V-F1
10102P	3/4"	3#12+1#12 GND		JB-10F-P	JB'S	10V-F3, F4, F5, F6, F7, F8, F10, F11, F12, F13, F14, F18, F20
10102D	3/4"	.	10#14	PLC-4	10HS603A/10ZS603	10V-F3
10103P	3/4"	2#12+1#12 GND		PANEL "LB"	10CIT616	
10103D	3/4"	.	10#14	PLC-4	10HS604A/10ZS604	10V-F4
10104D	3/4"	.	10#14	PLC-4	10HS605A/10ZS605	10V-F5
10105D	1 1/4"	.	30#14	PLC-4	10HS606A/10ZS606 10HS611A/10ZS611- 10HS612A/10ZS612	10V-F6, 10V-F11, 10V-F12
10106A	3/4"	.	2#18TSP	PLC-4	10HS607A/10ZIT607	10V-F7
10107D	1"	.	20#14	PLC-4	10HS607A/10ZS607- 10HS608A/10ZS608	10V-F7, 10V-F8 (4#14 SPARES)
10108D	1 1/4"	.	30#14	PLC-4	10HS610A/10ZS610 10HS613A/10ZS613- 10HS614A/10ZS614	10V-F10, 10V-F13, 10V-F14
10109D	1"	.	20#14	PLC-4	10HS618A/10ZS618- 10HS620A/10ZS620	10V-F18, 10V-F20
10110A	3/4"	.	1#18TSP	PLC-4	10PIT618	
10111A	3/4"	.	2#18TSP	PLC-4	10CIT616-10DPIT617	
10112D	3/4"	.	2#14	PLC-4	10CIT616	
10113A	3/4"	.	1#18TSP	PLC-4	10FIT615	
10114D	3/4"	.	2#14	PLC-4	10FIT615	
10115	3/4"	.	CO	10CIT616	SENSOR	

GENERAL NOTES

1. LIGHT LINEWORK (——) DENOTES EXISTING EQUIPMENT
2. HEAVY LINEWORK (——) DENOTES NEW EQUIPMENT

CONDUIT SCHEDULE						
CONDUIT NO.	CONDUIT SIZE	CONDUCTORS		FROM	TO	REMARKS
		POWER	CONTROL			
10121S	1"	CO		PANEL "HB"	JB-10G-P	SPARE
10121P	3/4"	3#12+1#12 GND		PANEL "HB"	JB-10G-P	10V-G1 *
10121D	1"	.	10#14	PLC-5	10HS701A/10ZS701	10V-G1 *
10122P	3/4"	3#12+1#12 GND		JB-10G-P	JB'S	10V-G3, G4, G5, G6, G7, G8, G10, G11, G12, G13, G14, G18, G20 *
10122D	3/4"	.	10#14	PLC-5	10HS703A/10ZS703	10V-G3 *
10123P	3/4"	2#12+1#12 GND		PANEL "LB"	10CIT716	*
10123D	3/4"	.	10#14	PLC-5	10HS704A/10ZS704	10V-G4 *
10124D	3/4"	.	10#14	PLC-5	10HS705A/10ZS705	10V-G5 *
10125D	1 1/4"	.	30#14	PLC-5	10HS706A/10ZS706 10HS711A/10ZS711- 10HS712A/10ZS712	10V-G6, 10V-G11, 10V-G12 *
10126A	3/4"	.	2#18TSP	PLC-5	10HS707A/10ZIT707	10V-G7 *
10127D	1"	.	20#14	PLC-5	10HS707A/10ZS707- 10HS708A/10ZS708	10V-G7, 10V-G8 (4#14 SPARES) *
10128D	1 1/4"	.	30#14	PLC-5	10HS710A/10ZS710 10HS713A/10ZS713- 10HS714A/10ZS714	10V-G10, 10V-G13, 10V-G14 *
10129D	1"	.	20#14	PLC-5	10HS718A/10ZS718- 10HS720A/10ZS720	10V-G18, 10V-G20 *
10130A	3/4"	.	1#18TSP	PLC-5	10PIT718	*
10131A	3/4"	.	2#18TSP	PLC-5	10CIT716-10DPIT717	*
10132D	3/4"	.	2#14	PLC-5	10CIT716	*
10133A	3/4"	.	1#18TSP	PLC-5	10FIT715	*
10134D	3/4"	.	2#14	PLC-5	10FIT715	*
10135	3/4"	.	CO	10CIT716	SENSOR	
10141P	3/4"	3#12+1#12 GND		PANEL "HB"	JB-10H-P	10V-H1 *
10141S	1"	CO		PANEL "HB"	JB-10H-P	SPARE
10141D	1"	.	10#14	PLC-5	10HS801A/10ZS801	10V-H1 *
10142P	3/4"	3#12+1#12 GND		JB-10H-P	JB'S	10V-H3, H4, H5, H6, H7, H8, H10, H11, H12, H13, H14, H18, H20 *
10142D	3/4"	.	10#14	PLC-5	10HS803A/10ZS803	10V-H3 *
10143P	3/4"	2#12+1#12 GND		PANEL "LB"	10CIT816	*
10143D	3/4"	.	10#14	PLC-5	10HS804A/10ZS804	10V-H4 *
10144D	3/4"	.	10#14	PLC-5	10HS805A/10ZS805	10V-H5 *
10145D	1 1/4"	.	30#14	PLC-5	10HS806A/10ZS806 10HS811A/10ZS811- 10HS812A/10ZS812	10V-H6, 10V-H11, 10V-H12 *
10146A	3/4"	.	2#18TSP	PLC-5	10HS807A/10ZIT807	10V-H7 *
10147D	1"	.	20#14	PLC-5	10HS807A/10ZS807- 10HS808A/10ZS808	10V-H7, 10V-H8 (4#14 SPARES) *
10148D	1 1/4"	.	30#14	PLC-5	10HS810A/10ZS810 10HS813A/10ZS813- 10HS814A/10ZS814	10V-H10, 10V-H13, 10V-H14 *
10149D	1"	.	20#14	PLC-5	10HS818A/10ZS818- 10HS820A/10ZS820	10V-H18, 10V-H20 *
10150A	3/4"	.	1#18TSP	PLC-5	10PIT818	*
10151A	3/4"	.	2#18TSP	PLC-5	10CIT816-10DPIT817	*
10152D	3/4"	.	2#14	PLC-5	10CIT816	*
10153A	3/4"	.	1#18TSP	PLC-5	10FIT815	*
10154D	3/4"	.	2#14	PLC-5	10FIT815	*
10155	3/4"	.	CO	10CIT816	SENSOR	
10161P	3/4"	3#12+1#12 GND		PANEL "HB"	JB-10J-P	10V-J1 *
10161S	1"	CO		PANEL "HB"	JB-10J-P	SPARE
10161D	1"	.	10#14	PLC-6	10HS901A/10ZS901	10V-J1 *
10162P	3/4"	3#12+1#12 GND		JB-10J-P	JB'S	10V-J3, J4, J5, J6, J7, J8, J10, J11, J12, J13, J14, J18, J20 *

CONDUIT SCHEDULE						
CONDUIT NO.	CONDUIT SIZE	CONDUCTORS		FROM	TO	REMARKS
		POWER	CONTROL			
10162D	3/4"	.	10#14	PLC-6	10HS903A/10ZS903	10V-J3 *
10163P	3/4"	2#12+1#12 GND		PANEL "LB"	10CIT916	
10163D	3/4"	.	10#14	PLC-6	10HS904A/10ZS904	10V-J4 *
10164D	3/4"	.	10#14	PLC-6	10HS905A/10ZS905	10V-J5 *
10165D	1 1/4"	.	30#14	PLC-6	10HS906A/10ZS906 10HS911A/10ZS911- 10HS912A/10ZS912	10V-J6, 10V-J11, 10V-J12 *
10166A	3/4"	.	2#18TSP	PLC-6	10HS907A/10ZIT907	10V-J7 *
10167D	1"	.	20#14	PLC-6	10HS907A/10ZS907- 10HS908A/10ZS908	10V-J7, 10V-J8 (4#14 SPARES) *
10168D	1 1/4"	.	30#14	PLC-6	10HS910A/10ZS910 10HS913A/10ZS913- 10HS914A/10ZS914	10V-J10, 10V-J13, 10V-J14 *
10169D	1"	.	20#14	PLC-6	10HS918A/10ZS918- 10HS920A/10ZS920	10V-J18, 10V-J20 *
10170A	3/4"	.	1#18TSP	PLC-6	10PIT918	*
10171A	3/4"	.	2#18TSP	PLC-6	10CIT916-10DPIT917	*
10172D	3/4"	.	2#14	PLC-6	10CIT916	*
10173A	3/4"	.	1#18TSP	PLC-6	10FIT915	*
10174D	3/4"	.	2#14	PLC-6	10FIT915	*
10175	3/4"	.	CO	10CIT916	SENSOR	
10181P	3/4"	3#12+1#12 GND		PANEL "HB"	JB-10K-P	10V-K1 *
10181S	1"	CO		PANEL "HB"	JB-10K-P	SPARE
10181D	1"	.	10#14	PLC-6	10HS1001A/10ZS1001	10V-K1 *
10182P	3/4"	3#12+1#12 GND		JB-10K-P	JB'S	10V-K3, K4, K5, K6, K7, K8, K10, K11, K12, K13, K14, K18, K20 *
10182D	3/4"	.	10#14	PLC-6	10HS1003A/10ZS1003	10V-K3 *
10183P	3/4"	2#12+1#12 GND		PANEL "LB"	10CIT1016	*
10183D	3/4"	.	10#14	PLC-6	10HS1004A/10ZS1004	10V-K4 *
10184D	3/4"	.	10#14	PLC-6	10HS1005A/10ZS1005	10V-K5 *
10185D	1 1/4"	.	30#14	PLC-6	10HS1006A/10ZS1006 10HS1011A/10ZS1011- 10HS1012A/10ZS1012	10V-K6, 10V-K11, 10V-K12 *
10186A	3/4"	.	2#18TSP	PLC-6	10HS1007A/10ZIT1007	10V-K7 *
10187D	1"	.	20#14	PLC-6	10HS1007A/10ZS1007- 10HS1008A/10ZS1008	10V-K7, 10V-K8 (4#14 SPARES) *
10188D	1 1/4"	.	30#14	PLC-6	10HS1010A/10ZS1010 10HS1013A/10ZS1013- 10HS1014A/10ZS1014	10V-K10, 10V-K13, 10V-K14 *
10189D	1"	.	20#14	PLC-6	10HS1018A/10ZS1018- 10HS1020A/10ZS1020	10V-K18, 10V-K20 *
10190A	3/4"	.	1#18TSP	PLC-6	10PIT1018	*
10191A	3/4"	.	2#18TSP	PLC-6	10CIT1016-10DPIT1017	*
10192D	3/4"	.	2#14	PLC-6	10CIT1016	*
10193A	3/4"	.	1#18TSP	PLC-6	10FIT1015	*
10194D	3/4"	.	2#14	PLC-6	10FIT1015	*
10195	3/4"	.	CO	10CIT1016	SENSOR	
20001P	3/4"	3#12+1#12 GND		PANEL "HA"	JB-20-P	20V-A2, A6
20001D	3/4"	.	10#14	PLC-1	20HS101A/20ZS101	20V-A1
20002P	3/4"	3#12+1#12 GND		JB-20A-P	JB'S	20V-A1, A3, A8, A9
20002D	3/4"	.	10#14	PLC-1	20HS102A/20ZS102	20V-A2
20003D	3/4"	.	10#14	PLC-1	20HS103A/20ZS103	20V-A3
20004D	3/4"	.	10#14	PLC-1	20HS106A/20ZS106	20V-A6
20005D	3/4"	.	10#14	PLC-1	20HS108A/20ZS108	20V-A8
20006D	3/4"	.	10#14	PLC-1	20HS109A/20ZS109	20V-A9

- * PROVIDE WIRE ONLY, USE EXISTING CONDUIT.
* PROVIDE FLEX CONDUIT TO EQUIPMENT WHERE APPLICABLE.

JURUPA COMMUNITY SERVICES DISTRICT
JURUPA ION EXCHANGE TREATMENT PLANT -- PHASE III

DRAWING NO: E-6
SHEET NO: 33
OF 48 SHEETS
FILE NO: S-2268

CONDUIT SCHEDULE

BOYLE ENGINEERING CORPORATION

DWG: S:\JWA\100-04 CAD (Phase III)\JPL\SEA\ELECTRICAL\S2268-E07.dwg
DATE: Nov 08, 2007 3:49pm
USER: bedford

CONDUIT SCHEDULE						
CONDUIT NO.	CONDUIT SIZE	CONDUCTORS		FROM	TO	REMARKS
		POWER	CONTROL			
20011P	3/4"	3#12+1#12 GND	.	PANEL "HA"	JB-20-P	20V-B2, B6 *
20011D	3/4"	.	10#14	PLC-1	20HS201A/20ZS201	20V-B1 *
20012P	3/4"	3#12+1#12 GND	.	JB-20B-P	JB'S	20V-B1, B3, B6, B9 *
20012D	3/4"	.	10#14	PLC-1	20HS202A/20ZS202	20V-B2 *
20013D	3/4"	.	10#14	PLC-1	20HS203A/20ZS203	20V-B3 *
20014D	3/4"	.	10#14	PLC-1	20HS206A/20ZS206	20V-B6 *
20015D	3/4"	.	10#14	PLC-1	20HS208A/20ZS208	20V-B8 *
20016D	3/4"	.	10#14	PLC-1	20HS209A/20ZS209	20V-B9 *
20021P	3/4"	3#12+1#12 GND	.	PANEL "HA"	20V-3	
20021A	3/4"	.	2#18TSP	PLC-1	20HS003A/20ZIT003C	20V-3
20022D	3/4"	.	10#14	PLC-1	20HS003A/20ZS003	20V-3 (4#14 SPARES)
20031A	3/4"	.	1#18TSP	PLC-1	20FIT005	
20032D	3/4"	.	2#14	PLC-1	20FIT005	
20033A	3/4"	.	1#18TSP	PLC-1	20FIT007	
20035P	3/4"	2#12+1#12 GND	.	20FIT007	PEROXIDE PUMP RECEPTACLE	
20035D	3/4"	.	2#14.	20FIT007	PEROXIDE PUMP	
30001P	3/4"	6#12+1#12 GND	.	PANEL "LA"	30LIT003	USE 3 SEPARATE EXISTING SPARE 20A/1P CIRCUIT BREAKERS IN EXISTING PANEL "LA"
30001A	3/4"	.	3#18TSP	PLC-1	30LIT003/30LIT013	
30002P	3/4"	2#12+1#12 GND	.	PANEL "LA"	30LIT004	
30002D	3/4"	.	10#14	PLC-1	30LIT003/30LIT013	
30003P	3/4"	2#12+1#12 GND	.	PANEL "LA"	30LIT005	
30003	3/4"	.	CO	30LIT003	LEVEL TRASDUCER	
30004P	3/4"	2#12+1#12 GND	.	PANEL "LA"	31LIT001	
3004A	3/4"	.	1#18TSP	PLC-1	30LIT004	
30005P	3/4"	2#12+1#12 GND	.	PANEL "LA"	31LIT002	
3005D	3/4"	.	2#14	PLC-1	30LIT004	
30006	3/4"	.	CO	30LIT004	LEVEL TRASDUCER	
30007A	3/4"	.	1#18TSP	PLC-1	30LIT005	
30008D	3/4"	.	2#14	PLC-1	30LIT005	
30009	3/4"	.	CO	31LIT005	LEVEL TRASDUCER	
30010A	3/4"	.	1#18TSP	PLC-1	31LIT001	
30011D	3/4"	.	2#14	PLC-1	31LIT001	
30012	3/4"	.	CO	31LIT001	LEVEL TRASDUCER	
30013A	3/4"	.	1#18TSP	PLC-1	31LIT002	
30014D	3/4"	.	2#14	PLC-1	31LIT002	
30015	3/4"	.	CO	31LIT002	LEVEL TRASDUCER	
20035P	3/4"	4#12+1#12 GND	.	30LIT003	30LIT002	
20035D	3/4"	2#12+1#12GND	.	30LIT002	30LIT001	
30021	1"	.	CO	30LIT007	LEVEL TRASDUCER	
30022	1"	.	CO	30LIT006	LEVEL TRASDUCER	

CONDUIT SCHEDULE						
CONDUIT NO.	CONDUIT SIZE	CONDUCTORS		FROM	TO	REMARKS
		POWER	CONTROL			
30023D	1"	.	10#14	JB	30HS212A/30ZS212	
30024D	1"	.	10#14	JB	30HS111A/30ZS111	
40001P	3/4"	3#12+1#12 GND	.	MCC-1	40P-A	
40001D	1"	.	20#14	PLC-1	40HS101A/40ZS101-40HS102A/40ZS102	40V-A1, 40V-B1
40002P	3/4"	3#12+1#12 GND	.	MCC-1	40P-B	
40003P	3/4"	3#12+1#12 GND	.	MCC-1	40P-C	
40004P	3/4"	3#12+1#12 GND	.	MCC-1	40P-D	
40004	3/4"	.	4#14	MCC-1	40FSL110/40FSL111	
40005P	3/4"	3#12+1#12 GND	.	PANEL "HA"	40V-A1, 40V-B2, 40V-4	
40005	3/4"	.	4#14	MCC-1	40FSL112/40FSL113	
40006P	3/4"	2#12+1#12 GND	.	PANEL "LA"	40CIT120	
40006A	3/4"	.	2#18TSP	PLC-1	40CIT120/40FIT121	
40007D	3/4"	.	4#14	PLC-1	40CIT120/40FIT121	
50001P	3/4"	3#12+1#12 GND	.	MCC-1	50P-A	*
50001D	1"	.	20#14	PLC-1	50HS101A/50ZS101-50HS102A/50ZS102	50V-A1, 50V-B1 *
50002P	3/4"	3#12+1#12 GND	.	MCC-1	50P-B	*
50003P	3/4"	3#12+1#12 GND	.	MCC-1	50P-C	*
50004P	3/4"	3#12+1#12 GND	.	MCC-1	50P-D	*
50004	3/4"	.	4#14	MCC-1	50FSL110/50FSL111	*
50005P	3/4"	3#12+1#12 GND	.	PANEL "HA"	50V-A1, 50V-B1	*
50005	3/4"	.	4#14	MCC-1	50FSL112/50FSL113	*
50006P	3/4"	2#12+1#12 GND	.	PANEL "LA"	50CIT120	*
50006A	3/4"	.	2#18TSP	PLC-1	50CIT120/50FIT121	*
50007D	3/4"	.	6#14	PLC-1	50CIT120/50FIT121	2#14 SPARE *
60001P	3/4"	3#12+1#12 GND	.	MCC-2	60BL-A	
60001A	3/4"	3#12+1#12 GND	1#18TSP	PLC-1	60PIT001	
60002D	3/4"	.	8#14	PLC-1	60HS101A/60ZS101-60HS111A/60ZS111	60V-A1-60V-B1
60002P	3/4"	3#12+1#12 GND	.	MCC-2	60BL-B	
60003D	3/4"	.	8#14	PLC-1	60HS121A/60ZS121-60HS131A/60ZS131	60V-C1-60V-D1
60003P	3/4"	3#12+1#12 GND	.	MCC-2	60BL-C	
60004P	3/4"	3#12+1#12 GND	.	PANEL "HB"	JB	60V-A1, 60V-B1
60005P	3/4"	3#12+1#12 GND	.	JB	JB	60V-C1

CONDUIT SCHEDULE						
CONDUIT NO.	CONDUIT SIZE	CONDUCTORS		FROM	TO	REMARKS
		POWER	CONTROL			
70001P	3/4"	3#12+1#12 GND	.	PANEL "HA"	70V-3	
70001A	3/4"	.	1#18TSP	PLC-1	70LIT101	
70002P	3/4"	2#12+1#12 GND	.	PANEL "LA"	70LIT101	
70002D	3/4"	.	2#14	PLC-1	70LIT101	
70003P	3/4"	2#12+1#12 GND	.	PANEL "LA"	70LIT102	*
70003	3/4"	.	CO	70LIT101	LEVEL TRASDUCER	
70004A	3/4"	.	1#18TSP	PLC-1	70LIT102	*
70005D	3/4"	.	2#14	PLC-1	70LIT102	*
70006	3/4"	.	CO	70LIT102	LEVEL TRASDUCER	
70007A	3/4"	.	2#18TSP	PLC-1	70HS103A/70ZIT103	70V-3
70008D	3/4"	.	10#14	PLC-1	70HS103A/70ZS103	70V-3 (4#14 SPARES)
70009A	3/4"	.	1#18TSP	PLC-1	70FIT104	
70010D	3/4"	.	2#14	PLC-1	70FIT104	
80001P	3/4"	3#12+1#12 GND	.	MCC-1	80P-A	
80001D	3/4"	.	4#14	PLC-1	80PIT005-80PIT011	
80002P	3/4"	3#12+1#12 GND	.	MCC-1	80P-B	
90001P	3/4"	2#12+1#12 GND	.	PANEL "LA"	90LIT101	
90001A	1"	.	4#18TSP	PLC-1	CLORTEC PLC	
90002P	3/4"	2#12+1#12 GND	.	PANEL "LA"	90LIT102	
90002D	1"	.	16#14	PLC-1	CLORTEC PLC	
90003A	3/4"	.	2#18TSP	PLC-1	90LIT101-90LIT102	
90004D	3/4"	.	4#14	PLC-1	90LIT101-90LIT102	
90005	3/4"	.	CO	90LIT101	LEVEL TRASDUCER	
90006	3/4"	.	CO	90LIT102	LEVEL TRASDUCER	
100001P	3/4"	3#10+1#10 GND	.	MCC-1	100P-A	
100001D	3/4"	.	10#14	PLC-1	100HS001A/100ZS001	100V-1
100002P	3/4"	3#12+1#12 GND	.	PANEL "HA"	100V-1	

* PROVIDE WIRE ONLY, USE EXISTING CONDUIT. PROVIDE FLEX CONNECTION TO EQUIPMENT WHERE APPLICABLE.

GENERAL NOTES

1. LIGHT LINEWORK (——) DENOTES EXISTING EQUIPMENT
2. HEAVY LINEWORK (——) DENOTES NEW EQUIPMENT

NOTES:

1

PULL OUT THE AND PROVIDE EXISTING CONDUIT

RECORD DRAWING
Date: 08-23-07
These record drawings apply only to those facilities constructed under the contract identified in the title block and have been prepared, in part, on the basis of information compiled and furnished by others. The Engineer/Architect will not be responsible for any errors or omissions which have been incorporated into this drawing as a result of the work by others.

JURUPA COMMUNITY SERVICES DISTRICT
JURUPA ION EXCHANGE TREATMENT PLANT -- PHASE III

CONDUIT SCHEDULE

DRAWING NO:

E-7

FILE NO:

SHEET NO:

34

OF 48 SHEETS

S-2268

BOYLE ENGINEERING CORPORATION

VERIFY SCALES

BAR IS ONE INCH ON ORIGINAL DRAWING
0 1
IF NOT ONE INCH ON THIS SHEET,
ADJUST SCALES ACCORDINGLY

APPROVAL:

APPROVAL:

APPROVAL:

DATE:

DATE:

DATE:

DESIGN BY:

CU/JL

DATE:

DD

CHECKED BY:

PT

DATE:

09/30/2005

REV

DATE



DESCRIPTION

APP

DATE

DESCRIPTION

APP

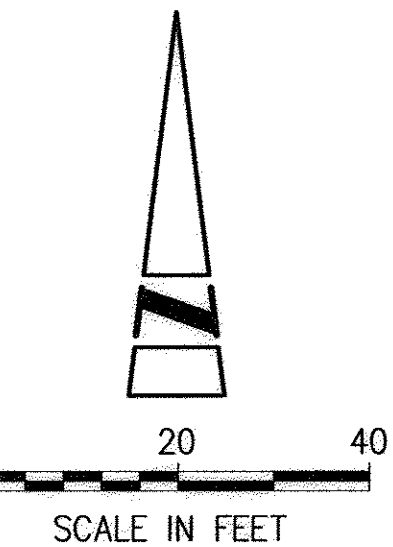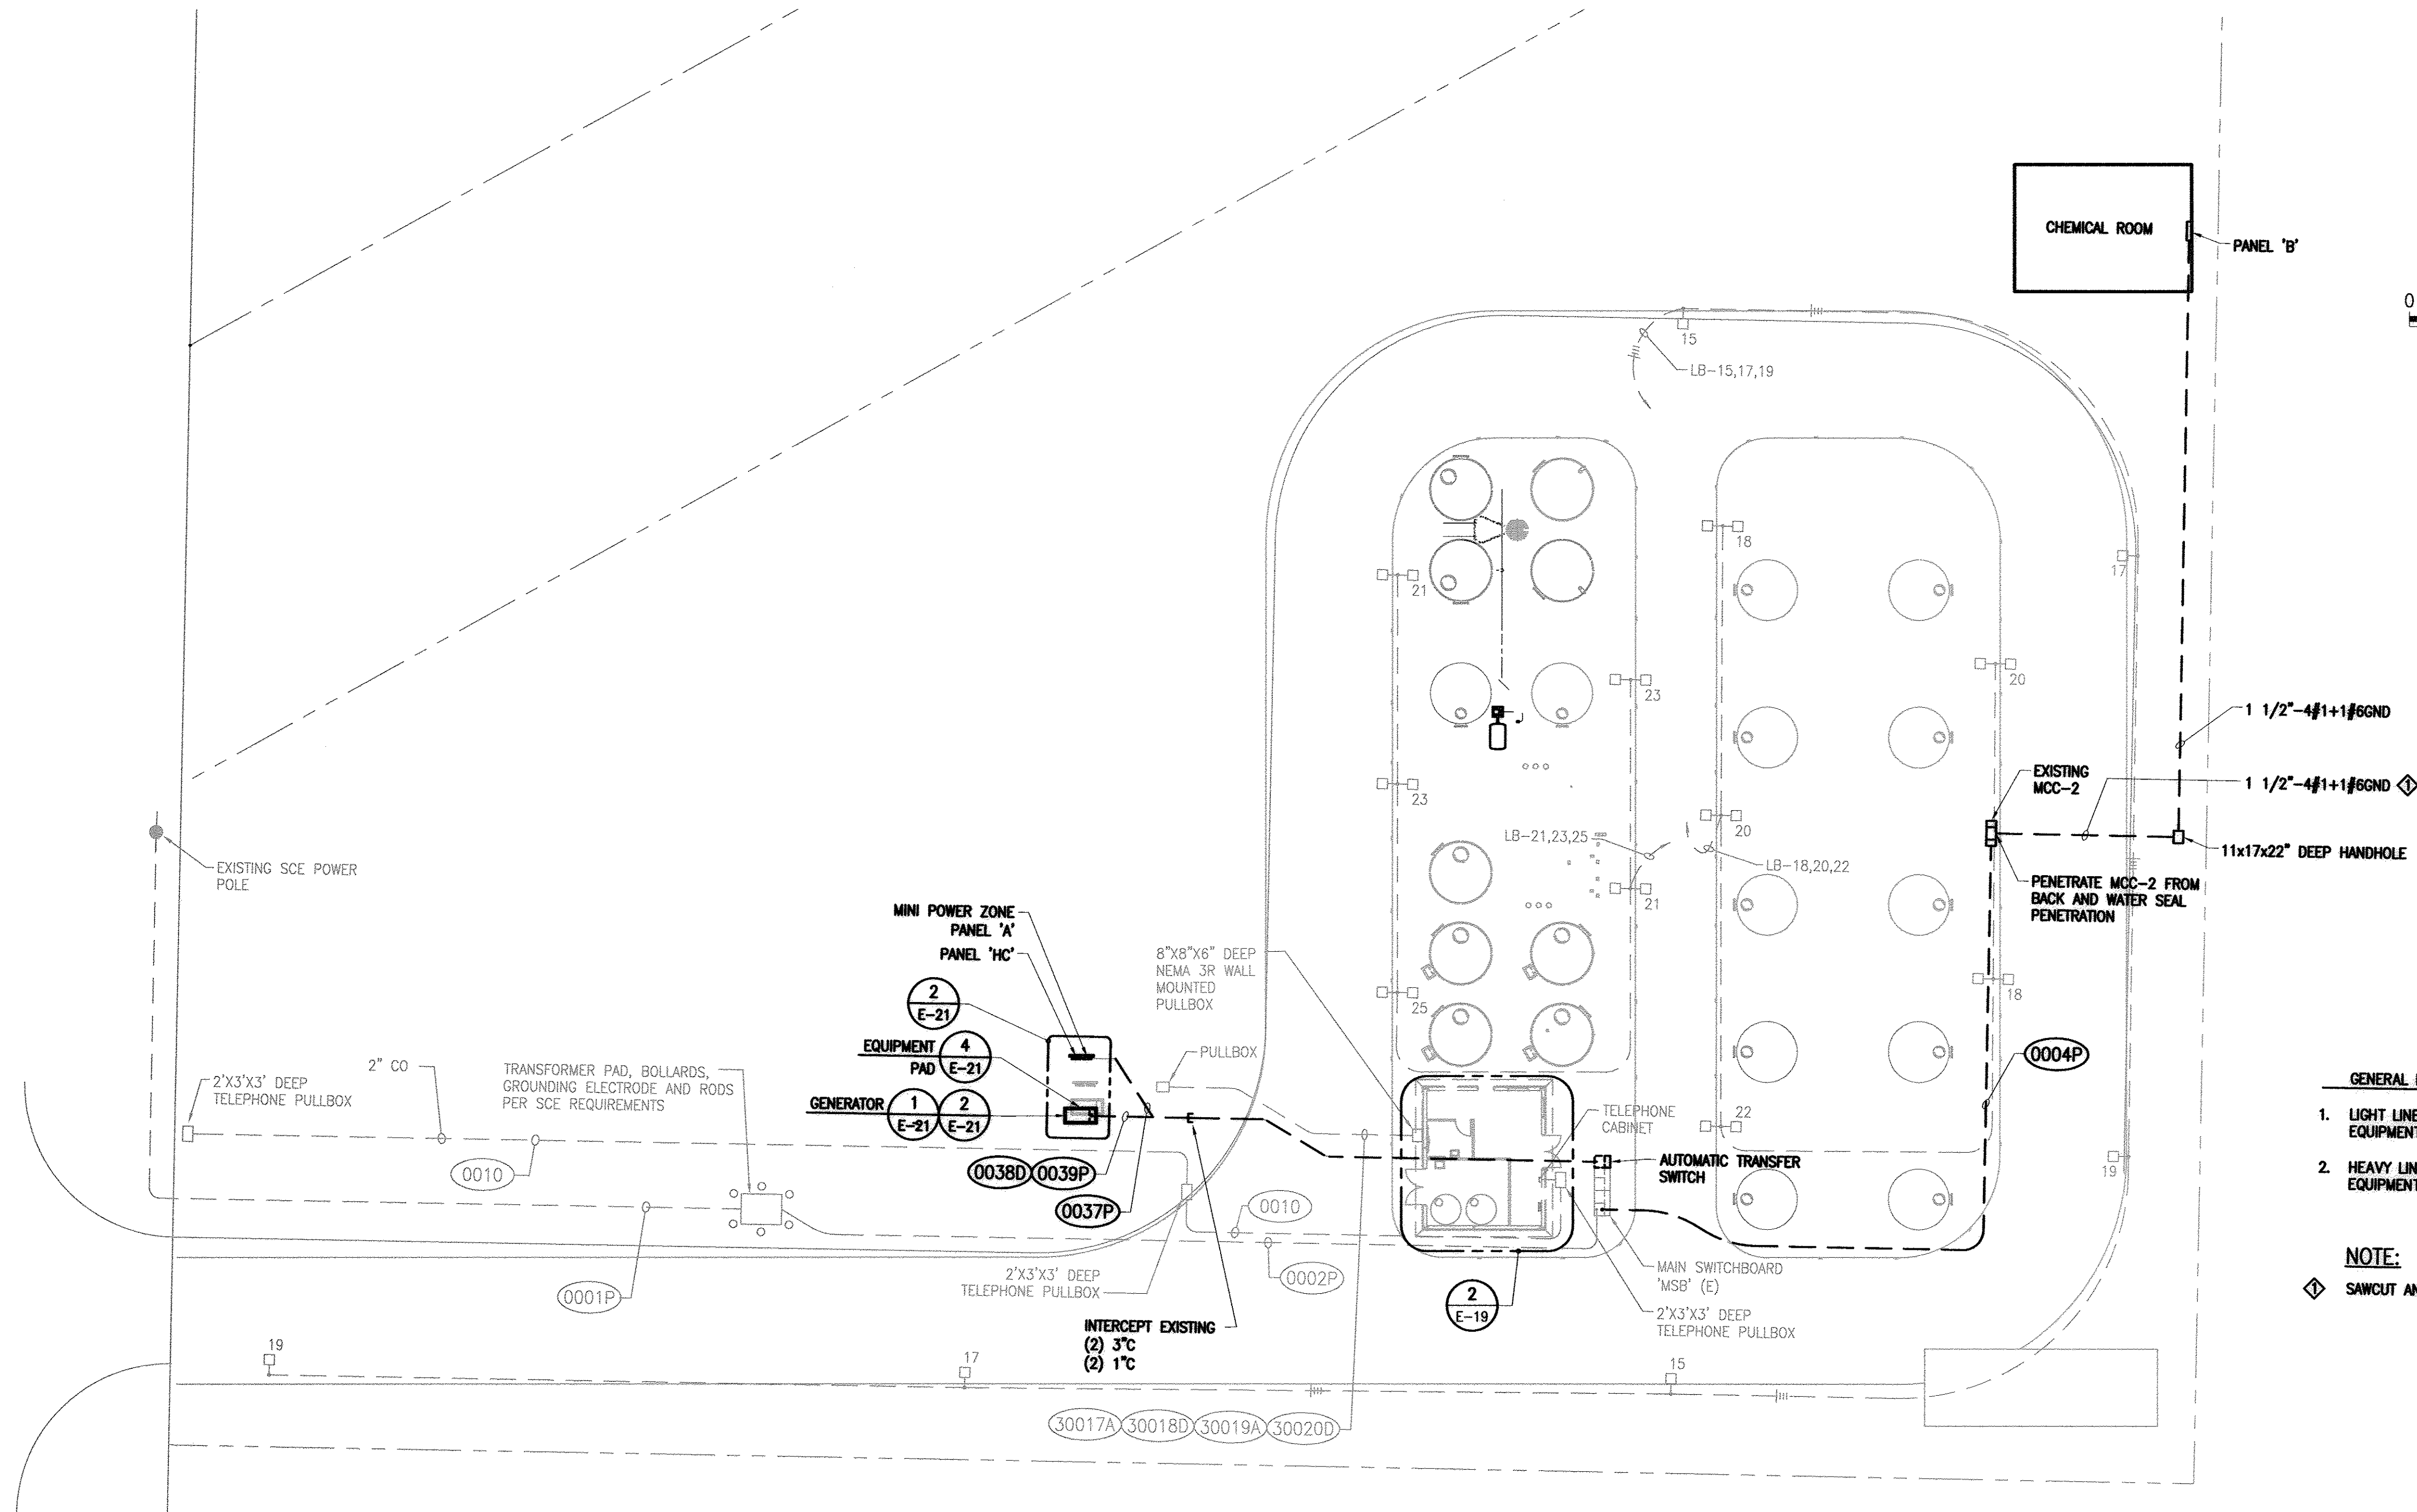

GENERAL NOTES

1. LIGHT LINEWORK (---) DENOTES EXISTING EQUIPMENT
2. HEAVY LINEWORK (—) DENOTES NEW EQUIPMENT

NOTE:

- ◆ SAWCUT AND PATCH EXISTING CONCRETE.

RECORD DRAWING

Date: 08-23-07

These record drawings apply only to those facilities constructed under the contract identified in the title block and have been prepared, in part, on the basis of information compiled and furnished by others. The Engineer/Architect will not be responsible for any errors or omissions which have been incorporated into this drawing as a result of the work by others.

DRAWING NO:

SHEET NO:

E-8

35

FILE NO:

OF 48 SHEETS

S-2268

JURUPA COMMUNITY SERVICES DISTRICT

JURUPA ION EXCHANGE TREATMENT PLANT - PHASE III

ELECTRICAL SITE PLAN

BOYLE ENGINEERING CORPORATION

VERIFY SCALES
BAR IS ONE INCH ON ORIGINAL DRAWING
0 1
IF NOT ONE INCH ON THIS SHEET,
ADJUST SCALES ACCORDINGLY

APPROVAL:	DATE:	DESIGN BY: CU/JL			
APPROVAL:	DATE:	DRAWN BY: RH			
APPROVAL:	DATE:	CHECKED BY: PT			
	DATE: 09/30/2005	REV	DATE	DESCRIPTION	APP

ION EXCHANGE VESSEL
PARTIAL PLAN

1 1
E-10 E-15

BLOWERS
PARTIAL PLAN

1 2
E-14 E-14

MOTOR CONTROL CENTER "MCC-2"

1 1 ION EXCHANGE VESSEL
PARTIAL PLAN

E-11 E-16

SCALE: 1/8" = 1'-0"

GENERAL NOTES

1. LIGHT LINEWORK (—) DENOTES EXISTING EQUIPMENT
2. HEAVY LINEWORK (—) DENOTES NEW EQUIPMENT

WASTE TANK AND
SOFTENER VESSELS
PARTIAL PLAN

1 1
E-12 E-17

- NOTES:
1. PROVIDE CONDUIT ONLY TO FUTURE EQUIPMENT, INCLUDE JUNCTION BOXES AND 'C' CHANNELS.

BRINE AND RINSE
TANKS PARTIAL PLAN

1 1
E-13 E-18

RECORD DRAWING

Date: 08-23-07

These record drawings apply only to those facilities constructed under the contract identified in the title block and have been prepared, in part, on the basis of information compiled and furnished by others. The Engineer/Architect will not be responsible for any errors or omissions which have been incorporated into this drawing as a result of the work by others.

DWG: S:\JWA\100-04 CAD (Phase III)\JWA\ELECTRICAL\S2268-E09.dwg
DATE: Nov 08, 2007 3:52 pm
USER: lbeckford
XREFS: Phobos BORDER

VERIFY SCALES
BAR IS ONE INCH ON ORIGINAL DRAWING
0 1
IF NOT ONE INCH ON THIS SHEET,
ADJUST SCALES ACCORDINGLY

APPROVAL:
DATE:
APPROVAL:
DATE:
APPROVAL:
DATE:

DESIGN BY: CU/JL
DATE: 2/27/06
DRAWN BY: RH
DATE: 3/1/07
CHECKED BY: PT
DATE: 09/30/2005

ADDENDUM 2
CHANGE ORDER 1.2
REV DATE DESCRIPTION APP

BOYLE ENGINEERING CORPORATION


JURUPA COMMUNITY SERVICES DISTRICT
JURUPA ION EXCHANGE TREATMENT PLANT - PHASE III

SITE POWER & CONTROL DISTRIBUTION PLAN

DRAWING NO: E-9
SHEET NO: 36
OF 48 SHEETS
FILE NO: S-2268

DWG: S:\J04\100-04\CAD (phase III)\PlanSet\ELECTRICAL\S2268--E10.dwg
 DATE: Nov 08 2007 3:52pm
 XREFS: Pintolan BORDER
 USER: kbedford

THIS SHEET IS PROVIDED FOR INFORMATION PURPOSES ONLY

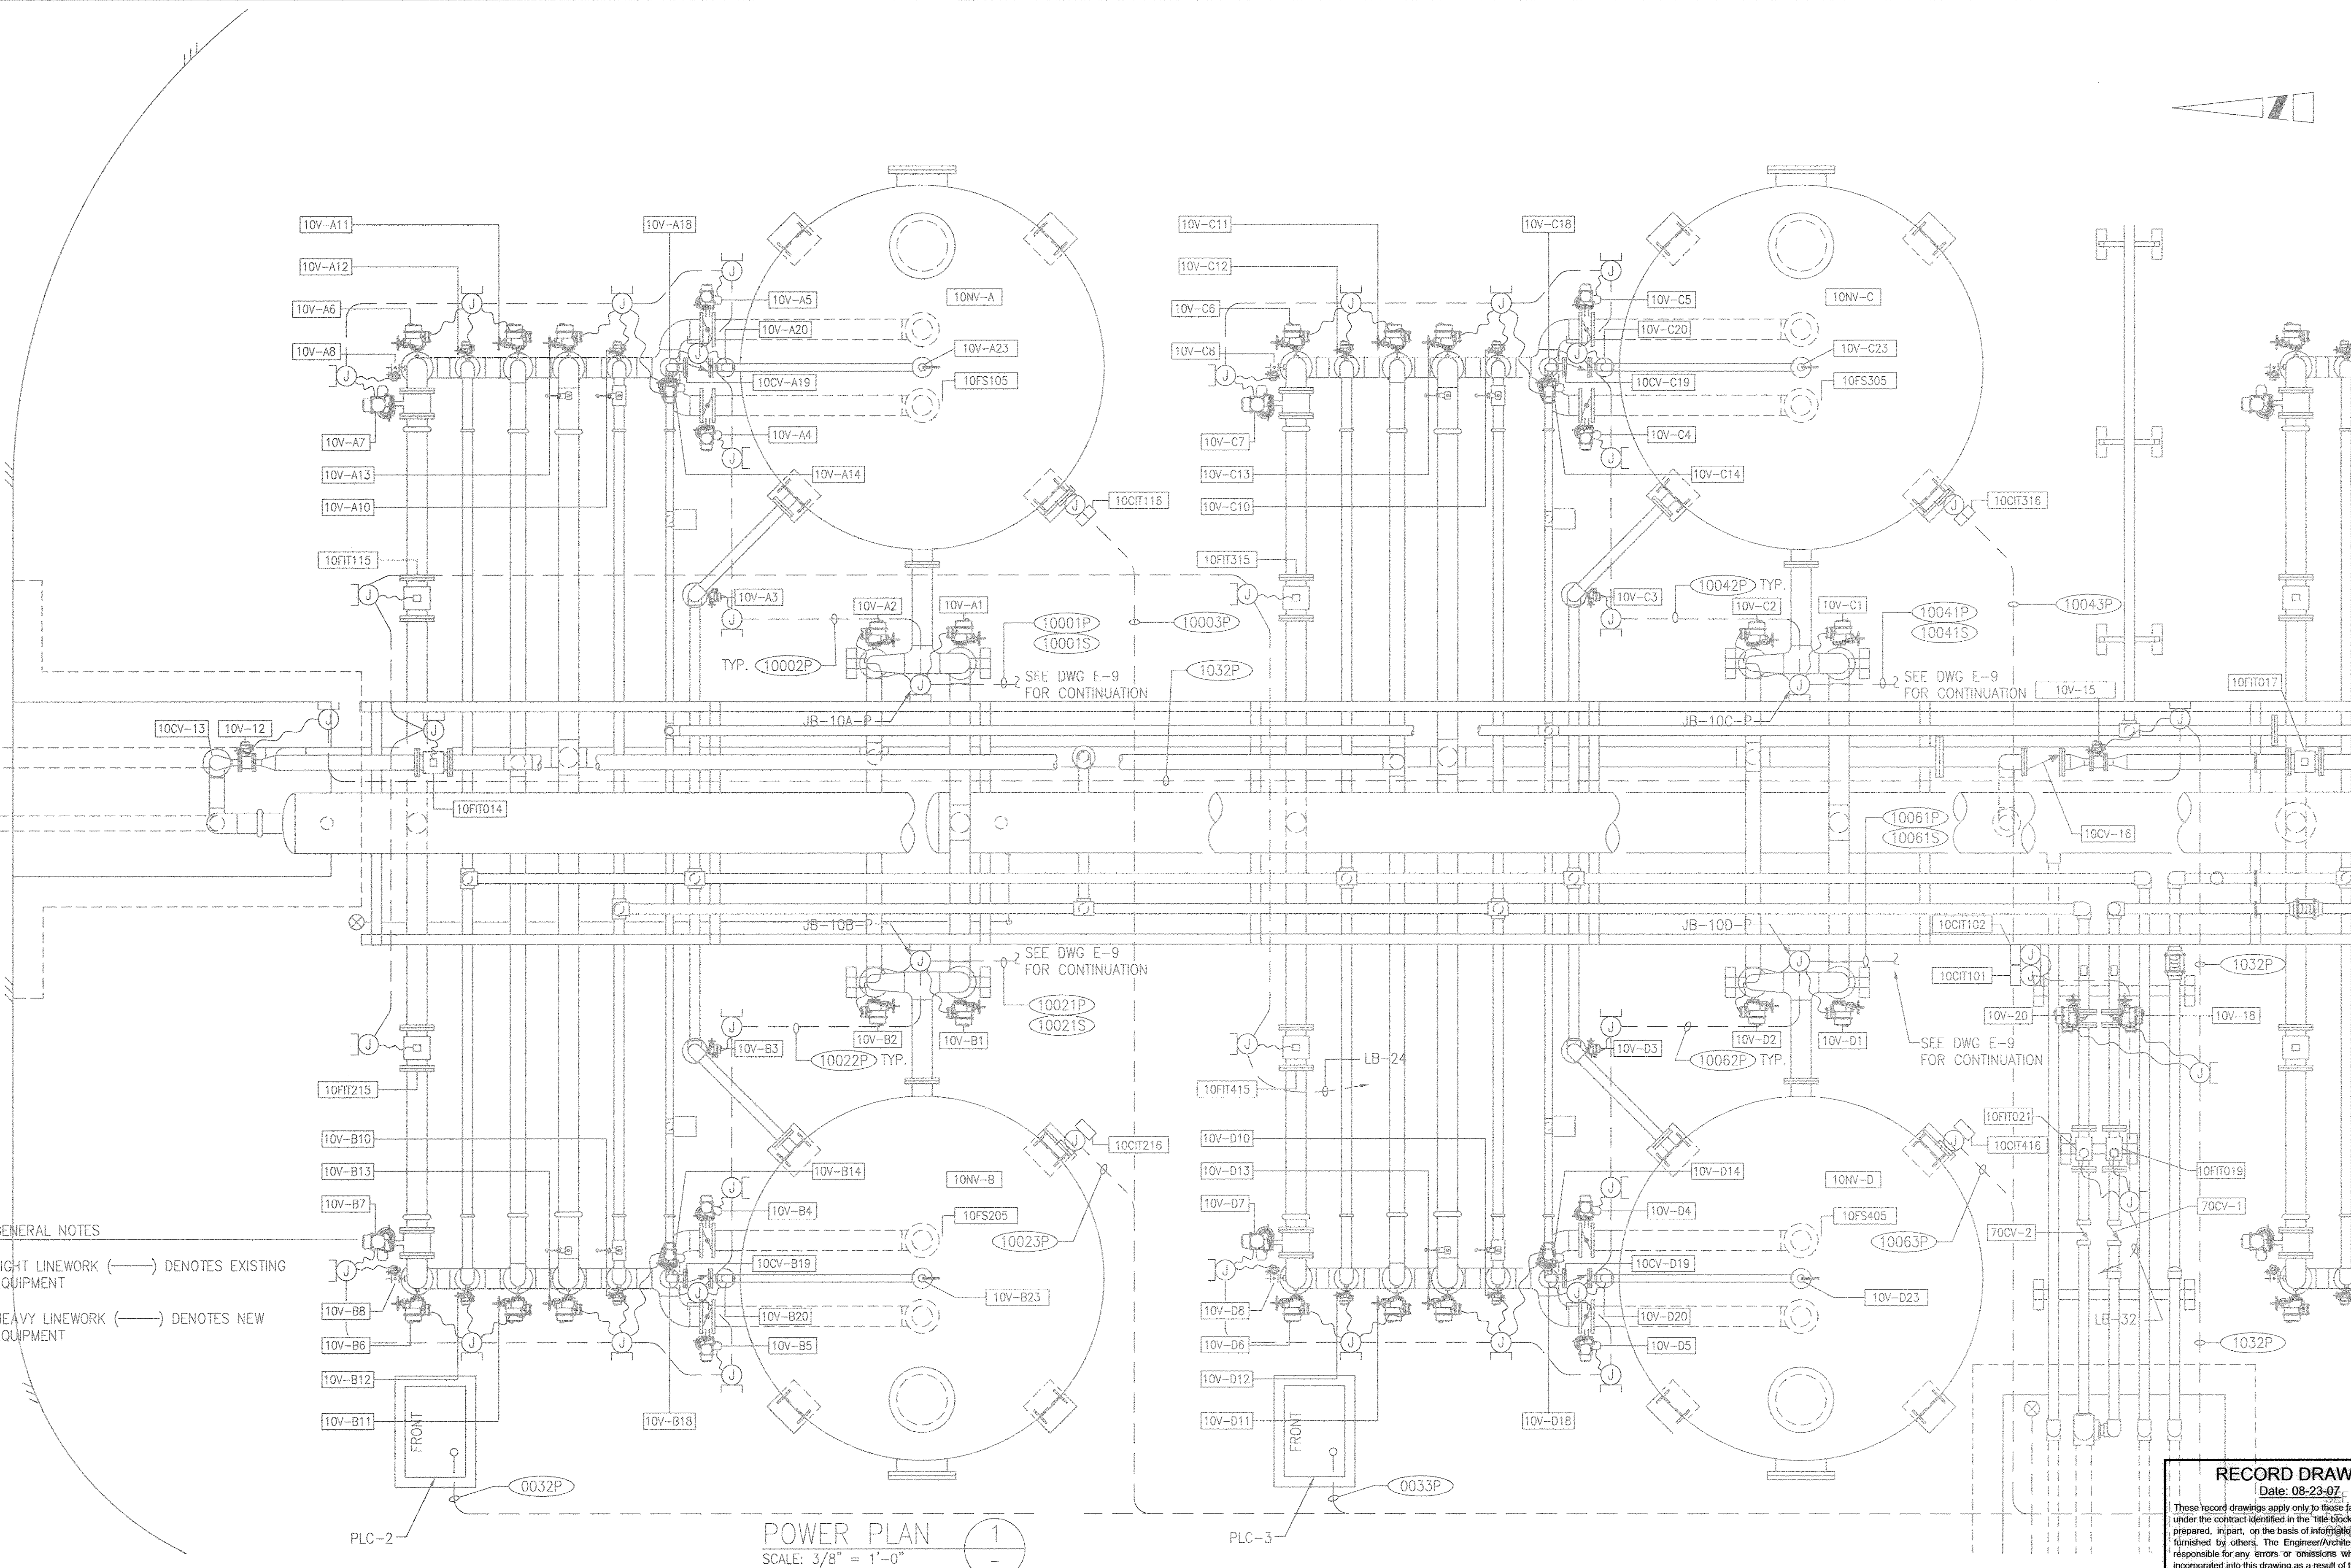

VERIFY SCALES
ONE INCH ON ORIGINAL DRAWING
0 ——— 1
NOT ONE INCH ON THIS SHEET,
ADJUST SCALES ACCORDINGLY

APPROVAL:	
APPROVAL:	
APPROVAL:	

DATE:	DESIGN BY:	CU/J
DATE:	DRAWN BY:	RH
DATE:	CHECKED BY:	PT
DATE:	DATE:	09/30/2005


REV.	DATE	DESCRIPTION	AMT.

BOYLE ENGINEERING CORPORATION

JURUPA COMMUNITY SERVICES DISTRICT
JURUPA ION EXCHANGE TREATMENT PLANT – PHASE I
ION EXCHANGE VESSEL
PARTIAL POWER PLAN

DRAWING NO:	SHEET NO:
E-10	37
FILE NO:	OF 48 SHEETS
S-2268	

DWG: S:\04\100-04\CAD (Phase III)\PlanSet\ELECTRICAL\2268-E11.dwg
DATE: Nov 08, 2007 4:07pm
USER: bedford
XREFS: 100-04

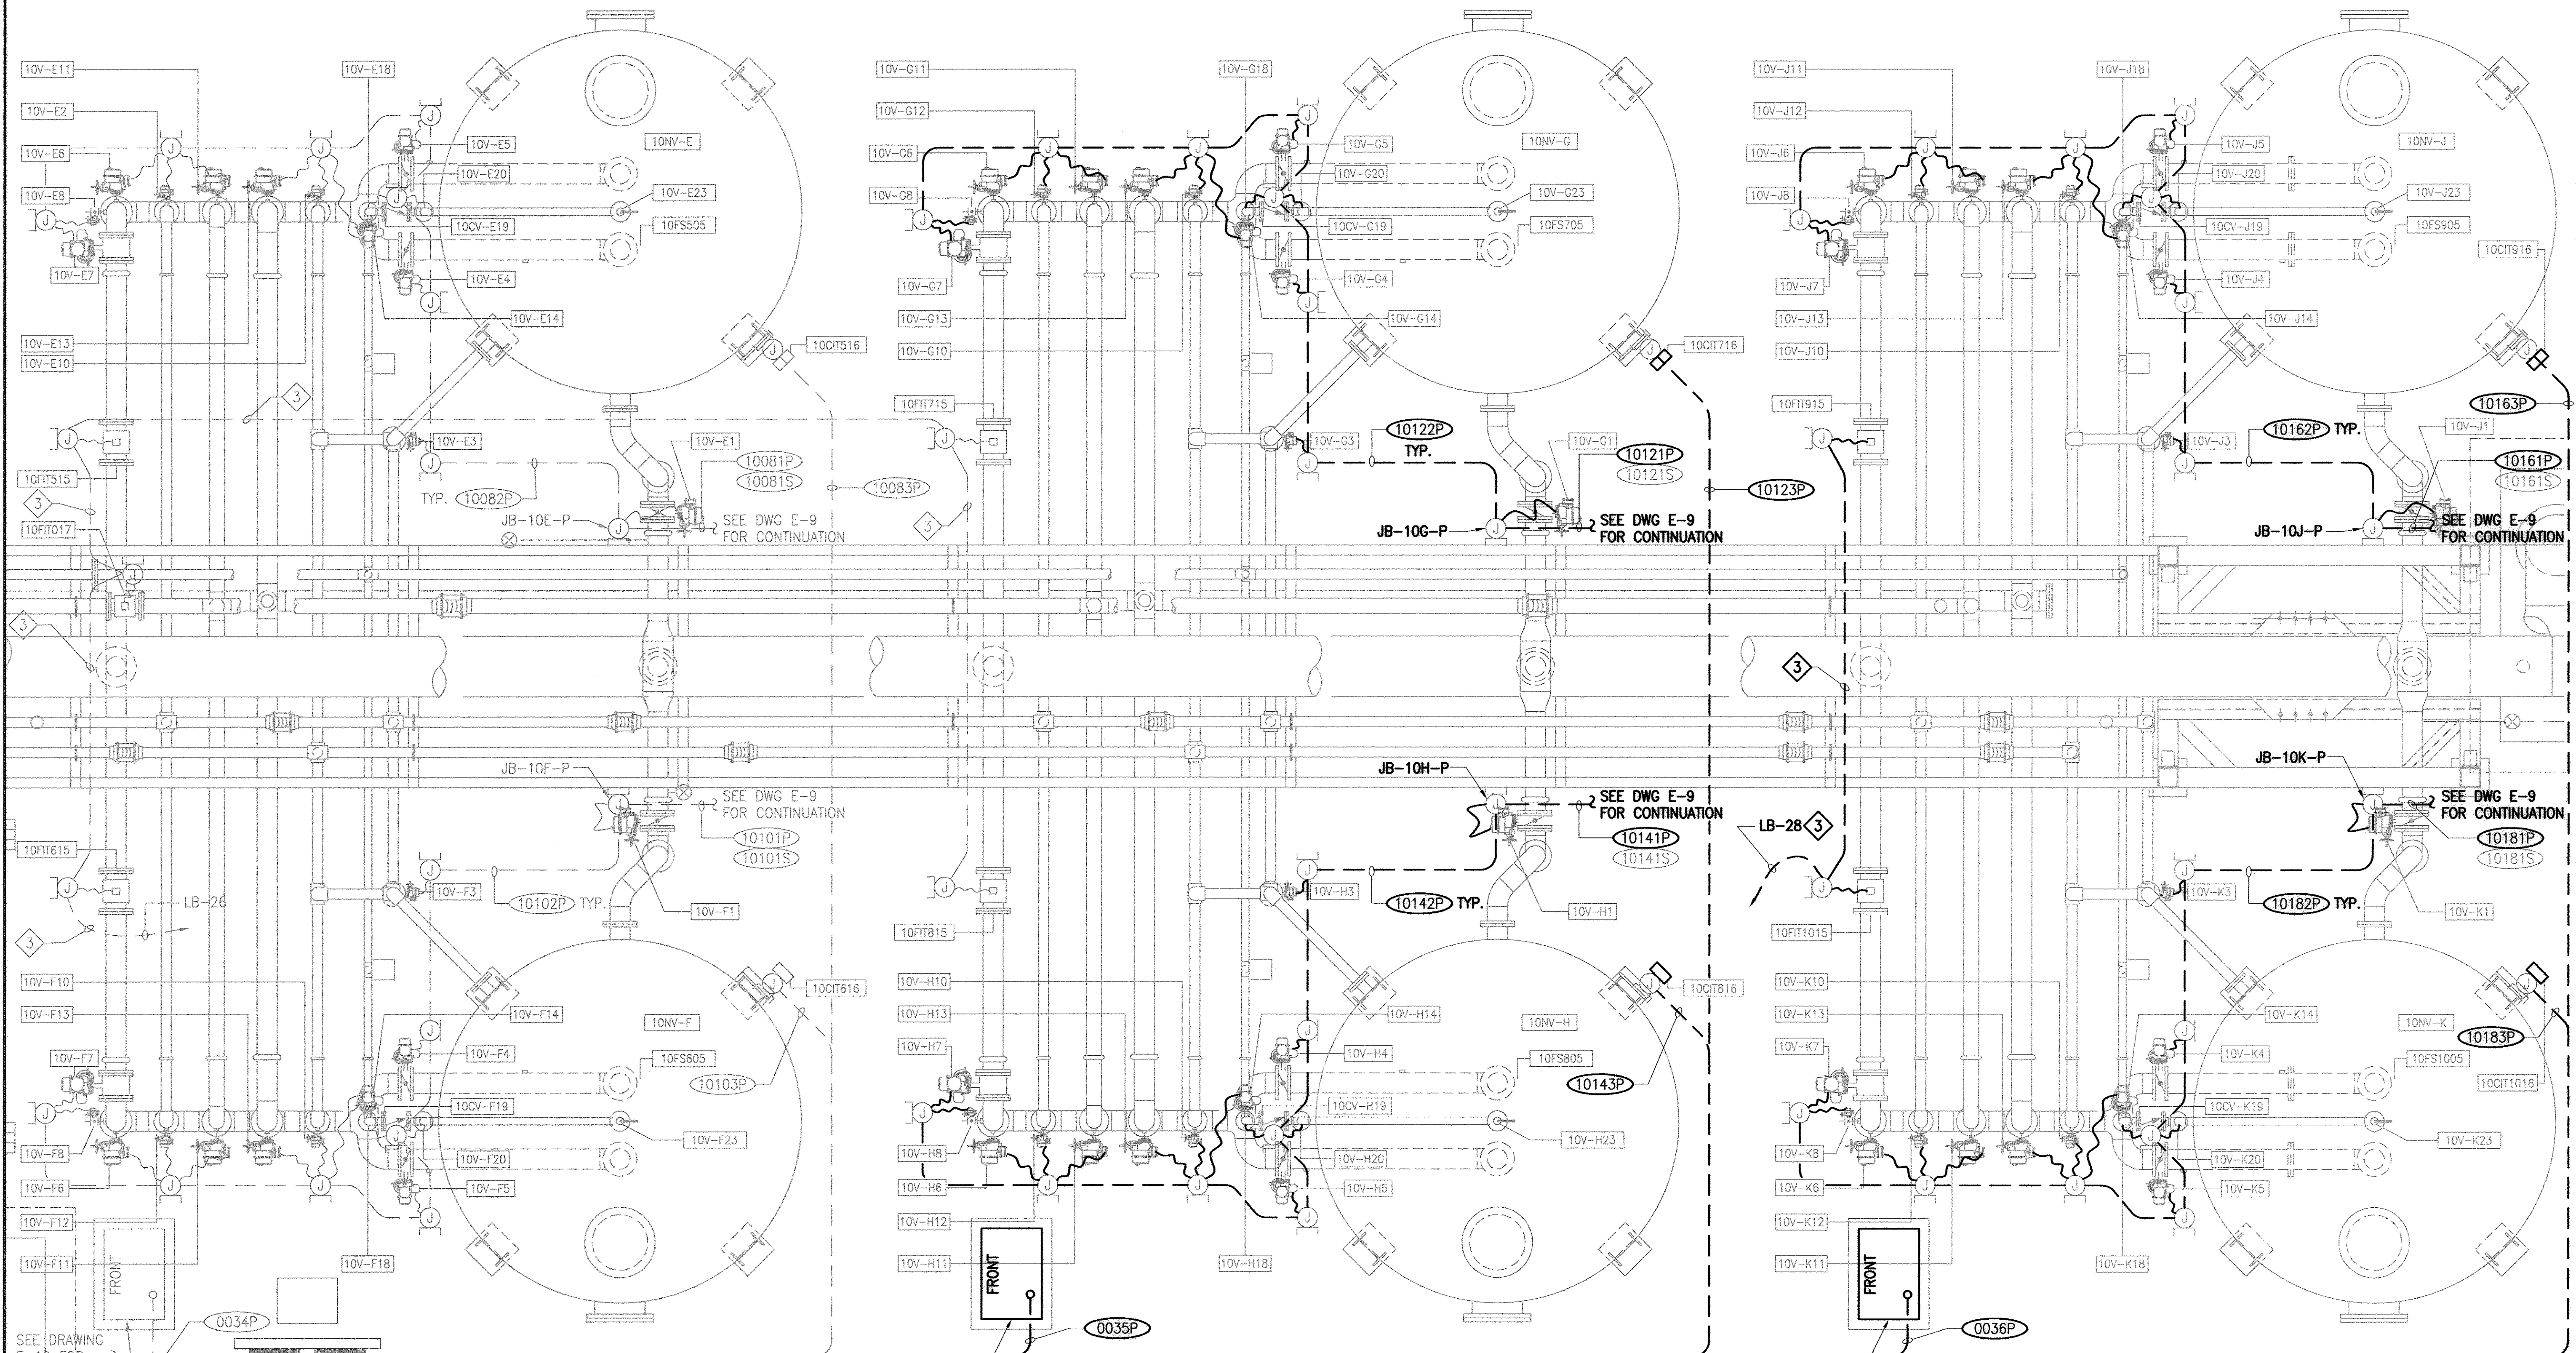

POWER PLAN

SCALE: 3/8" = 1'-0"

1

NOTES

1. LIGHT LINEWORK (—) DENOTES EXISTING EQUIPMENT
2. HEAVY LINEWORK (—) DENOTES NEW EQUIPMENT

RECORD DRAWING

Date: 08-23-07

CONDUIT IS EXISTING
These facilities constructed under the contract identified in the title block and have been prepared, in part, on the basis of information compiled and furnished by others. The Engineer/Architect will not be responsible for any errors or omissions which have been incorporated into this drawing as a result of the work by others.

VERIFY SCALES
BAR IS ONE INCH ON ORIGINAL DRAWING
0 1
IF NOT ONE INCH ON THIS SHEET,
ADJUST SCALES ACCORDINGLY

APPROVAL:	DATE:	DESIGN BY:	CU/JL
APPROVAL:	DATE:	DRAWN BY:	RH
APPROVAL:	DATE:	CHECKED BY:	PT
APPROVAL:	DATE:	DATE:	09/30/2005

DESIGN BY: CU/JL
DRAWN BY: RH
CHECKED BY: PT
DATE: 09/30/2005

REV	DATE	DESCRIPTION	APP

BOYLE ENGINEERING CORPORATION

JURUPA COMMUNITY SERVICES DISTRICT
JURUPA ION EXCHANGE TREATMENT PLANT - PHASE III
ION EXCHANGE VESSEL
PARTIAL POWER PLAN

DRAWING NO: E-11
SHEET NO: 38
OF 48 SHEETS
FILE NO: S-2268

1. LIGHT LINEWORK (—) DENOTES EXISTING EQUIPMENT
2. HEAVY LINEWORK (—) DENOTES NEW EQUIPMENT



1
RECORD DRAWING
Date: 08-23-07

These record drawings apply only to those facilities constructed under the contract identified in the title block and have been prepared, in part, on the basis of information compiled and furnished by others. The Engineer/Architect will not be responsible for any errors or omissions which have been incorporated into this drawing as a result of the work by others.

DRAWING NO: E-12	SHEET NO: 39
FILE NO:	OF 48 SHEETS
S-2268	


VERIFY SCALES
ONE INCH ON ORIGINAL DRAWING
0 ——— 1
NOT ONE INCH ON THIS SHEET,
ADJUST SCALES ACCORDINGLY

[illegible]

BOYLE ENGINEERING CORPORATION

JURUPA COMMUNITY SERVICES DISTRICT
JURUPA ION EXCHANGE TREATMENT PLANT – PHASE III
WASTE TANKS AND SOFTENER VESSELS
POWER PLAN

DWG: S:\J04\100-04\CAD (phase III)\PlanSet\ELECTRICAL\S2268-E12.dwg
 DATE: Nov 08, 2007 4:09pm
 XREFS: BORDER Pintplan
 USER: kbedford

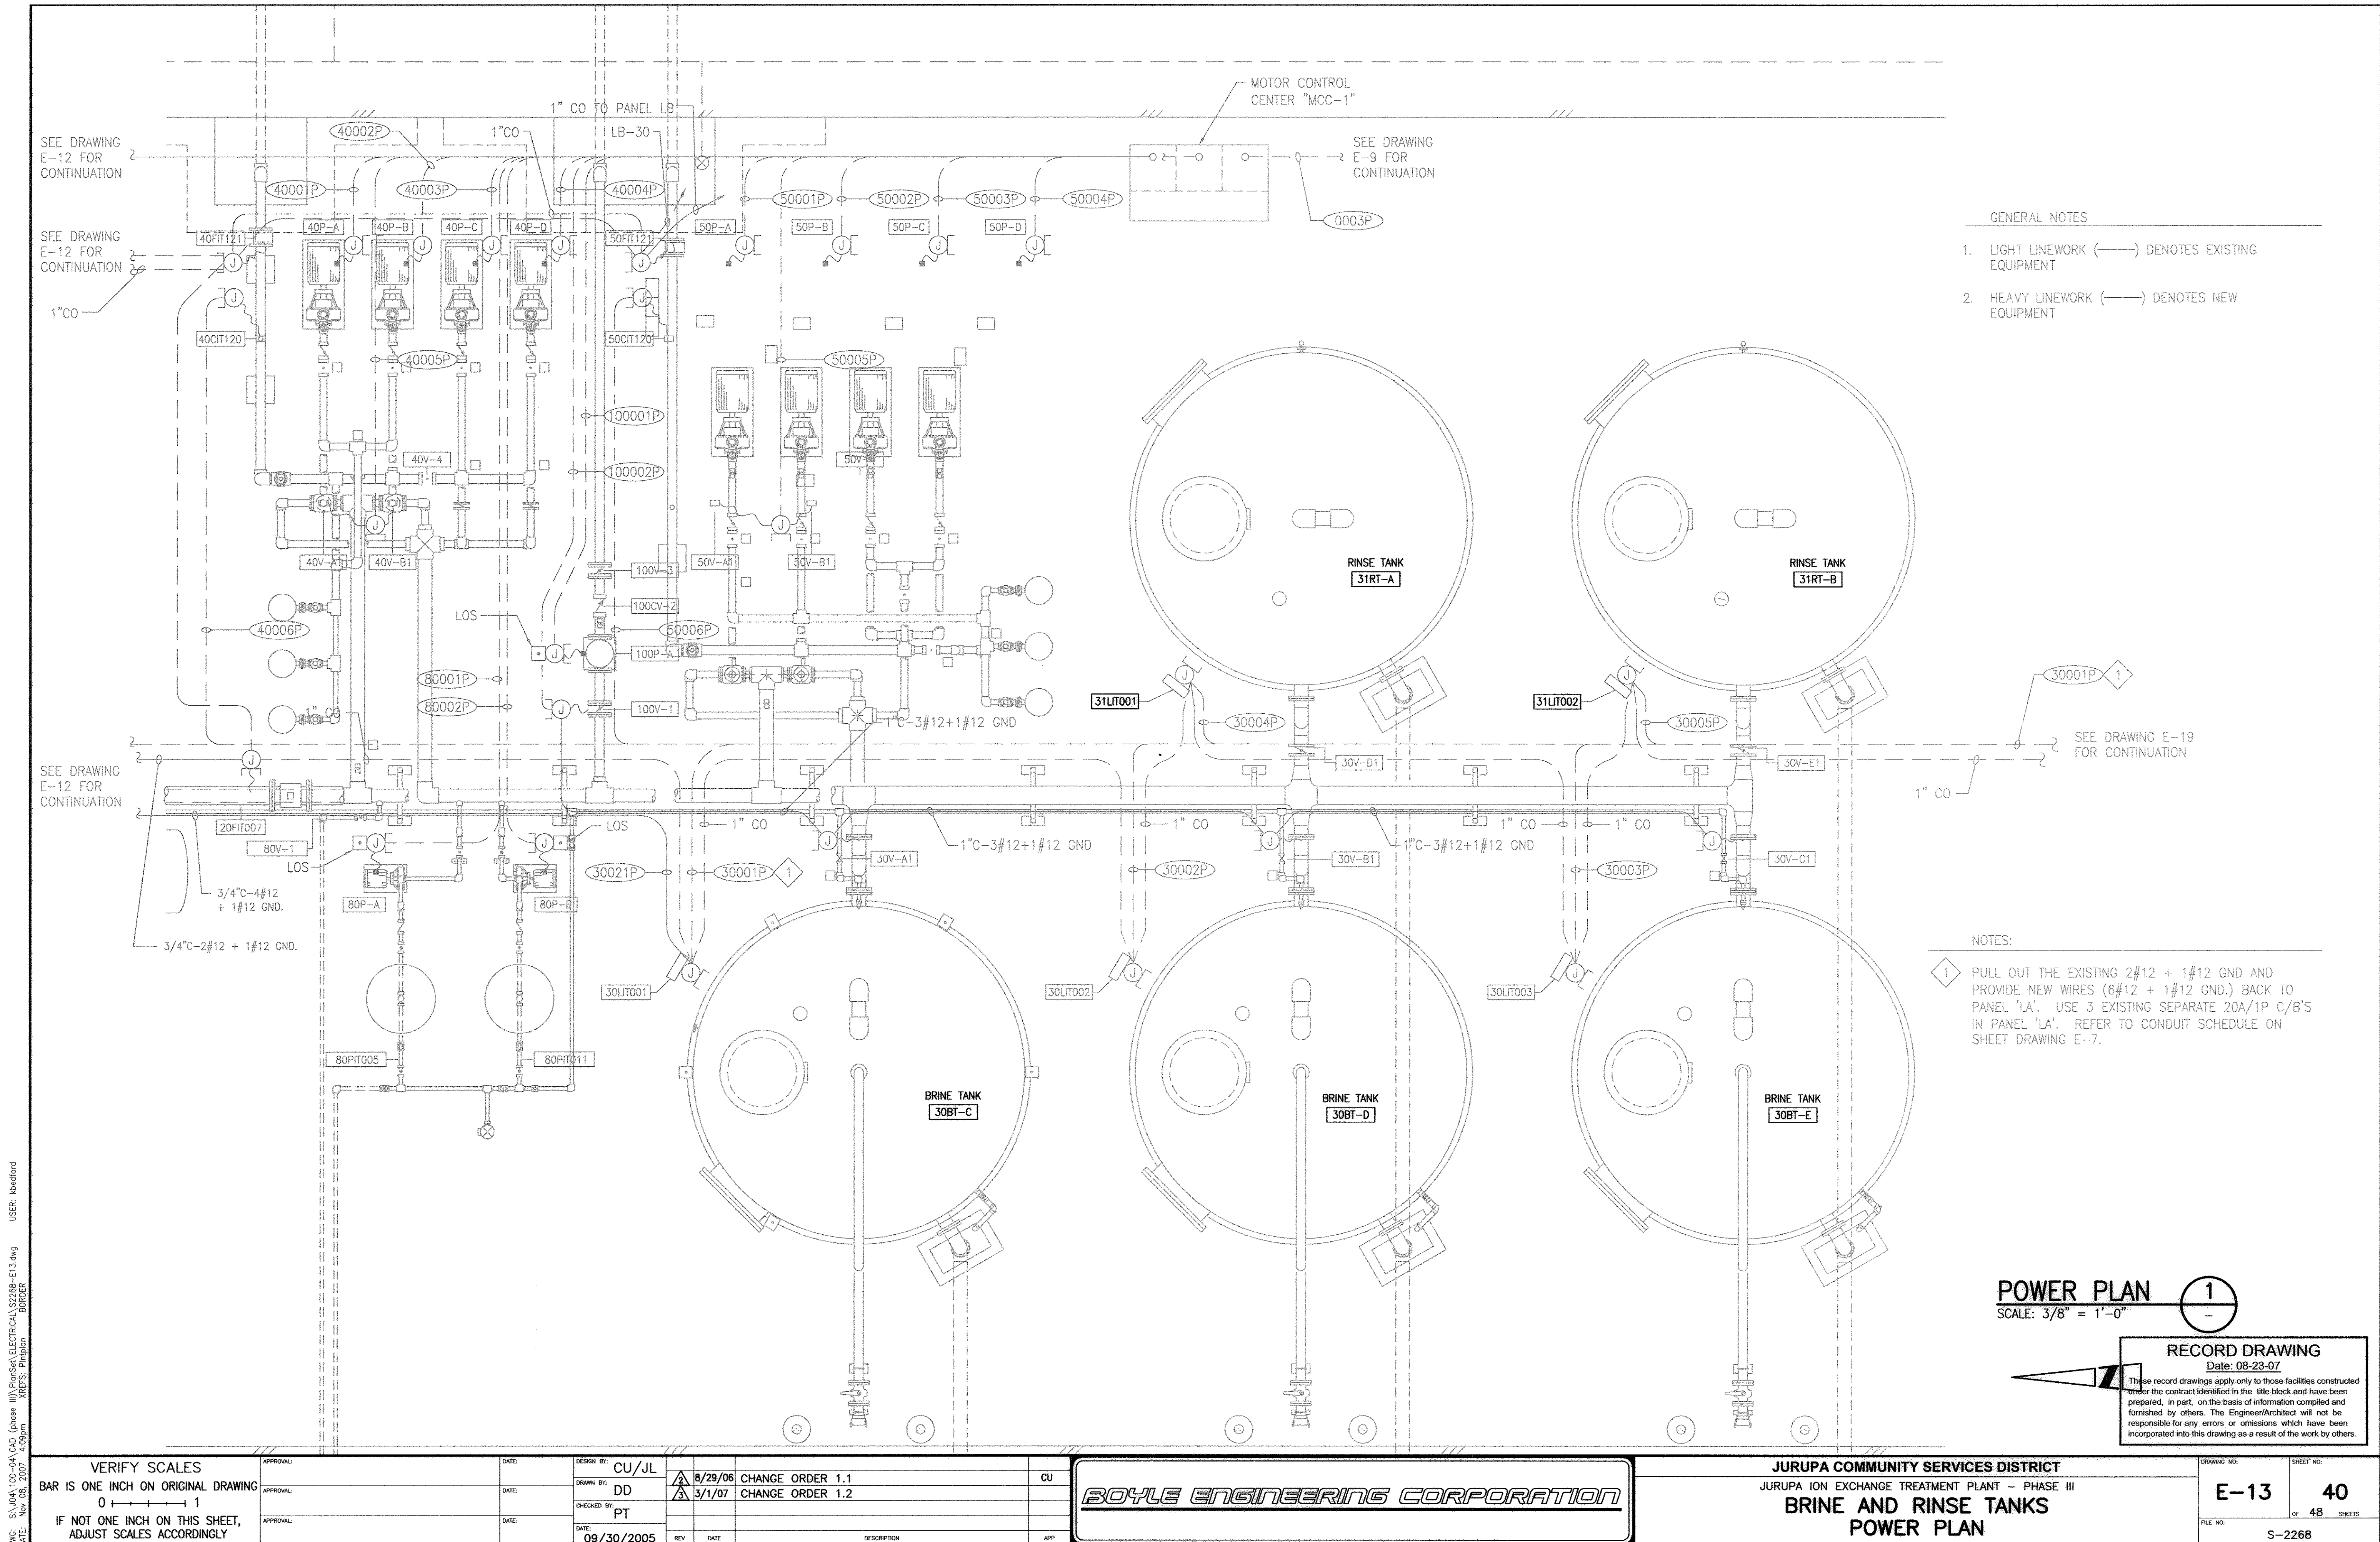

DWG: S:\JCA\100-04\100-04.dwg (phase 1) J:\P\JCA\100-04\100-04.dwg
DATE: Nov 03, 2007 4:48pm USER: bedford
S:\JCA\100-04\100-04.dwg (phase 1) J:\P\JCA\100-04\100-04.dwg
DATE: Nov 03, 2007 4:48pm USER: bedford

VERIFY SCALES
BAR IS ONE INCH ON ORIGINAL DRAWING
0 1
IF NOT ONE INCH ON THIS SHEET,
ADJUST SCALES ACCORDINGLY

APPROVAL:	DATE:	DESIGN BY:	CU/JL
APPROVAL:	DATE:	DRAWN BY:	DD
APPROVAL:	DATE:	CHECKED BY:	PT
APPROVAL:	DATE:	DATE:	09/30/2005

REV	DATE	DESCRIPTION	APP
1	8/29/06	CHANGE ORDER 1.1	CU
2	3/1/07	CHANGE ORDER 1.2	


BOYLE ENGINEERING CORPORATION

JURUPA COMMUNITY SERVICES DISTRICT
JURUPA ION EXCHANGE TREATMENT PLANT - PHASE III
BRINE AND RINSE TANKS
POWER PLAN


DRAWING NO:	SHEET NO:
E-13	40
FILE NO:	OF 48 SHEETS
S-2268	

POWER PLAN
SCALE: 3/8" = 1'-0"

RECORD DRAWING
Date: 08-23-07
These record drawings apply only to those facilities constructed under the contract identified in the title block and have been prepared, in part, on the basis of information compiled and furnished by others. The Engineer/Architect will not be responsible for any errors or omissions which have been incorporated into this drawing as a result of the work by others.

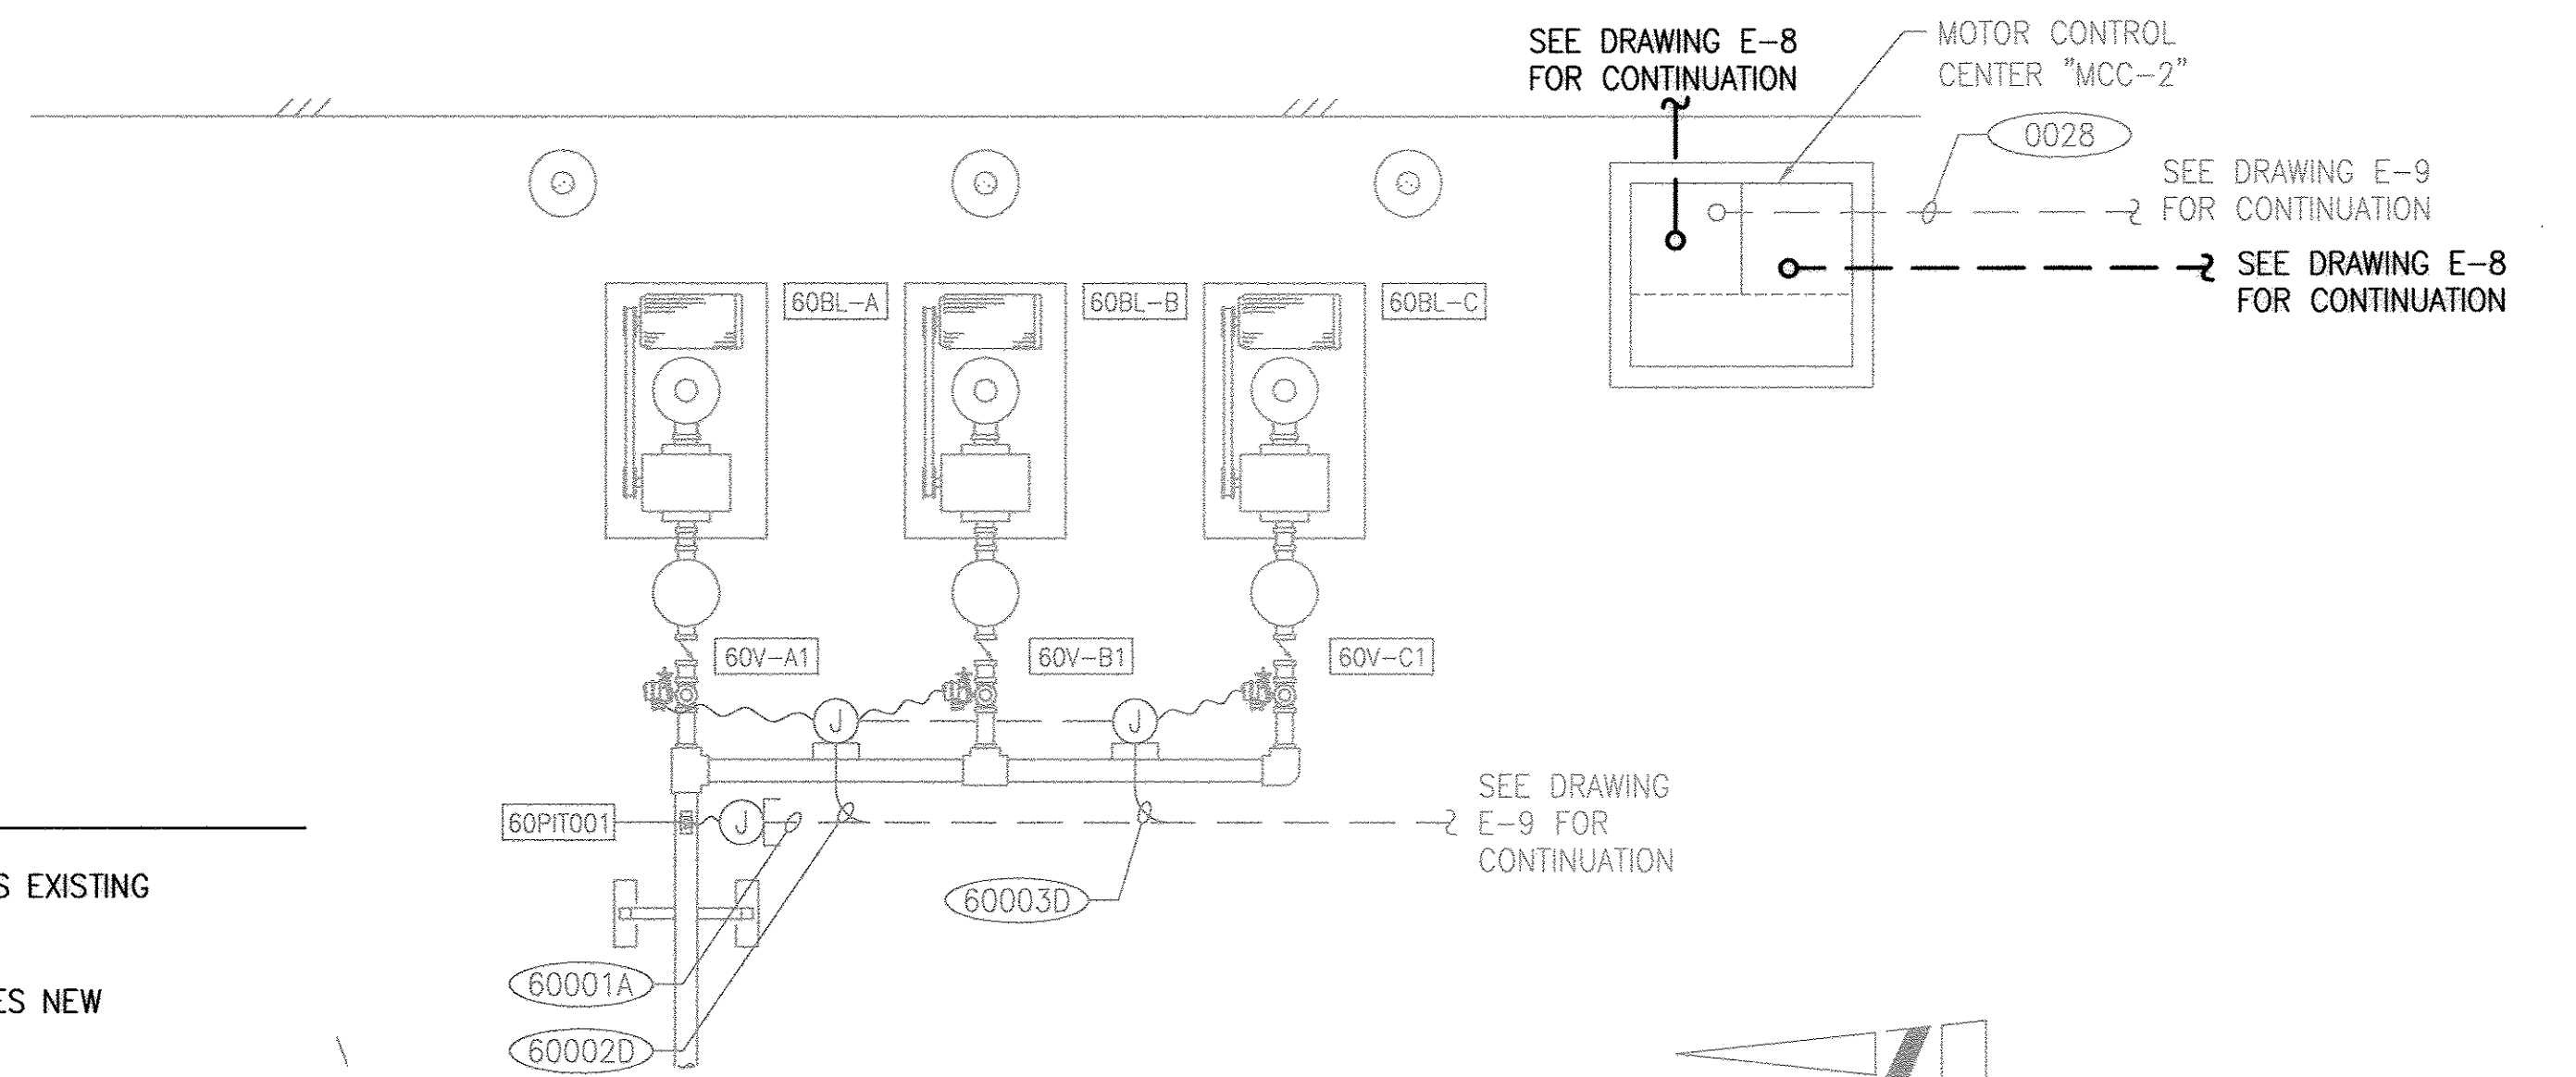

BLOWER CONTROL PLAN
SCALE: 3/8" = 1'-0"

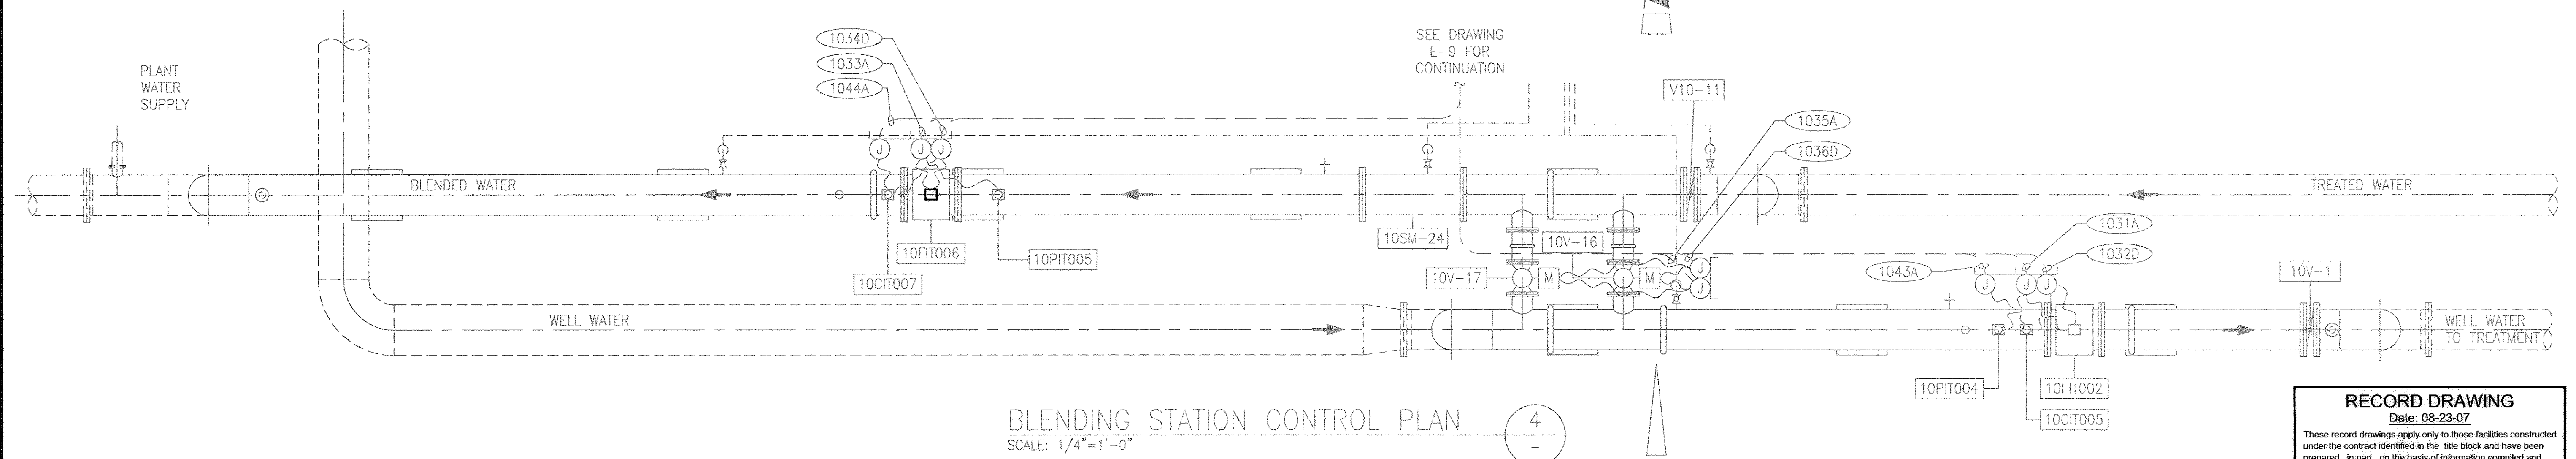


DRAWING NO:	SHEET NO:
E-14	41
OF 48	SHEETS

E. NO: S-2268

DWG: S:\J04\100-04\CAO Phase III\PlanSet\ELECTRICAL\S2268-E15.dwg USER: bedford
DATE: Nov 08, 2007 4:10pm XREFS: P:\mplan BORDER

THIS SHEET IS PROVIDED FOR
INFORMATION PURPOSES ONLY

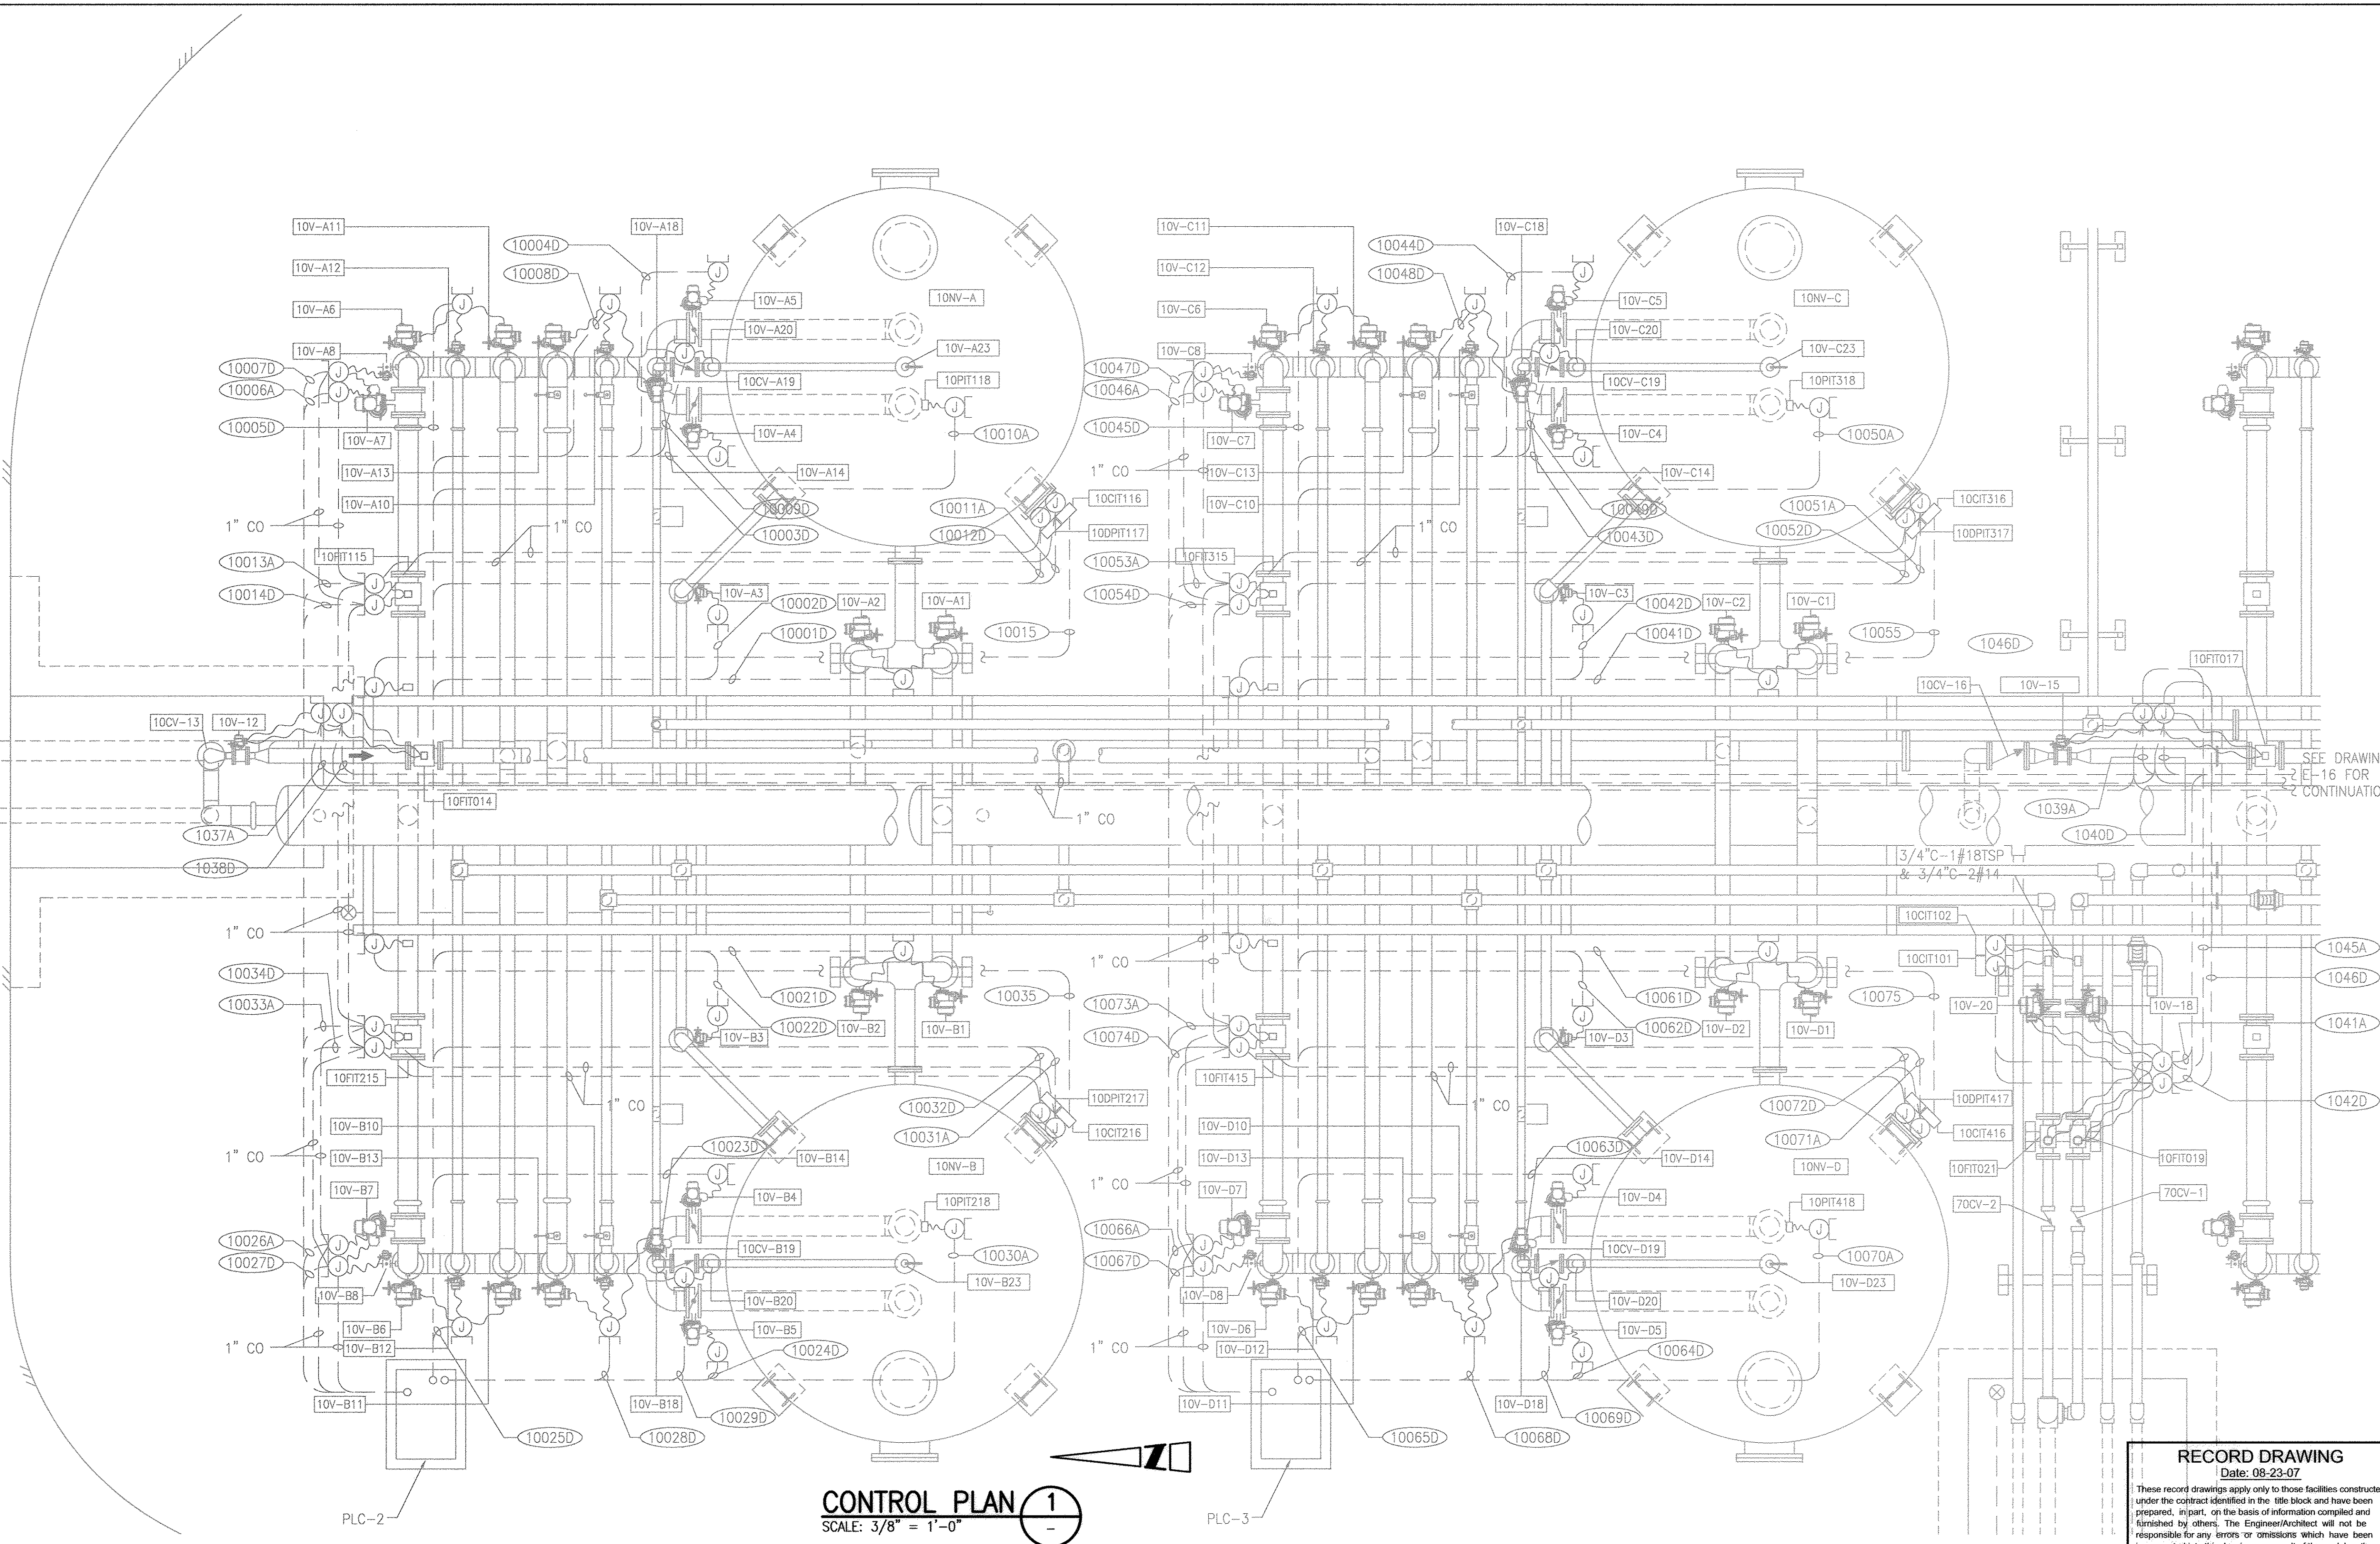

CONTROL PLAN 1
SCALE: 3/8" = 1'-0"

RECORD DRAWING
Date: 08-23-07
These record drawings apply only to those facilities constructed under the contract identified in the title block and have been prepared, in part, on the basis of information compiled and furnished by others. The Engineer/Architect will not be responsible for any errors or omissions which have been incorporated into this drawing as a result of the work by others.


VERIFY SCALES
BAR IS ONE INCH ON ORIGINAL DRAWING
0 1
IF NOT ONE INCH ON THIS SHEET,
ADJUST SCALES ACCORDINGLY

APPROVAL:	DATE:	DESIGN BY:	CU/JL
APPROVAL:	DATE:	DRAWN BY:	RH
APPROVAL:	DATE:	CHECKED BY:	PT
APPROVAL:	DATE:	DATE:	09/30/2005
APPROVAL:	DATE:	REV	
APPROVAL:	DATE:	DATE:	
APPROVAL:	DATE:	DESCRIPTION	
APPROVAL:	DATE:	APP	

BOYLE ENGINEERING CORPORATION

JURUPA COMMUNITY SERVICES DISTRICT
JURUPA ION EXCHANGE TREATMENT PLANT - PHASE III
ION EXCHANGE VESSEL
PARTIAL CONTROL PLAN

DRAWING NO: E-15
SHEET NO: 42
OF 48 SHEETS
FILE NO: S-2268

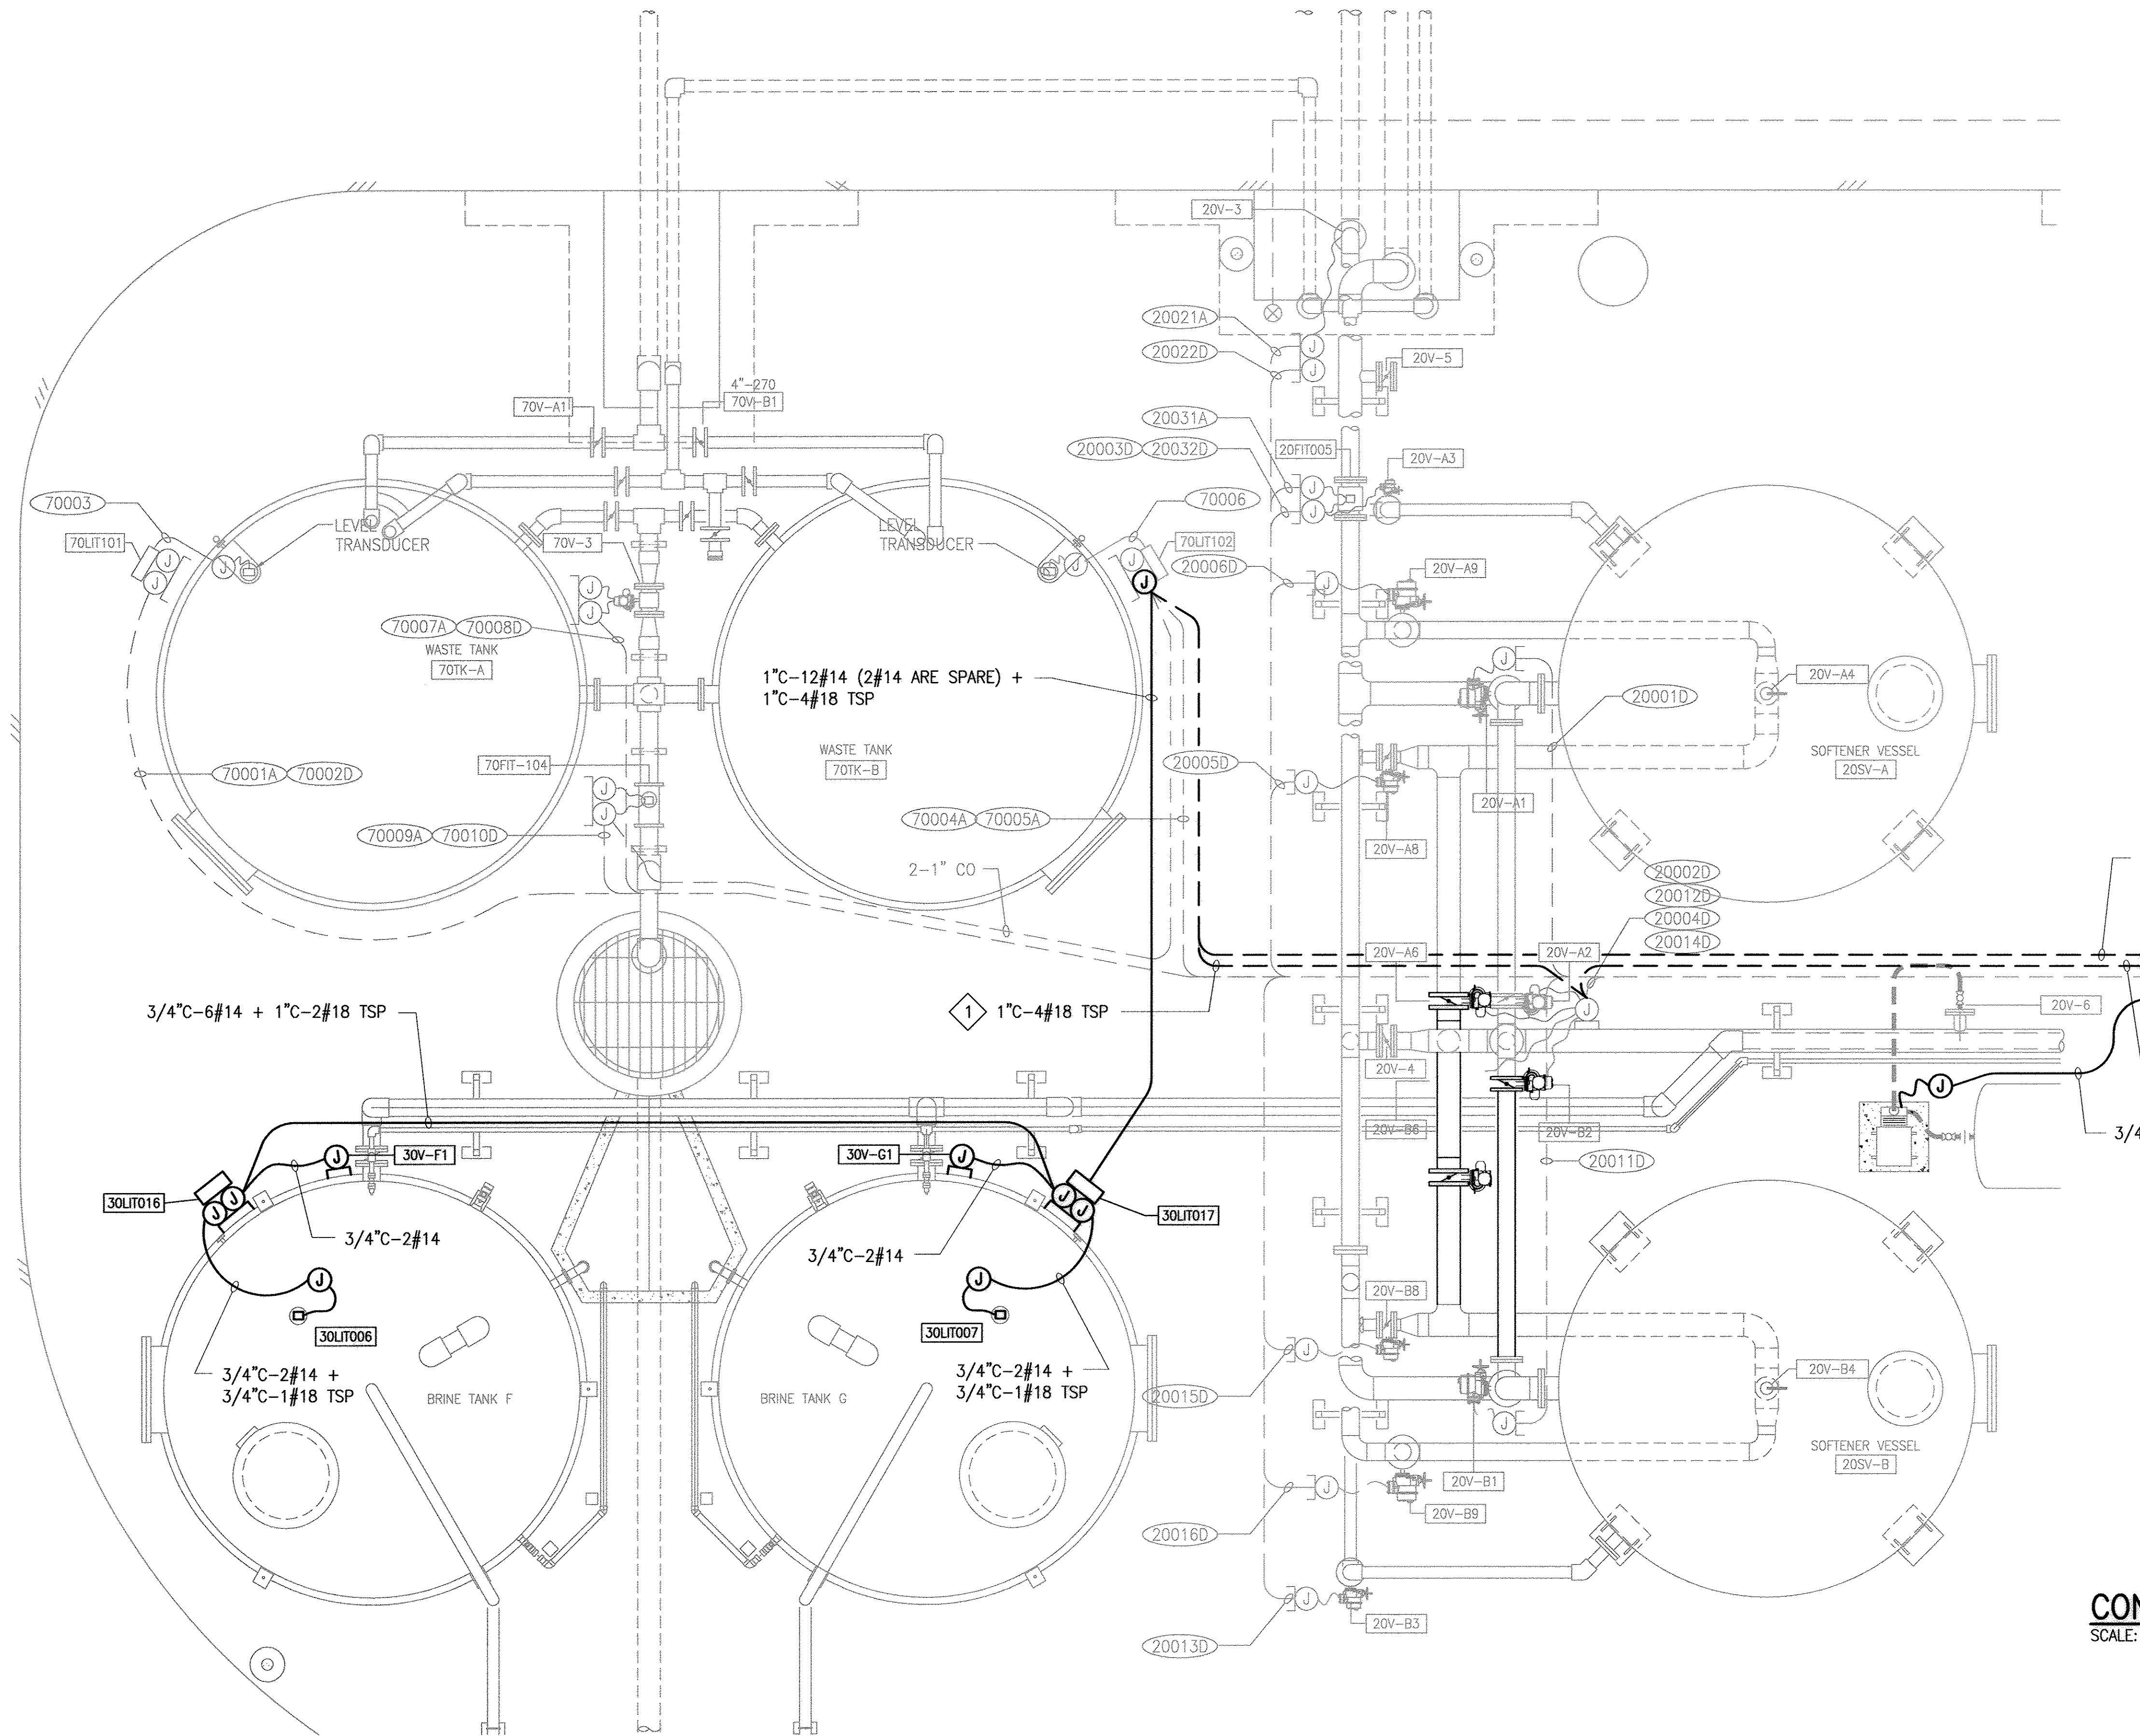

GENERAL NOTES

1. LIGHT LINEWORK (—) DENOTES EXISTING EQUIPMENT
2. HEAVY LINEWORK (—) DENOTES NEW EQUIPMENT

NOTES:

- 1 REUSE EXISTING CONDUIT.

CONTROL PLAN
SCALE: 3/8" = 1'-0"

RECORD DRAWING

Date: 08-23-07

These record drawings apply only to those facilities constructed under the contract identified in the title block and have been prepared, in part, on the basis of information compiled and furnished by others. The Engineer/Architect will not be responsible for any errors or omissions which have been incorporated into this drawing as a result of the work by others.

PWS: S:\JWA\100-000 CAD (chase) \J11\2106-000 ELECTRICAL\22068-E17.dwg USER: bedford
DATE: Nov 08, 2007 4:13pm XREFS: 2106-000 22068-E17 22068-E18 22068-E19 22068-E100

VERIFY SCALES
BAR IS ONE INCH ON ORIGINAL DRAWING
0 1
IF NOT ONE INCH ON THIS SHEET,
ADJUST SCALES ACCORDINGLY

APPROVAL: _____
DATE: _____
APPROVAL: _____
DATE: _____
APPROVAL: _____
DATE: _____


DESIGN BY: CU/JL
DRAWN BY: DD
CHECKED BY: PT
DATE: 09/30/2005

2 8/29/06 CHANGE ORDER 1.1
REV DATE DESCRIPTION APP


BOYLE ENGINEERING CORPORATION



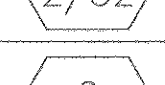
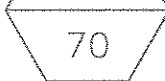

JURUPA COMMUNITY SERVICES DISTRICT
JURUPA ION EXCHANGE TREATMENT PLANT - PHASE III
WASTE TANKS AND SOFTENER VESSELS
CONTROL PLAN

DRAWING NO: E-17
SHEET NO: 44
OF 48 SHEETS
FILE NO: S-2268

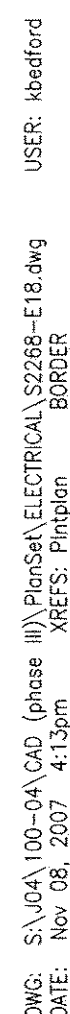

S-2268

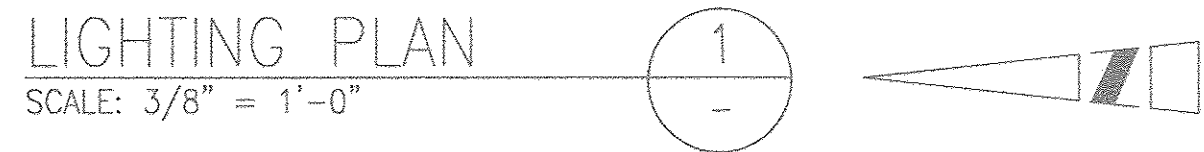

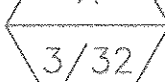LIGHTING FIXTURE SCHEDULE					
TYPE	DESCRIPTION	MOUNTING	VOLTS	WATTS	LAMPS
	FLUORESCENT 2'X4' DIE FORMED STEEL HOUSING, WHITE BAKED ENAMEL FINISH, WITH DIMMING BALLAST. UL LISTED, PRUDENTIAL P-2000 OR EQUAL	RECESSED	120V	120W	FLUOR.
	FLUORESCENT - 4' WRAP AROUND PRUDENTIAL P-1600 OR EQUAL.	SURFACE	120V	80W	FLUOR.
	WALLLIGHTER, COMPACT ONE PIECE MEDIUM BASE SOCKET WITH COATED LAMP WITH INTERNAL PHOTO CELL CONTROL FUNCTIONS. MANUFACTURER SHALL BE GE CAT. NO. WM7S07S SERIES OR EQUAL.	WALL	120V	70W	HPS
	FLUORESCENT-THERMOPLASTIC HOUSING, HIGH IMPACT ACRYLIC DIFFUSER, GASKETED, 130°F RATED. UL LISTED FOR WET LOCATIONS, 1 PHASE ELECTRONIC BALLAST, MANUFACTURER SHALL BE DAY-BRITE CAT. NO. VD248 SERIES OR EQUAL.	SURFACE	120V	80W	FLUOR.
	20 FEET STEEL POLE WITH 6 FOOT ARM GENERAL ELECTRIC #RRTS20 SERIES WITH 250 WATT HPS HEADS #M4AR SERIES.	POLE	120V	250W	HPS




- 1 REUSE EXISTING CONDUIT.
- 2 PULL OUT THE EXISTING 2#12 + 1#12 GND AND PROVIDE NEW WIRES (6#12 + 1#12 GND.) BACK TO PANEL 'LA'. USE 3 EXISTING SEPARATE 20A/1P C/B'S IN PANEL 'LA'. REFER TO CONDUIT SCHEDULE ON SHEET DRAWING E-7.

1. LIGHT LINEWORK (—) DENOTES EXISTING EQUIPMENT
2. HEAVY LINEWORK (—) DENOTES NEW EQUIPMENT




These record drawings apply only to those facilities constructed under the contract identified in the title block and have been prepared, in part, on the basis of information compiled and furnished by others. The Engineer/Architect will not be responsible for any errors or omissions which have been incorporated into this drawing as a result of the work by others.

THIS SHEET IS PROVIDED FOR
INFORMATION PURPOSES ONLY

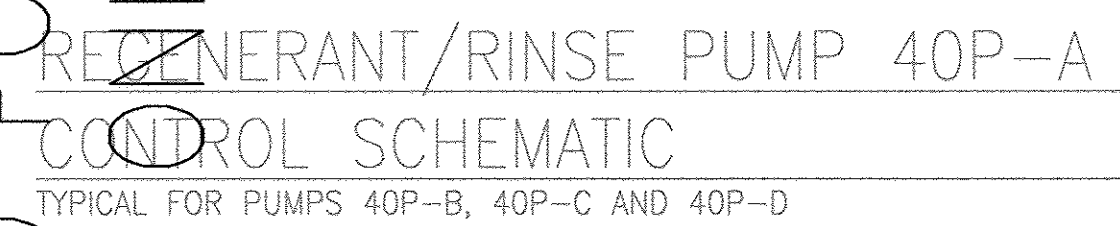

- GENERAL NOTES
-
1. LIGHT LINEWORK (————) DENOTES EXISTING EQUIPMENT
2. HEAVY LINEWORK (————) DENOTES NEW EQUIPMENT

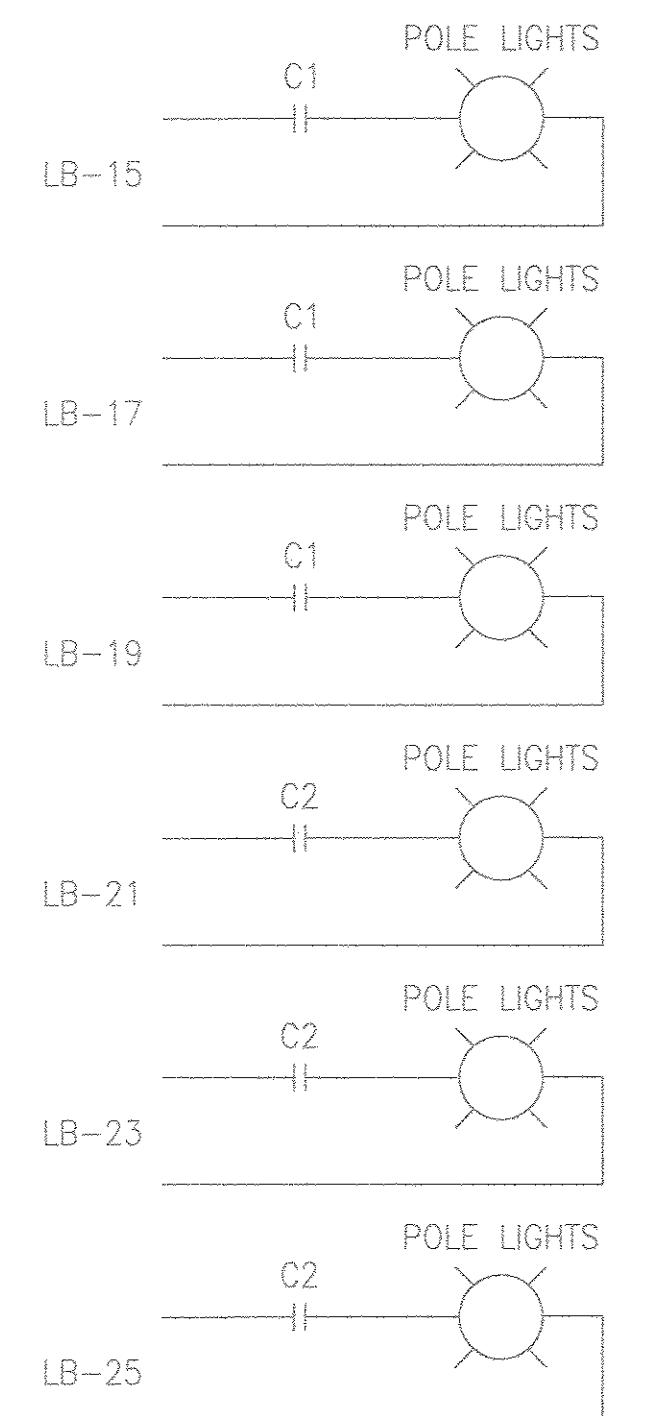


These record drawings apply only to those facilities constructed under the contract identified in the title block and have been prepared, in part, on the basis of information compiled and furnished by others. The Engineer/Architect will not be responsible for any errors or omissions which have been incorporated into this drawing as a result of the work by others.


SITE CONTROL TIME CLOCK
MOUNT CONTROLS AND TIME CLOCK IN NEMA 3R ENCLOSURE ADJACENT TO PANEL 'B'

SCHEMATIC DIAGRAMS


DRAWING NO:	SHEET NO:
E-20	47
	OF 48 SHEETS
FILE NO:	S-2268

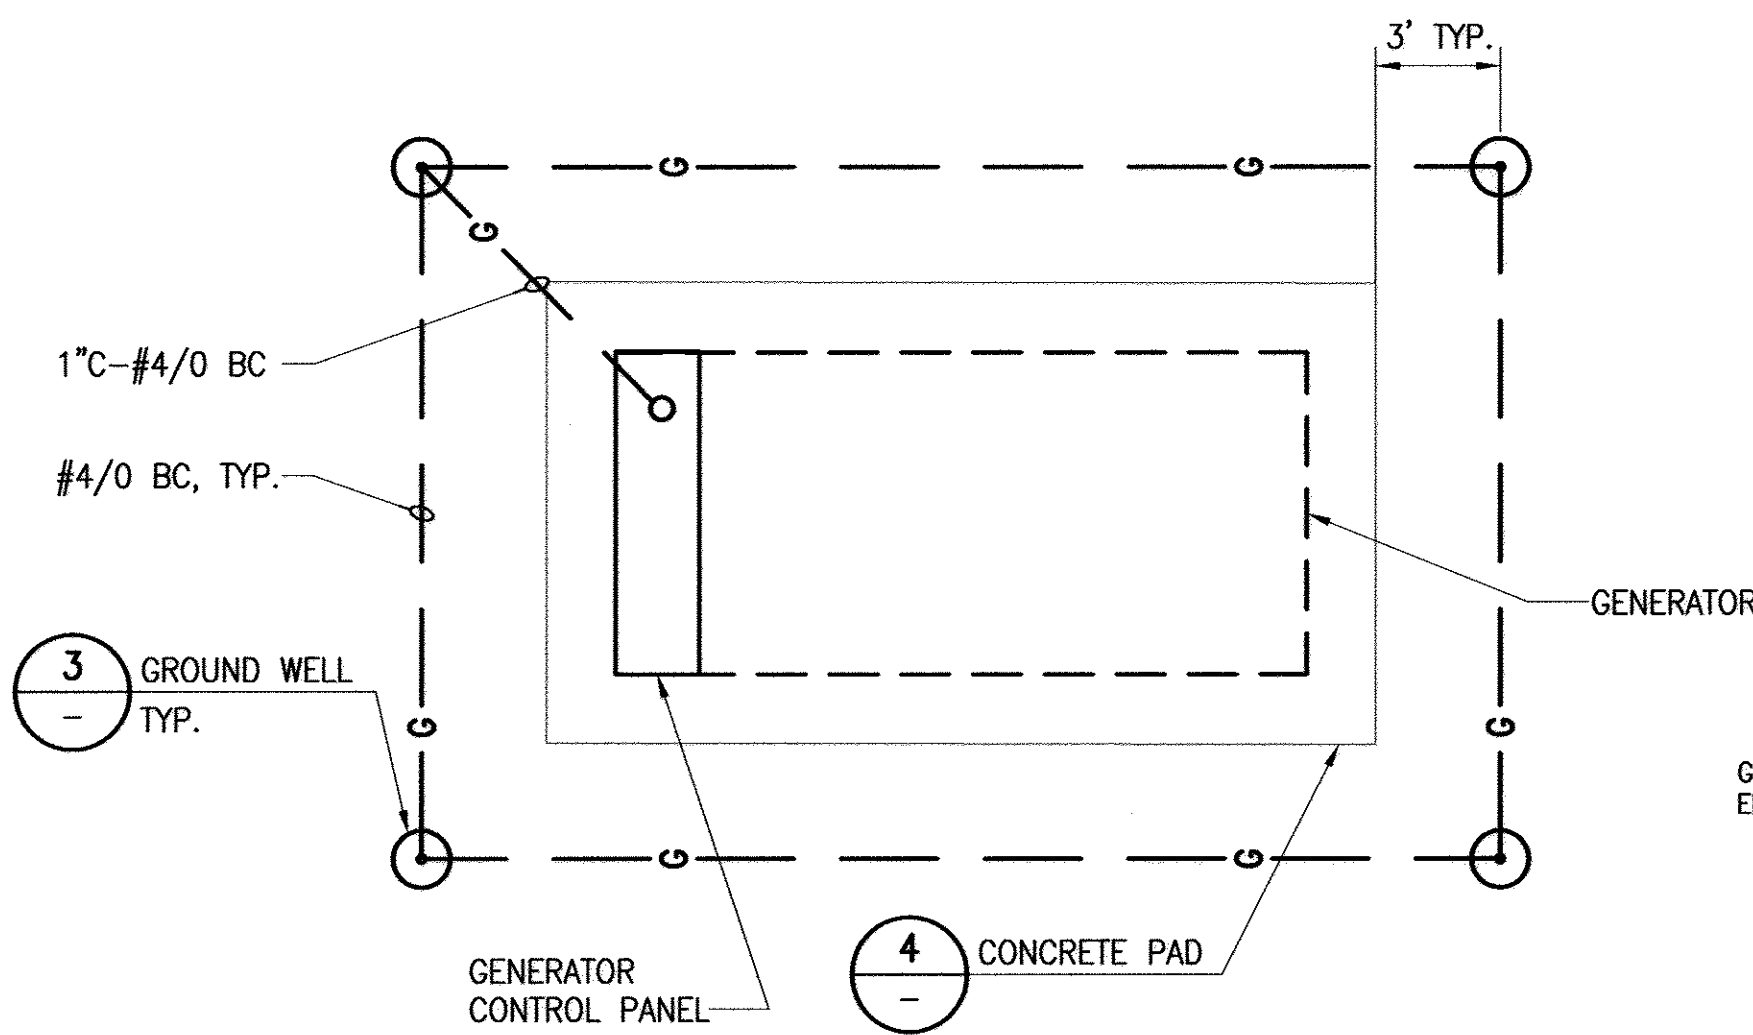


GENERATOR GROUNDING DETAIL
SCALE: NTS

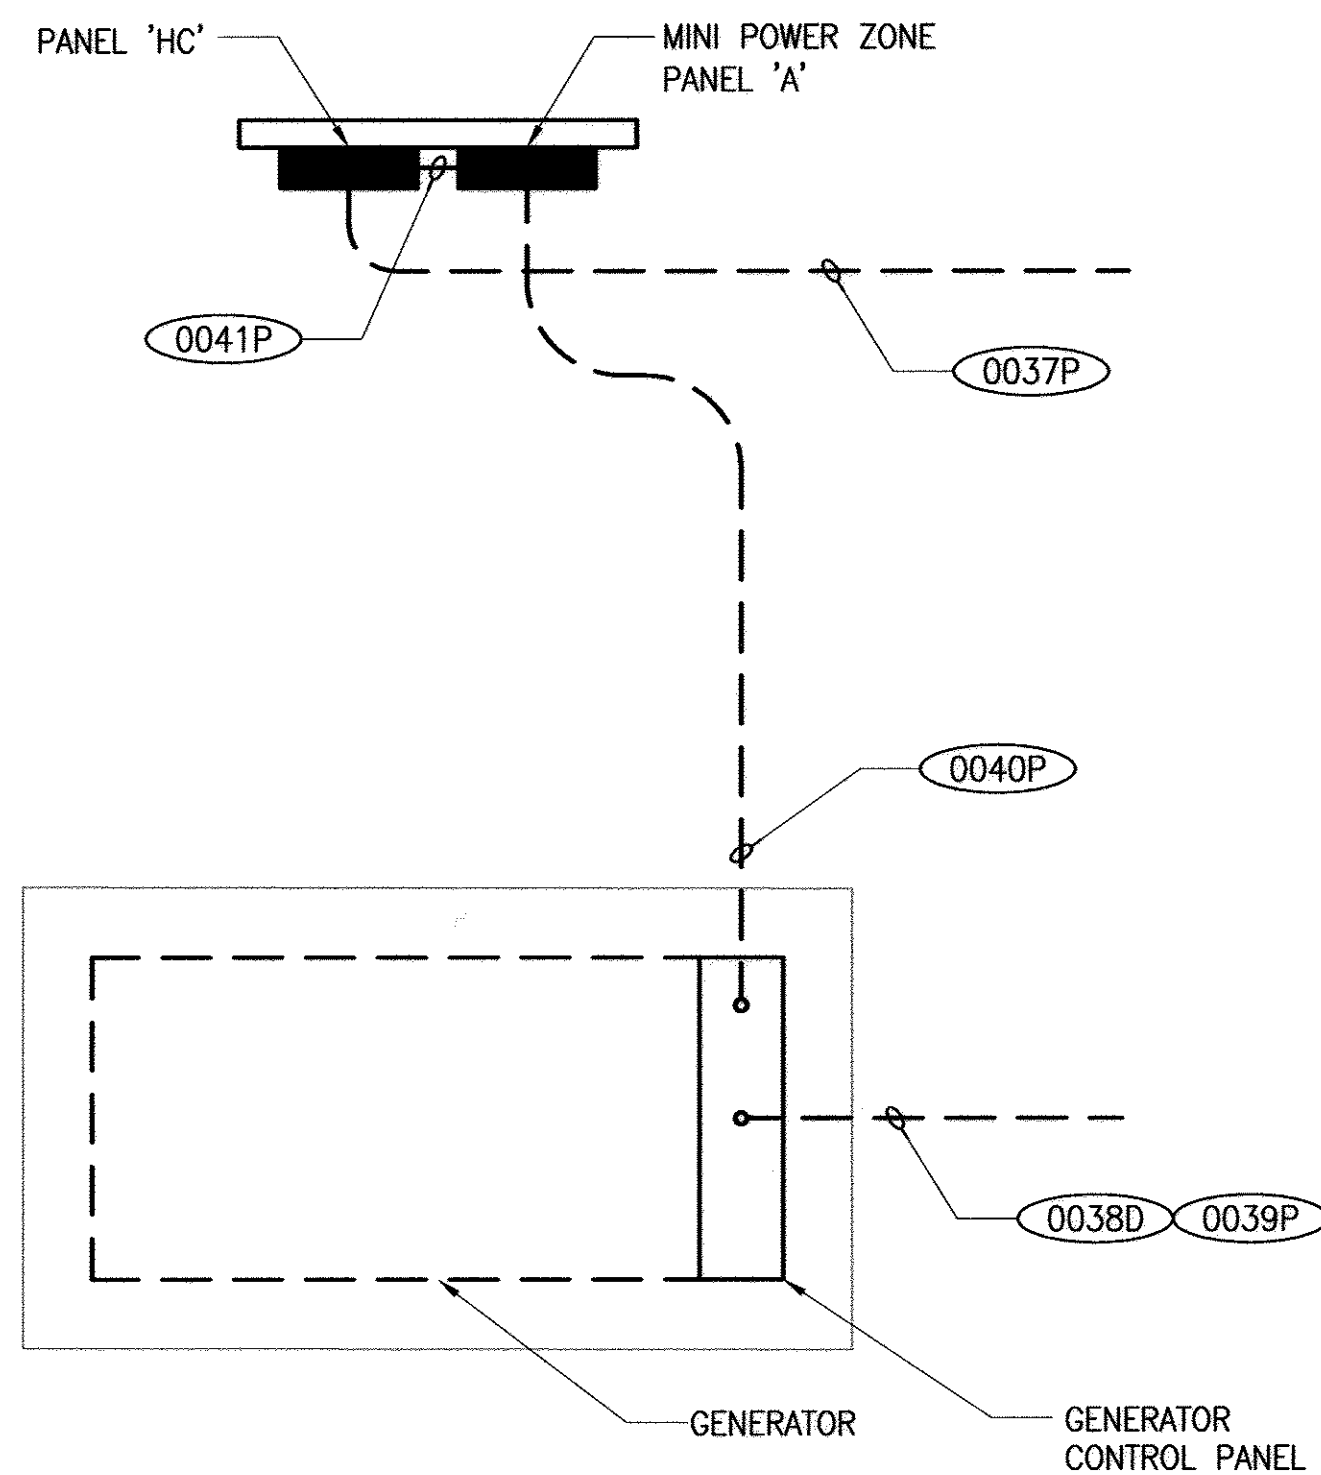


GENERATOR DETAIL
SCALE: NTS

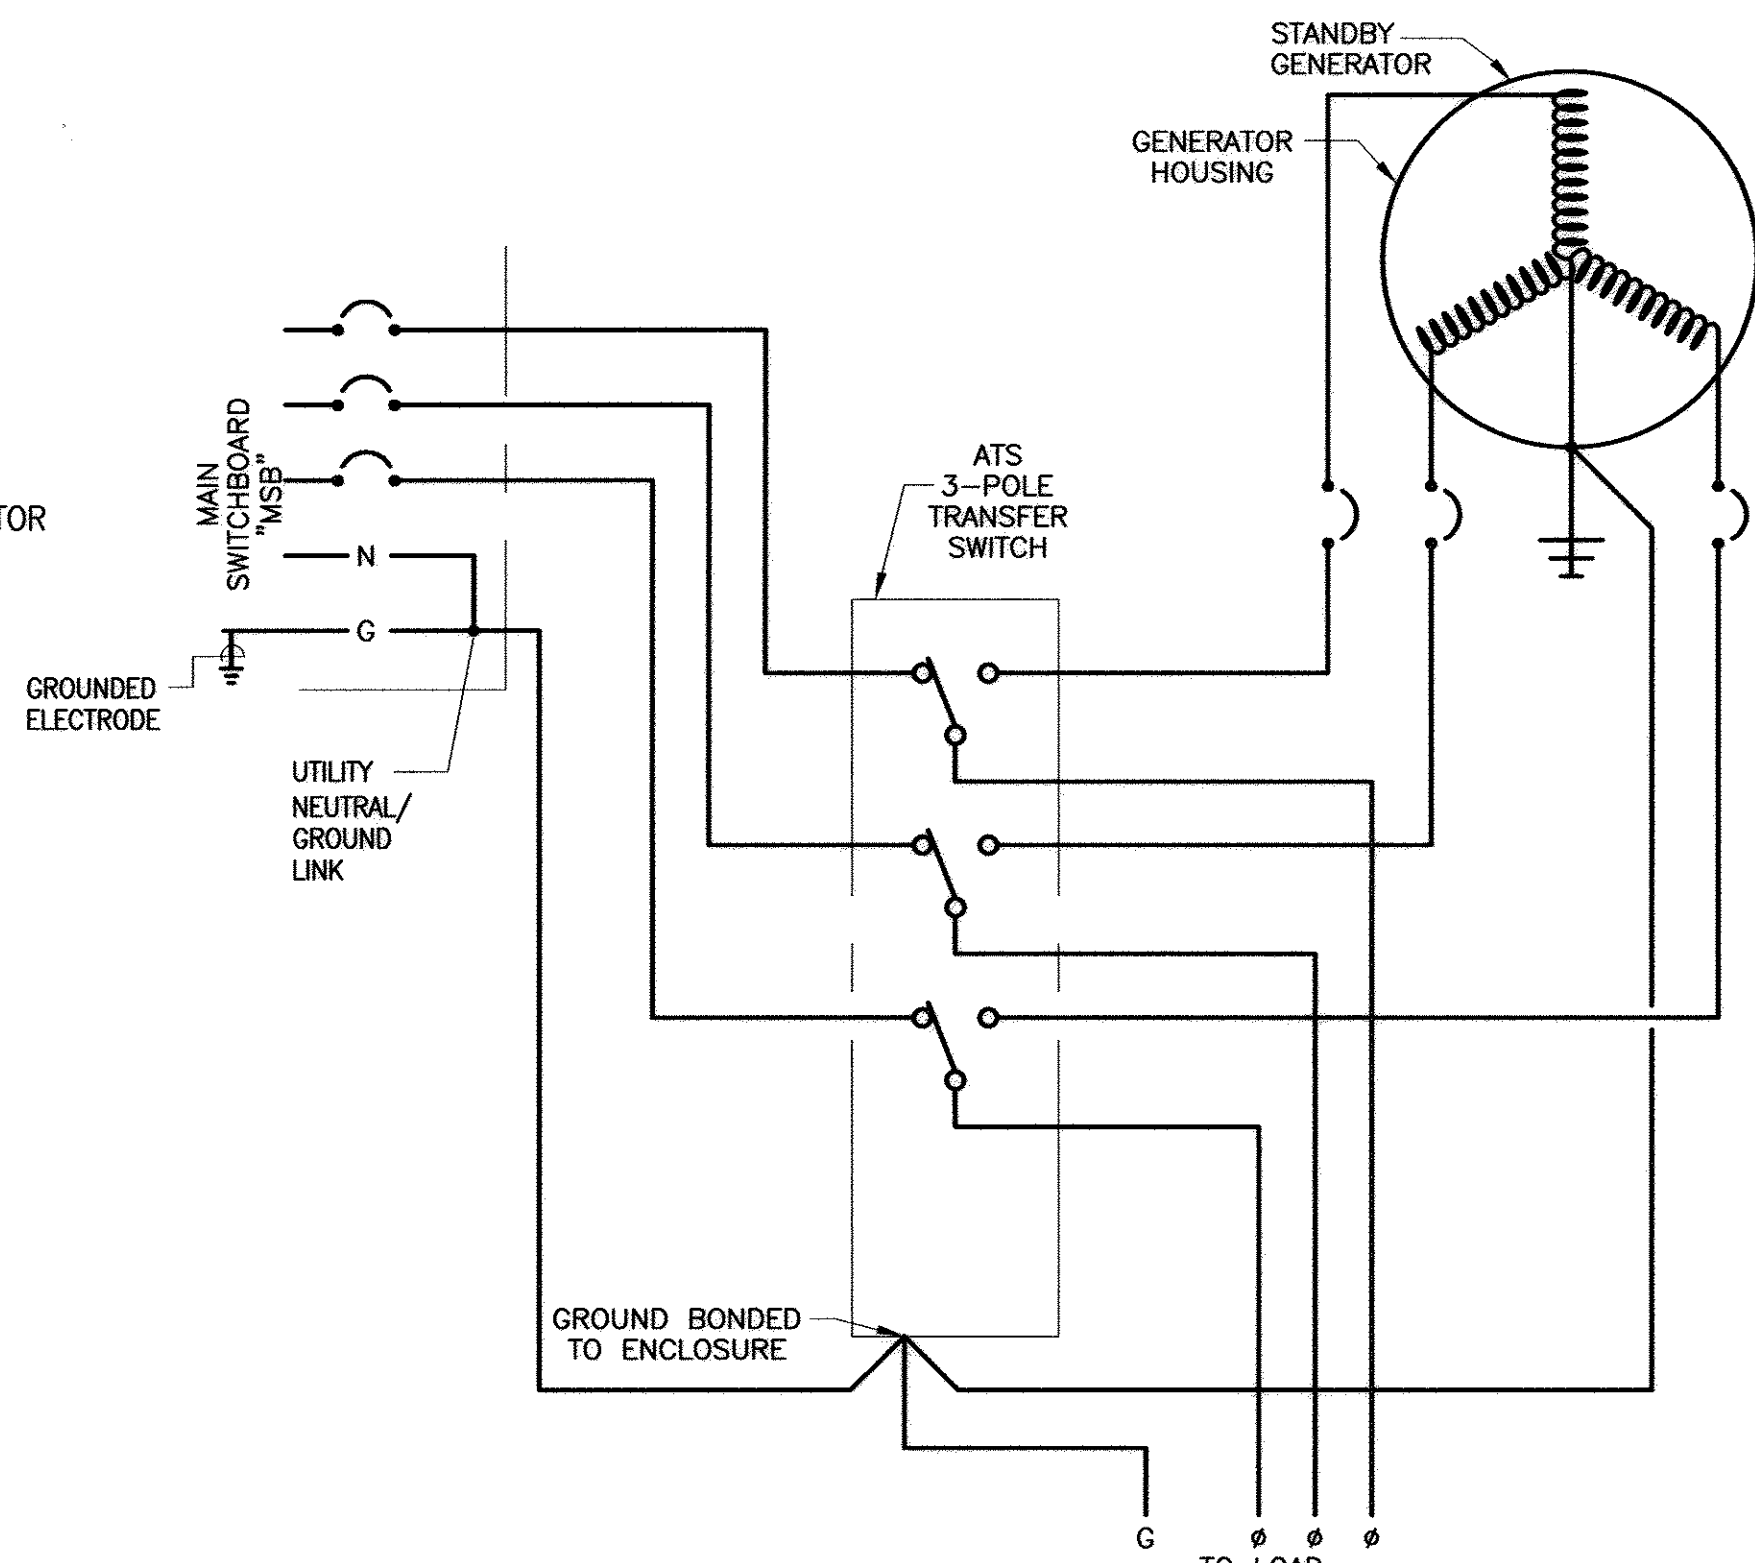

**STANDBY SYSTEM WIRING
THREE LINE DIAGRAM**
SCALE: NTS

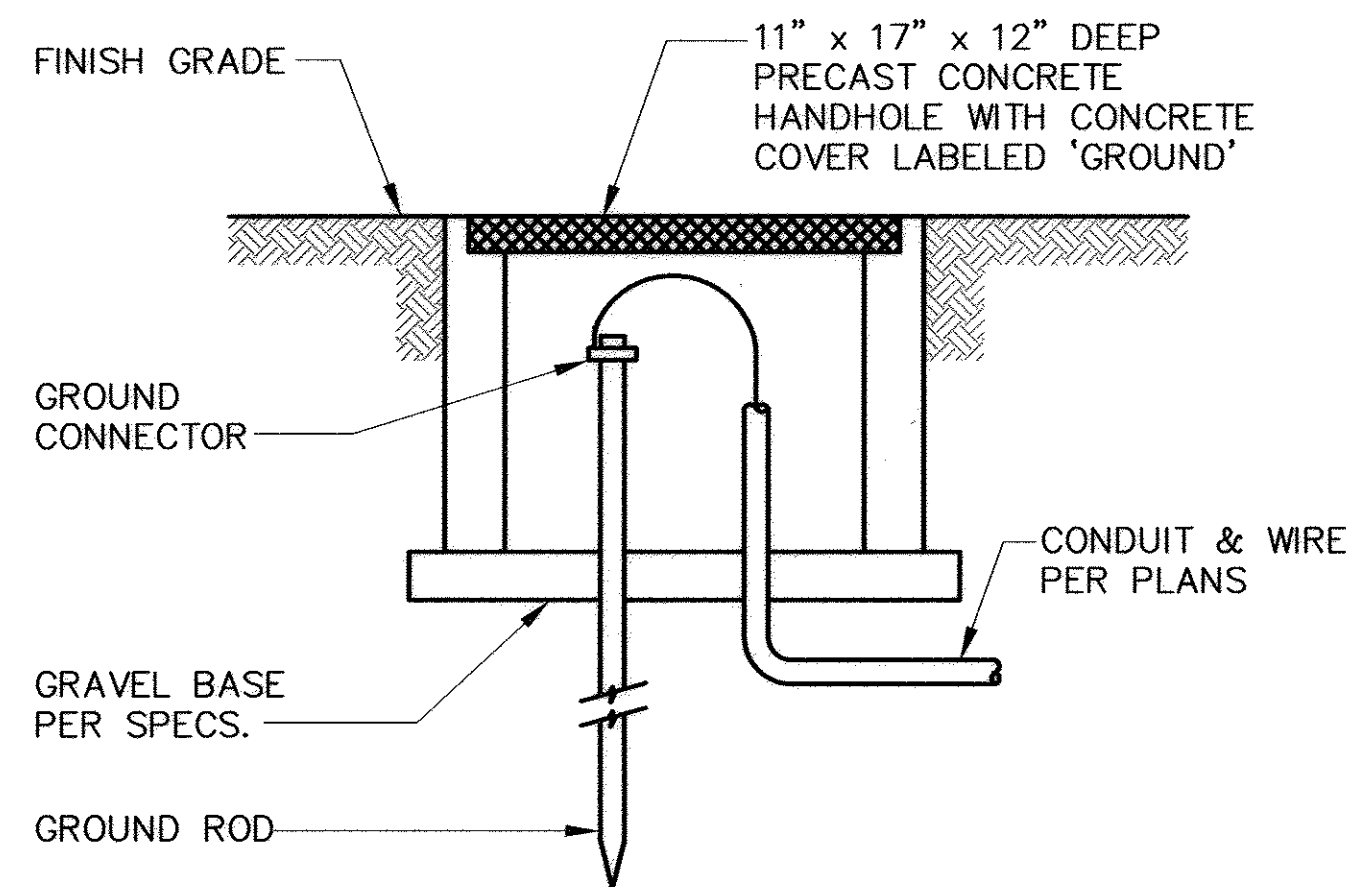


GROUND WELL DETAIL
SCALE: NTS

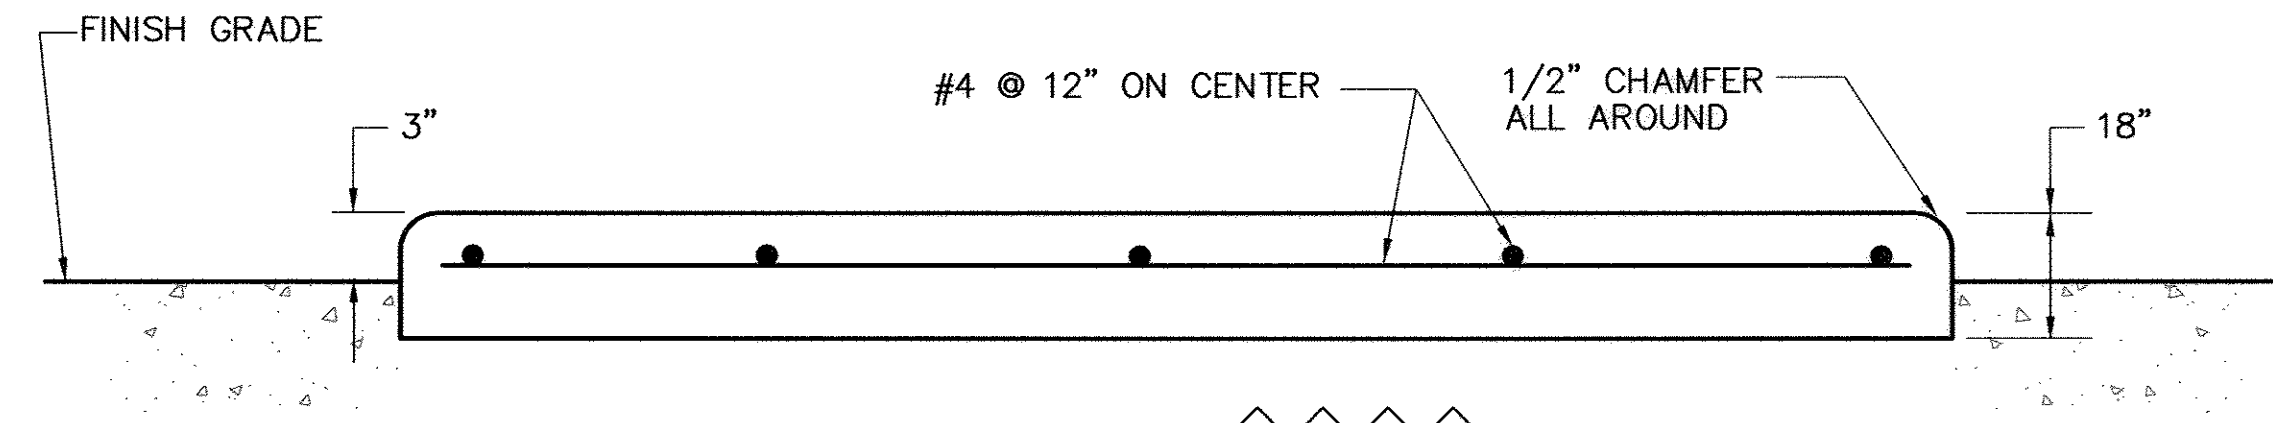


EQUIPMENT PAD
SCALE: NTS

- NOTES:
- COORDINATE PAD SIZE WITH SHOP DRAWINGS.
 - CONCRETE SHALL BE CLASS 'A'.
 - REINFORCING STEEL SHALL BE GRADE 60 ASTM A615. ALL APPLICABLE REINFORCEMENT SHALL BE IN PLACE AT THE TIME OF INSPECTION.
 - PAD SHALL EXTEND 12" ALL AROUND FOOTPRINT OF GENERATOR ENCLOSURE

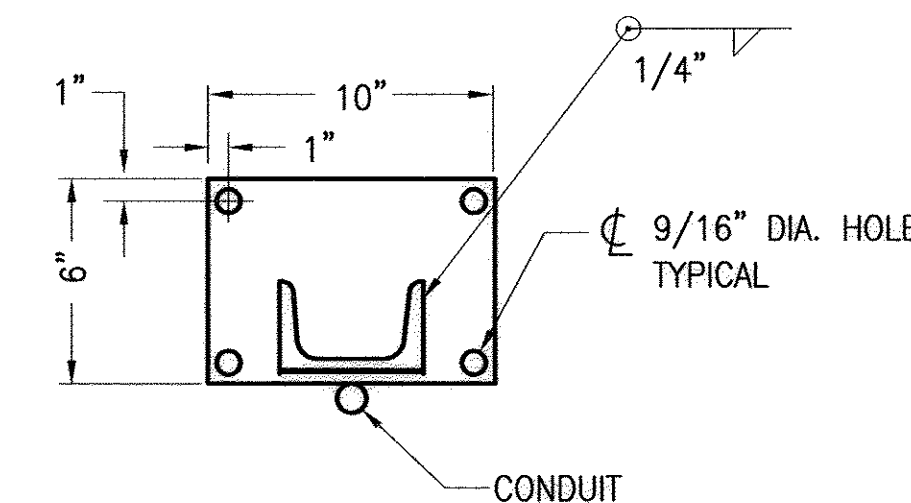

SECTION "A-A"

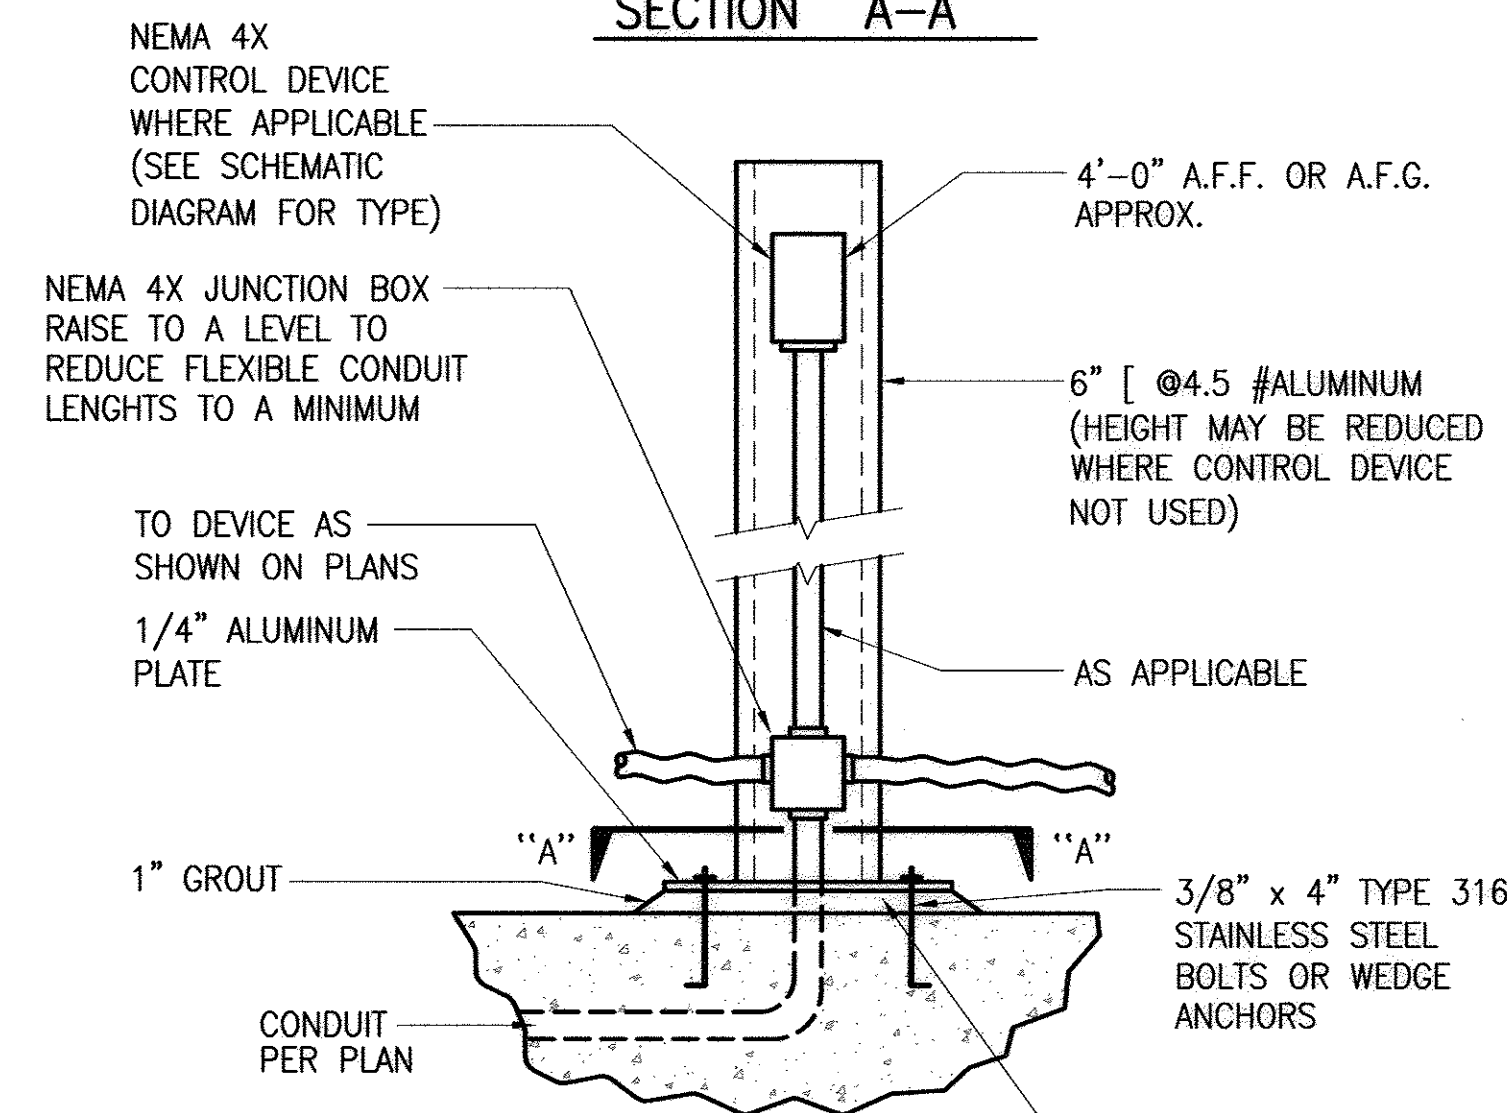

PRIME COAT: APPLY SYNTHETIC RESIN PRIMER TO METAL SURFACE BEFORE FINISH COATS. PRODUCTS: KOPPERS 40, TNEC 32-1210, PORTER VC 1799, OR EQUAL.

FINISH COAT: TWO COATS OF KOPPERS BITUMASTIC SUPER SERVICE BLACK, 12 MILS EACH; TWO COATS OF TNEC 46-450 HEAVY TNECOCOL, 12 MILS EACH; TWO COATS OF PORTER TARMASTIC 100, 12 MILS EACH; OR EQUAL.

CONTROL STATION OR JBOX MOUNTING DETAIL
SCALE: NTS

RECORD DRAWING
Date: 08-23-07

These record drawings apply only to those facilities constructed under the contract identified in the title block and have been prepared, in part, on the basis of information compiled and furnished by others. The Engineer/Architect will not be responsible for any errors or omissions which have been incorporated into this drawing as a result of the work by others.

DWG: S:\PA\100-04\CD (phase III)\JURUPA\ELECTRICAL\S2268-C21.dwg
 DATE: Nov 08, 2007 4:18pm
 USER: boyle
 XREFS: 80308

VERIFY SCALES BAR IS ONE INCH ON ORIGINAL DRAWING 0 1 1	APPROVAL:	DATE:	DESIGN BY: CU/JL						
	APPROVAL:	DATE:	DRAWN BY: RH						
	APPROVAL:	DATE:	CHECKED BY: PT						
		DATE: 09/30/2005							
			REV	DATE	DESCRIPTION				APP

BOYLE ENGINEERING CORPORATION

JURUPA COMMUNITY SERVICES DISTRICT
JURUPA ION EXCHANGE TREATMENT PLANT - PHASE III

ELECTRICAL DETAIL

DRAWING NO: **E-21**
SHEET NO: **48**
OF 48 SHEETS
FILE NO: S-2268

Attachment “D”
Process Controls and Operation

Nitrate Vessel Regeneration Cycle

	Volume (Gal.)	Flow Rate (GPM)	Source	Discharge To	Duration (min.)
Drain Vessel	7,100	250-350	N/A	Softener	25
Brine (down flow)	7,500	200	B/R Pumps	Waste Tank	37.5
Rinse #1 (down flow)	10,000	250	B/R Pumps	Waste Tank	40
Rinse #2	750	150	B/R Pumps	Waste Tank	5
Rinse #3	5,500	275	Raw Water	Waste Tank	20
Purge	800	165	Treated Water	Waste Tank	5
Standby	N/A	N/A	Raw Water	N/A	10